

83 SPACES THIS LEVEL

PARKING GARAGE

RAMP DN 6.5%

24

18 18

+696'-3 5/8"
+696.3'


CMU WALL

ELEVATOR PENTHOUSE

STAIR #5

COPYRIGHT © Beeler Guest Owens Architects ALL RIGHTS RESERVED

1 DIVISION 'D' ROOF PLAN
1/8"=1'-0"

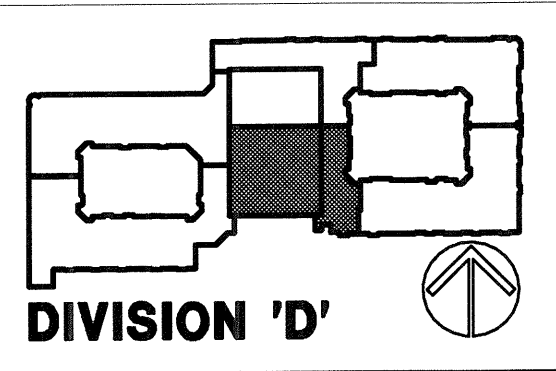

BGO
architects
4144 N. Central Expy.
Suite 855
Dallas, TX 75204
214.520.8878
bgoarchitects.com

CONSTRUCTION ISSUE
10-17-2011

REVISIONS
▲ GARAGE REVISIONS PER SHOP DWGS 01-03-2012

KELLER SPRINGS LOFTS
LOFT APARTMENTS IN ADDISON, TEXAS

01-03-2012

DATE
08-05-2011
PROJECT
11129

SHEET NUMBER
3.6D
BLDG PLAN 'D'