


1/8"=1'-0"

DIVISION 'D' ROOF PLAN AT GARAGE STAIR

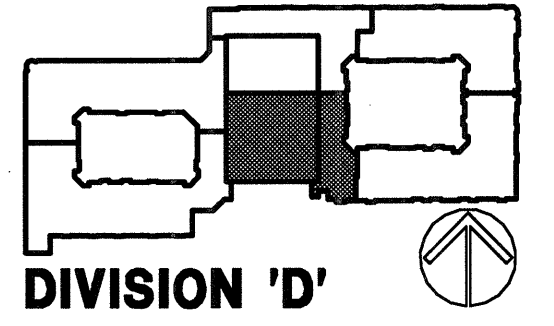

DIVISION 'D'

BGO
architects
4144 N. Central Expy.
Suite 855
Dallas, TX 75204
214.520.8878
bgoarchitects.com

CONSTRUCTION ISSUE
10-17-2011

REVISIONS

NO.	DESCRIPTION

KELLER SPRINGS LOFTS
LOFT APARTMENTS IN ADDISON, TEXAS

10-17-2011

DATE
08-05-2011
PROJECT
11129

SHEET NUMBER
3.7D
BLDG PLAN 'D'

COPYRIGHT © Beeler, Guest Owens Architects ALL RIGHTS RESERVED