

DIVISION C  
DIVISION D




DIVISION C  
DIVISION D

DIVISION E  
DIVISION F

DIVISION A  
DIVISION B


DIVISION D  
DIVISION F

DIVISION D  
DIVISION F

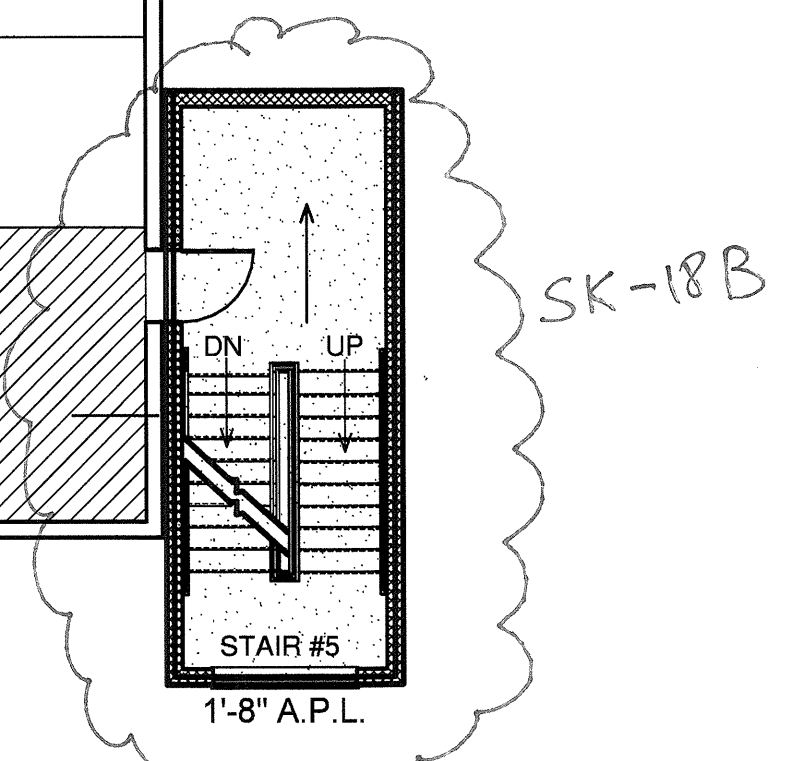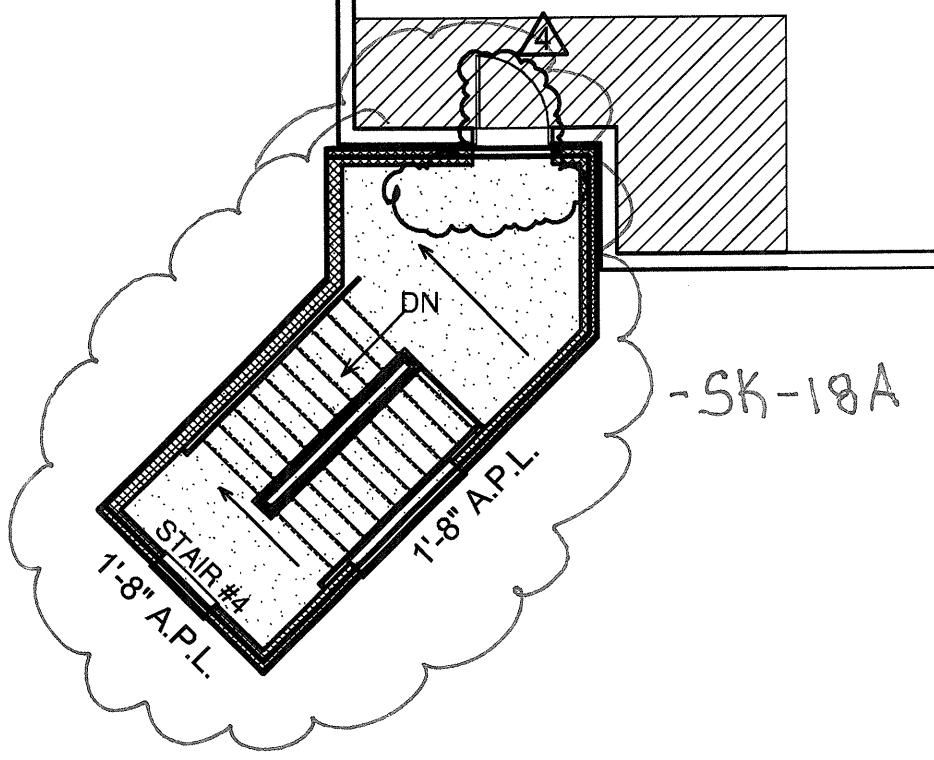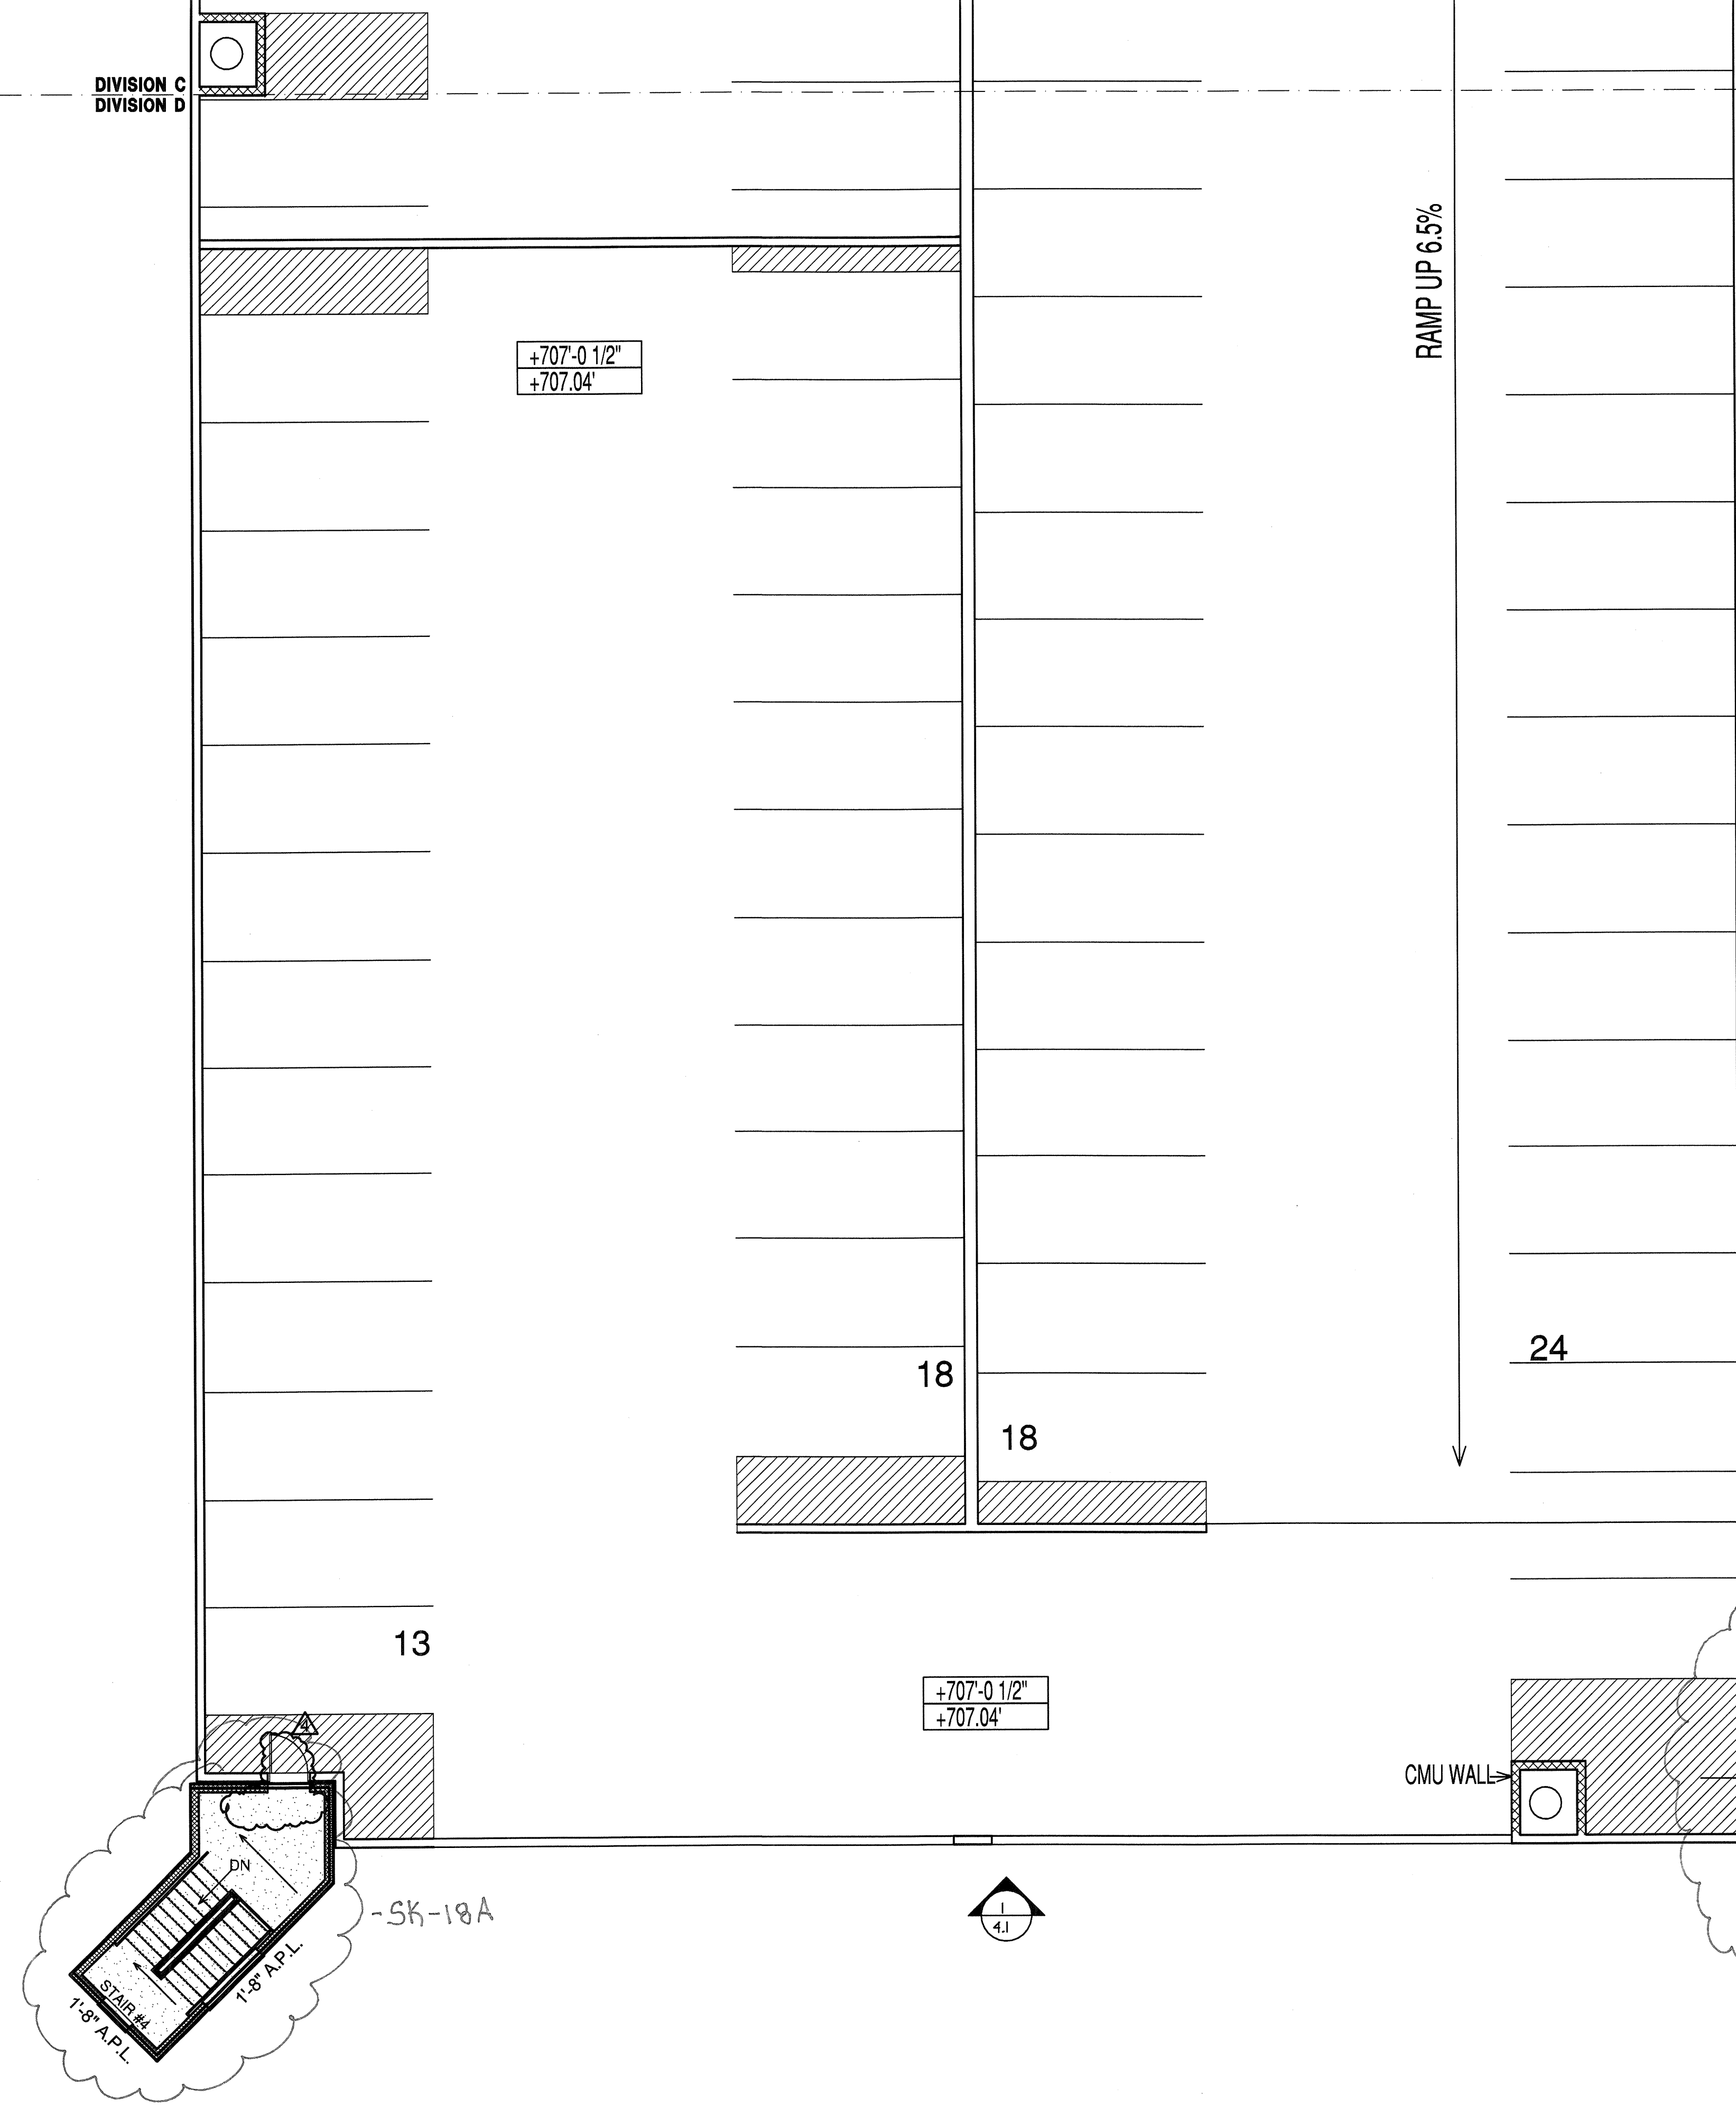

DIVISION 'D' ROOF PLAN AT GARAGE STAIR

1/8" = 1'-0"

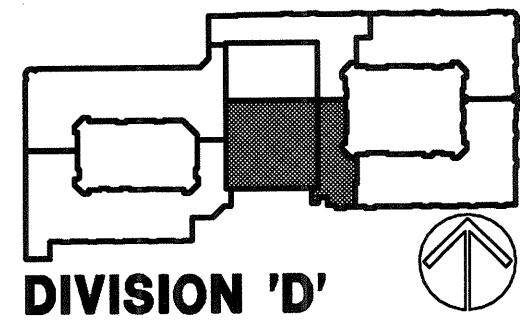

DIVISION 'D'

**BGO**  
architects  
4144 N. Central Expy.  
Suite 855  
Dallas, TX 75204  
214.520.8878  
bgoarchitects.com

CONSTRUCTION ISSUE  
10-17-2011

REVISIONS

▲	GARAGE REVISIONS PER SHOP DWGS	01-03-2012
---	--------------------------------	------------

**KELLER SPRINGS LOFTS**  
LOFT APARTMENTS IN ADDISON, TEXAS

01-03-2012

DATE  
08-05-2011

PROJECT  
11129

SHEET NUMBER  
**3.7D**  
BLDG PLAN 'D'

COPYRIGHT © Beeler Guest Owens Architects ALL RIGHTS RESERVED