



4 EAST ELEVATION
SCALE: 1"=20'-0"

REFER TO SHEET 4.5

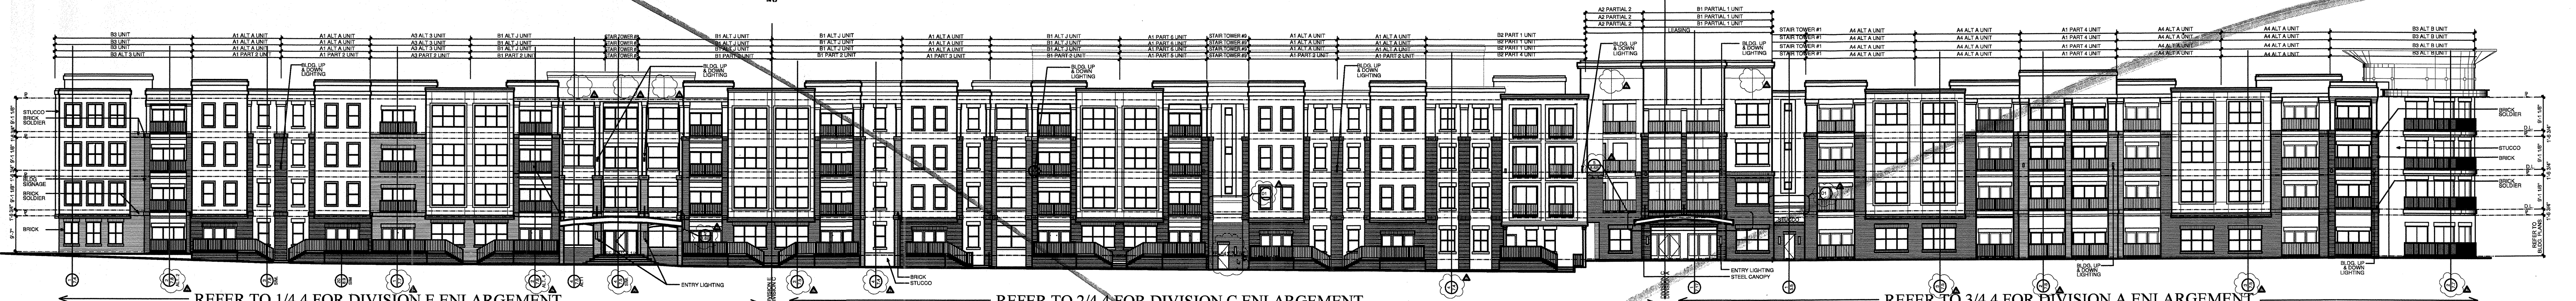


3 NORTH ELEVATION
SCALE: 1"=20'-0"

REFER TO SHEET 4.4

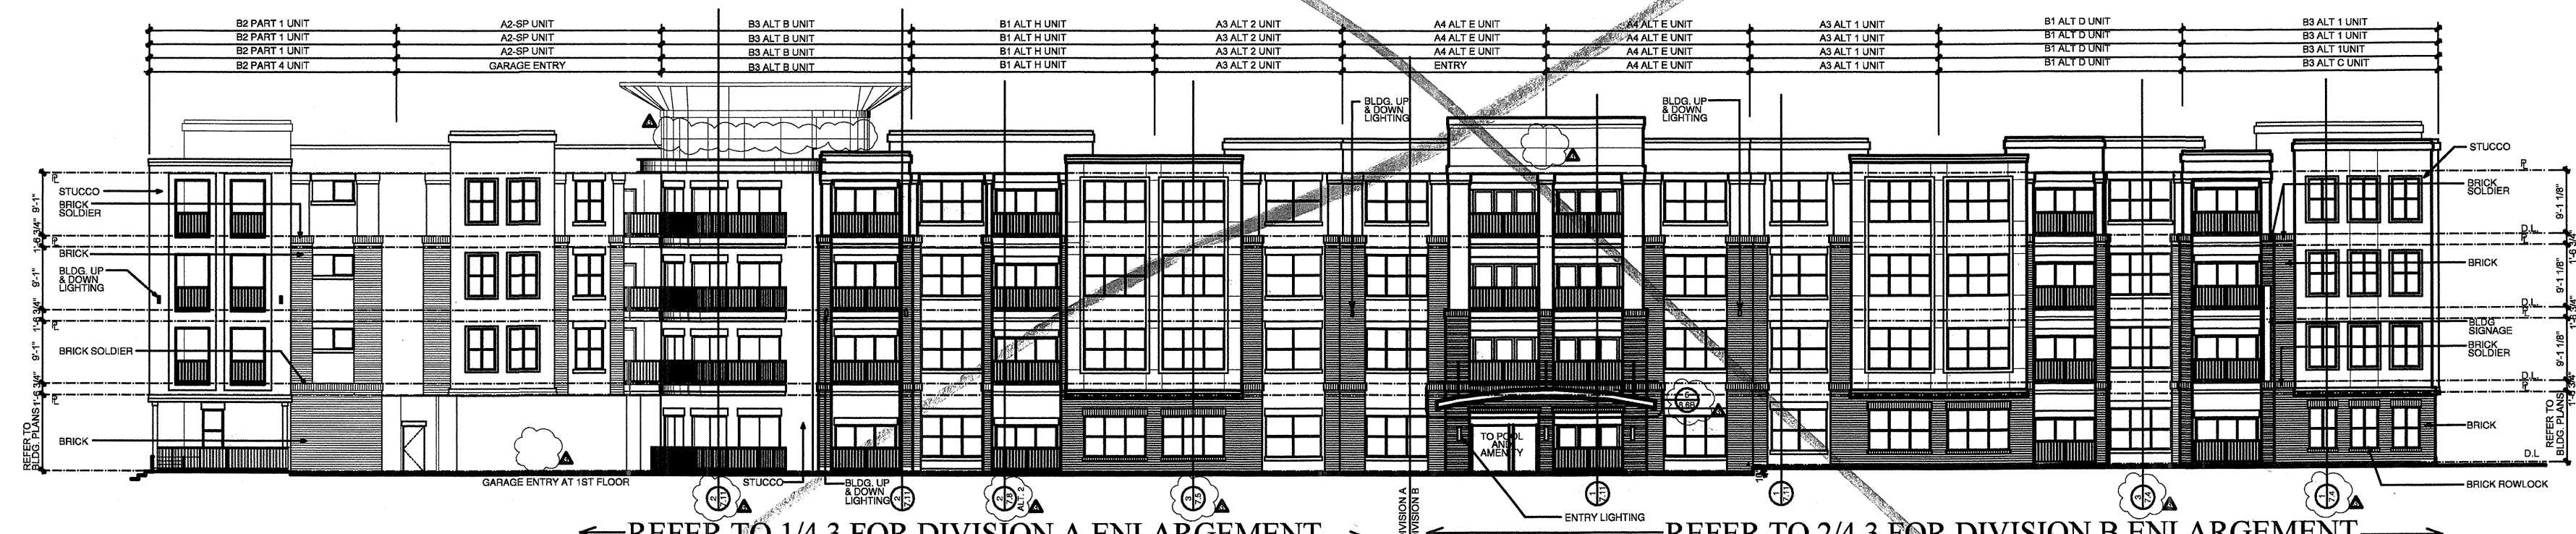

2 WEST ELEVATION
SCALE: 1"=20'-0"

REFER TO SHEET 4.3

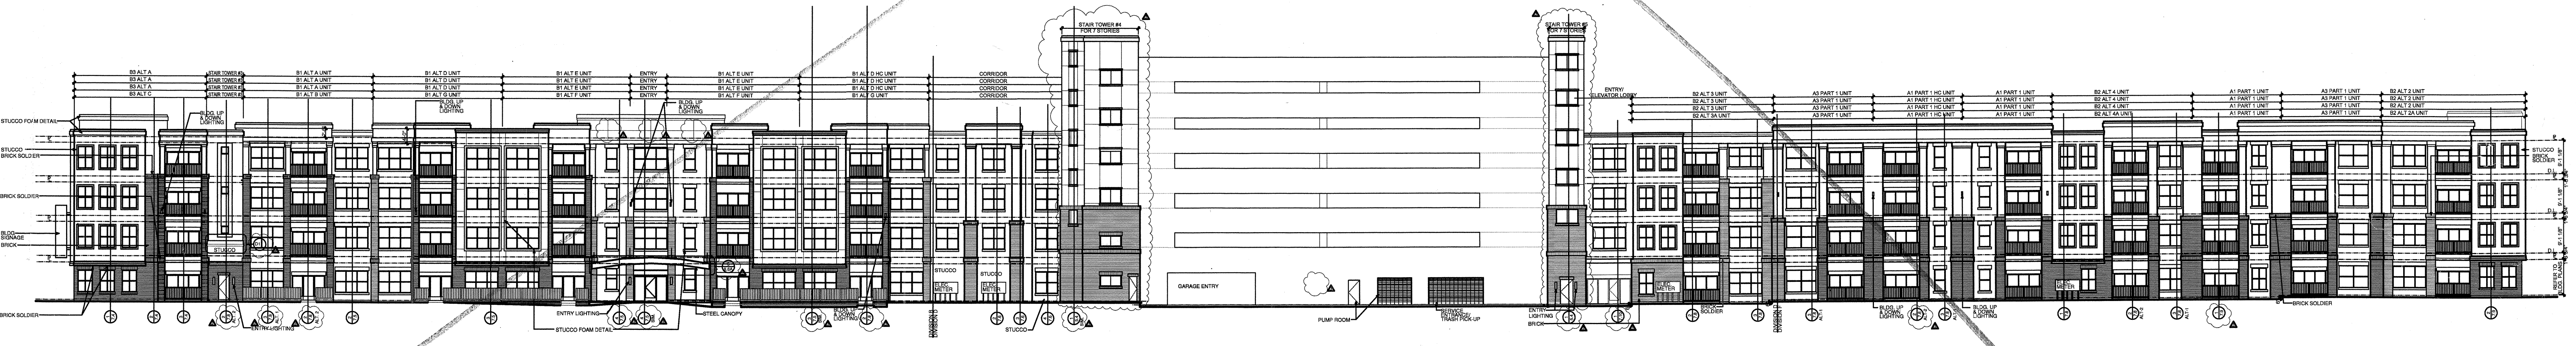

1 SOUTH ELEVATION
SCALE: 1"=20'-0"

REFER TO SHEET 4.2

BGO
architects
4144 N. Central Expy.
Suite 855
Dallas, TX 75204
214.520.8878
bgoarchitects.com

CONSTRUCTION ISSUE
10-17-2011

REVISIONS
COORDINATION 10-17-2011

KELLER SPRINGS LOFTS
LOFT APARTMENTS IN ADDISON, TEXAS

10-17-2011

DATE
08-05-2011
PROJECT
11129

SHEET NUMBER
4.1
ELEVATIONS