


4 EAST ELEVATION
SCALE: 1"=20'-0"

REFER TO SHEET 4.5




3 NORTH ELEVATION
SCALE: 1"=20'-0"

REFER TO SHEET 4.4

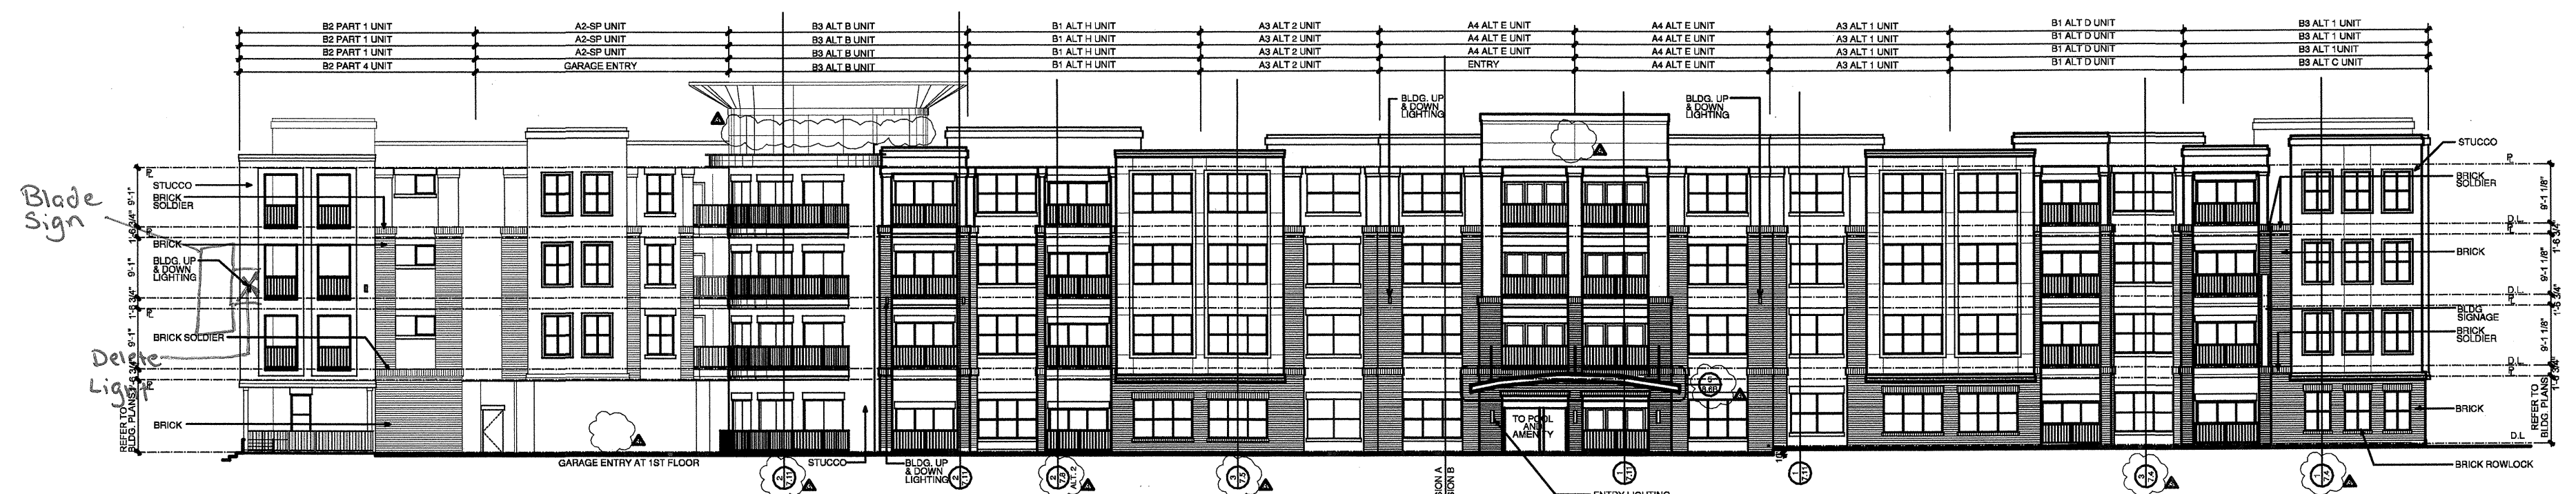

2 WEST ELEVATION
SCALE: 1"=20'-0"

REFER TO SHEET 4.3

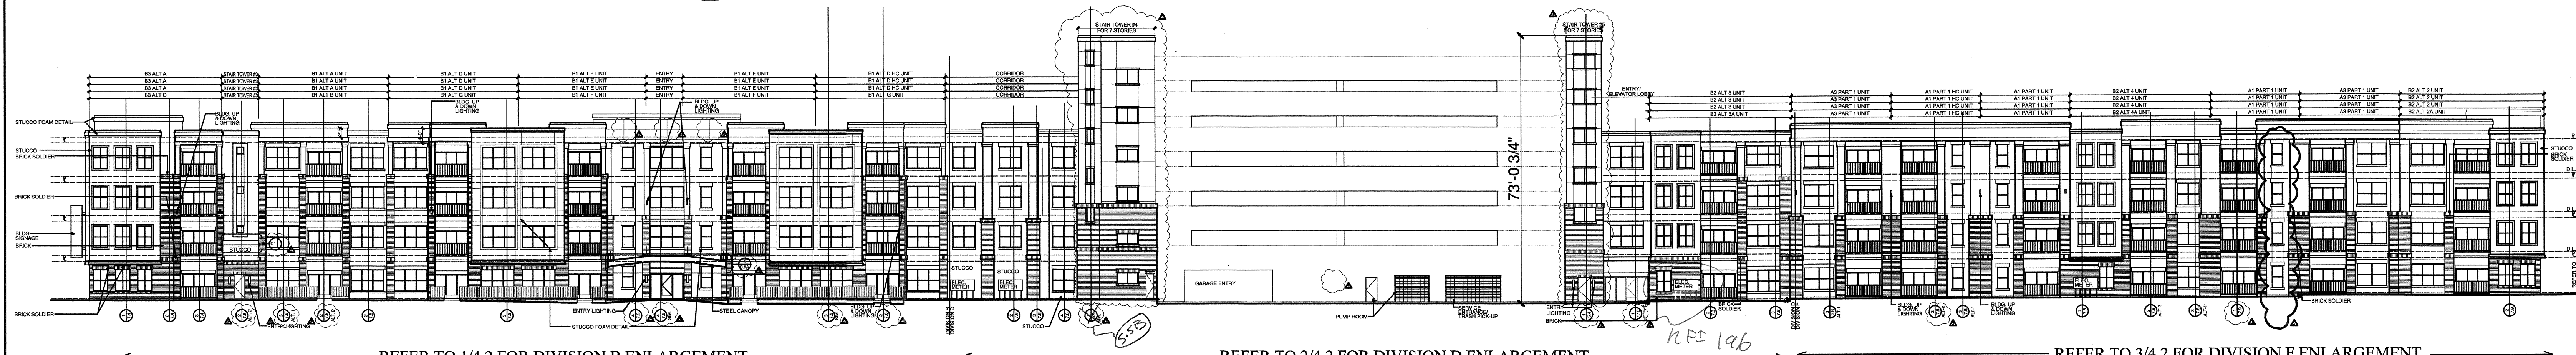

1 SOUTH ELEVATION
SCALE: 1"=20'-0"

REFER TO SHEET 4.2

BGO
architects
4144 N. Central Exp.,
Suite 855
Dallas, TX 75204
214.520.8878
bgoarchitects.com

CONSTRUCTION ISSUE
10-17-2011

REVISIONS	
Δ	COORDINATION 10-17-2011
Δ	COORDINATION 02-29-2012

KELLER SPRINGS LOFTS
LOFT APARTMENTS IN ADDISON, TEXAS



DATE	08-05-2011
PROJECT	11129

SHEET NUMBER	4.1
ELEVATIONS	