





3 DIVISION 'F' SOUTH ELEVATION
SCALE: 3/32" = 1'-0"

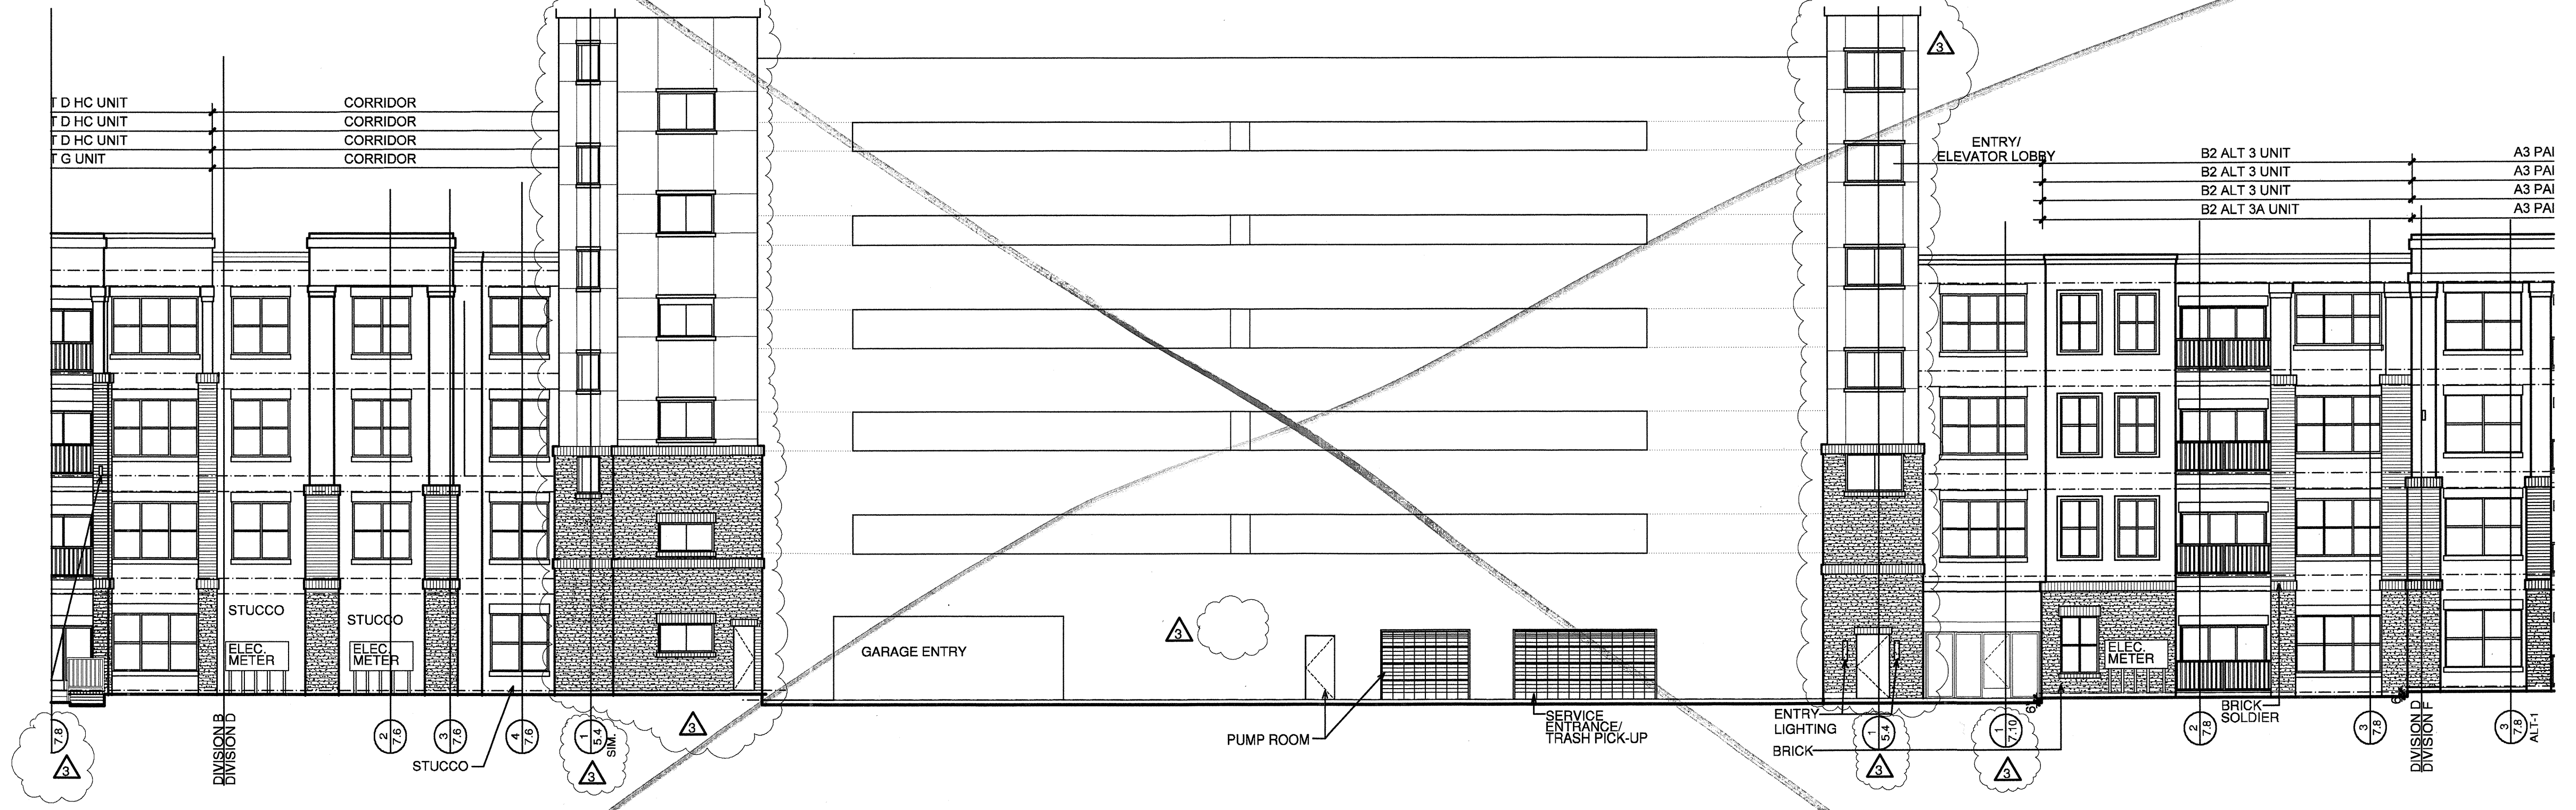


2 DIVISION 'D' SOUTH ELEVATION
SCALE: 3/32" = 1'-0"

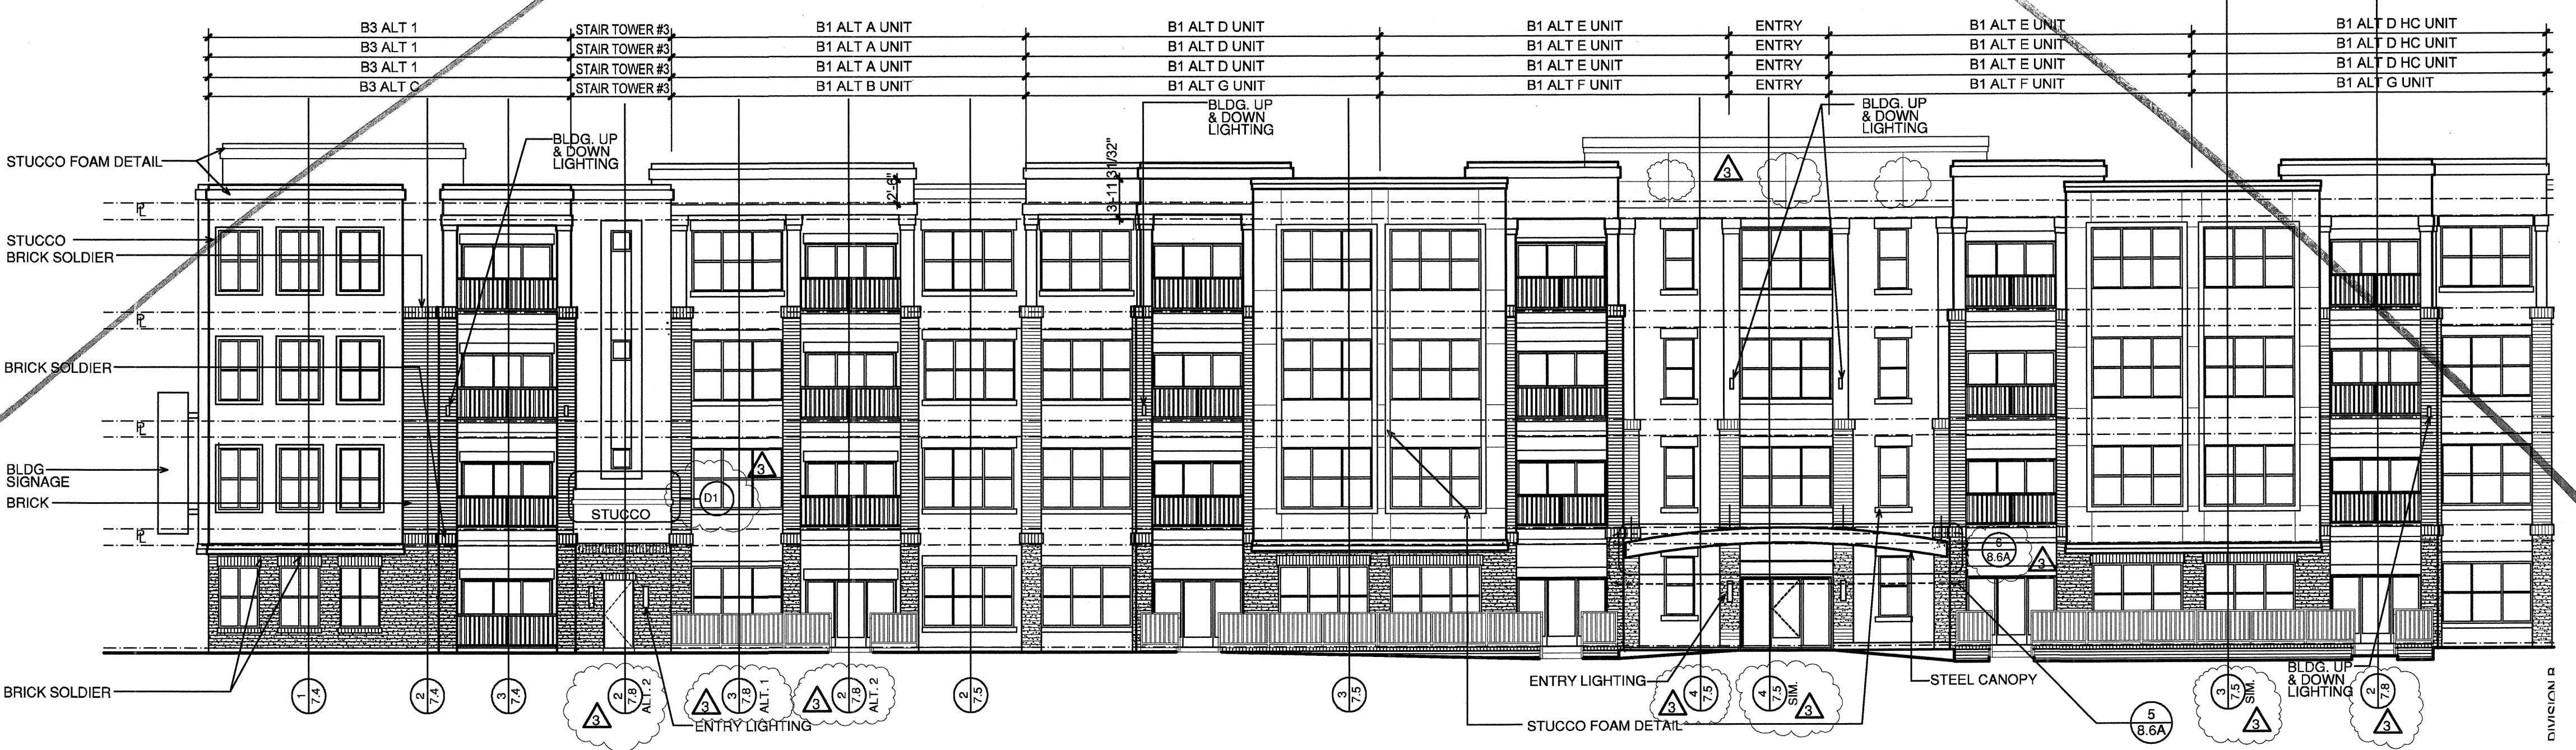

1 DIVISION 'B' SOUTH ELEVATION
SCALE: 3/32" = 1'-0"

HATCH LEGEND:

[Hatched Pattern]	BRICK #1
[Hatched Pattern]	BRICK #2

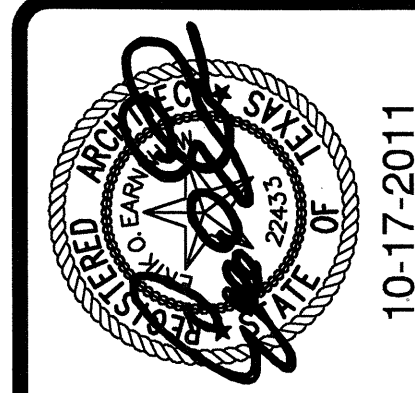

10-17-2011

REVISIONS

COORDINATION 10-17-2011

KELLER SPRINGS LOFTS

LOFT APARTMENTS IN ADDISON, TEXAS

CONSTRUCTION ISSUE
10-17-2011



4144 N. Central Expy.
Suite B55
Dallas, TX 75204
214.520.8878
bgoarchitects.com

DATE

08-05-2011

PROJECT

11129

SHEET NUMBER

4.2

ELEVATIONS

COPYRIGHT © Beeler Guest Owners Architects ALL RIGHTS RESERVED