



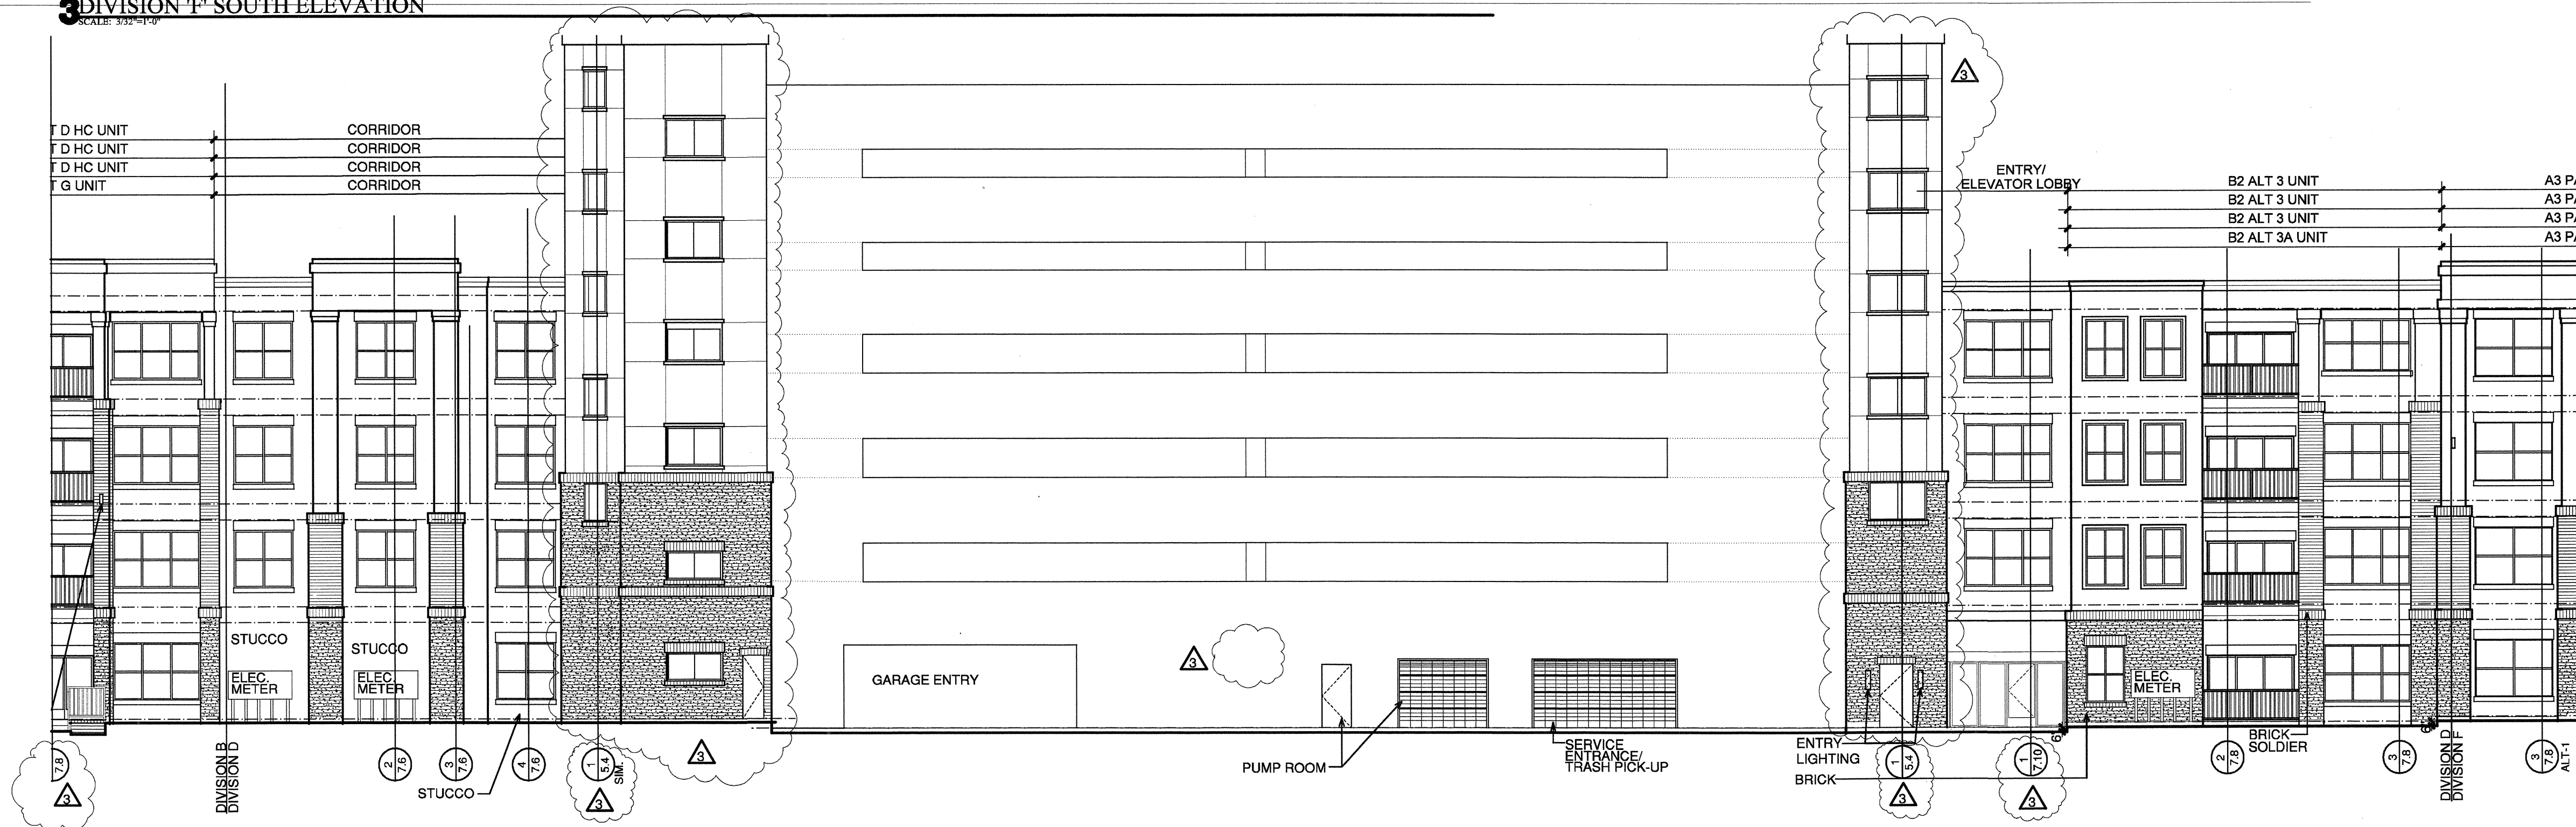



3 DIVISION 'F' SOUTH ELEVATION
SCALE: 3/32"=1'-0"

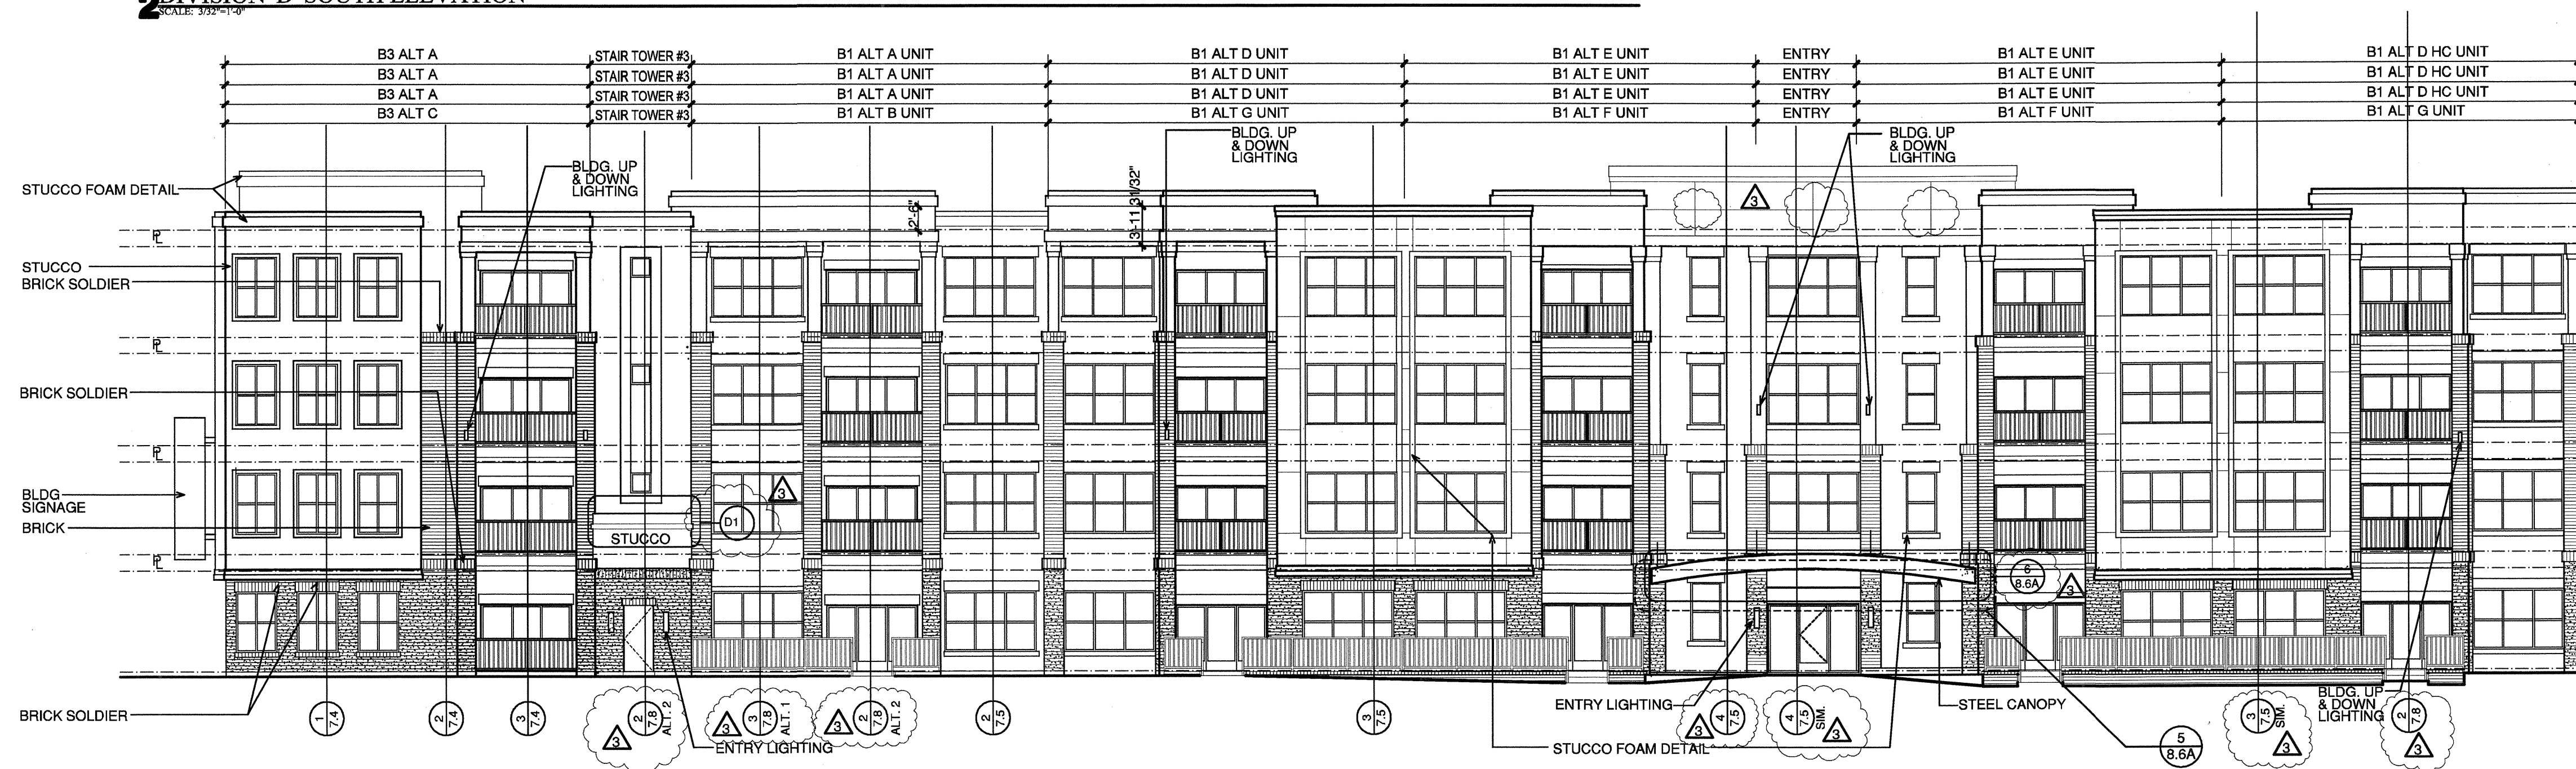

2 DIVISION 'D' SOUTH ELEVATION
SCALE: 3/32"=1'-0"



1 DIVISION 'B' SOUTH ELEVATION
SCALE: 3/32"=1'-0"

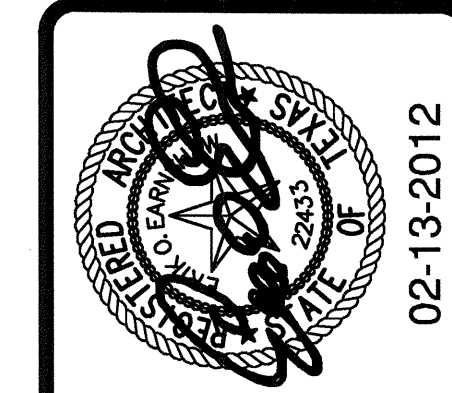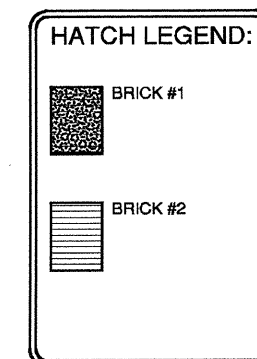

02-13-2012

REVISIONS

- △ COORDINATION 10-17-2011
- △ COORDINATION 02-29-2012

KELLER SPRINGS LOFTS

LOFT APARTMENTS IN ADDISON, TEXAS

CONSTRUCTION ISSUE
10-17-2011



4144 N. Central Expy.
Suite 855
Dallas, TX 75204
214.520.8878
bgoarchitects.com

DATE
08-05-2011

PROJECT
11129

SHEET NUMBER

4.2
ELEVATIONS

COPYRIGHT © Beeler Owens Architects ALL RIGHTS RESERVED