

10-17-2011

REVISIONS

COORDINATION 10-17-2011

KELLER SPRINGS LOFTS

LOFT APARTMENTS IN ADDISON, TEXAS

CONSTRUCTION ISSUE
10-17-2011



4144 N. Central Expy.
Suite 855
Dallas, TX 75204
214.520.6878
bgoarchitects.com

DATE

08-05-2011


PROJECT

11129

SHEET NUMBER


4.3

ELEVATIONS

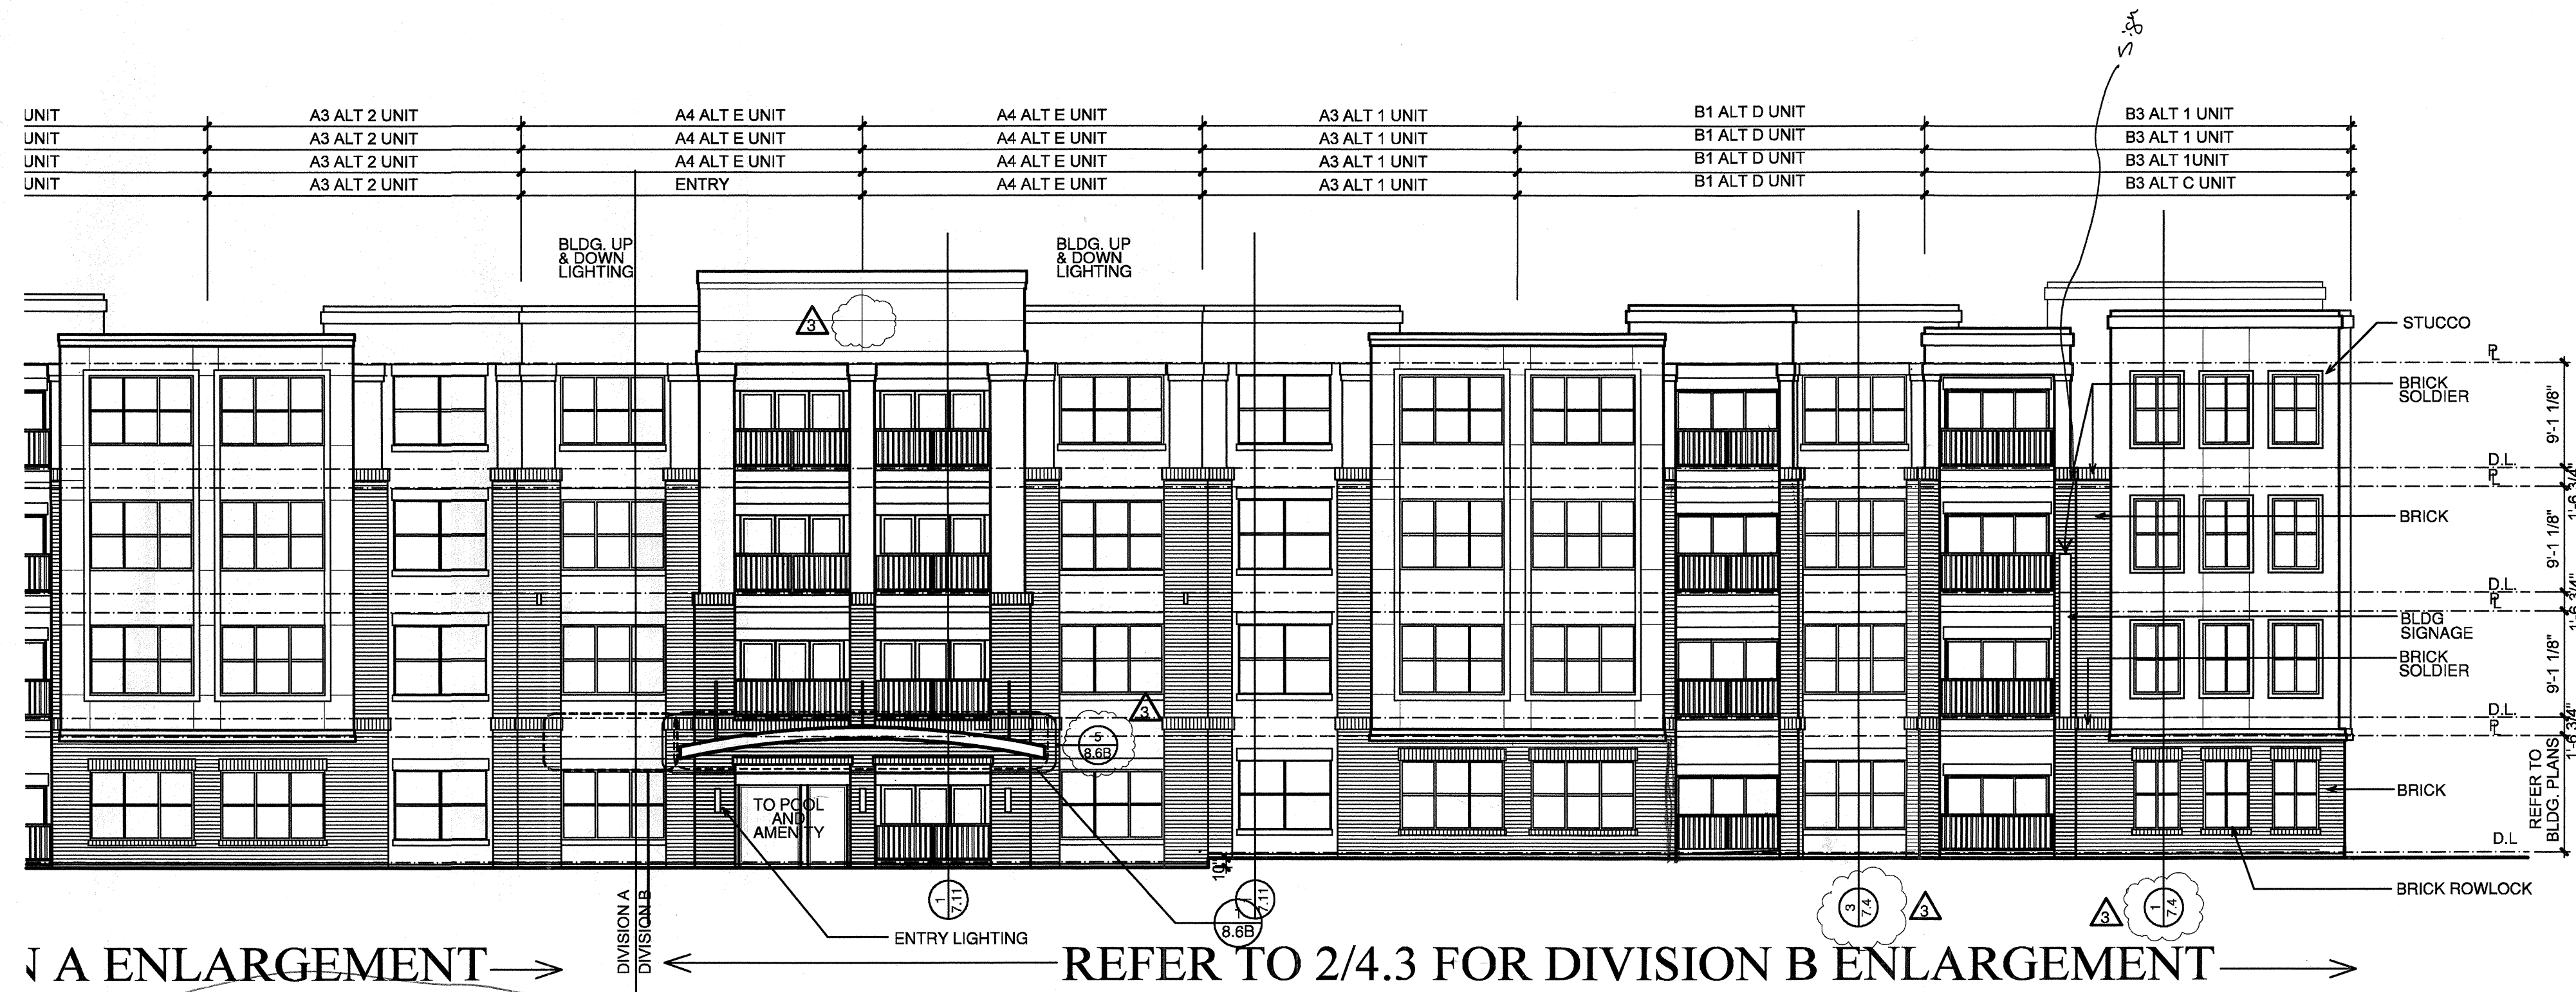

REFER TO 2/4.3 FOR DIVISION B ENLARGEMENT

2 DIVISION 'B' WEST ELEVATION NFI 210

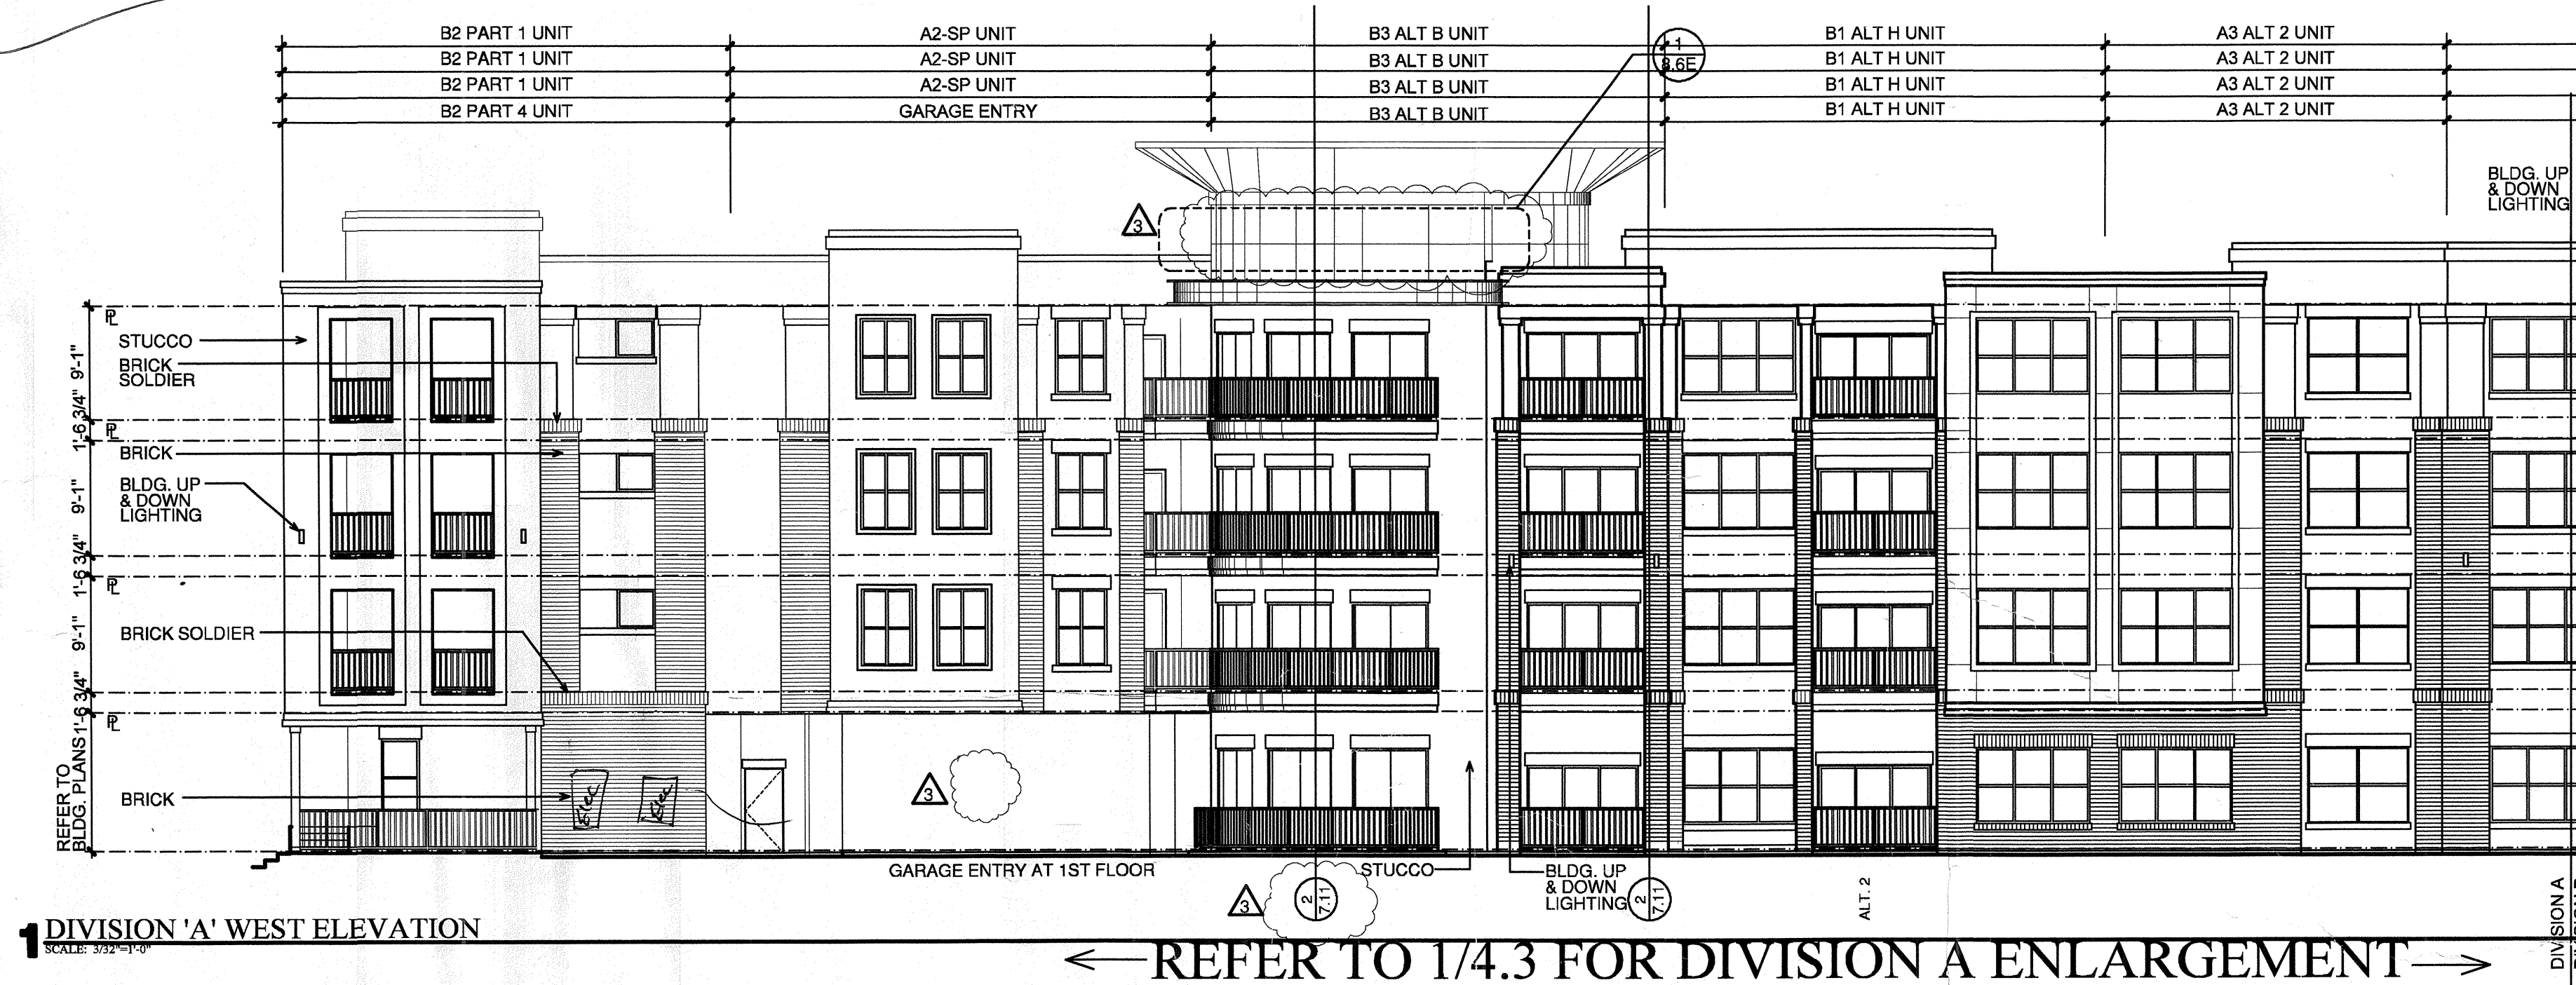

REFER TO 1/4.3 FOR DIVISION A ENLARGEMENT

1 DIVISION 'A' WEST ELEVATION

HATCH LEGEND:

	BRICK #1
	BRICK #2

COPYRIGHT © Beeler Guest Owens Architects ALL RIGHTS RESERVED