

10-17-2011

REVISIONS

COORDINATION 10-17-2011

KELLER SPRINGS LOFTS

LOFT APARTMENTS IN ADDISON, TEXAS

CONSTRUCTION ISSUE
10-17-2011



4144 N. Central Expy.
Suite 855
Dallas, TX 75204
214.520.8878
bgoarchitects.com

DATE

08-05-2011


PROJECT

11129

SHEET NUMBER

4.5

ELEVATIONS

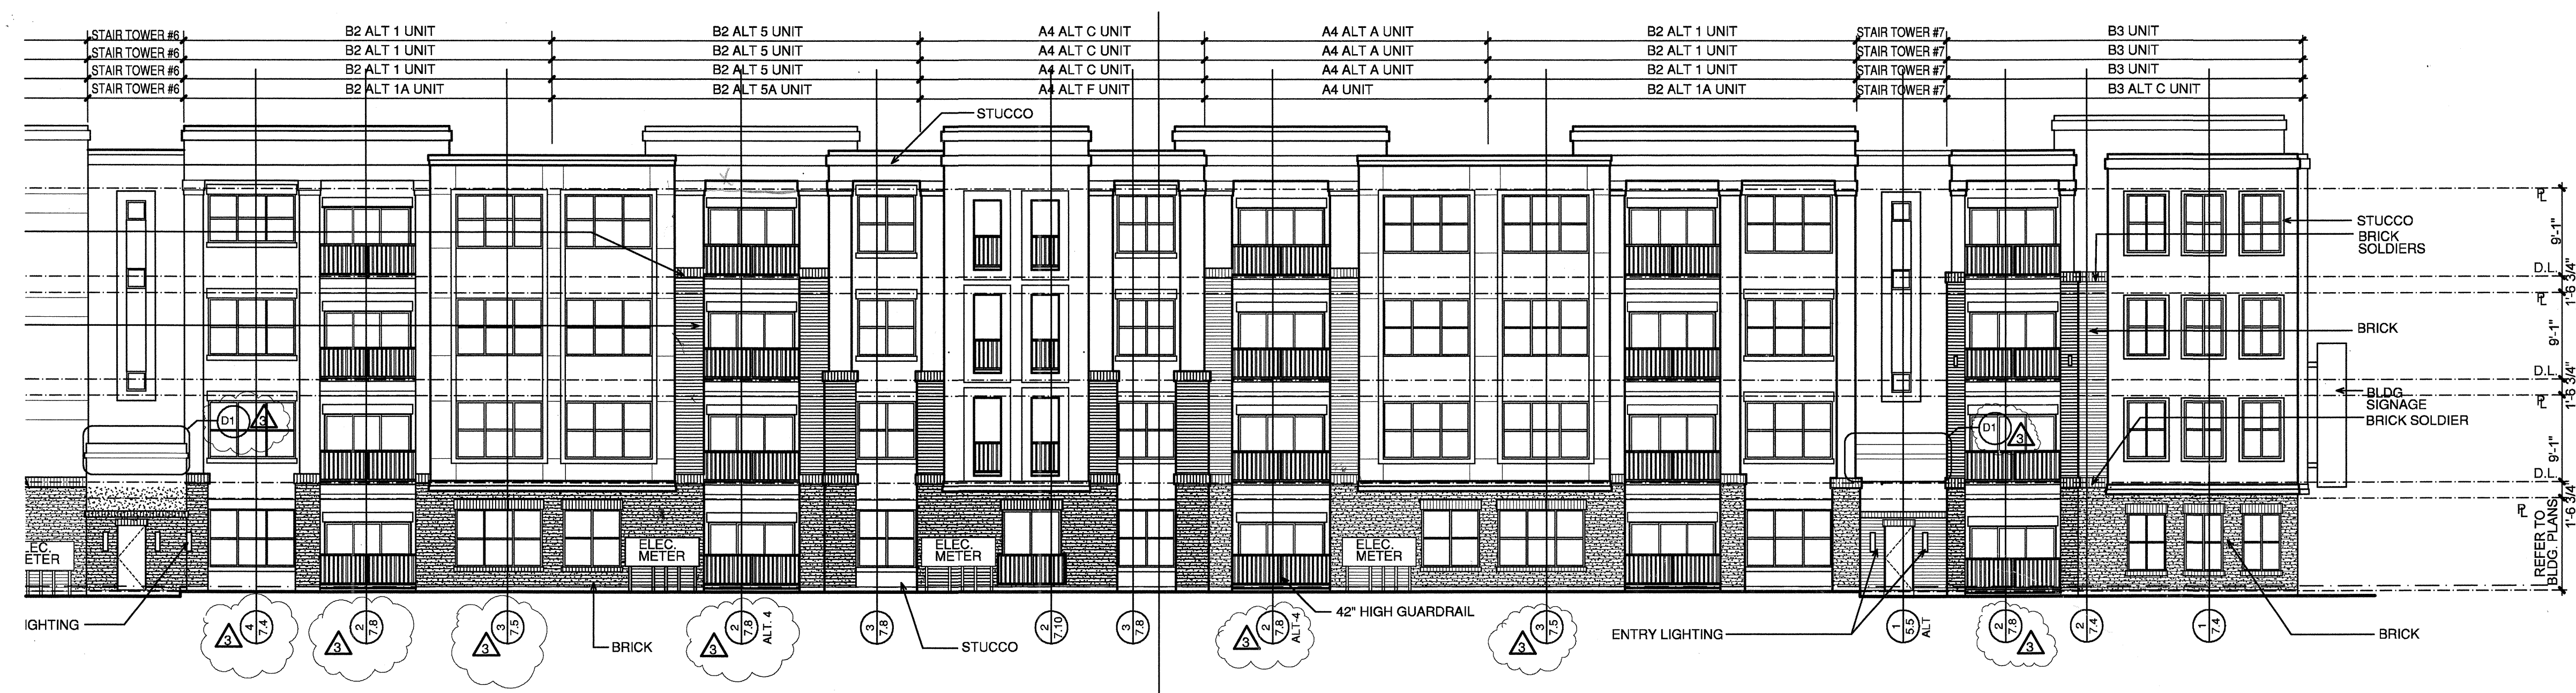

2 DIVISION 'A' EAST ELEVATION
SCALE: 3/8\"/>

HATCH LEGEND:

	BRICK #1
	BRICK #2

COPYRIGHT © Beeler Guest Owens Architects All Rights Reserved