



REVISIONS
COORDINATION
10-17-2011

RFI - 038

KELLER SPRINGS LOFTS

LOFT APARTMENTS IN ADDISON, TEXAS

CONSTRUCTION ISSUE
10-17-2011


BGO
architects
4144 N. Central Expy.
Suite 955
Dallas, TX 75204
214.520.8878
bgoarchitects.com

DATE
08-05-2011


PROJECT
11129

SHEET NUMBER


4.6
COURTYARD
ELEVATIONS

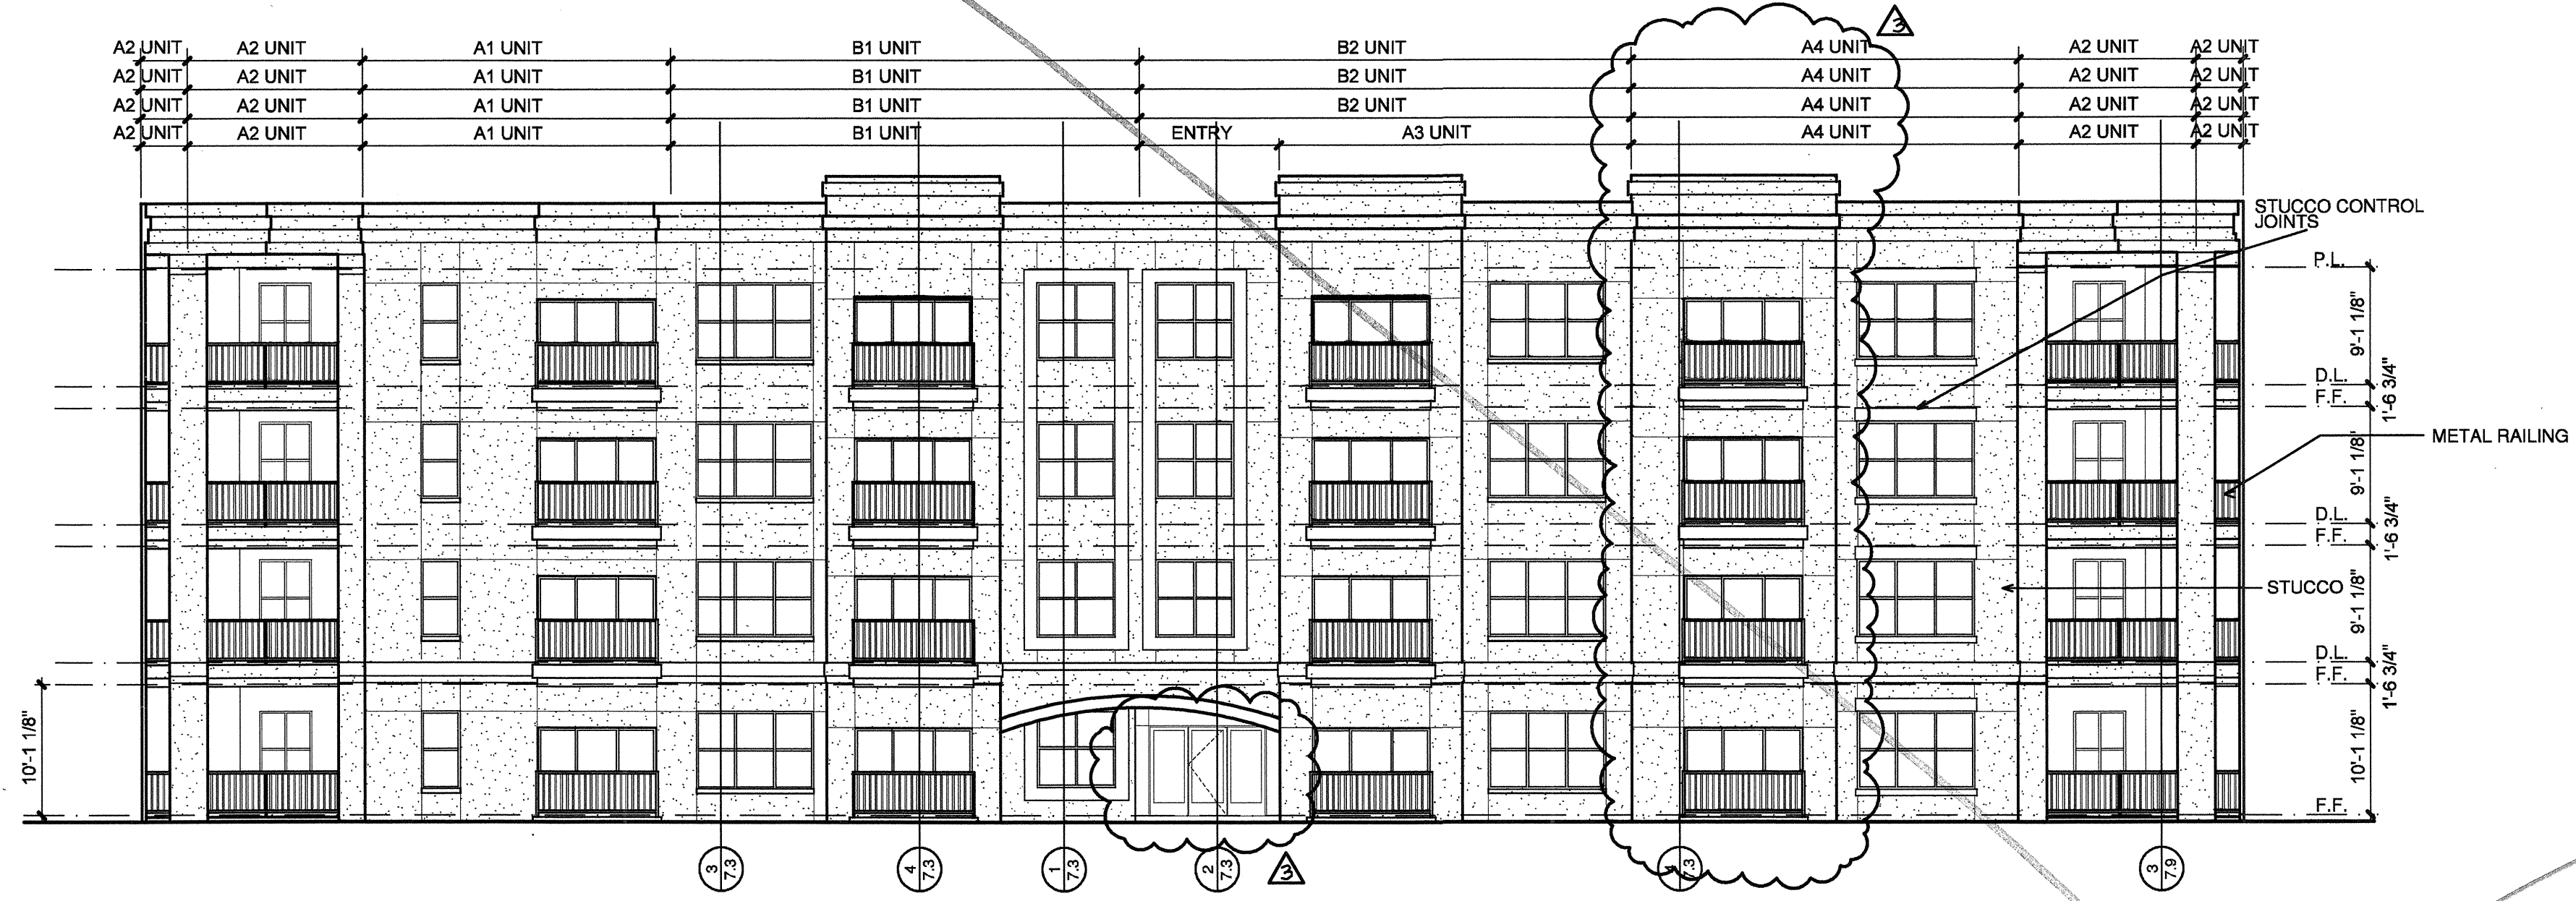


3 COURT ELEVATION
SCALE: 3/32"=1'-0"

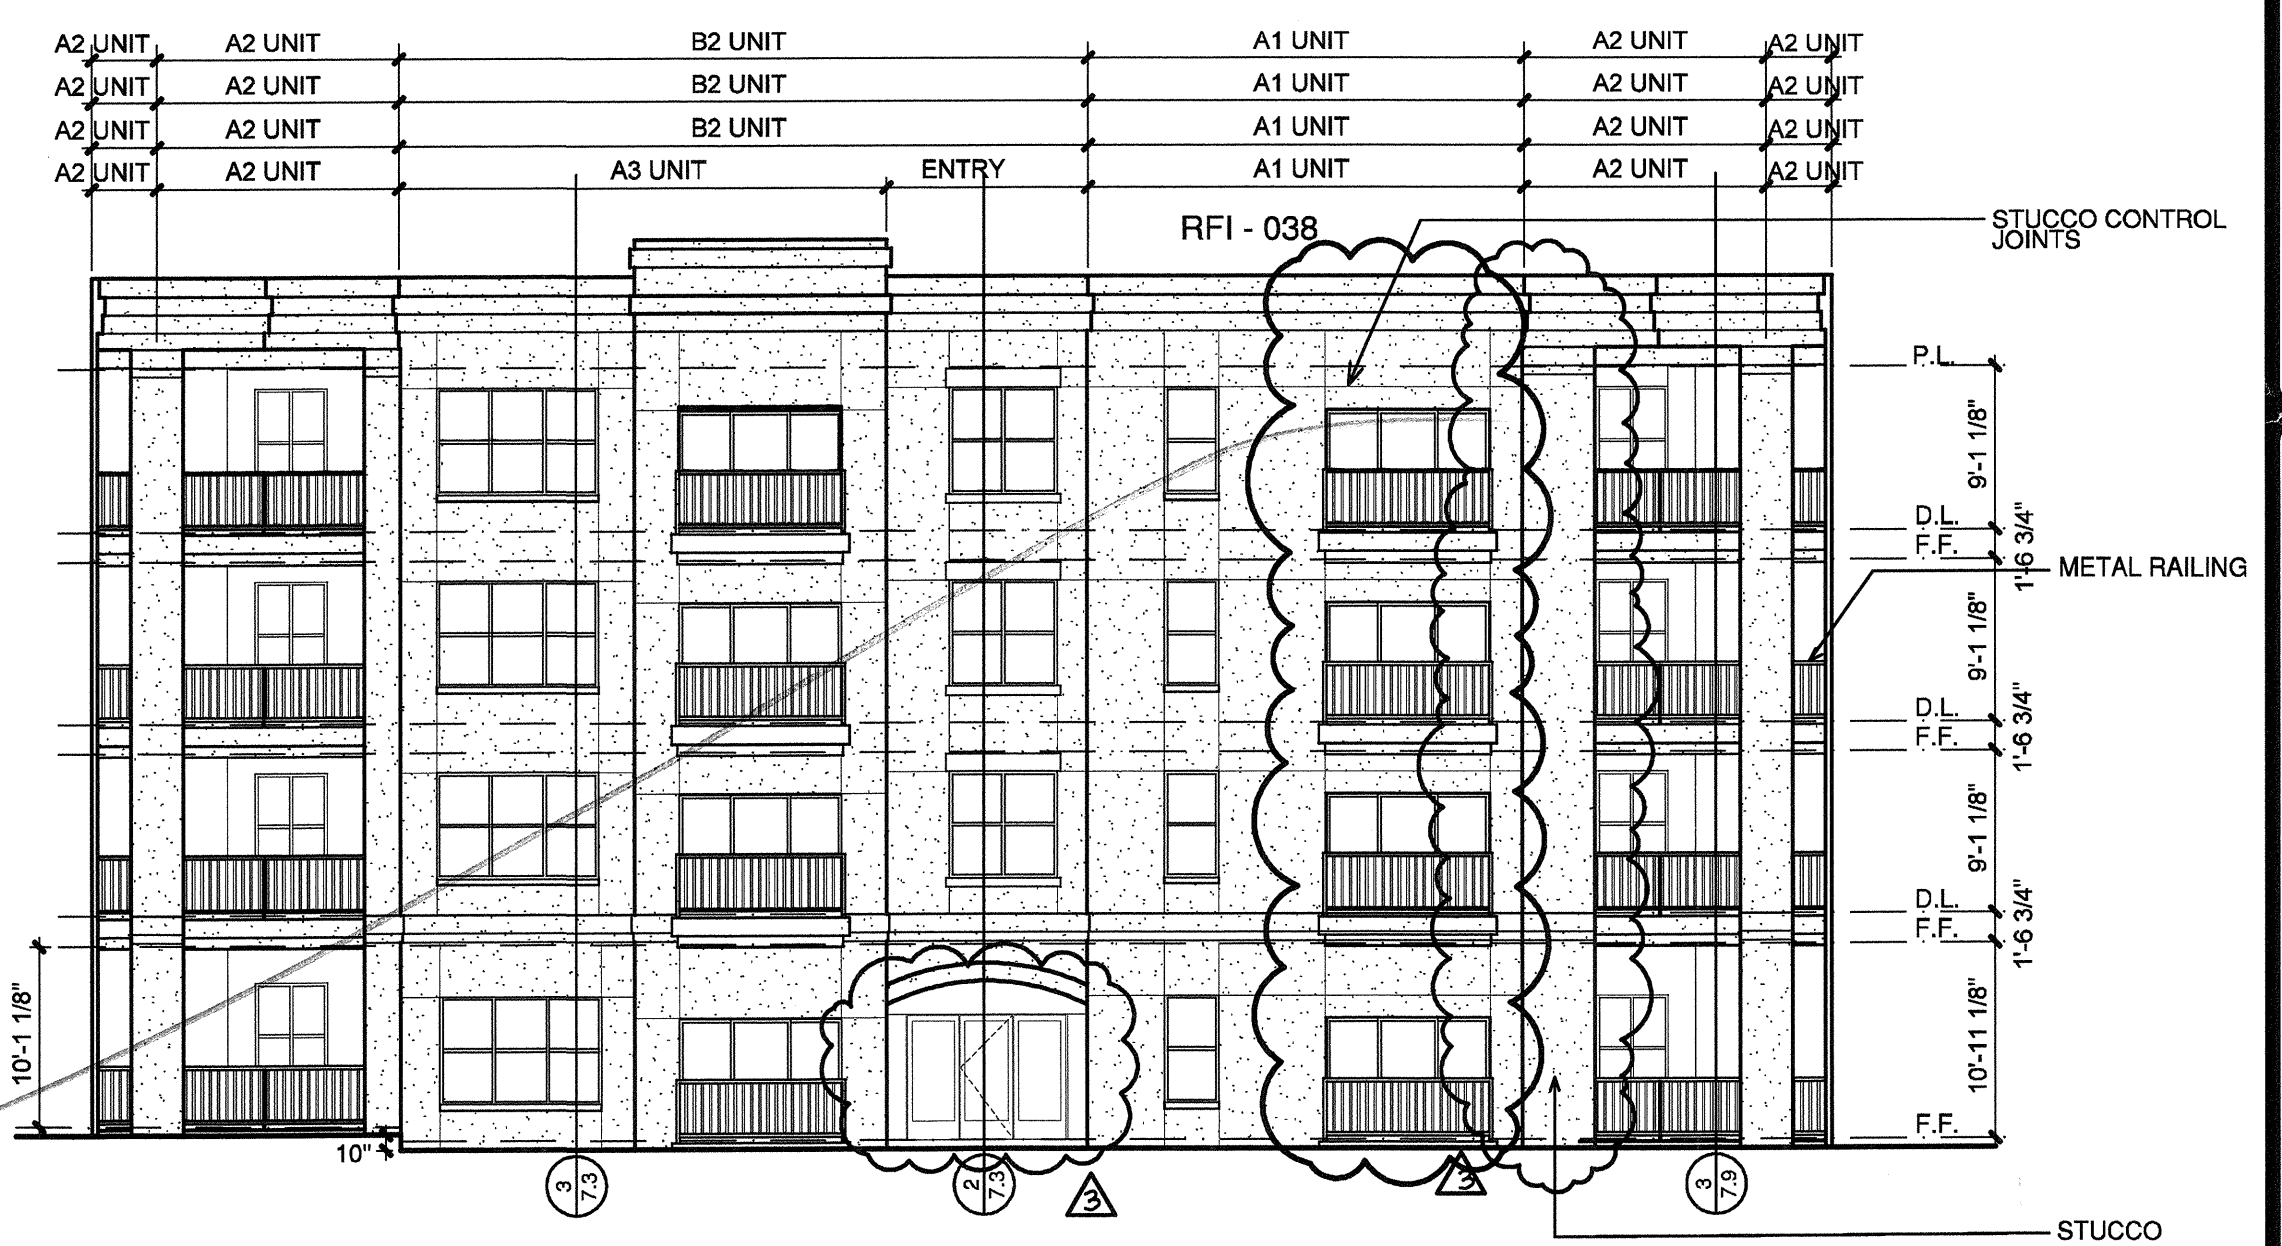

4 COURT ELEVATION
SCALE: 3/32"=1'-0"

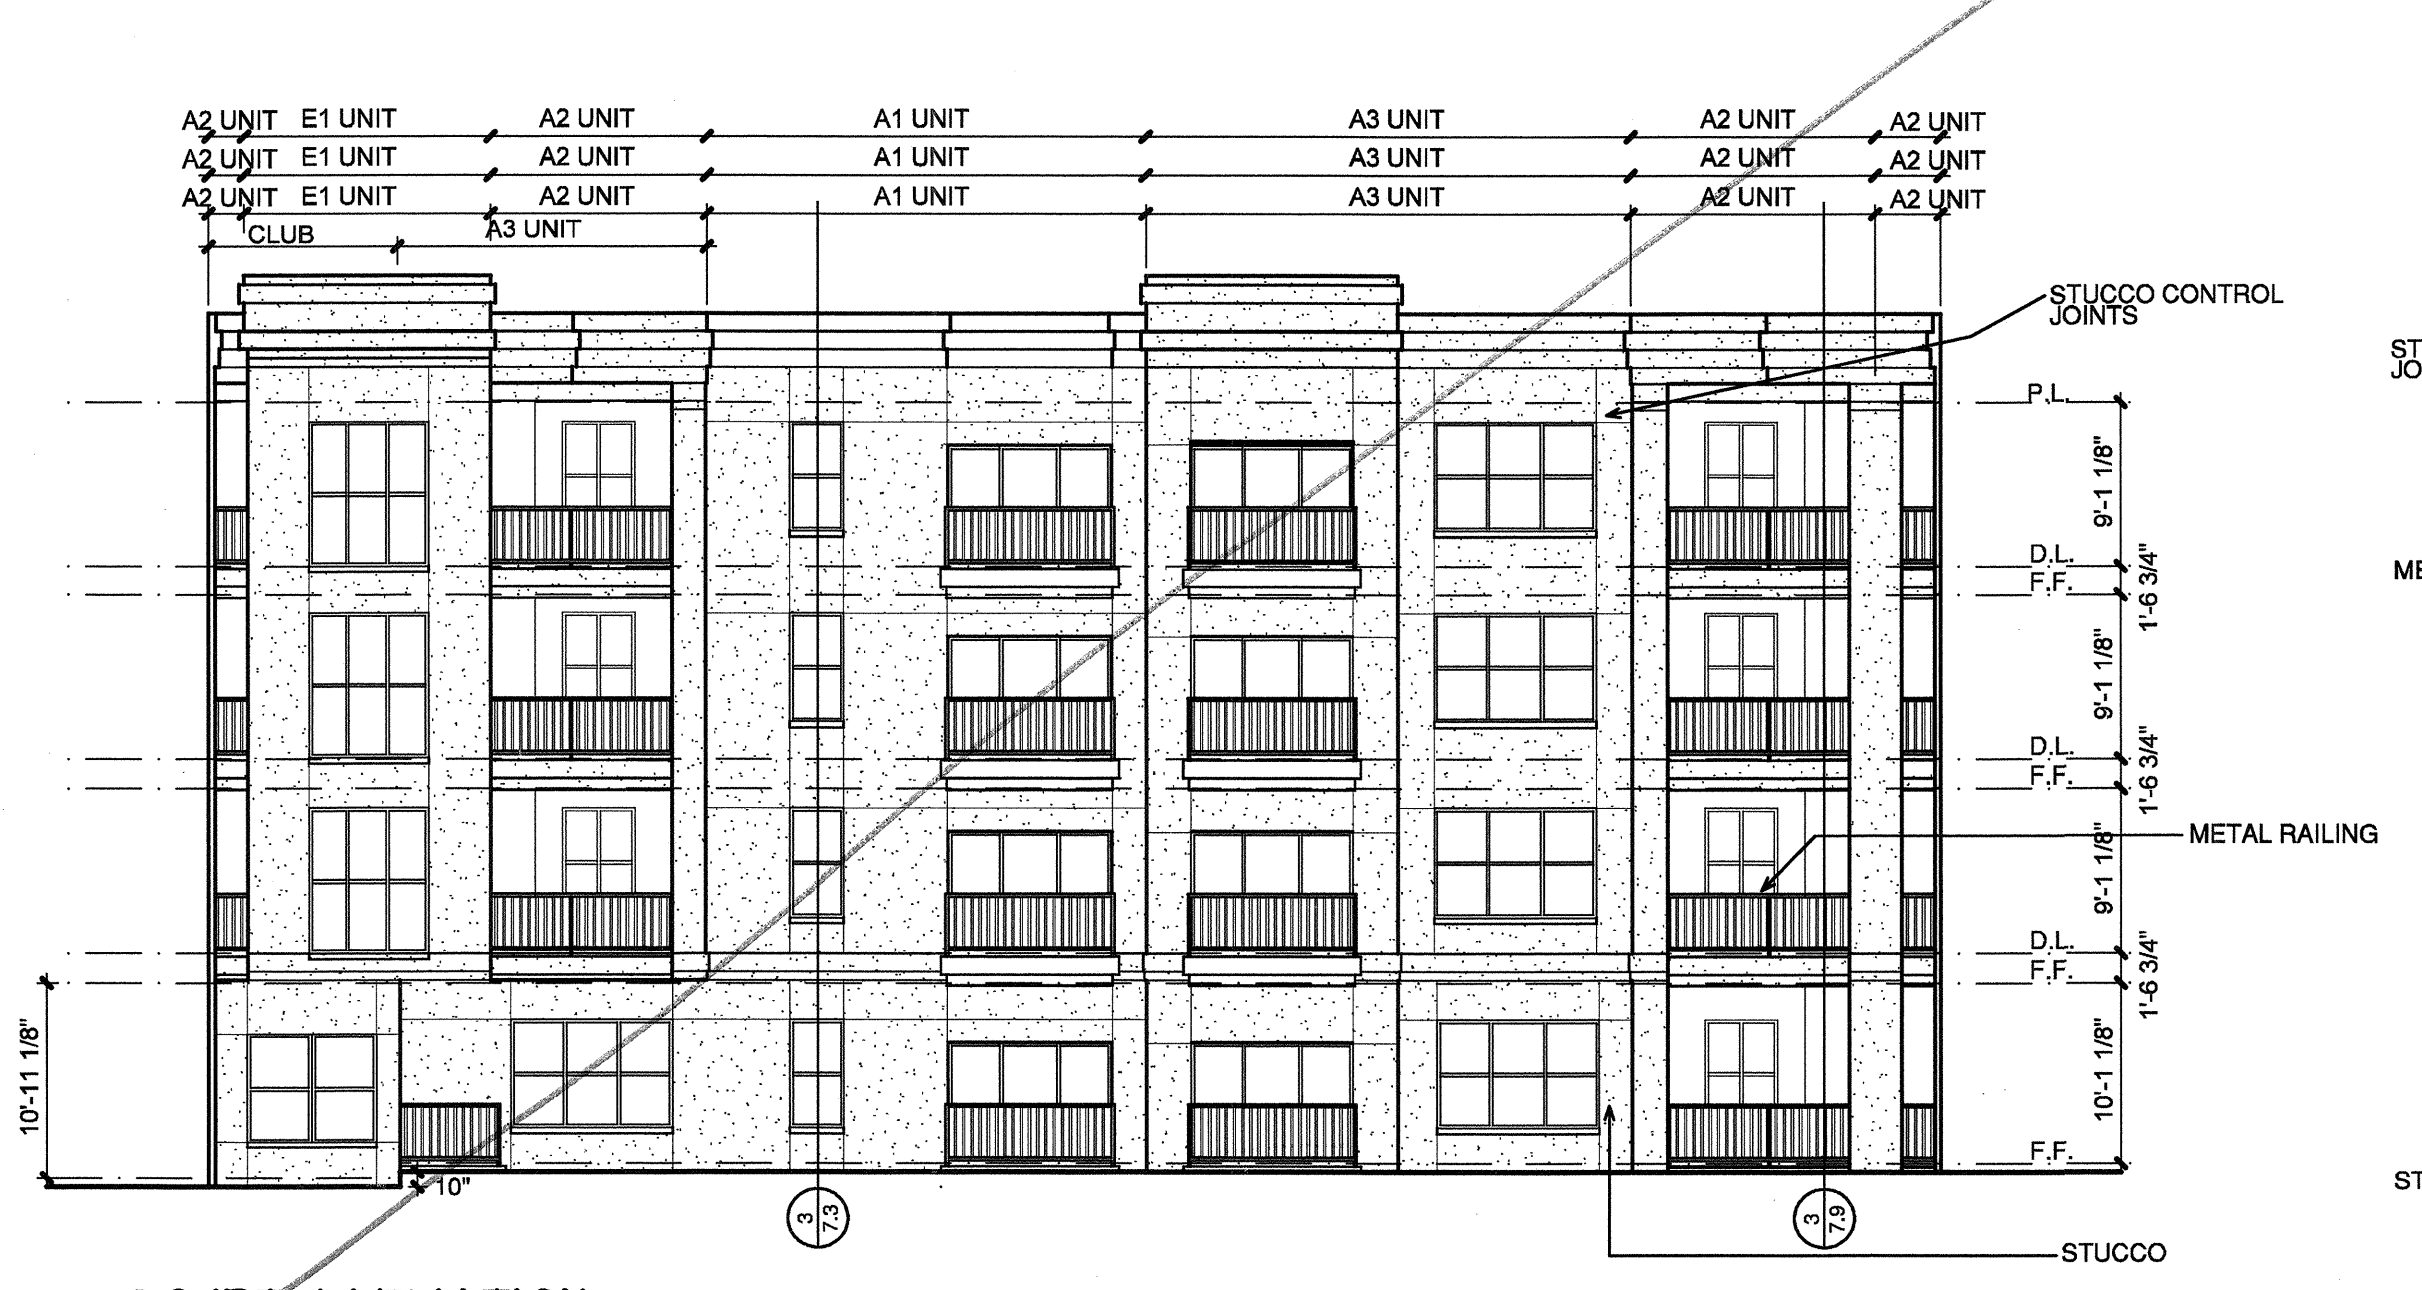

2 COURT ELEVATION
SCALE: 3/32"=1'-0"

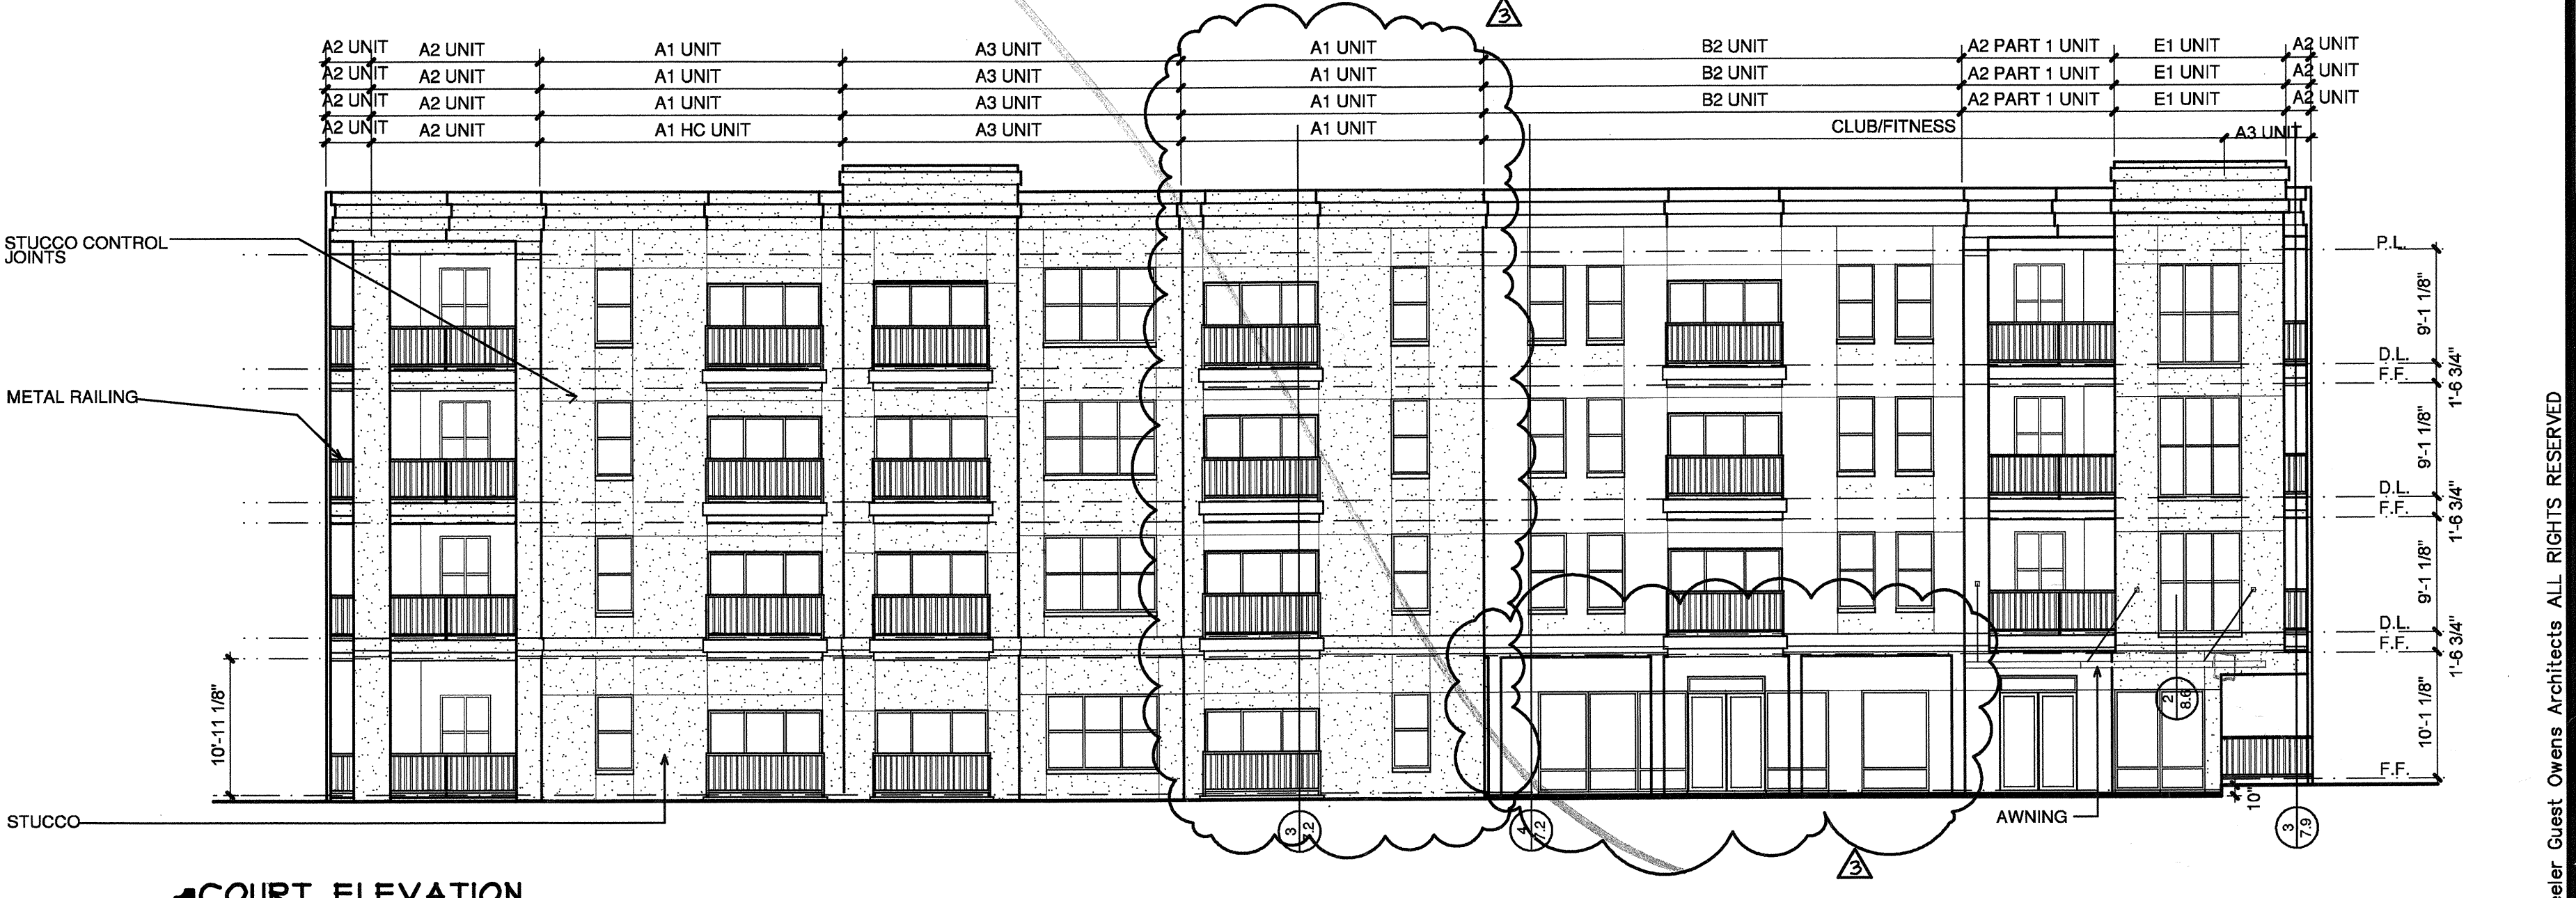

1 COURT ELEVATION
SCALE: 3/32"=1'-0"

COPYRIGHT © Beeler Guest Owens Architects ALL RIGHTS RESERVED