

REVISIONS
 Δ COORDINATION
 10-17-2011

KELLER SPRINGS LOFTS
 LOFT APARTMENTS IN ADDISON, TEXAS

CONSTRUCTION ISSUE
 10-17-2011


BGO
 architects
 4144 N. Central Expy.
 Suite 855
 Dallas, TX 75204
 214.520.8878
 bgoarchitects.com

DATE
 08-05-2011


PROJECT
 11129

SHEET NUMBER

4.6
 COURTYARD
 ELEVATIONS

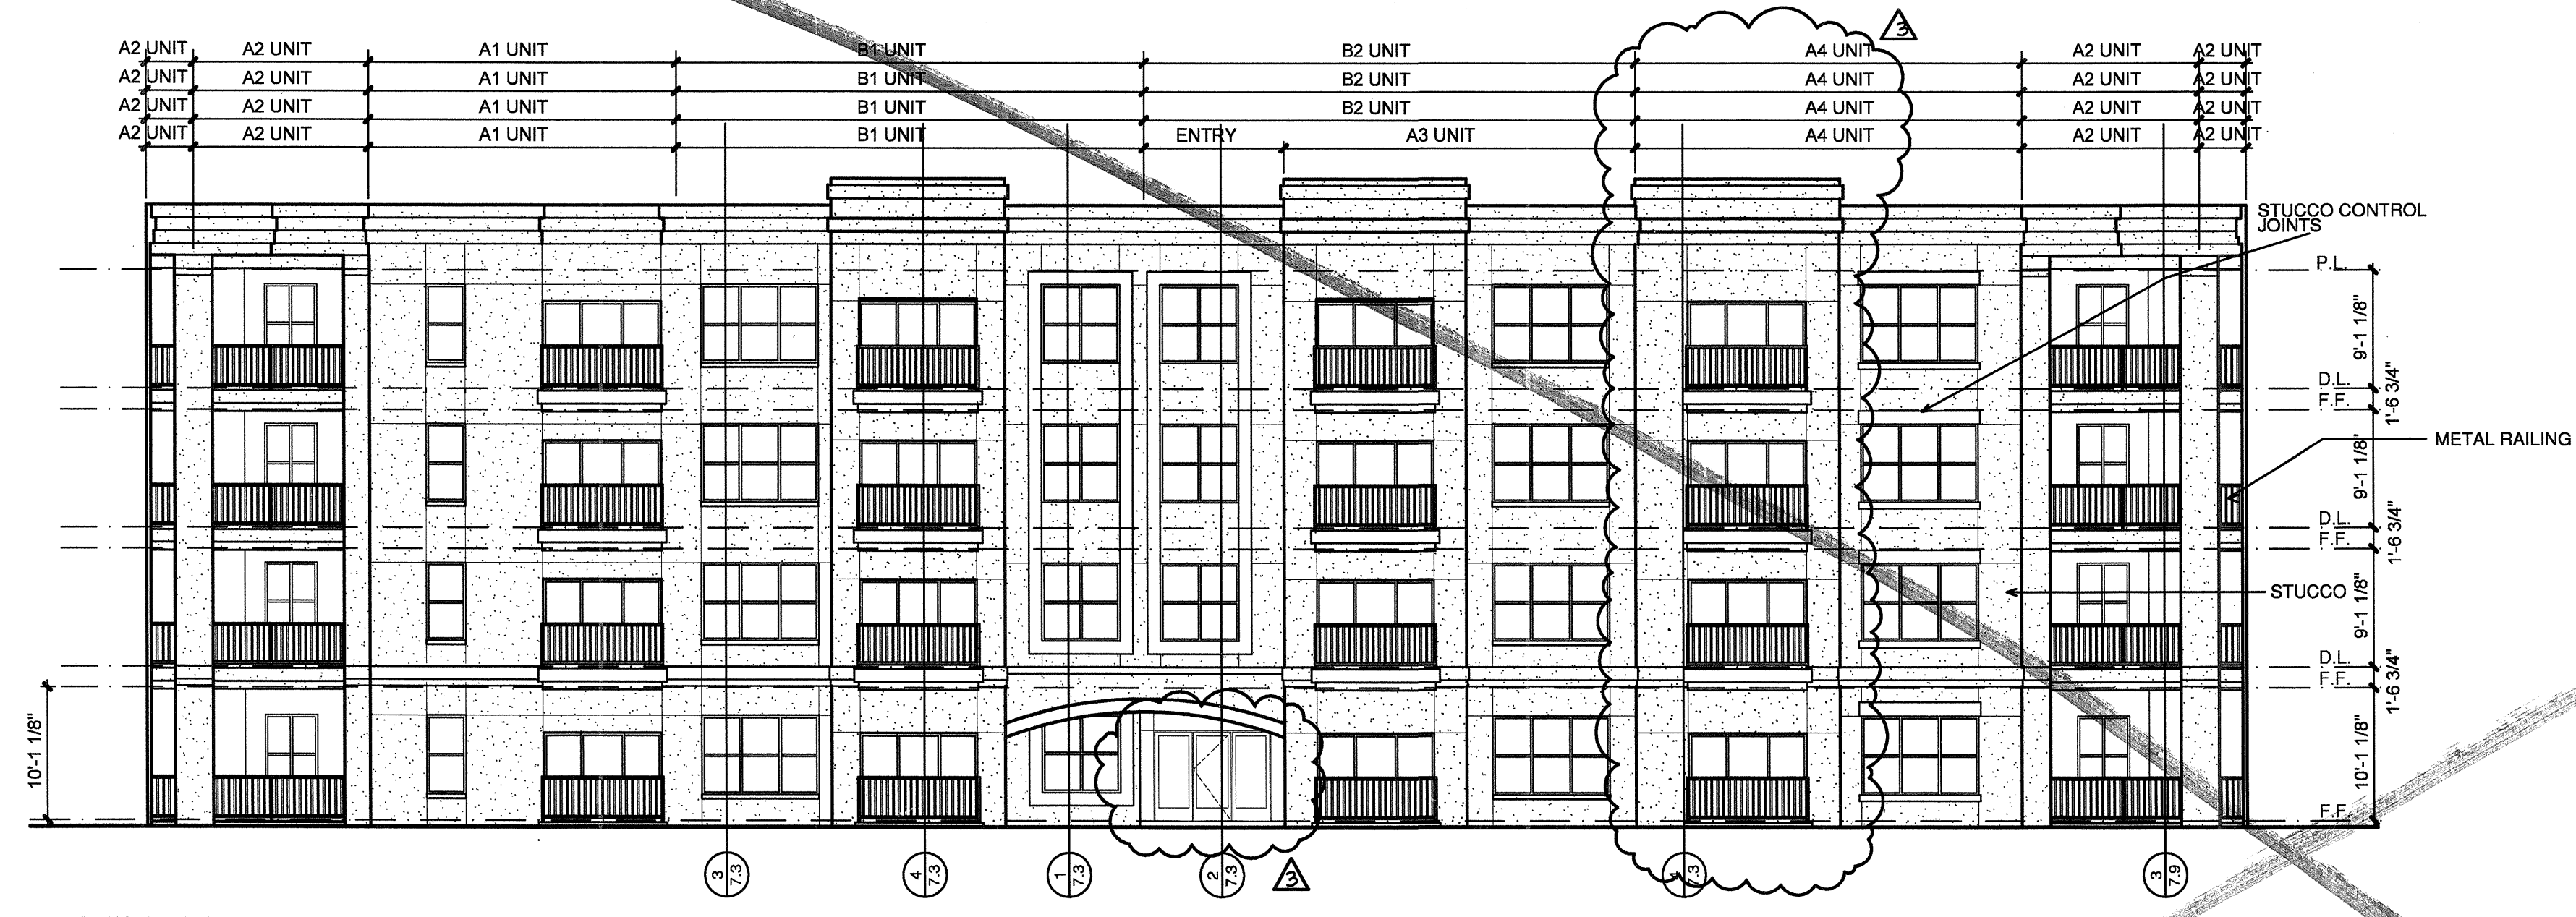


3 COURT ELEVATION
 SCALE: 3/32"=1'-0"

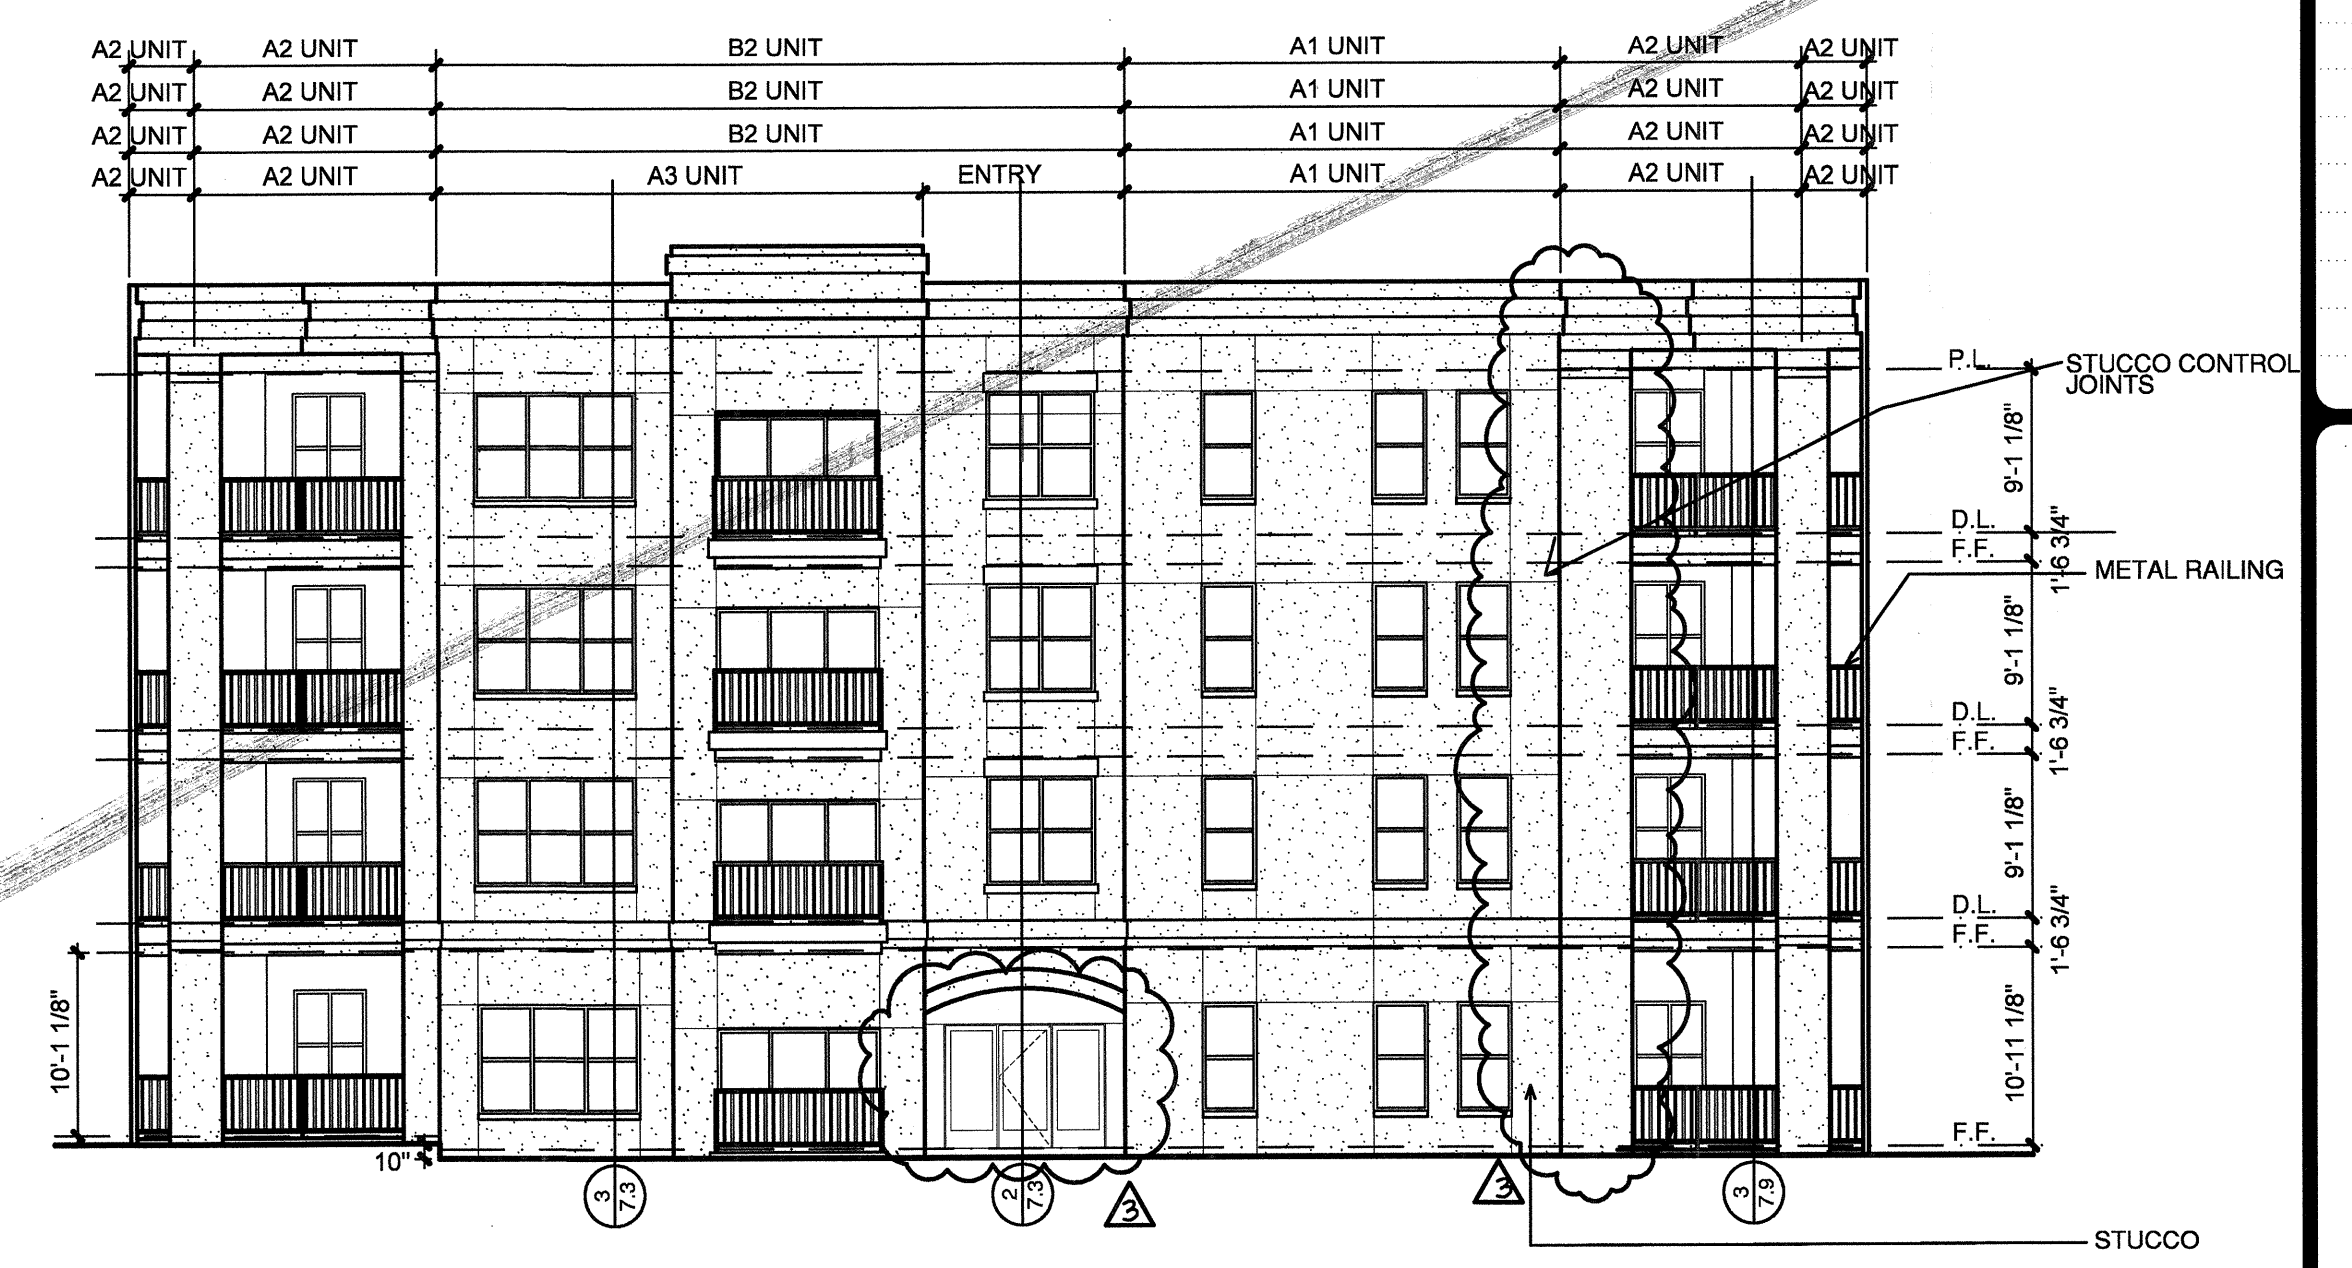

4 COURT ELEVATION
 SCALE: 3/32"=1'-0"



2 COURT ELEVATION
 SCALE: 3/32"=1'-0"

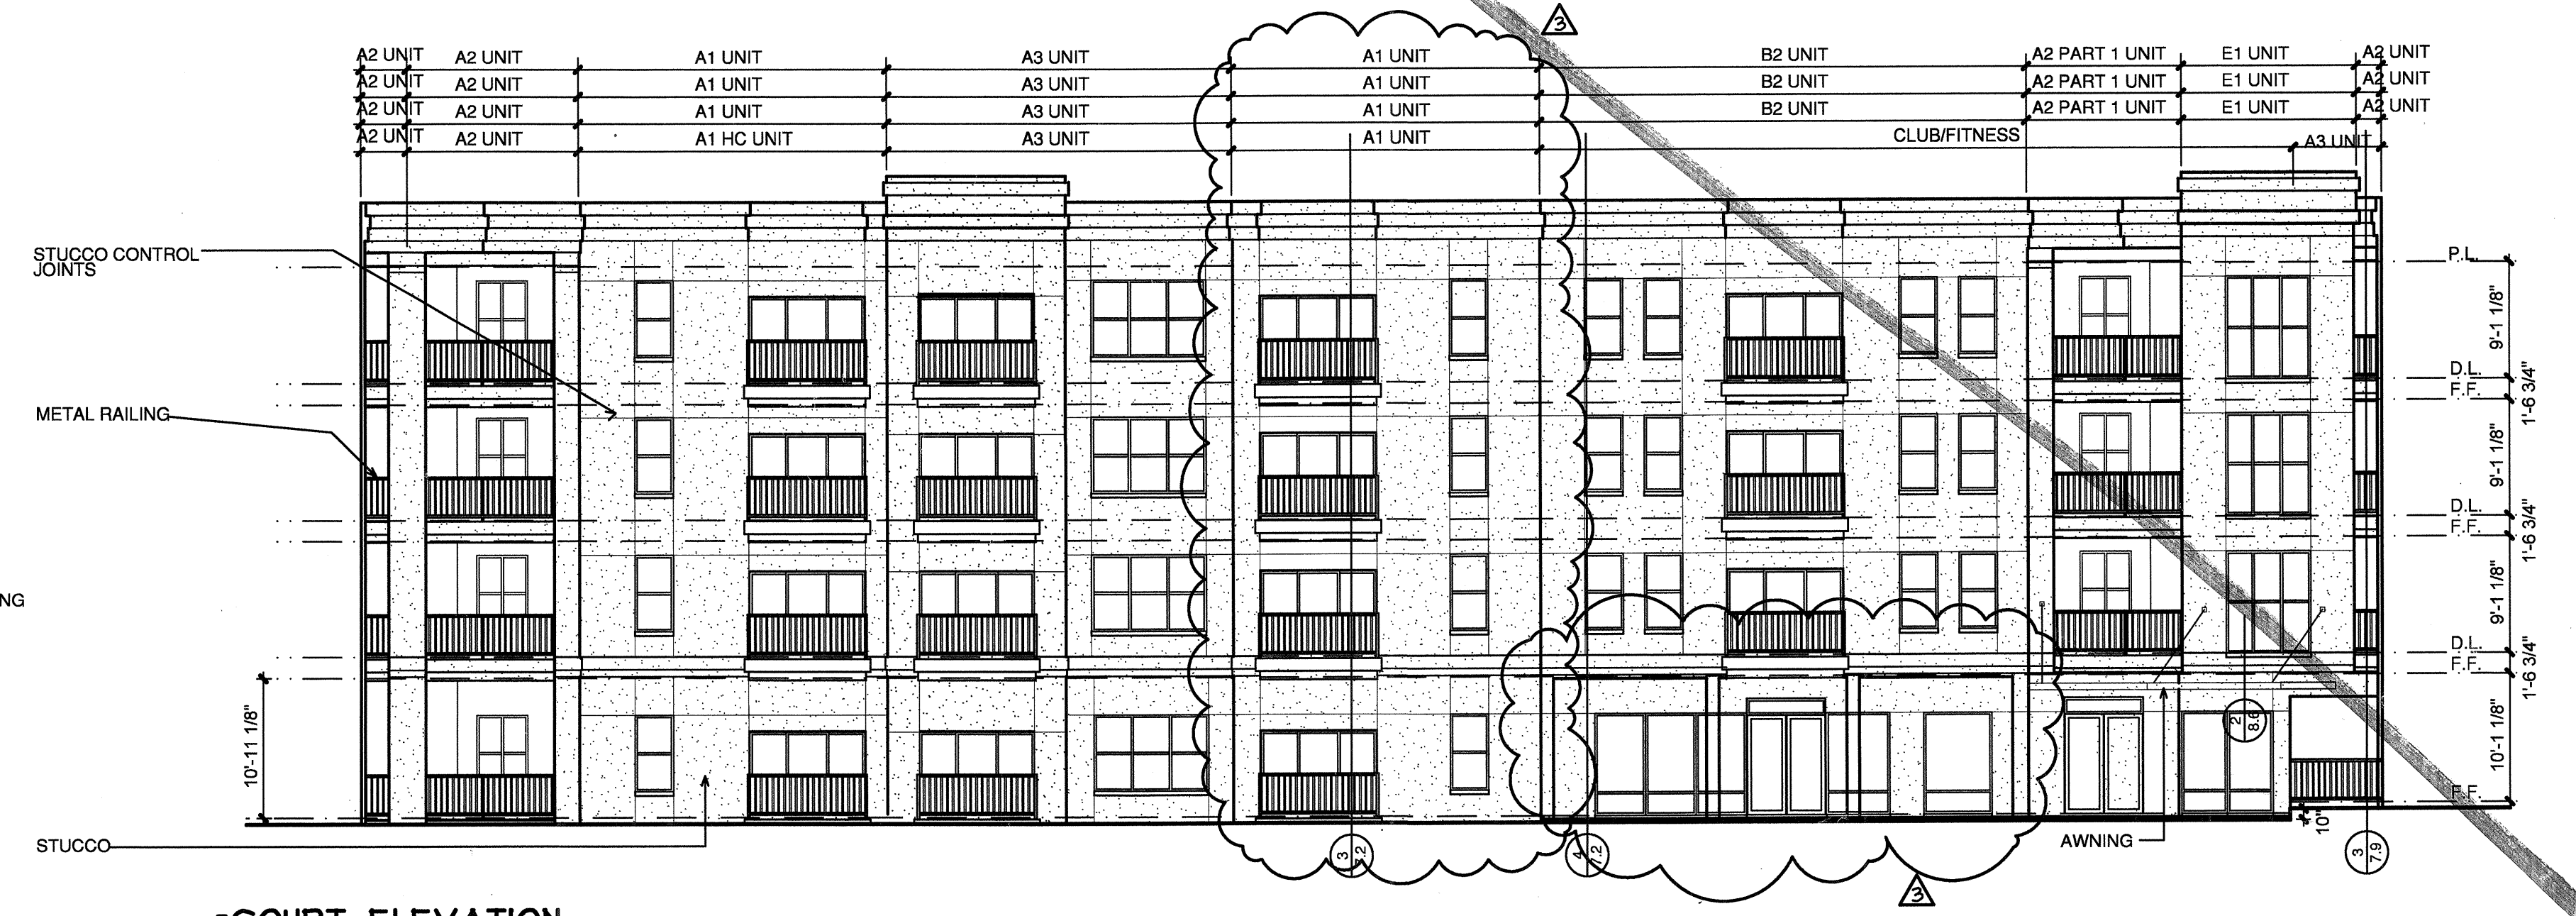

1 COURT ELEVATION
 SCALE: 3/32"=1'-0"

COPYRIGHT © Beeler Guest Owens Architects ALL RIGHTS RESERVED