



REVISIONS  
 Δ COORDINATION 10-17-2011  
 Δ COORDINATION 02-29-2012

**KELLER SPRINGS LOFTS**  
 LOFT APARTMENTS IN ADDISON, TEXAS

CONSTRUCTION ISSUE  
 10-17-2011

**BGO**  
 architects  
 4144 N. Central Expy.  
 Suite 855  
 Dallas, TX 75204  
 214.520.8878  
 bgoarchitects.com


DATE  
 08-05-2011  
 PROJECT  
 11129  
 SHEET NUMBER

**4.6**  
 COURTYARD  
 ELEVATIONS



**3 COURT ELEVATION**  
 SCALE: 3/32"=1'-0"

*South*

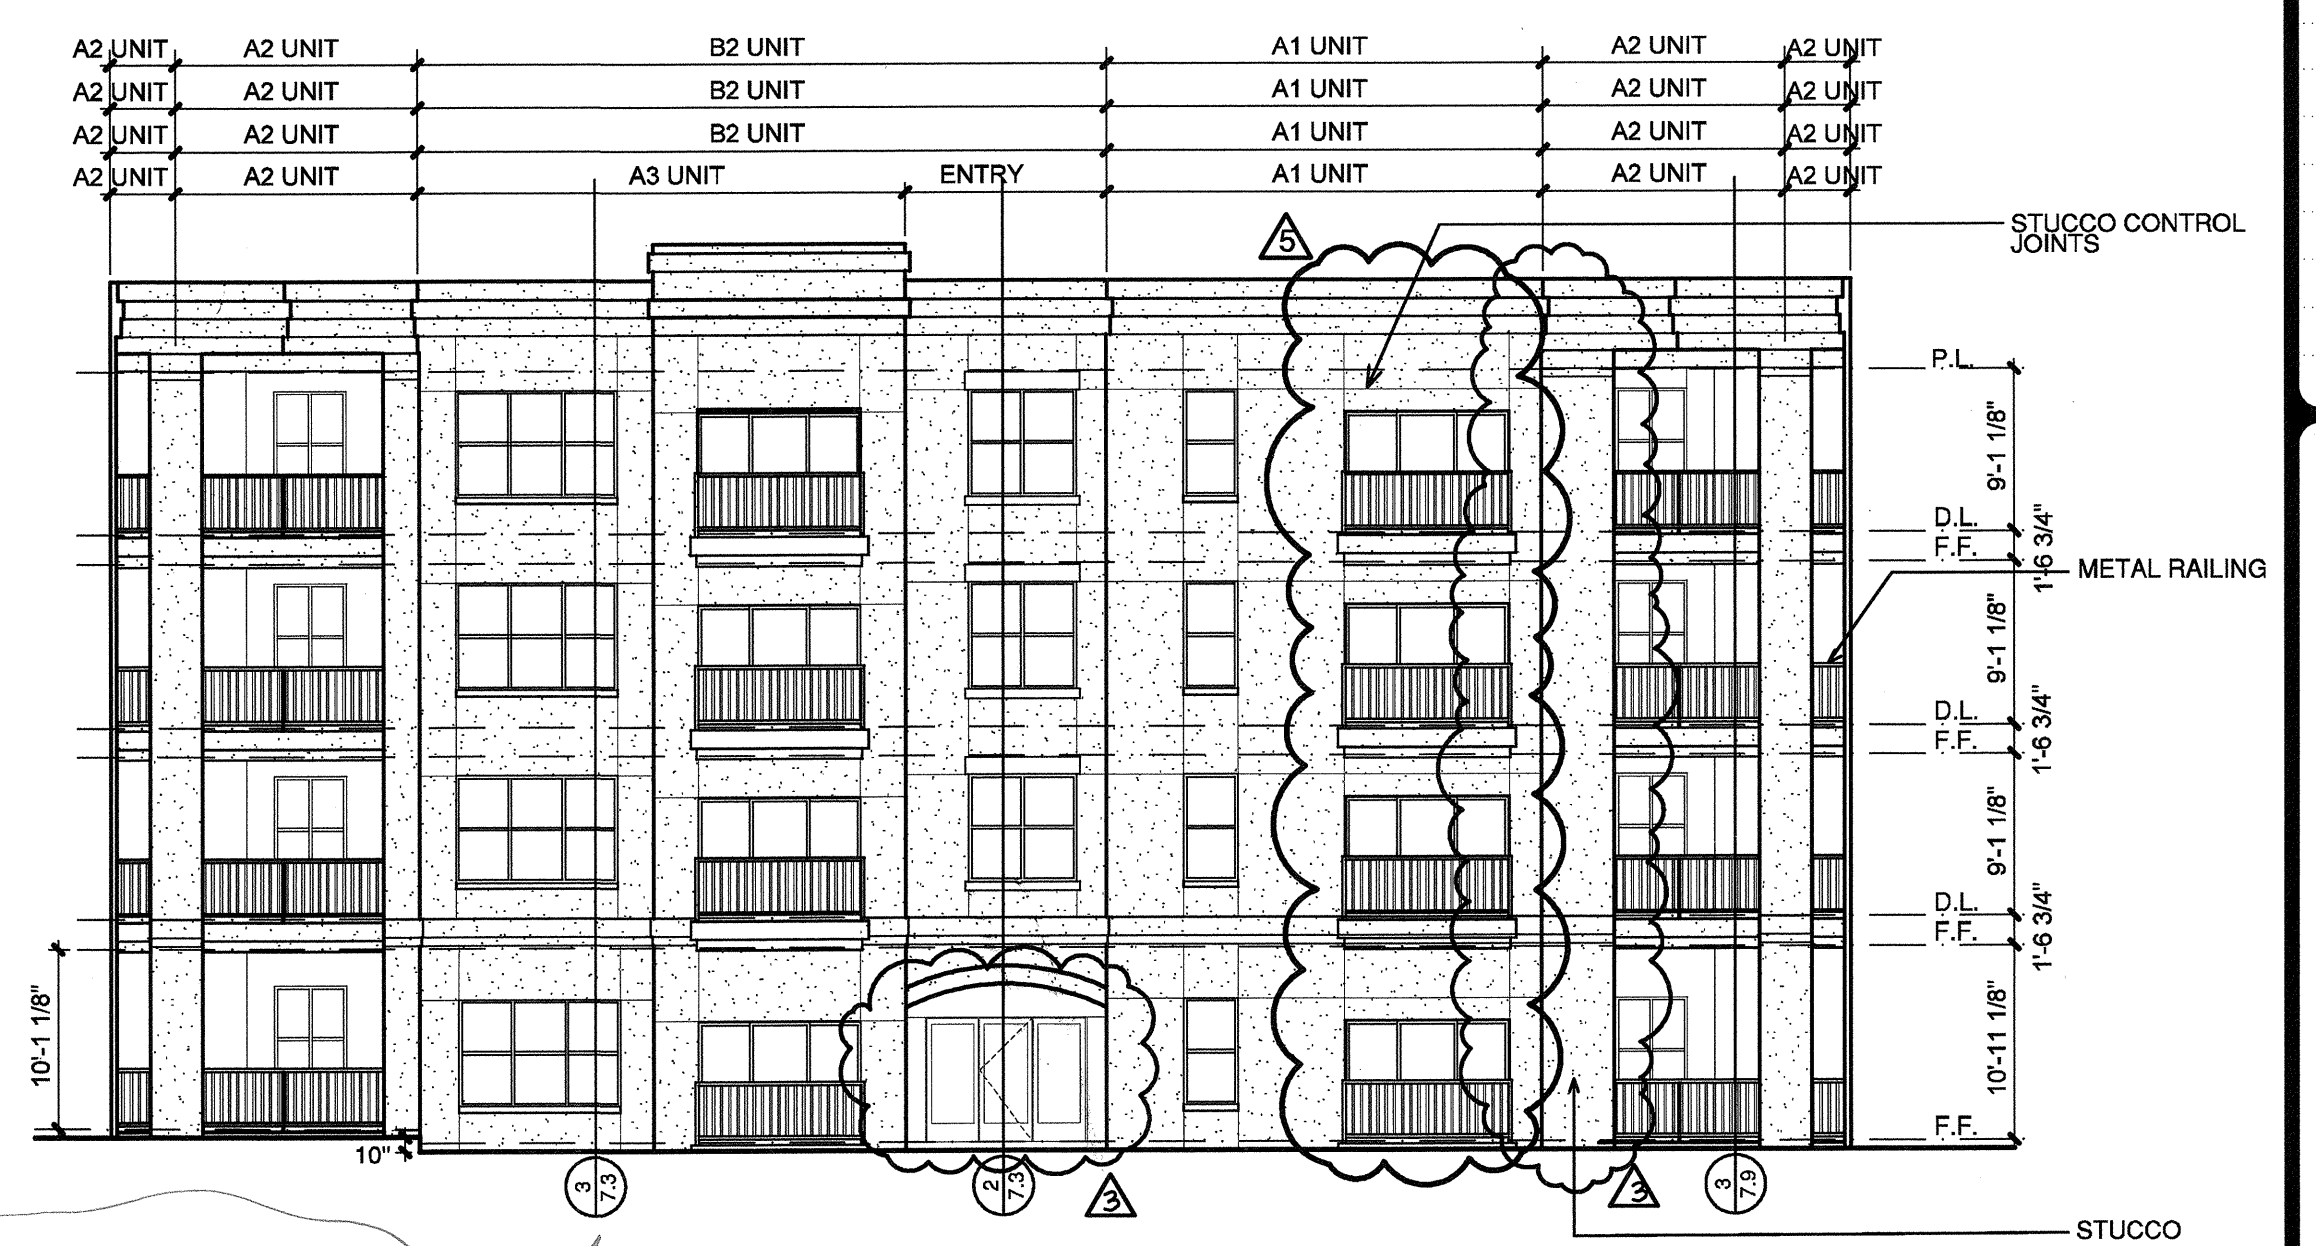

**4 COURT ELEVATION**  
 SCALE: 3/32"=1'-0"


*West*

*RFI 38*



**2 COURT ELEVATION**  
 SCALE: 3/32"=1'-0"

*EAST*

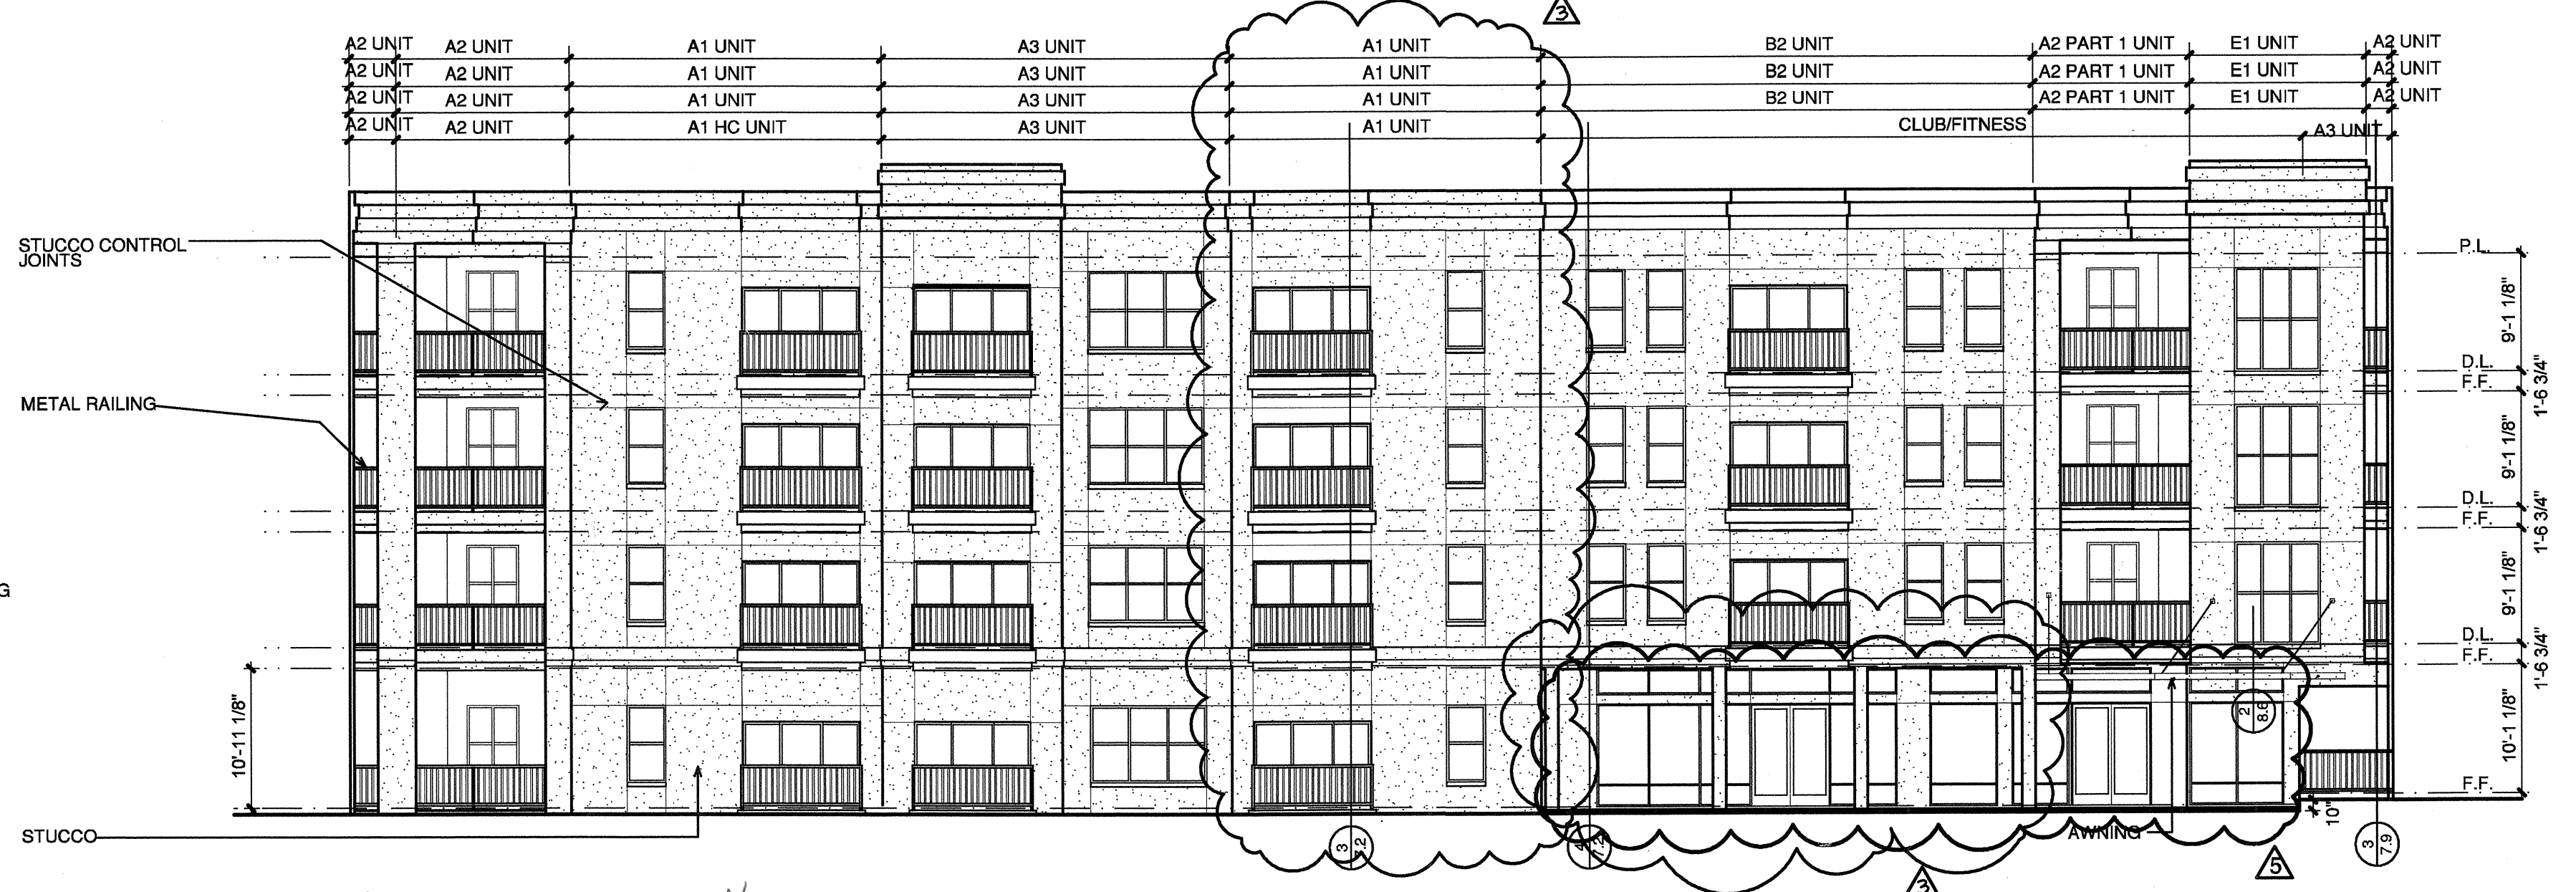

**1 COURT ELEVATION**  
 SCALE: 3/32"=1'-0"

*North*

COPYRIGHT © Beeler Owens Architects ALL RIGHTS RESERVED