

10-17-2011

REVISIONS  
COORDINATION  
10-17-2011

**KELLER SPRINGS LOFTS**  
LOFT APARTMENTS IN ADDISON, TEXAS

CONSTRUCTION ISSUE  
10-17-2011



4144 N. Central Expy.  
Suite 855  
Dallas, TX 75204  
214.520.8878  
bgoarchitects.com

DATE  
08-05-2011

PROJECT  
11129

SHEET NUMBER


**4.7**  
COURTYARD ELEVATIONS



**4 POOL COURTYARD ELEVATION** West  
SCALE: 3/32"=1'-0"  
RFI 43



**3 POOL COURTYARD ELEVATION** North  
SCALE: 3/32"=1'-0"

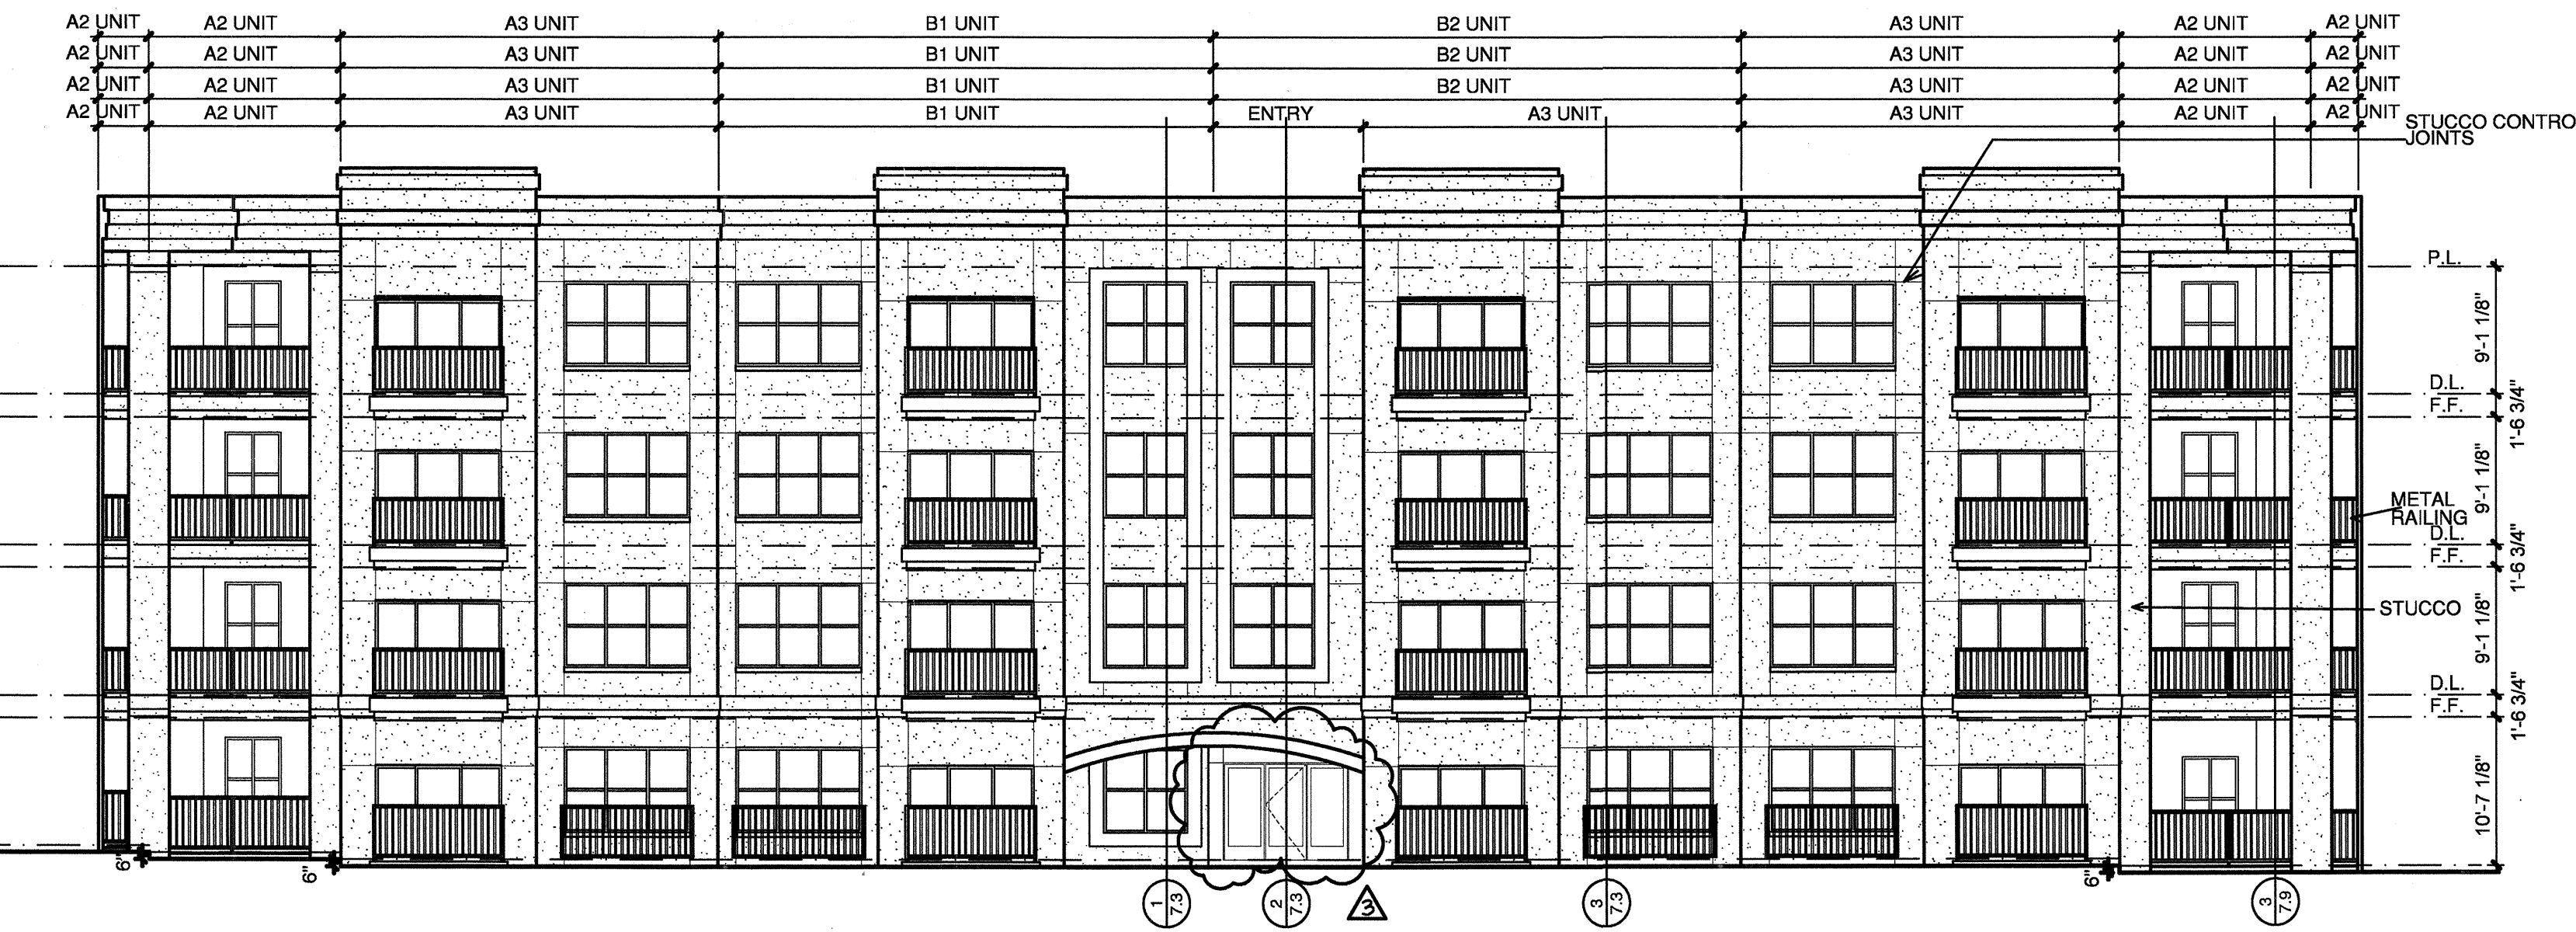

**2 POOL COURTYARD ELEVATION** South  
SCALE: 3/32"=1'-0"



**1 POOL COURTYARD ELEVATION** EAST  
SCALE: 3/32"=1'-0"

COPYRIGHT © Beele, Guest, Owens Architects ALL RIGHTS RESERVED