



REVISIONS	
△	COORDINATION 01-17-2012

KELLER SPRINGS LOFTS

LOFT APARTMENTS IN ADDISON, TEXAS

CONSTRUCTION ISSUE
10-17-2011



4144 N. Central Expy.
Suite 855
Dallas, TX 75204
214.520.8878
bgoarchitects.com

DATE
08-05-2011


PROJECT
11129

SHEET NUMBER

5.4

SECT./PLAN

COPYRIGHT © Beeler, Guest, Owens Architects. ALL RIGHTS RESERVED

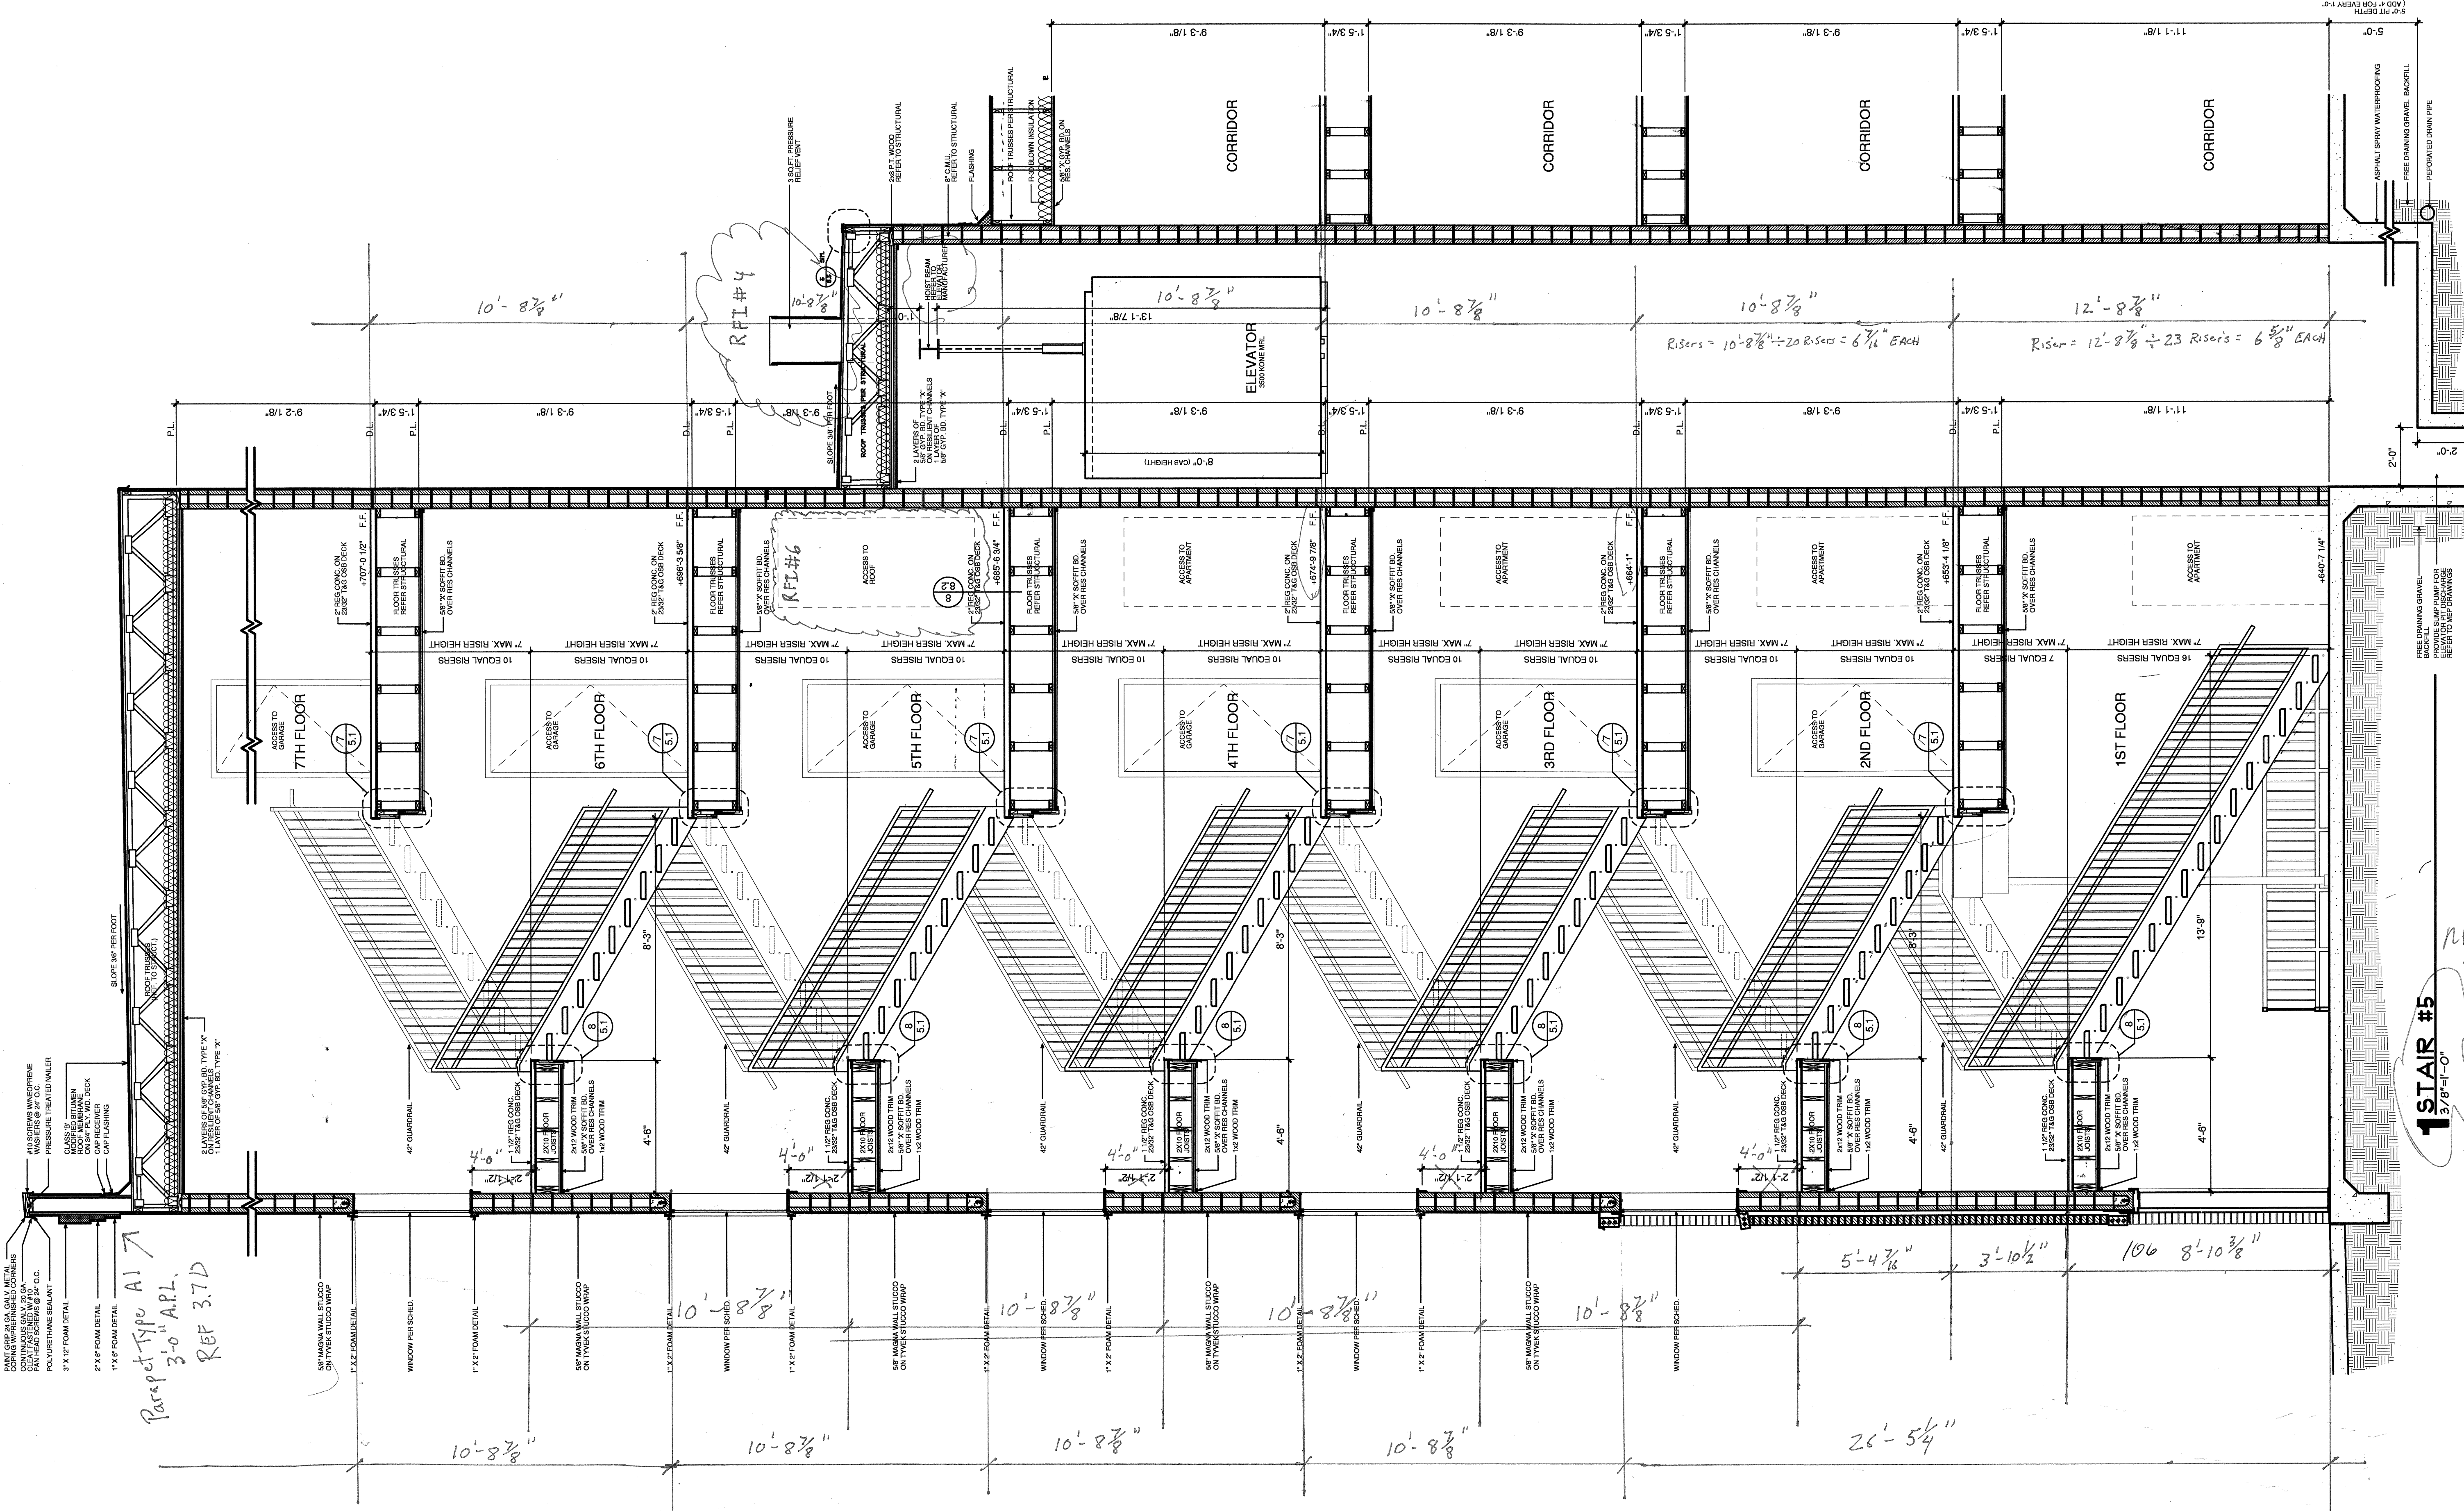

Risers = 12"

10'-8 7/8"

10'-8 7/8"

10'-8 7/8"

10'-8 7/8"

12'-8 7/8"

Risers = 10'-8 7/8" ÷ 20 Risers = 6 5/8" EACH

Riser = 12'-8 7/8" ÷ 23 Risers = 6 5/8" EACH

1 STAIR #5
3/8" x 0"

Parapet type A1
3'-0" A.P.L.
REF 3.7D

10'-8 7/8"

10'-8 7/8"

26'-5 1/4"

5'-4 7/8"

3'-10 1/2"

106 8'-10 3/8"

RFE
204