


2 STAIR #2
3/8"=1'-0"
2

As per Ryan BGO
8/22/12

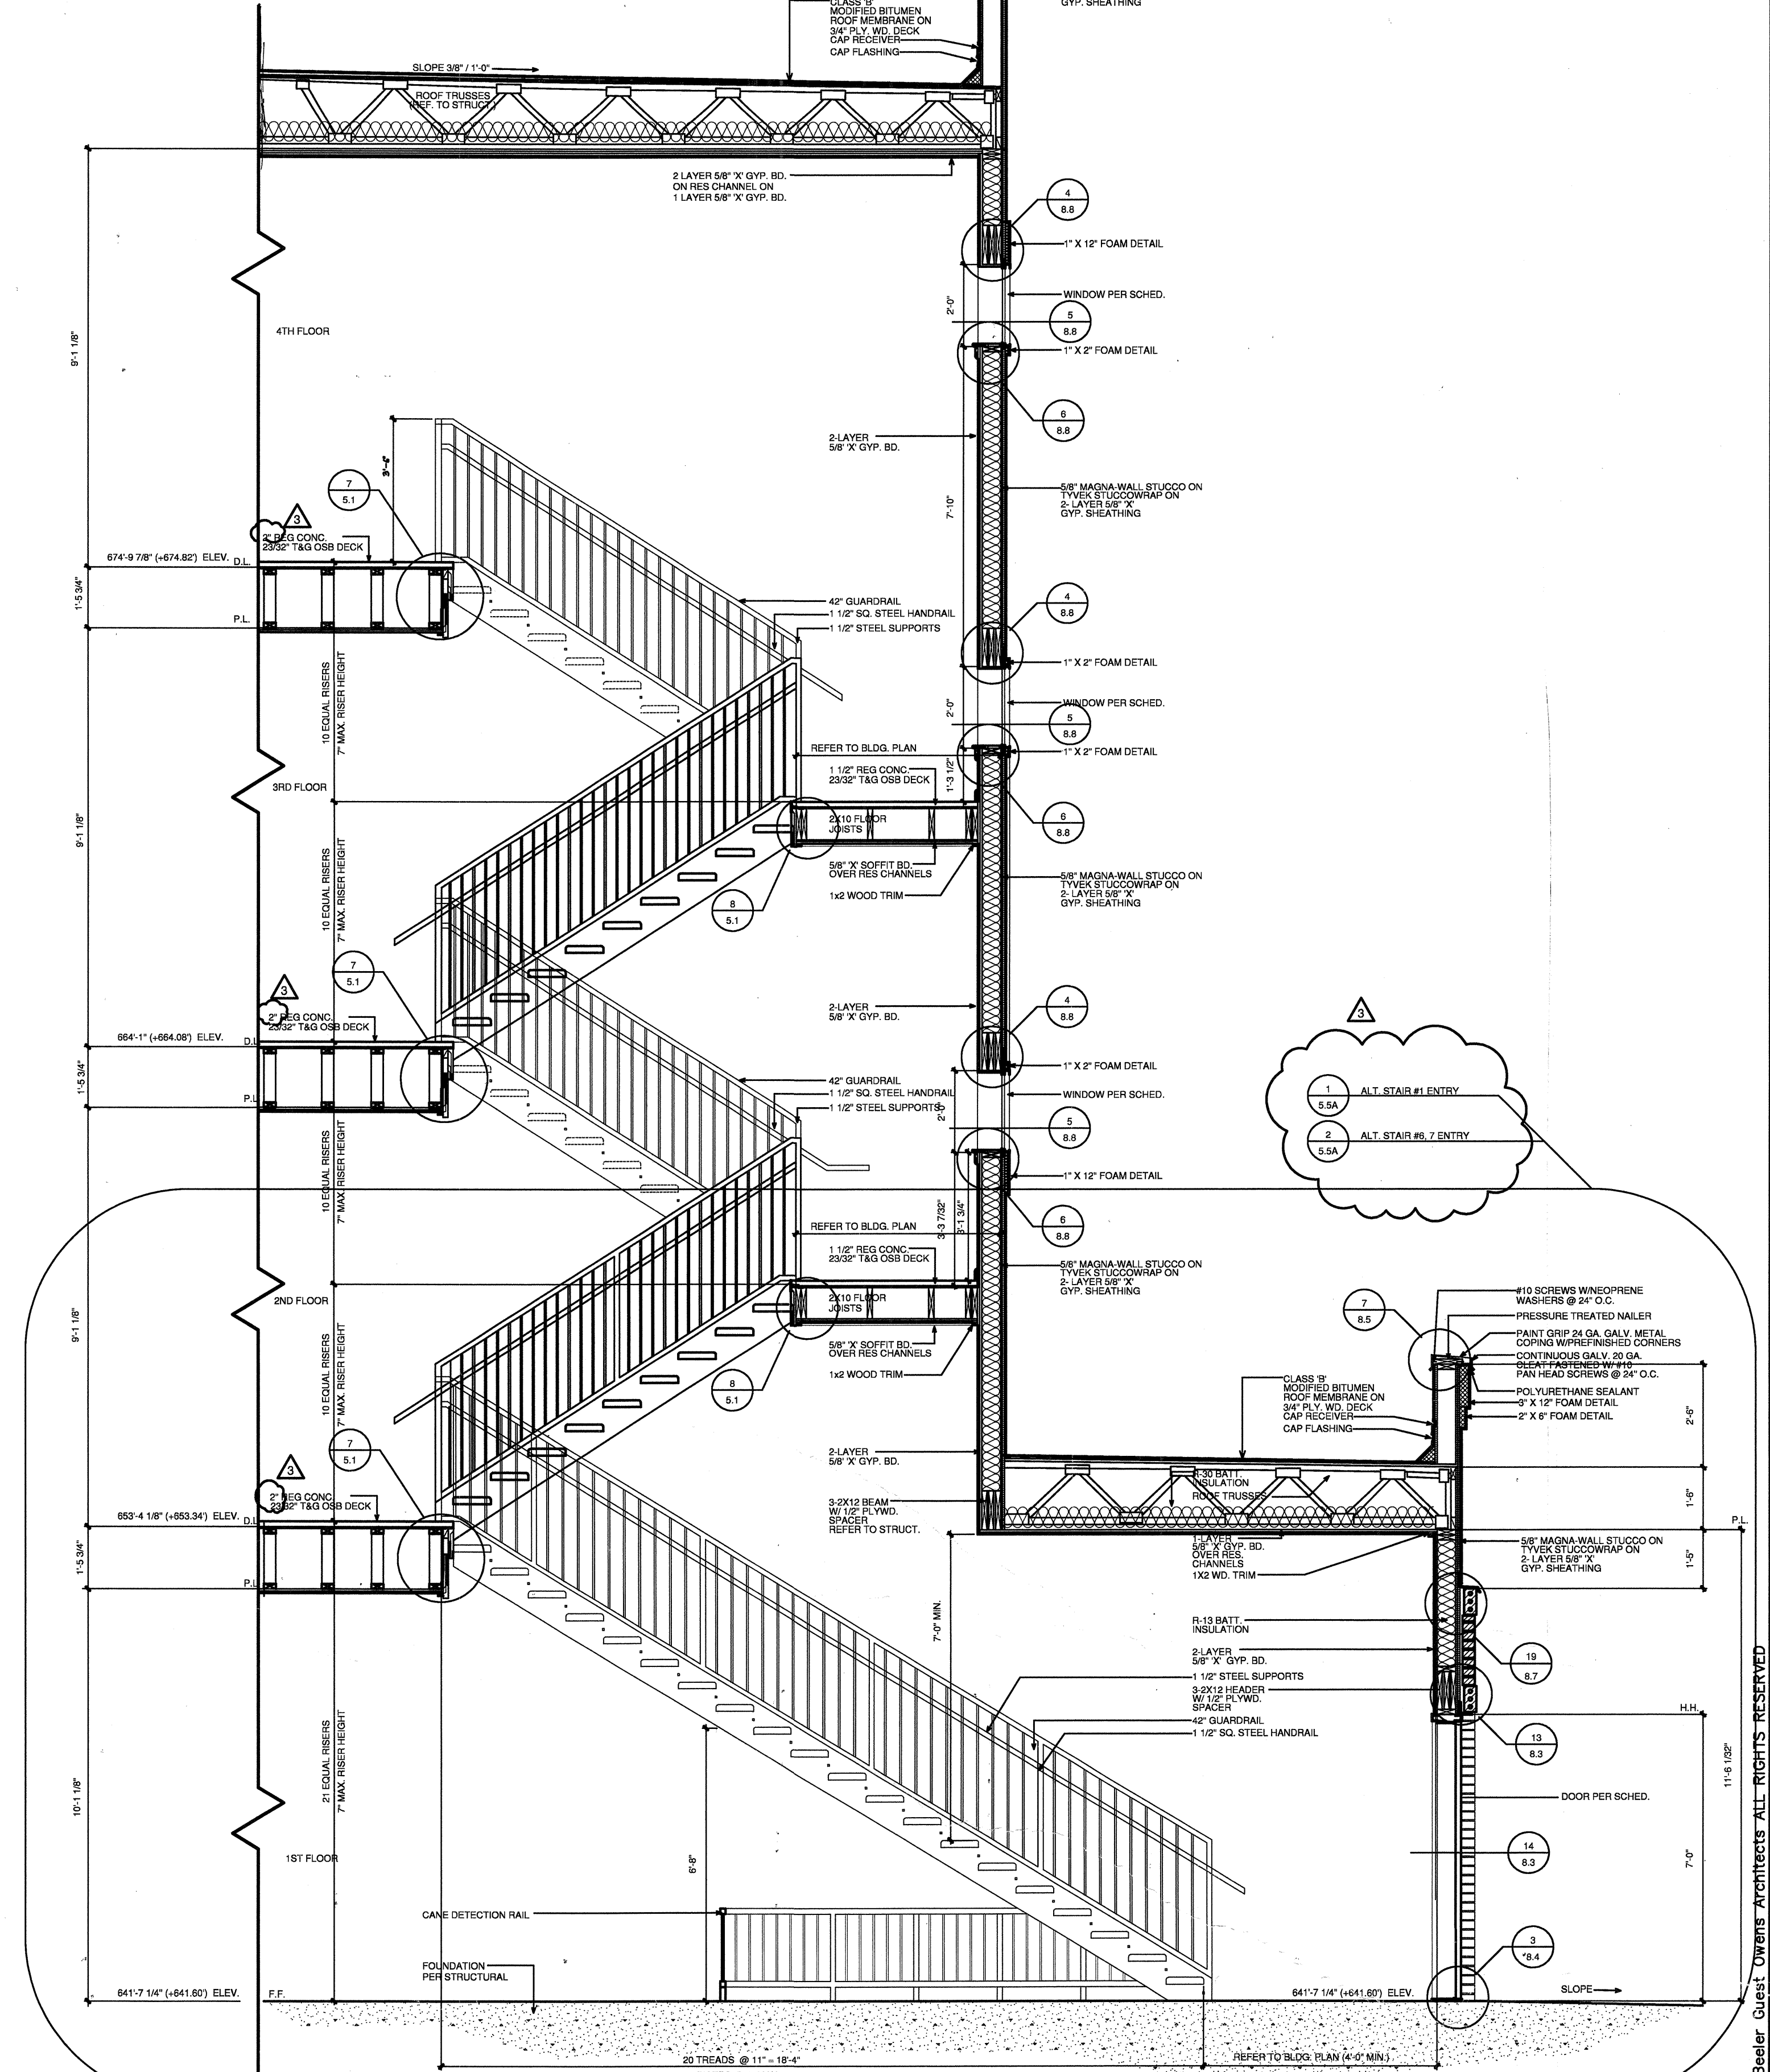

1 STAIR #3, 9
3/8"=1'-0"

RF# 193



REVISIONS
CORRODINATION
10-17-2011

KELLER SPRINGS LOFTS
LOFT APARTMENTS IN ADDISON, TEXAS

CONSTRUCTION ISSUE
10-17-2011

BGO architects
4144 N. Central Expy.
Suite 855
Dallas, TX 75204
214.520.8878
bgoarchitects.com

DATE
08-05-2011

PROJECT
11129

SHEET NUMBER

5.5
STAIR SECTIONS

COPYRIGHT © Beeler Owens Architects ALL RIGHTS RESERVED