



10-17-2011

REVISIONS

3. COORDINATION 10-17-2011

KELLER SPRINGS LOFTS

LOFT APARTMENTS IN ADDISON, TEXAS

CONSTRUCTION ISSUE
10-17-2011


BGO architects
4144 N. Central Expy.
Suite 855
Dallas, TX 75204
214.520.8878
bgoarchitects.com

DATE
08-05-2011

PROJECT
11129

SHEET NUMBER

5.5A
STAIR SECTIONS

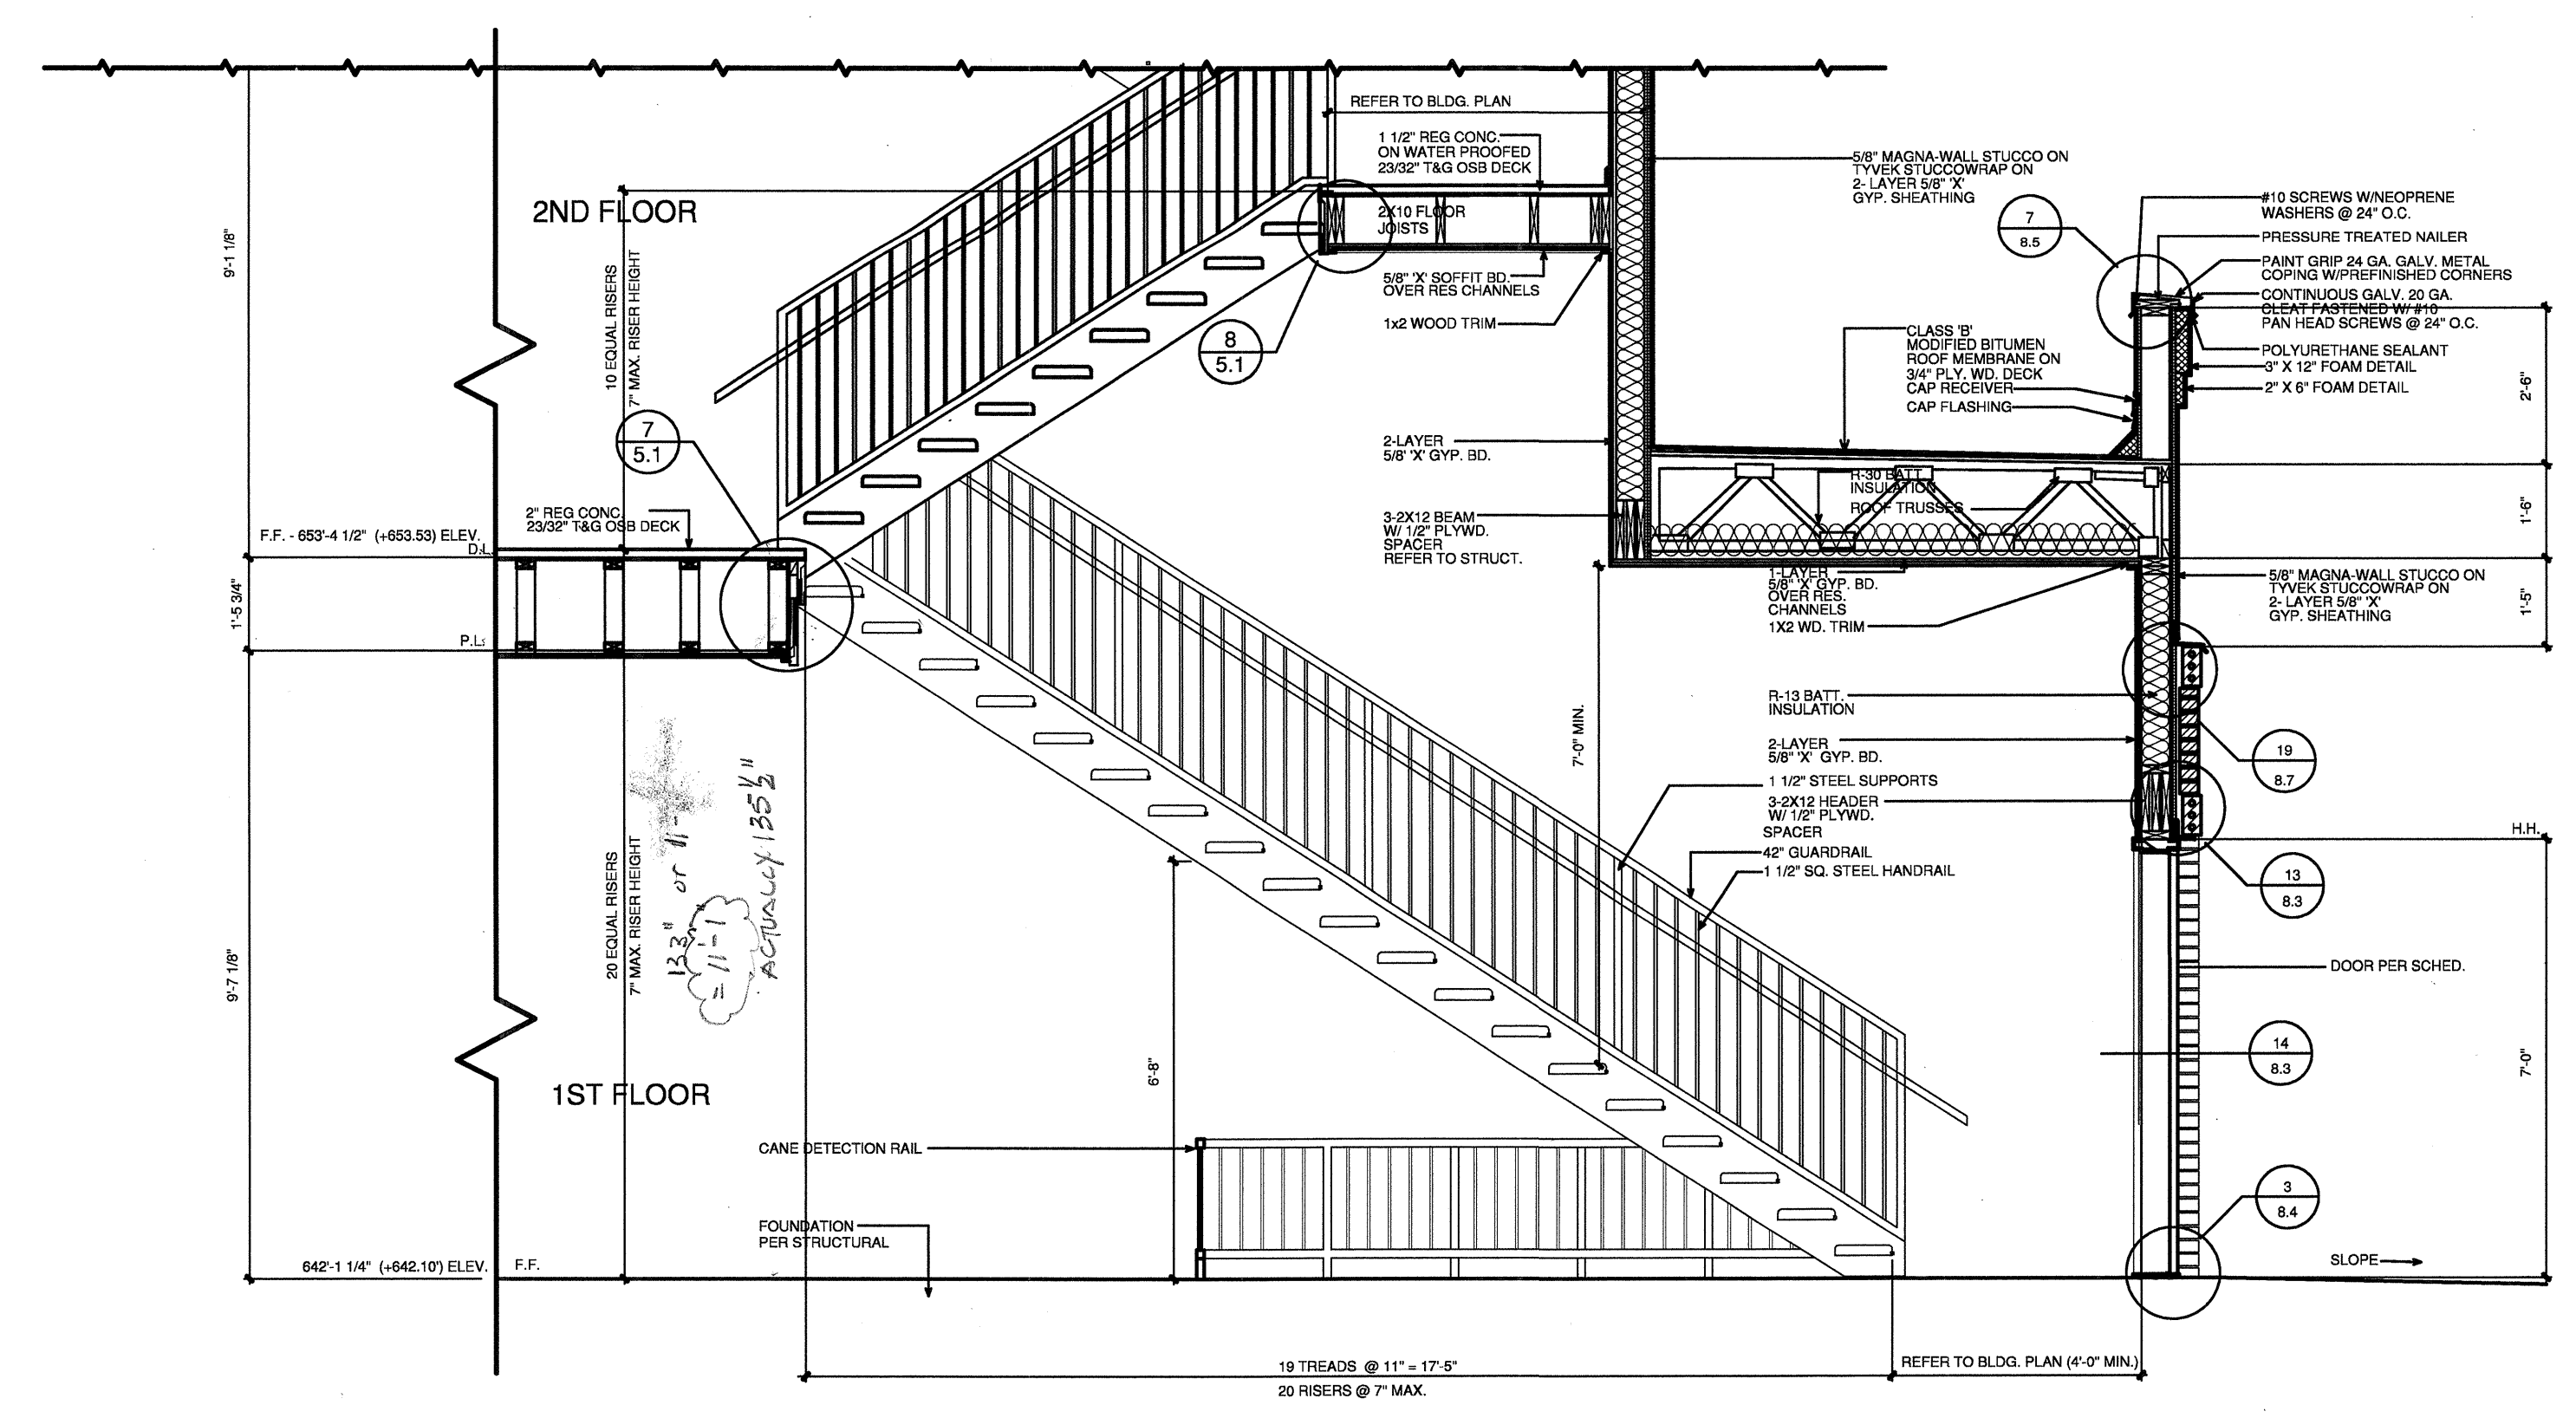


2 ALT. STAIR # 6, 7

3/8"=1'-0"

FIRE RATINGS:
ROOF/CLG: 1 HR. U.L. #PS22
FLOOR/CLG: 1 HR. U.L. #R50
WALL: 2 HR. #1, #201
RISER: #2 @ STUCCO

SOUND RATINGS:
FLOOR/CLG: STC 62 (60 REQ.)
WITH FLOOR COVERING

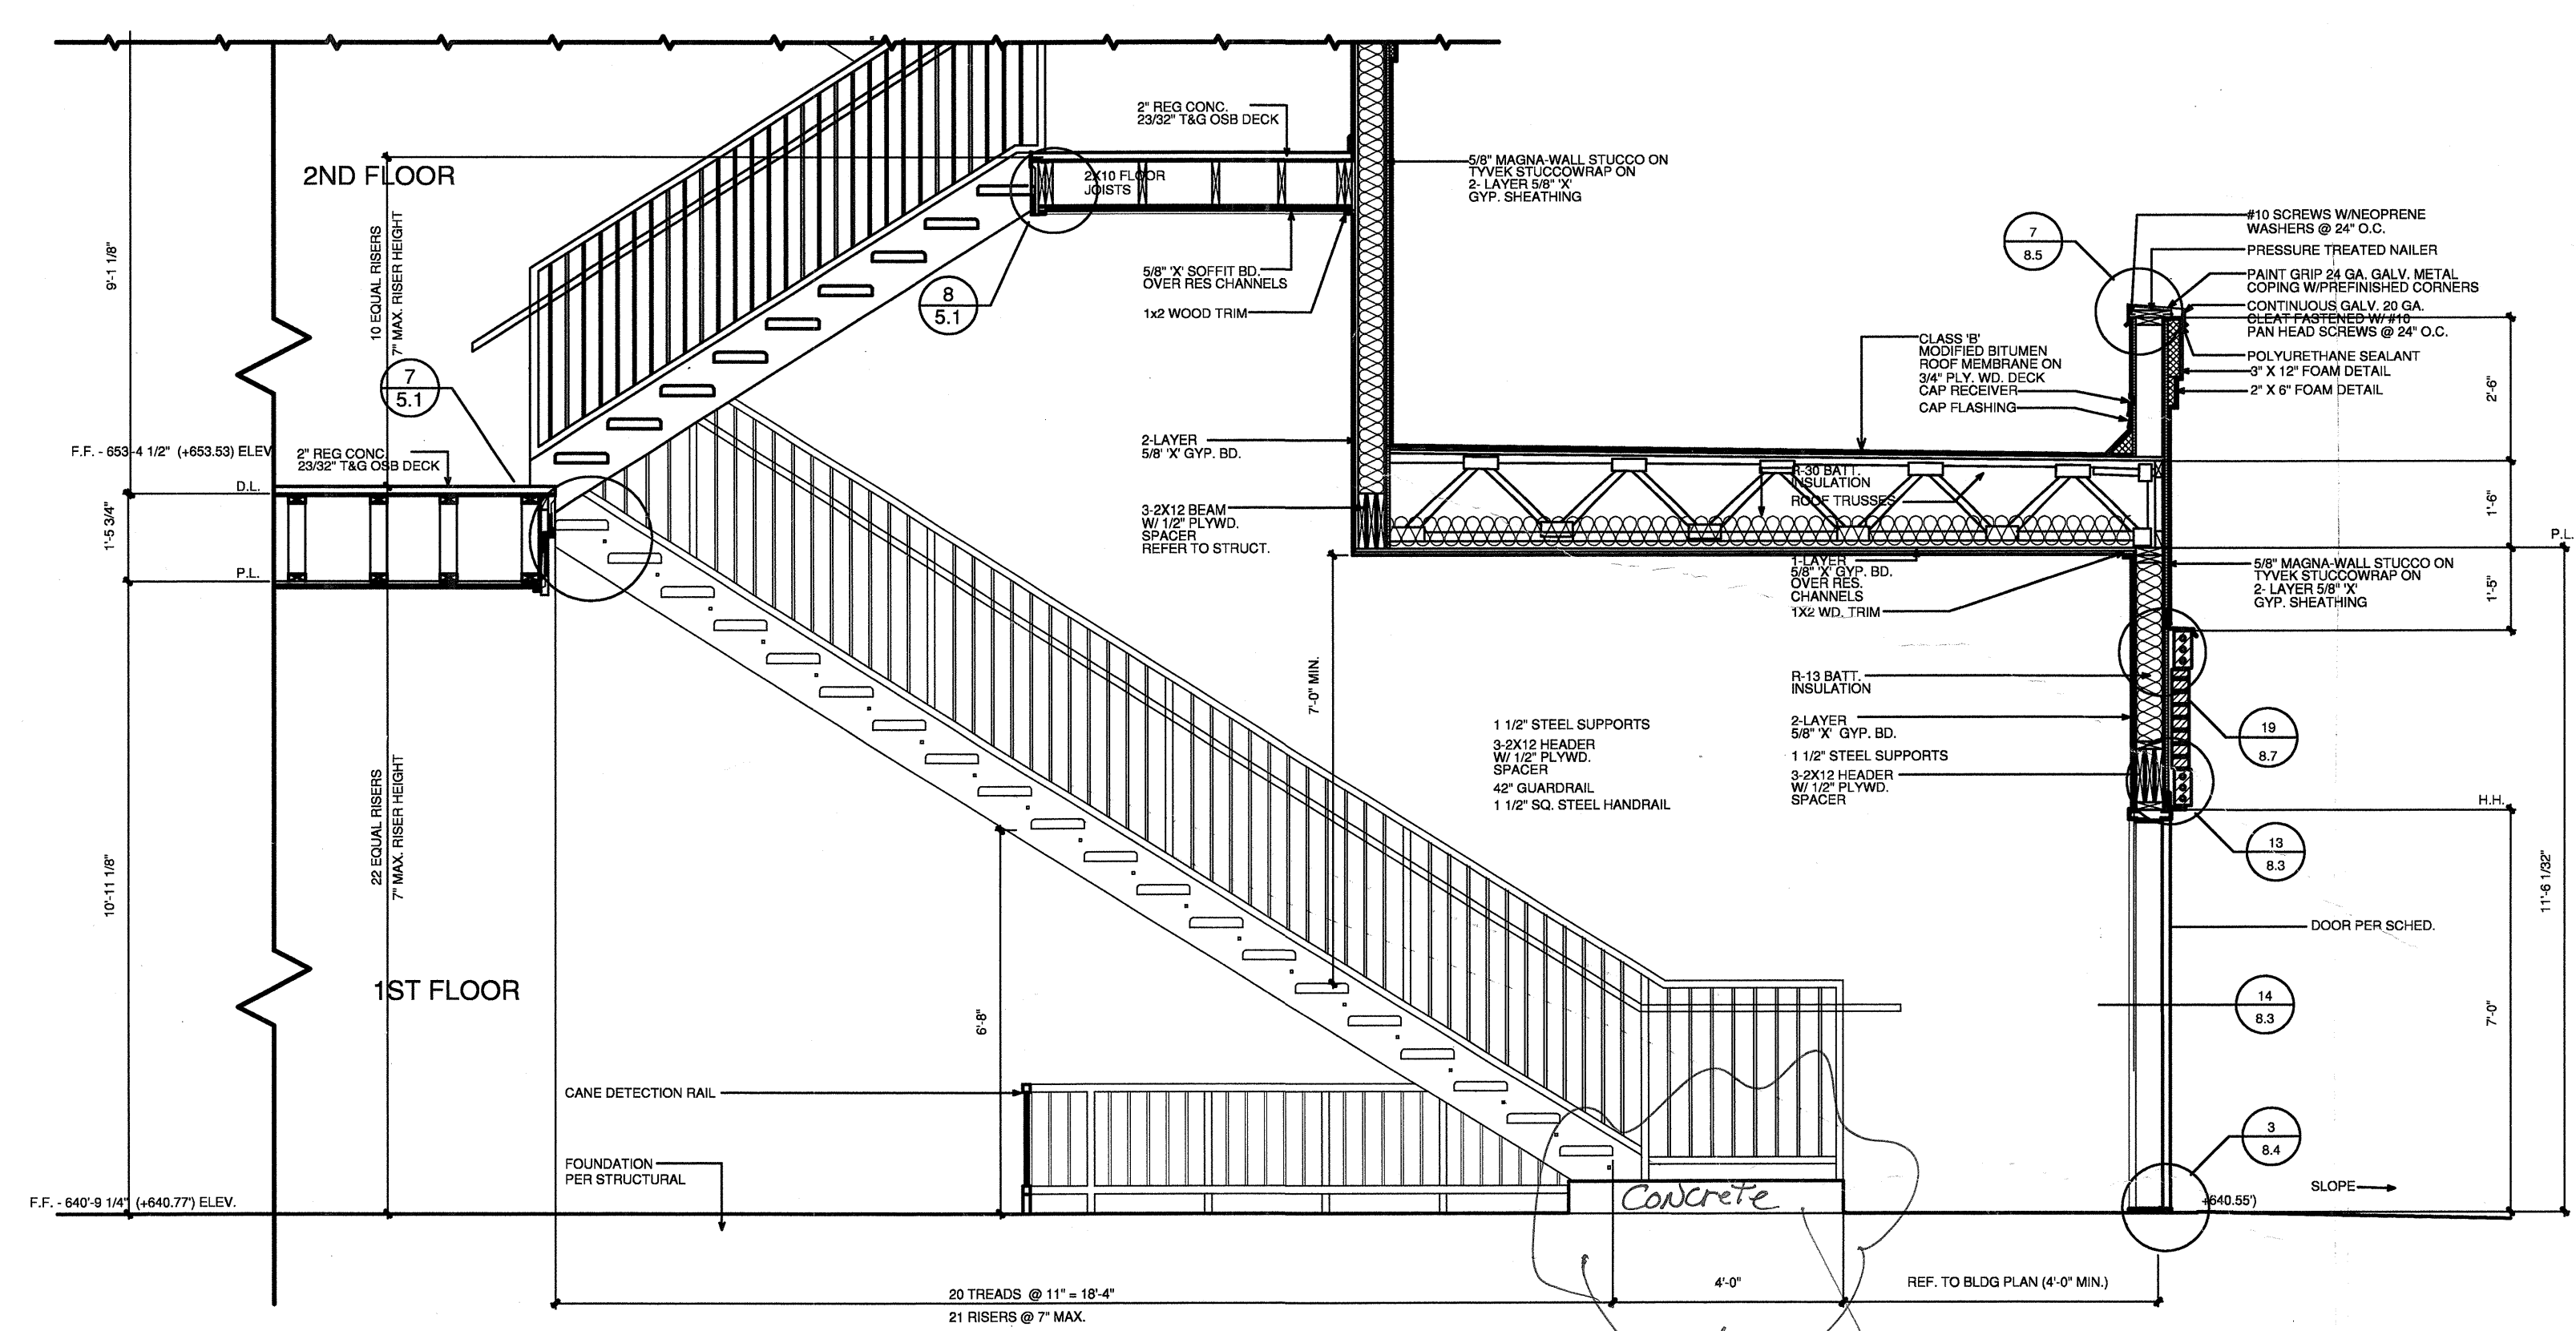

1 ALT. STAIR # 1

3/8"=1'-0"

FIRE RATINGS:
ROOF/CLG: 1 HR. U.L. #PS22
FLOOR/CLG: 1 HR. U.L. #R50
WALL: 2 HR. #1, #201
RISER: #2 @ STUCCO

SOUND RATINGS:
FLOOR/CLG: STC 62 (60 REQ.)
WITH FLOOR COVERING

As per Ryan with BGO
8/28/12

COPYRIGHT © Beeler Guest Owens Architects ALL RIGHTS RESERVED