


1 BUILDING SECTION THROUGH CORRIDOR AND PARKING GARAGE W/ 2" EXPANSION JOINT
 SCALE: 3/8"=1'-0"

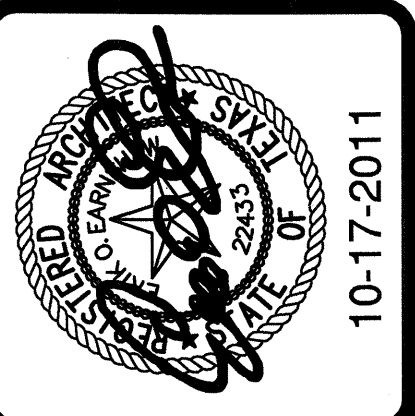

REVISIONS
 3 COORDINATION
 10-17-2011

KELLER SPRINGS LOFTS
 LOFT APARTMENTS IN ADDISON, TEXAS

CONSTRUCTION ISSUE
 10-17-2011

BGO
 architects
 4144 N. Central Expy.
 Suite 855
 Dallas, TX 75204
 214.520.8878
 bgoarchitects.com

DATE
 08-05-2011

PROJECT
 11129

SHEET NUMBER

6.1
 BUILDING SECTION

COPYRIGHT © Beeler, Guest, Owens Architects All Rights Reserved