



REVISIONS  
 4 GARAGE REVISIONS PER SHOP DWGS 01-03-2012

**KELLER SPRINGS LOFTS**  
 LOFT APARTMENTS IN ADDISON, TEXAS

CONSTRUCTION ISSUE  
 10-17-2011




**BGO architects**  
 4144 N. Central Exp. Suite 855  
 Dallas, TX 75204  
 214.520.8878  
 bgoarchitects.com

DATE  
 08-05-2011

PROJECT  
 11129

SHEET NUMBER

**6.2**  
 GARAGE PLAN  
 1-3

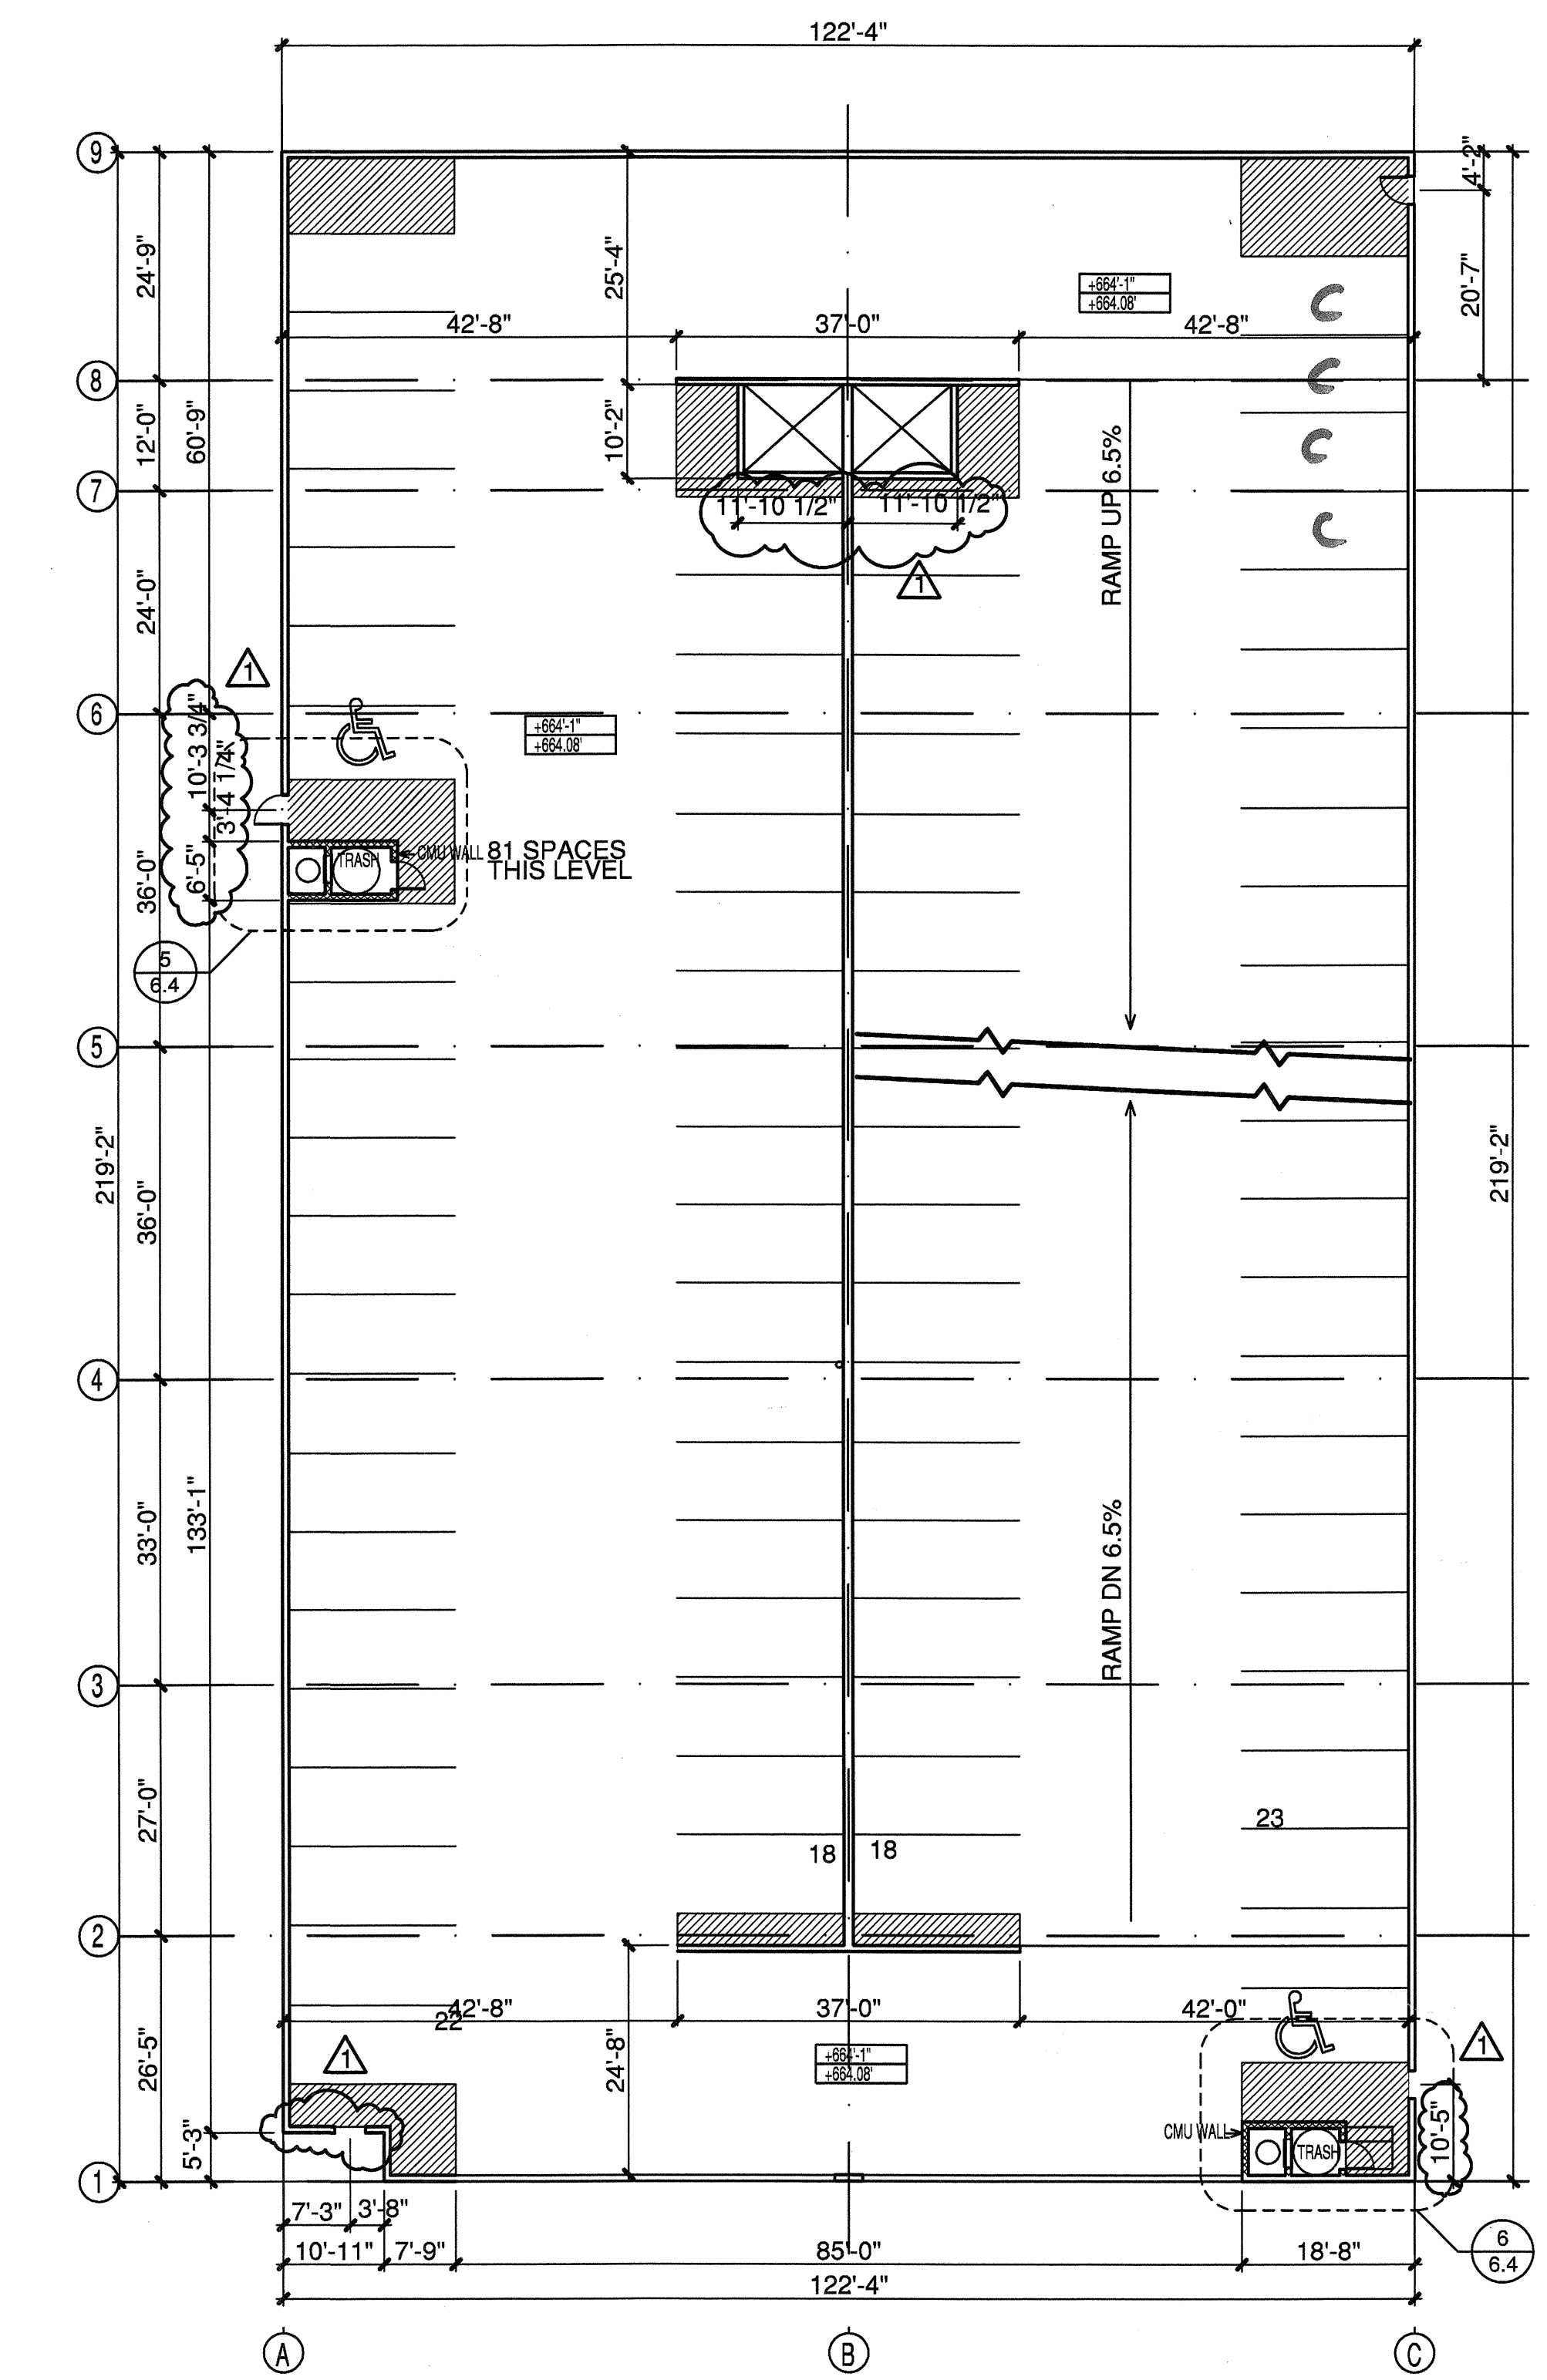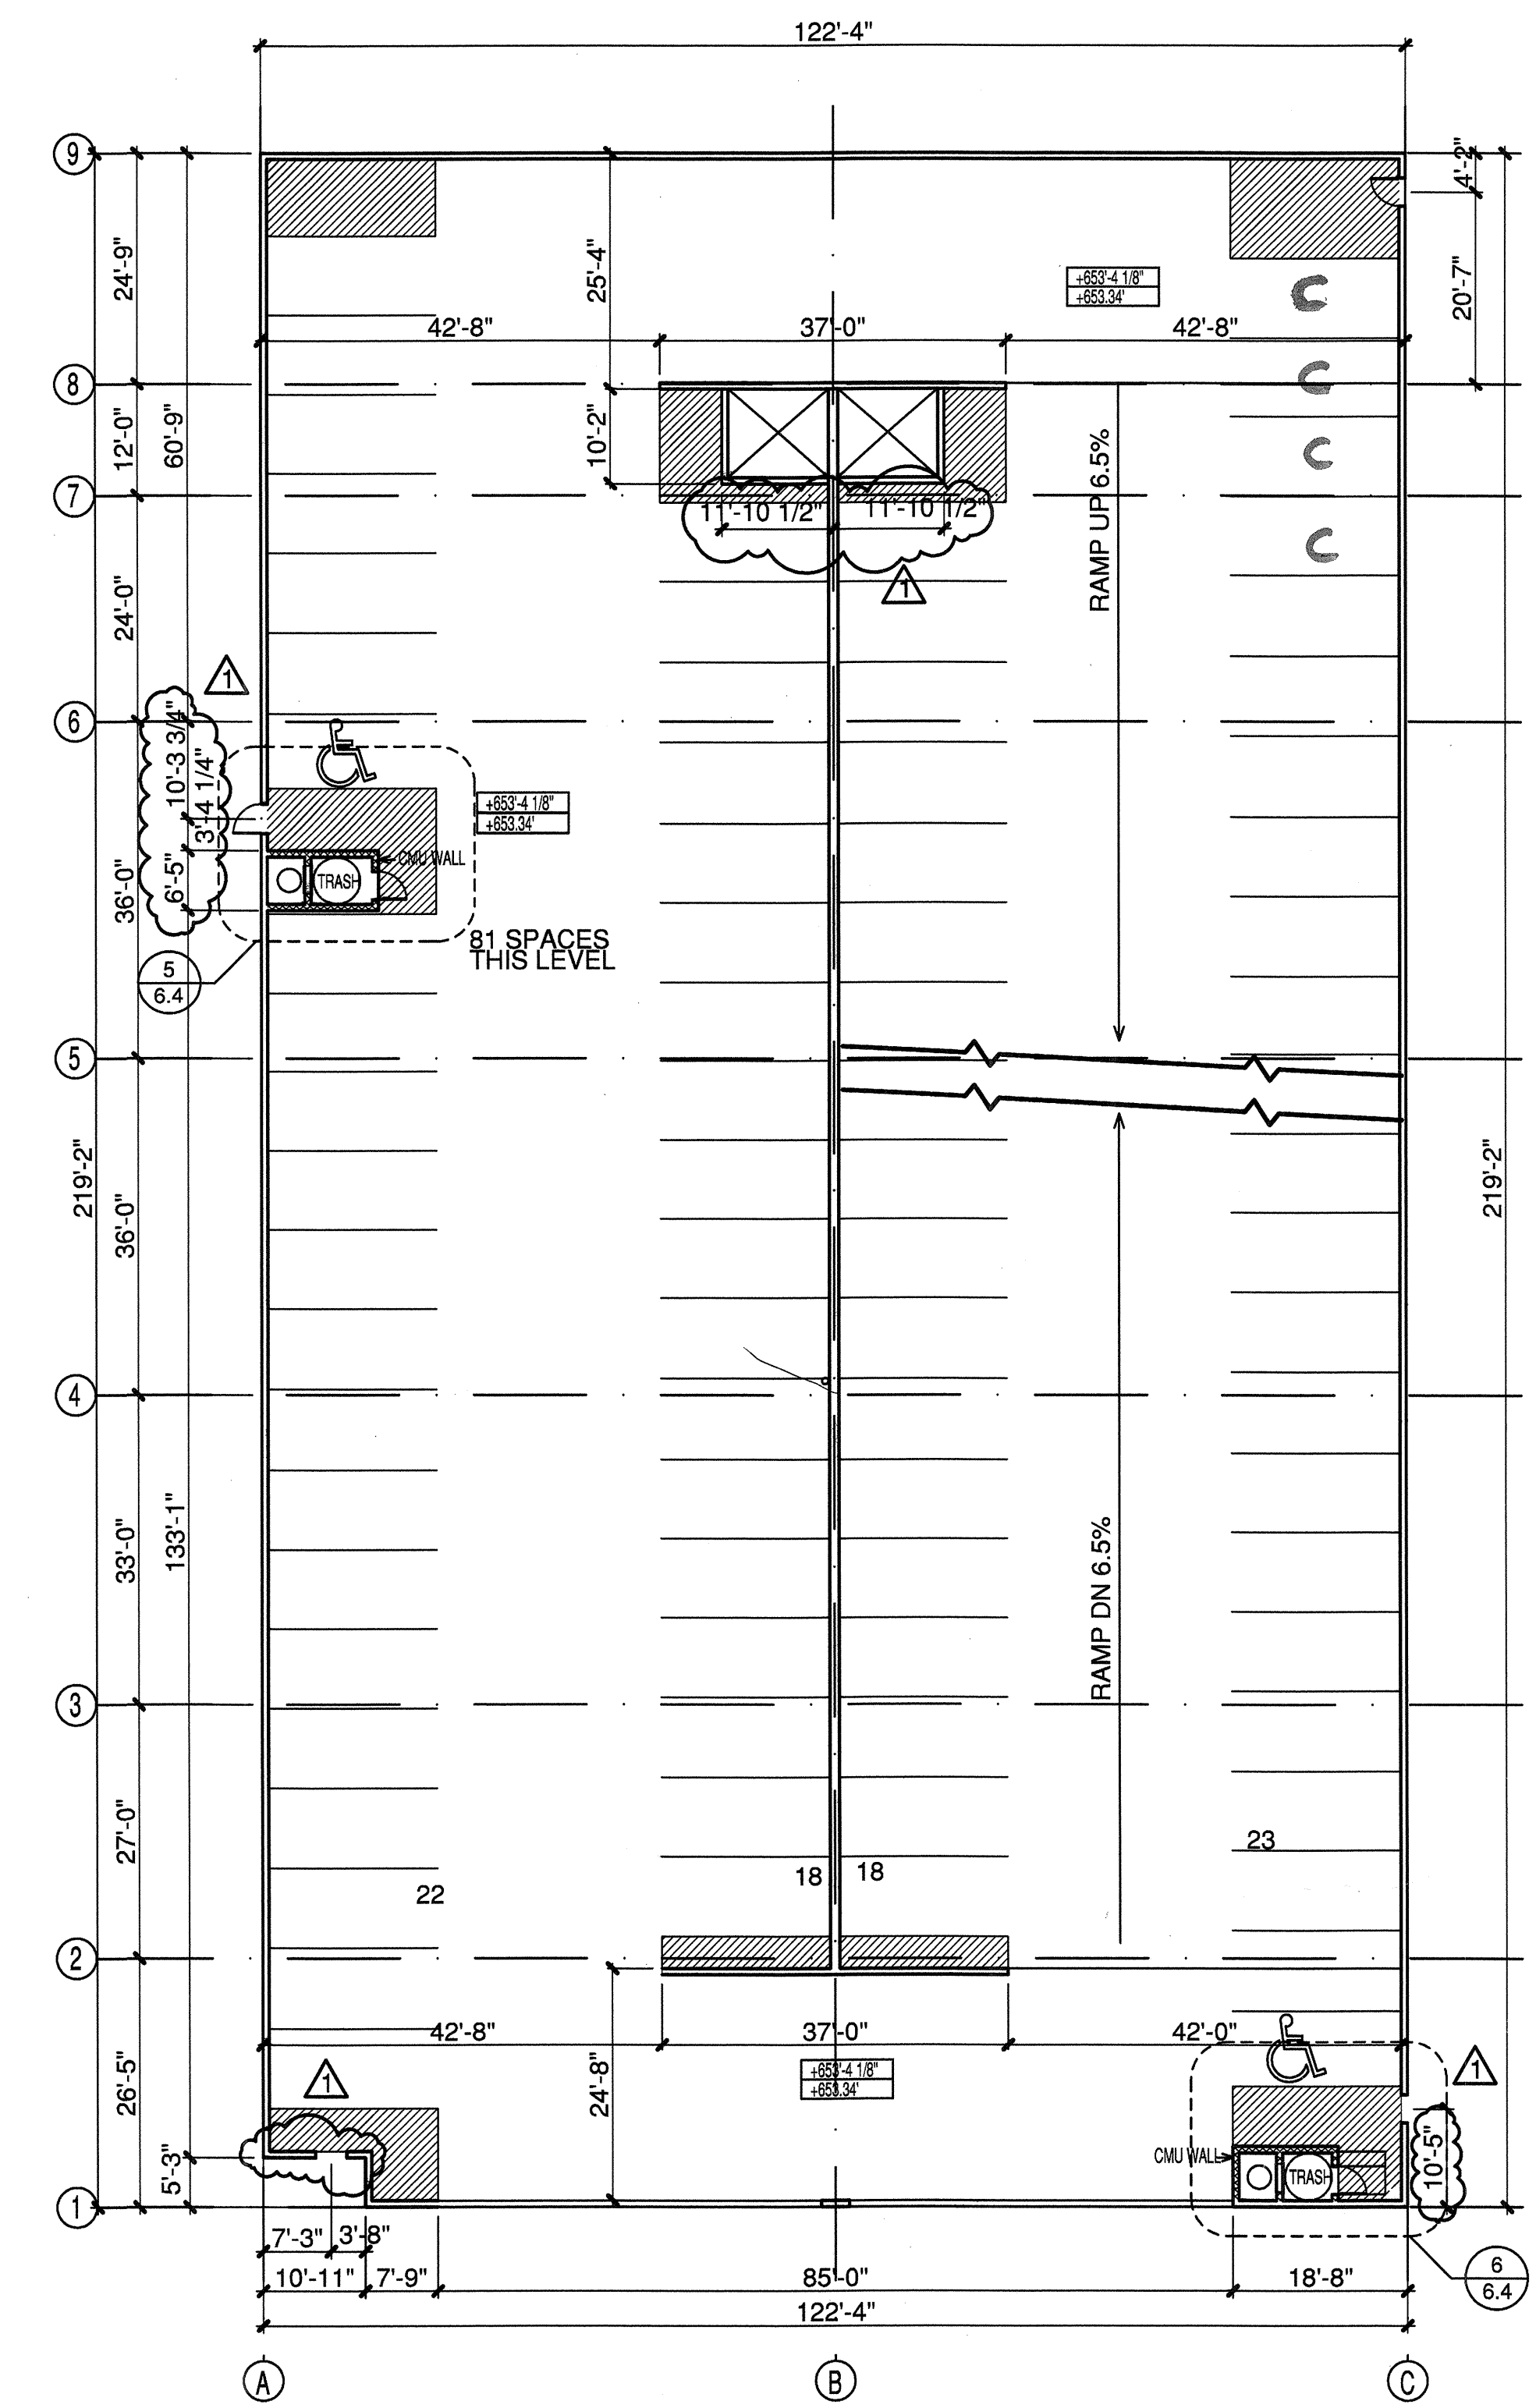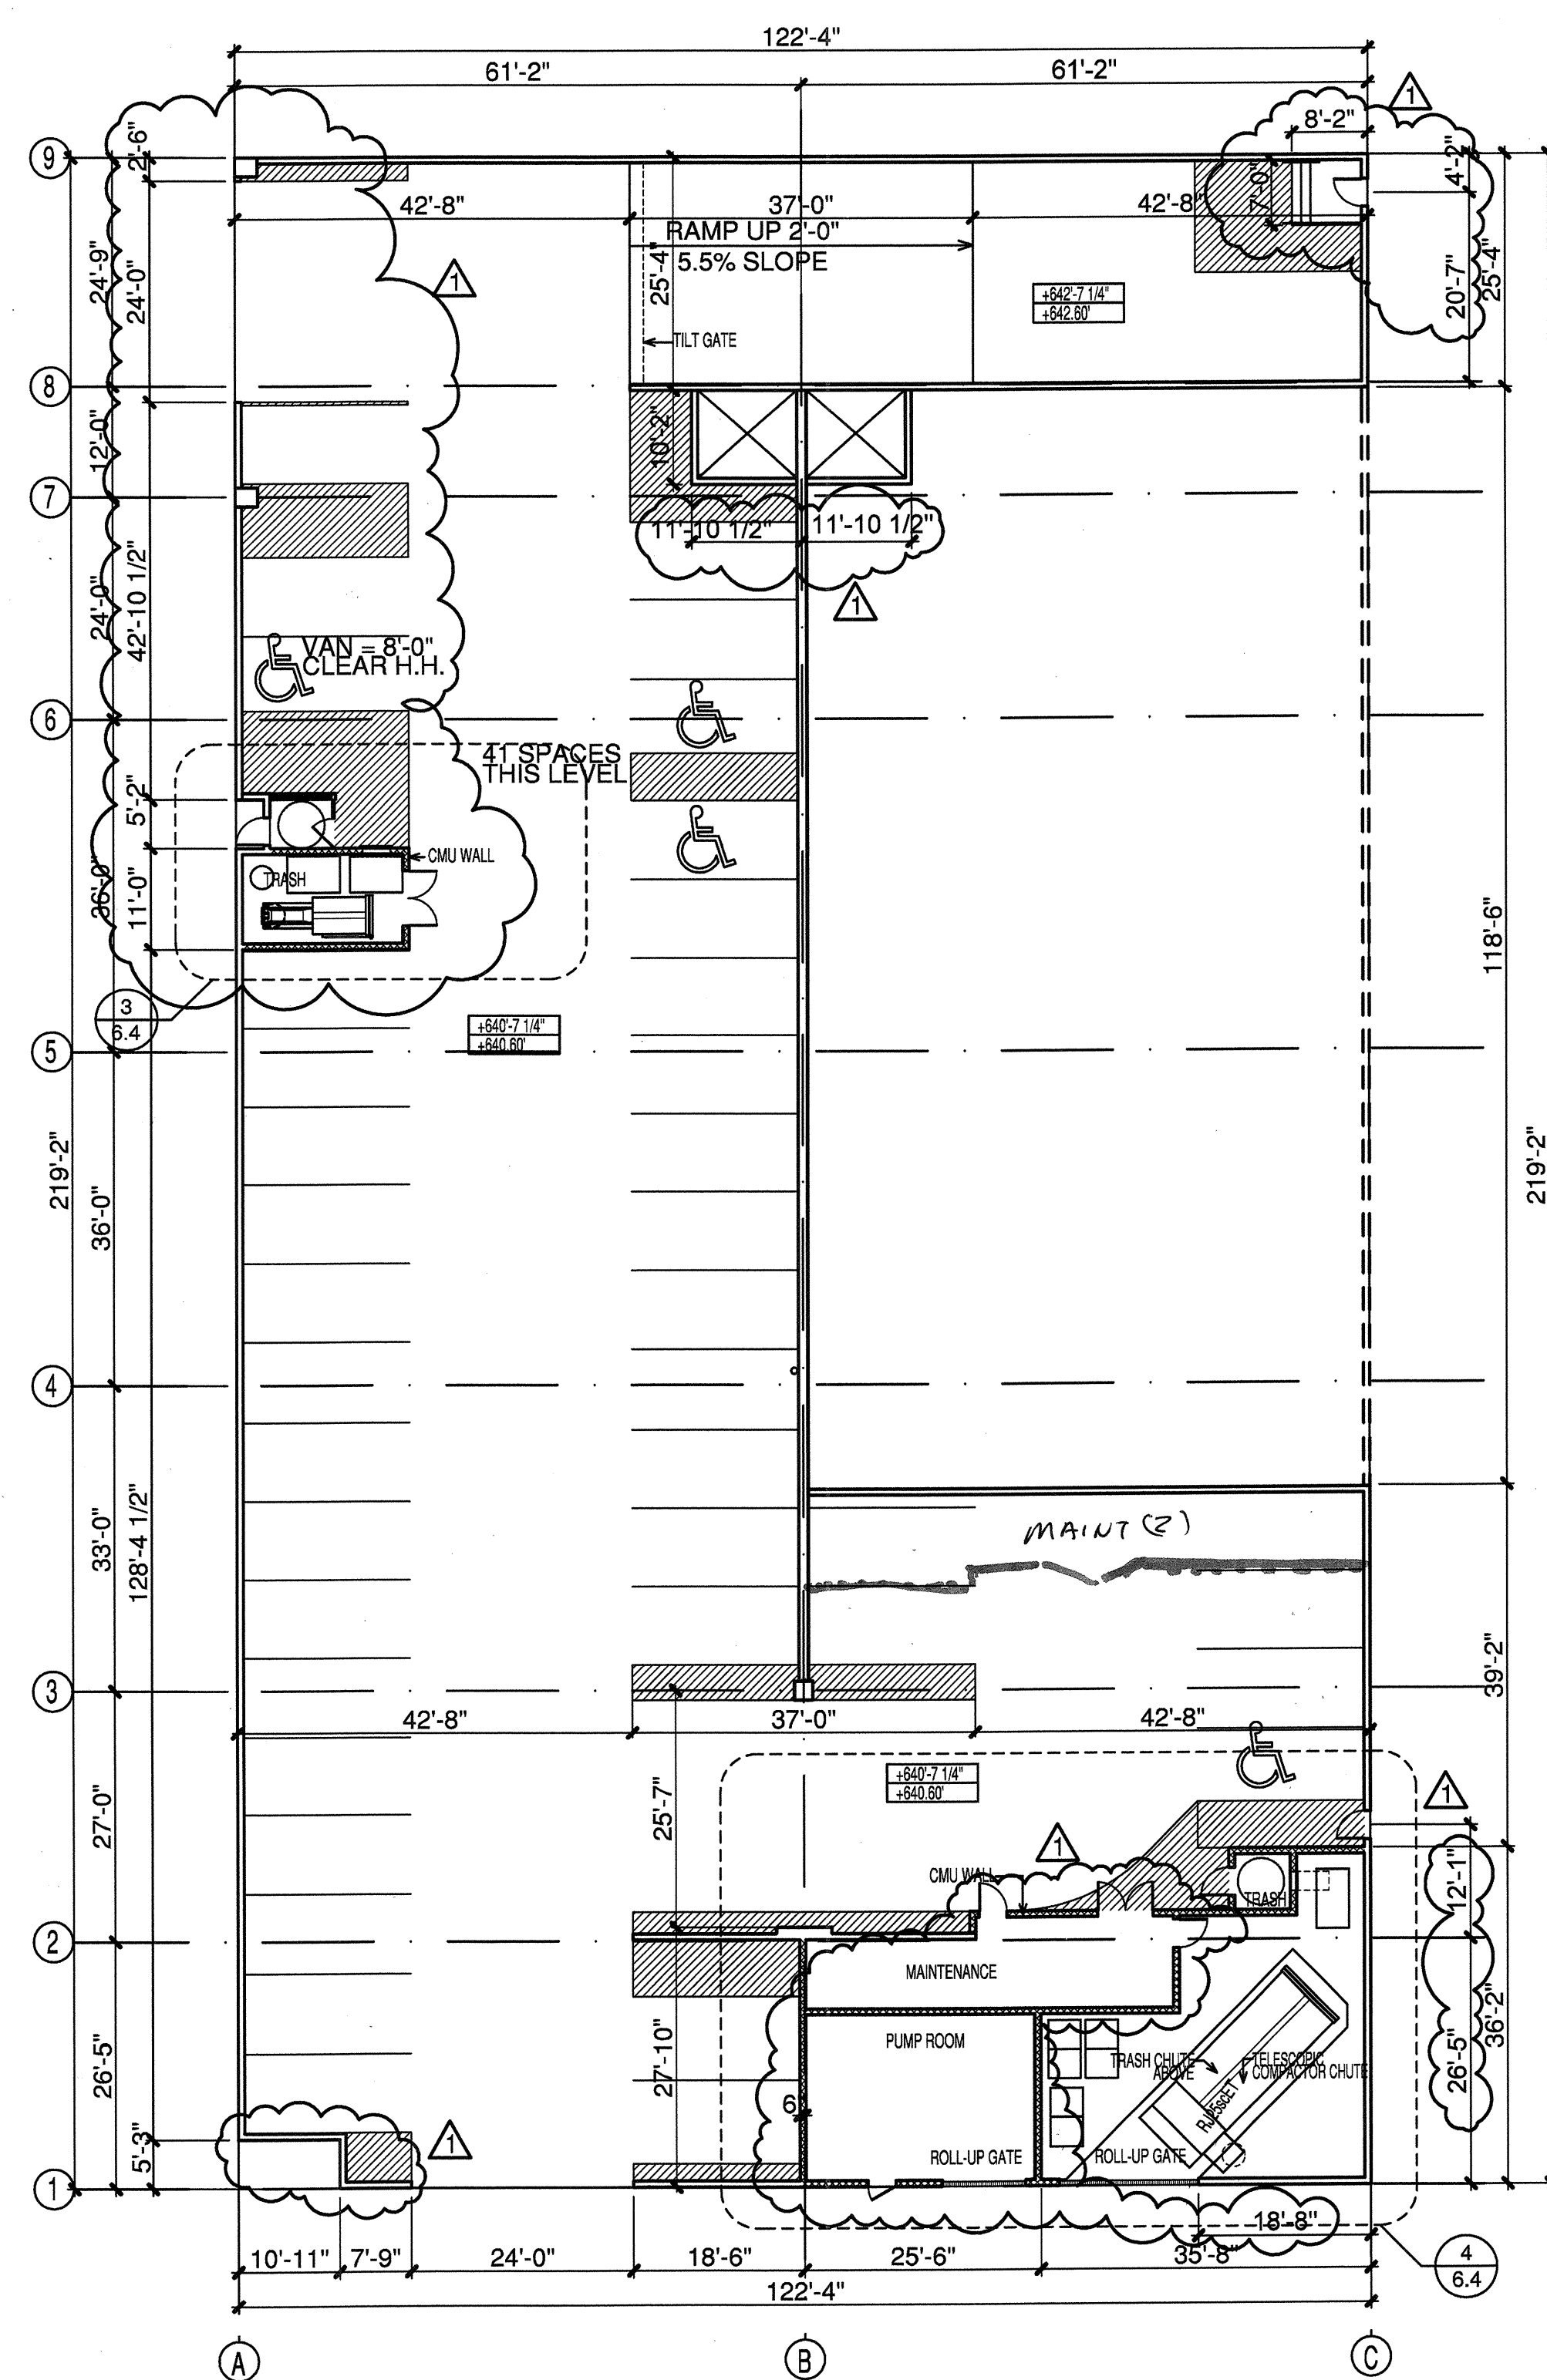

COPYRIGHT © Beeler Guest Owens Architects ALL RIGHTS RESERVED