



REVISIONS

△ GARAGE REVISIONS PER SHOP DWGS 01-03-2012

KELLER SPRINGS LOFTS

LOFT APARTMENTS IN ADDISON, TEXAS

CONSTRUCTION ISSUE
10-17-2011



4144 N. Central Expy.
Suite 855
Dallas, TX 75204
214.520.8878
bgoarchitects.com


DATE
08-05-2011

PROJECT
11129


SHEET NUMBER

6.3
GARAGE PLAN
4-6


COPYRIGHT © Beeler Guest Owens Architects ALL RIGHTS RESERVED

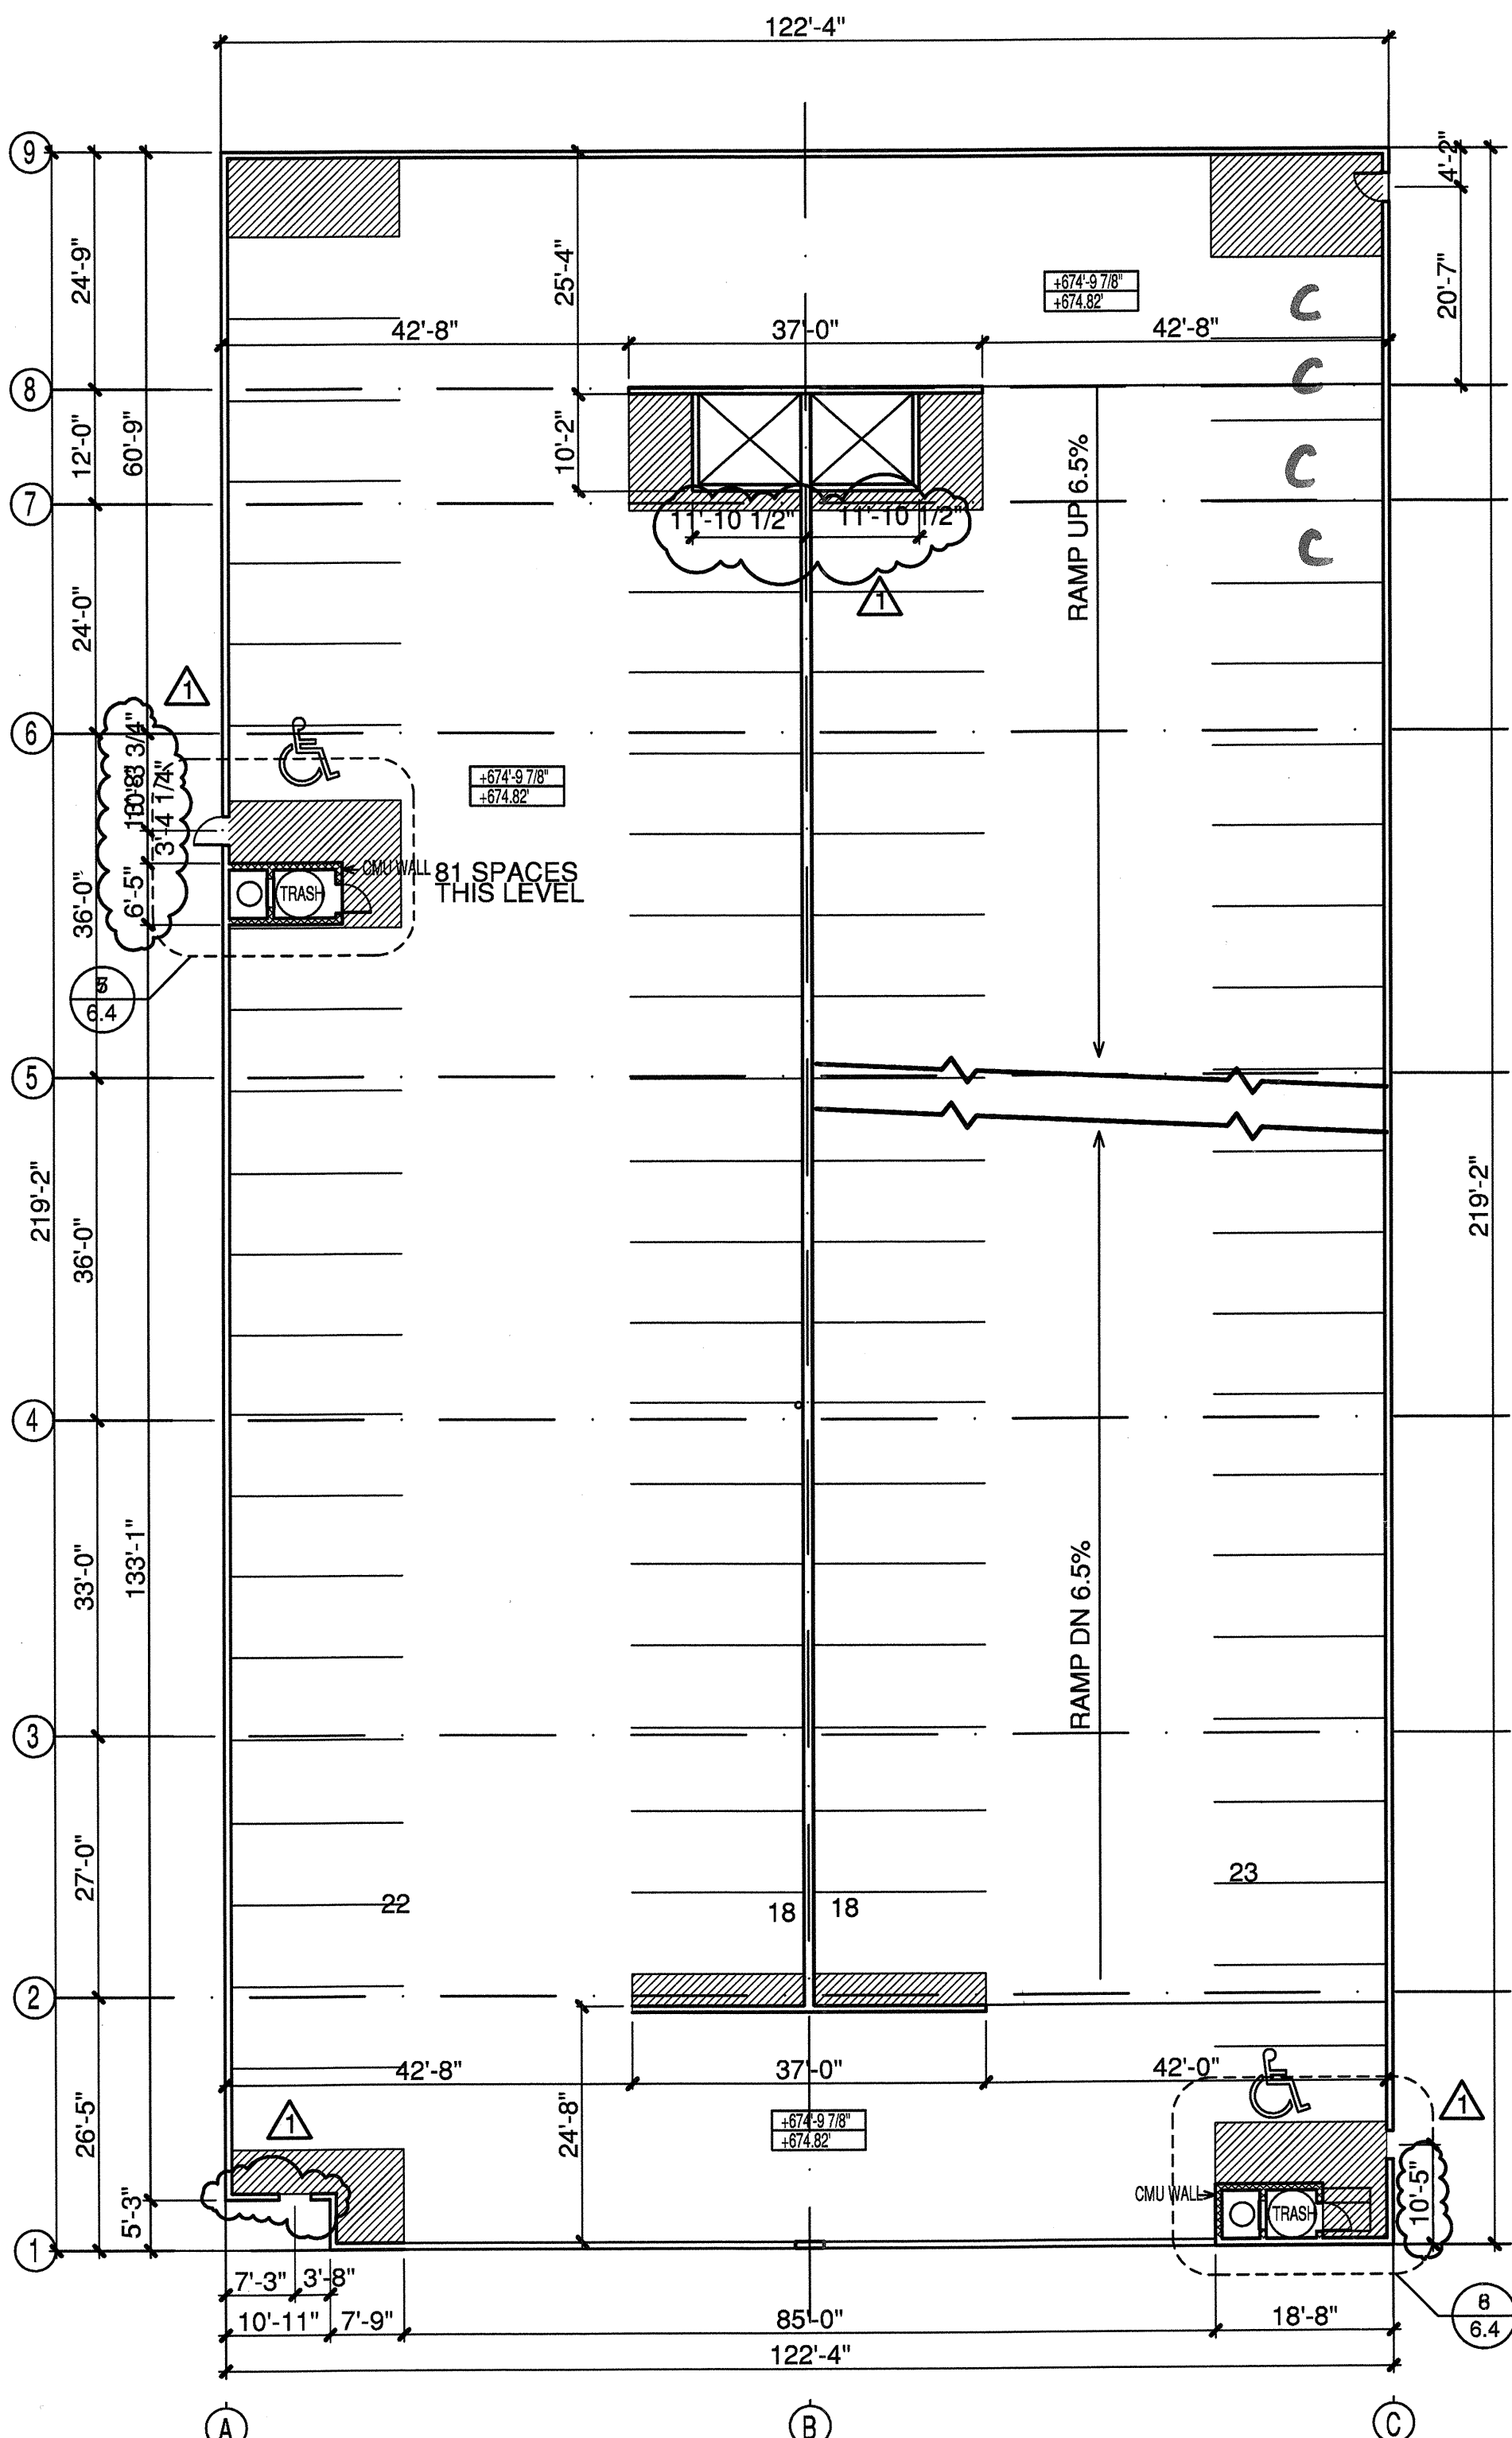

1 LEVEL 4
SCALE: 1/16"=1'-0"

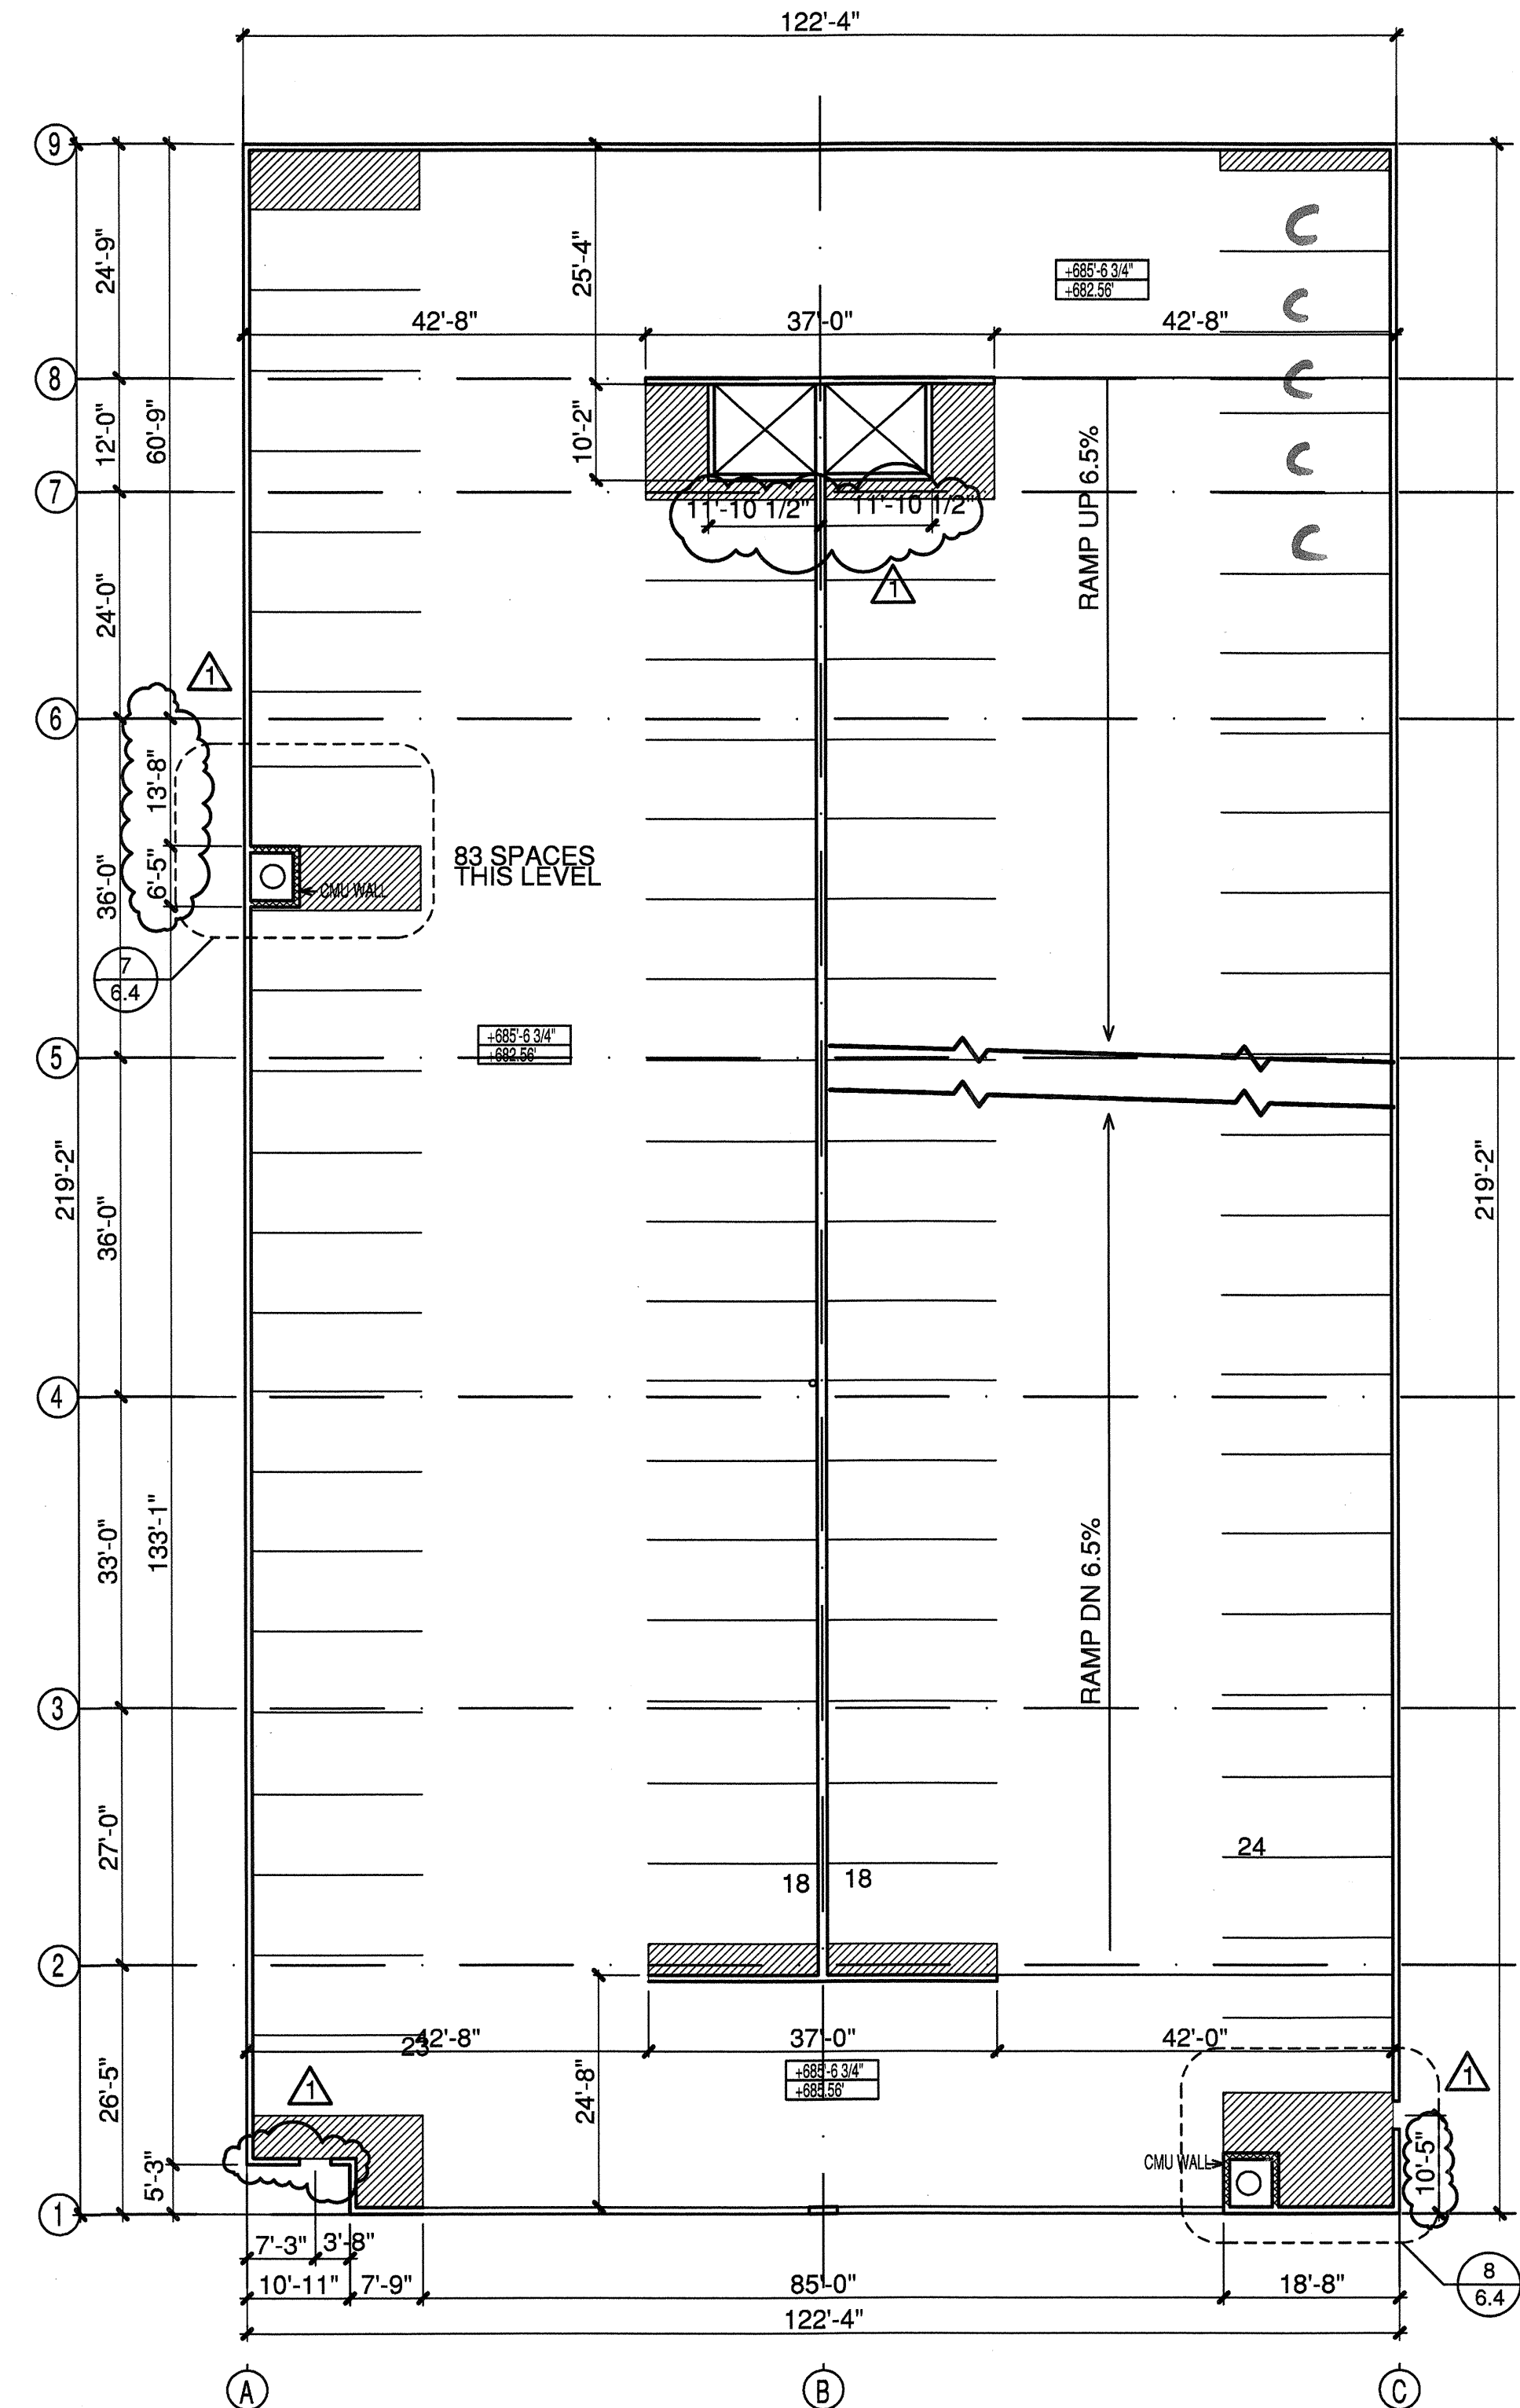

2 LEVEL 5
SCALE: 1/16"=1'-0"

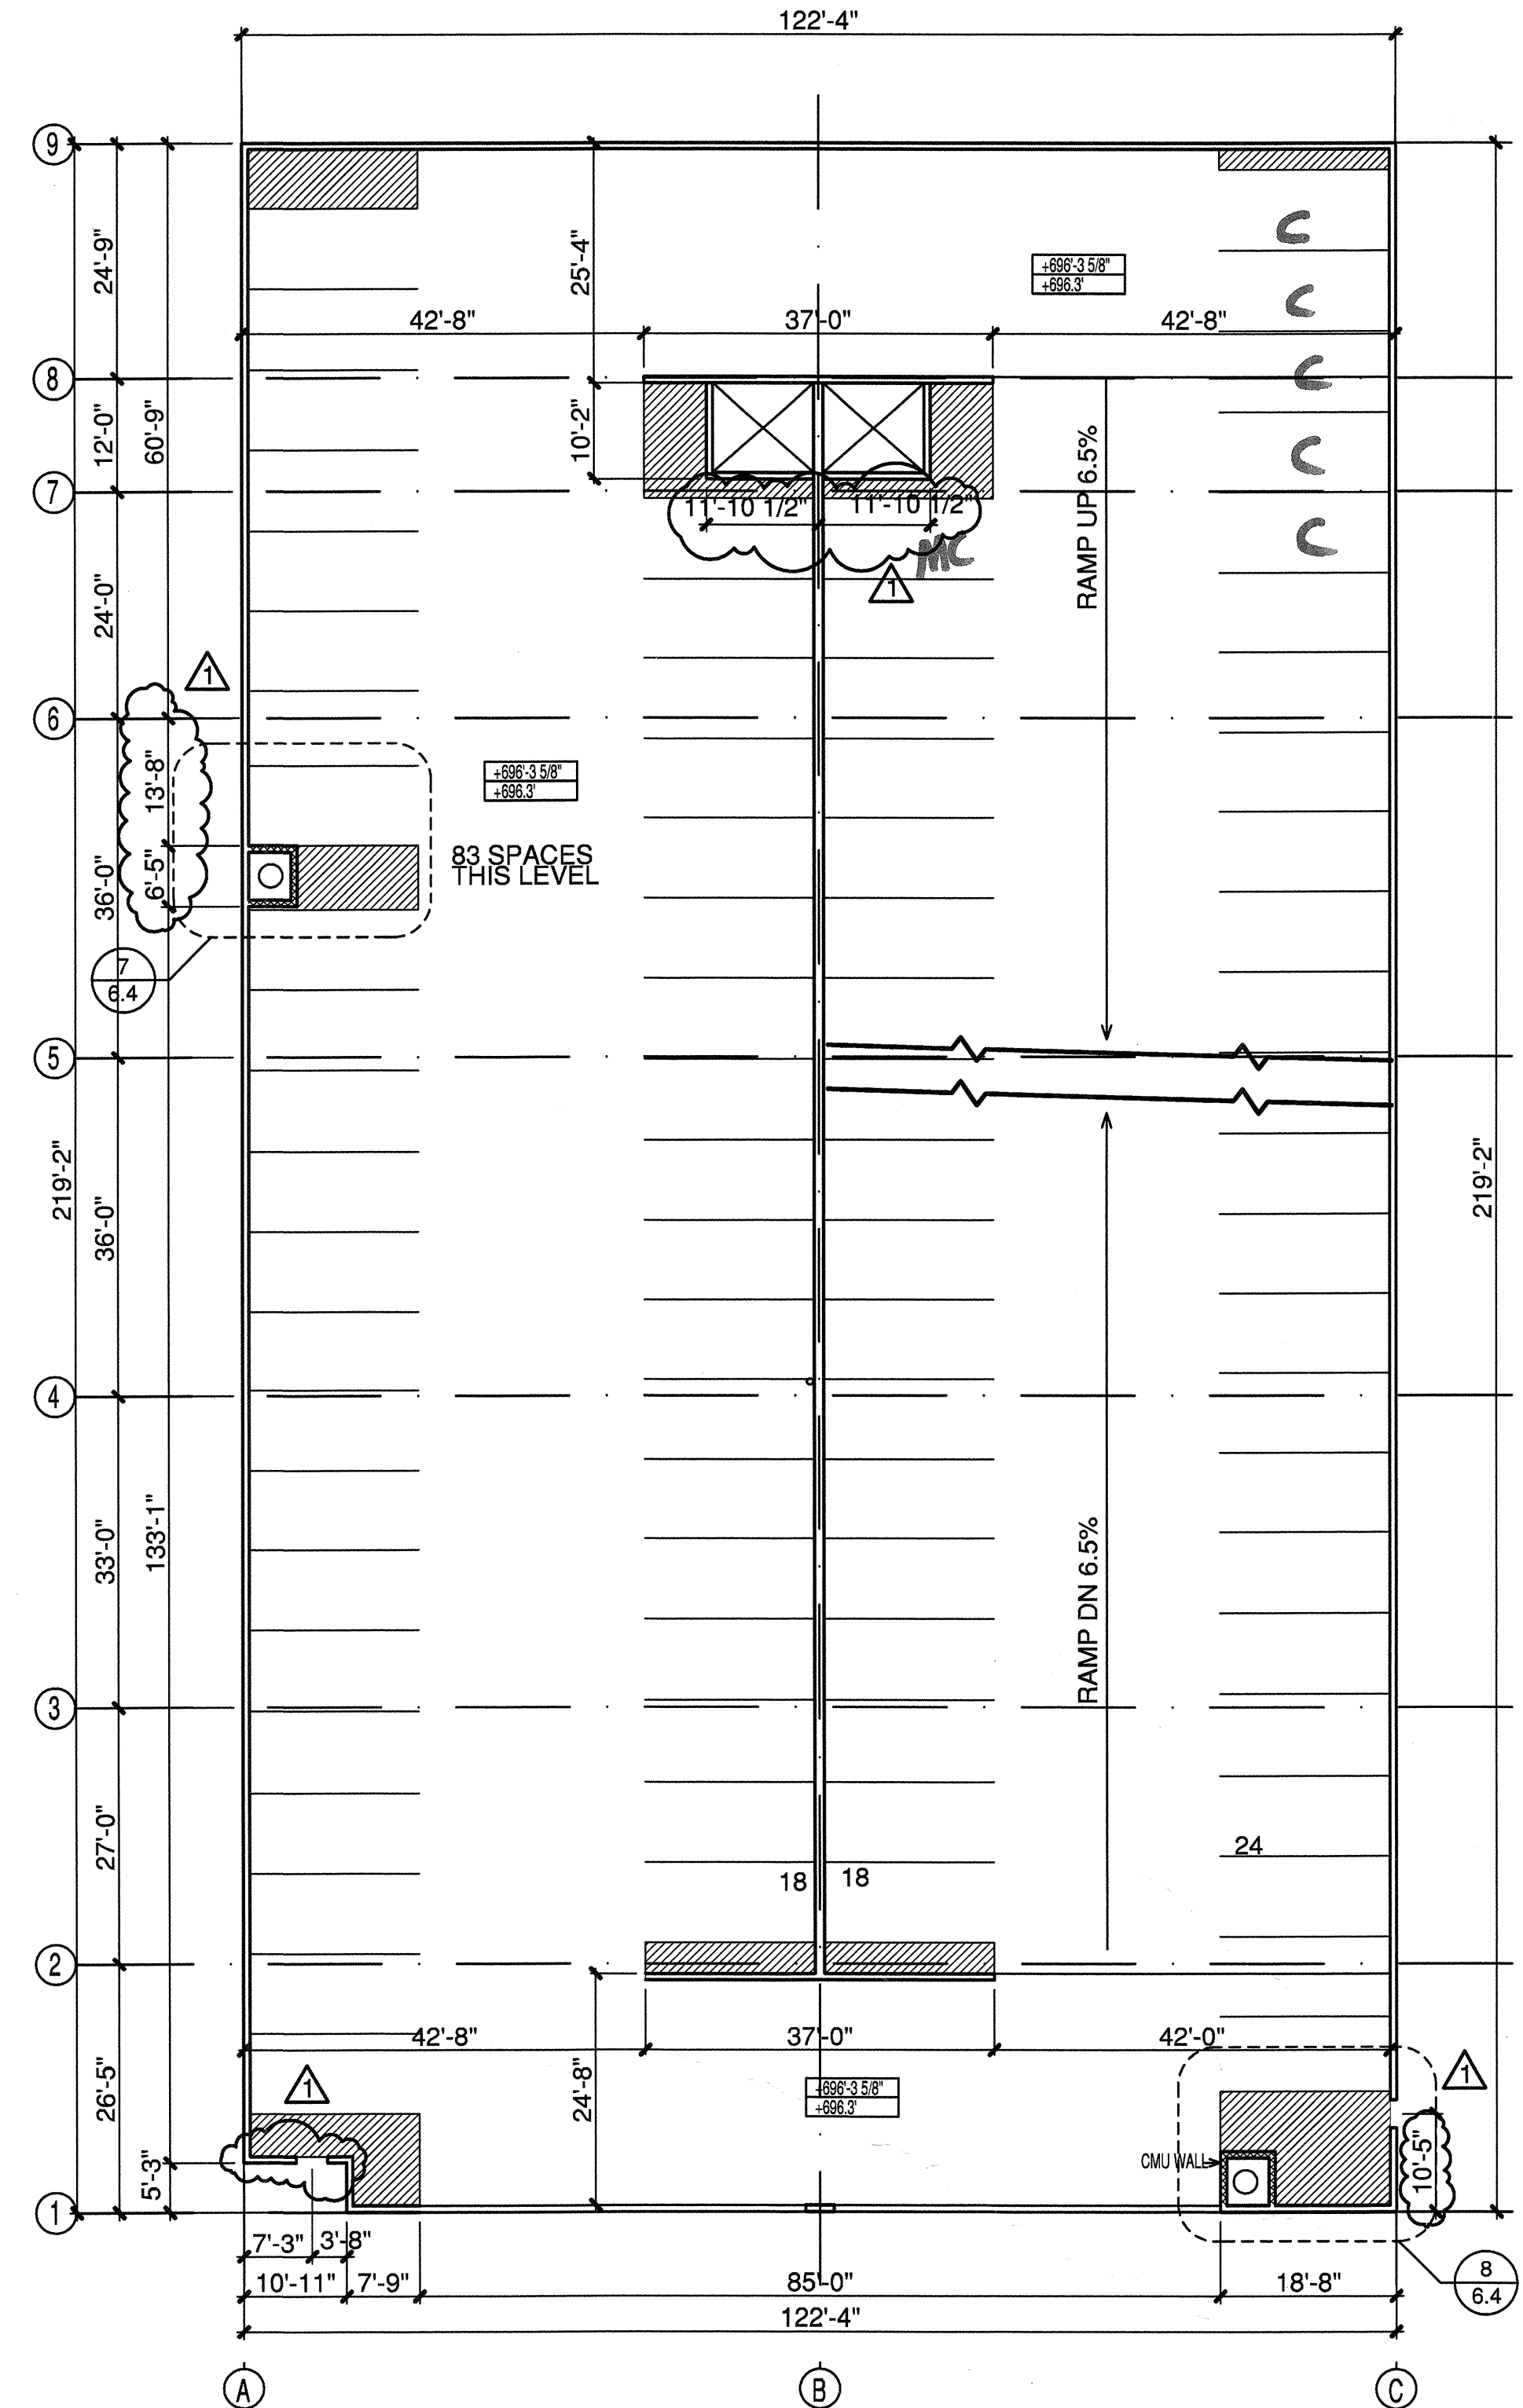

3 LEVEL 6
SCALE: 1/16"=1'-0"