




1 4-STORY IHR. FIRE PARTITION
 3/4"=1'-0"
 FIRE RATINGS:
 ROOF/CLG.-1 HR.-U.L. #P522
 FLOOR/CLG.-1 HR.-U.L. #L550
 WALL-1 HR.-U.L. U341
 SOUND RATINGS:
 FLOOR/CLG.-STC 58
 WITH FLOOR COVERING

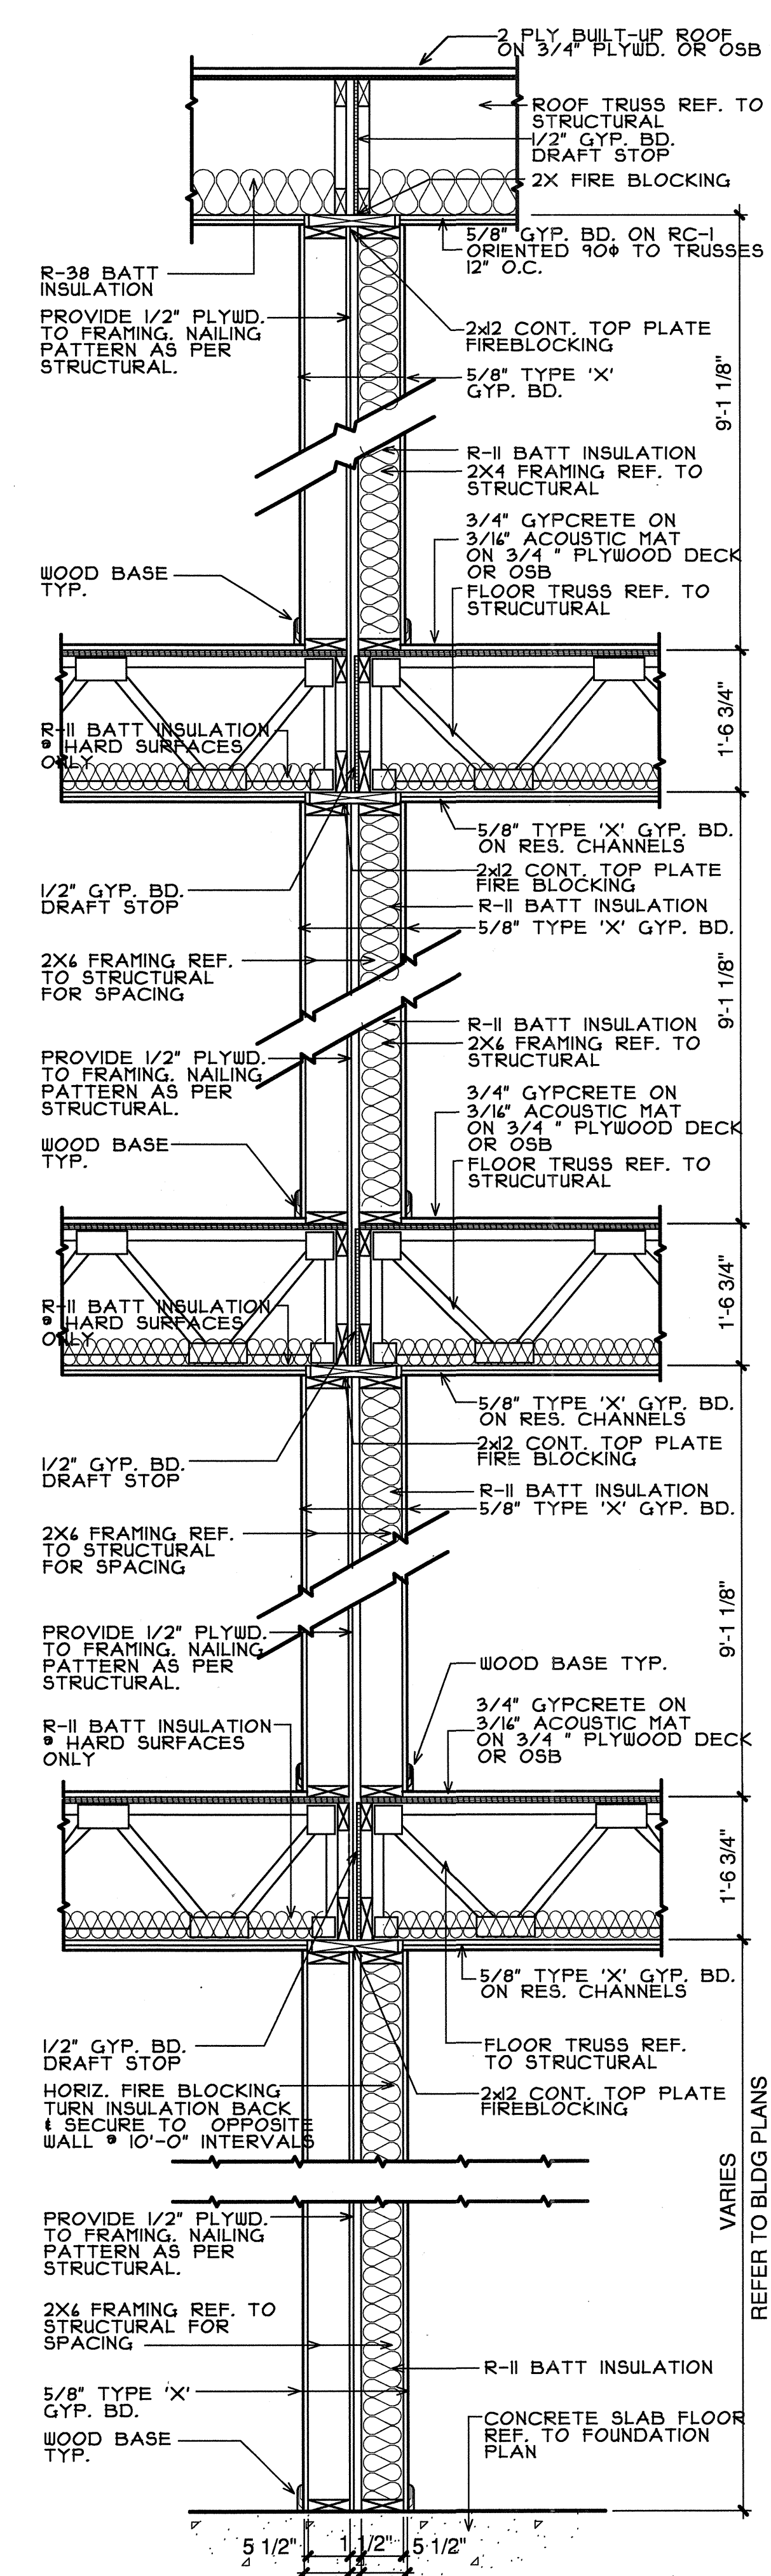


2 24-STORY PLUMBING WALL
 3/4"=1'-0"
 FIRE RATINGS:
 ROOF/CLG.-1 HR.-U.L. #P522
 FLOOR/CLG.-1 HR.-U.L. #L550
 WALL-1 HR.-U.L. U341
 SOUND RATINGS:
 FLOOR/CLG.-STC 58
 WITH FLOOR COVERING

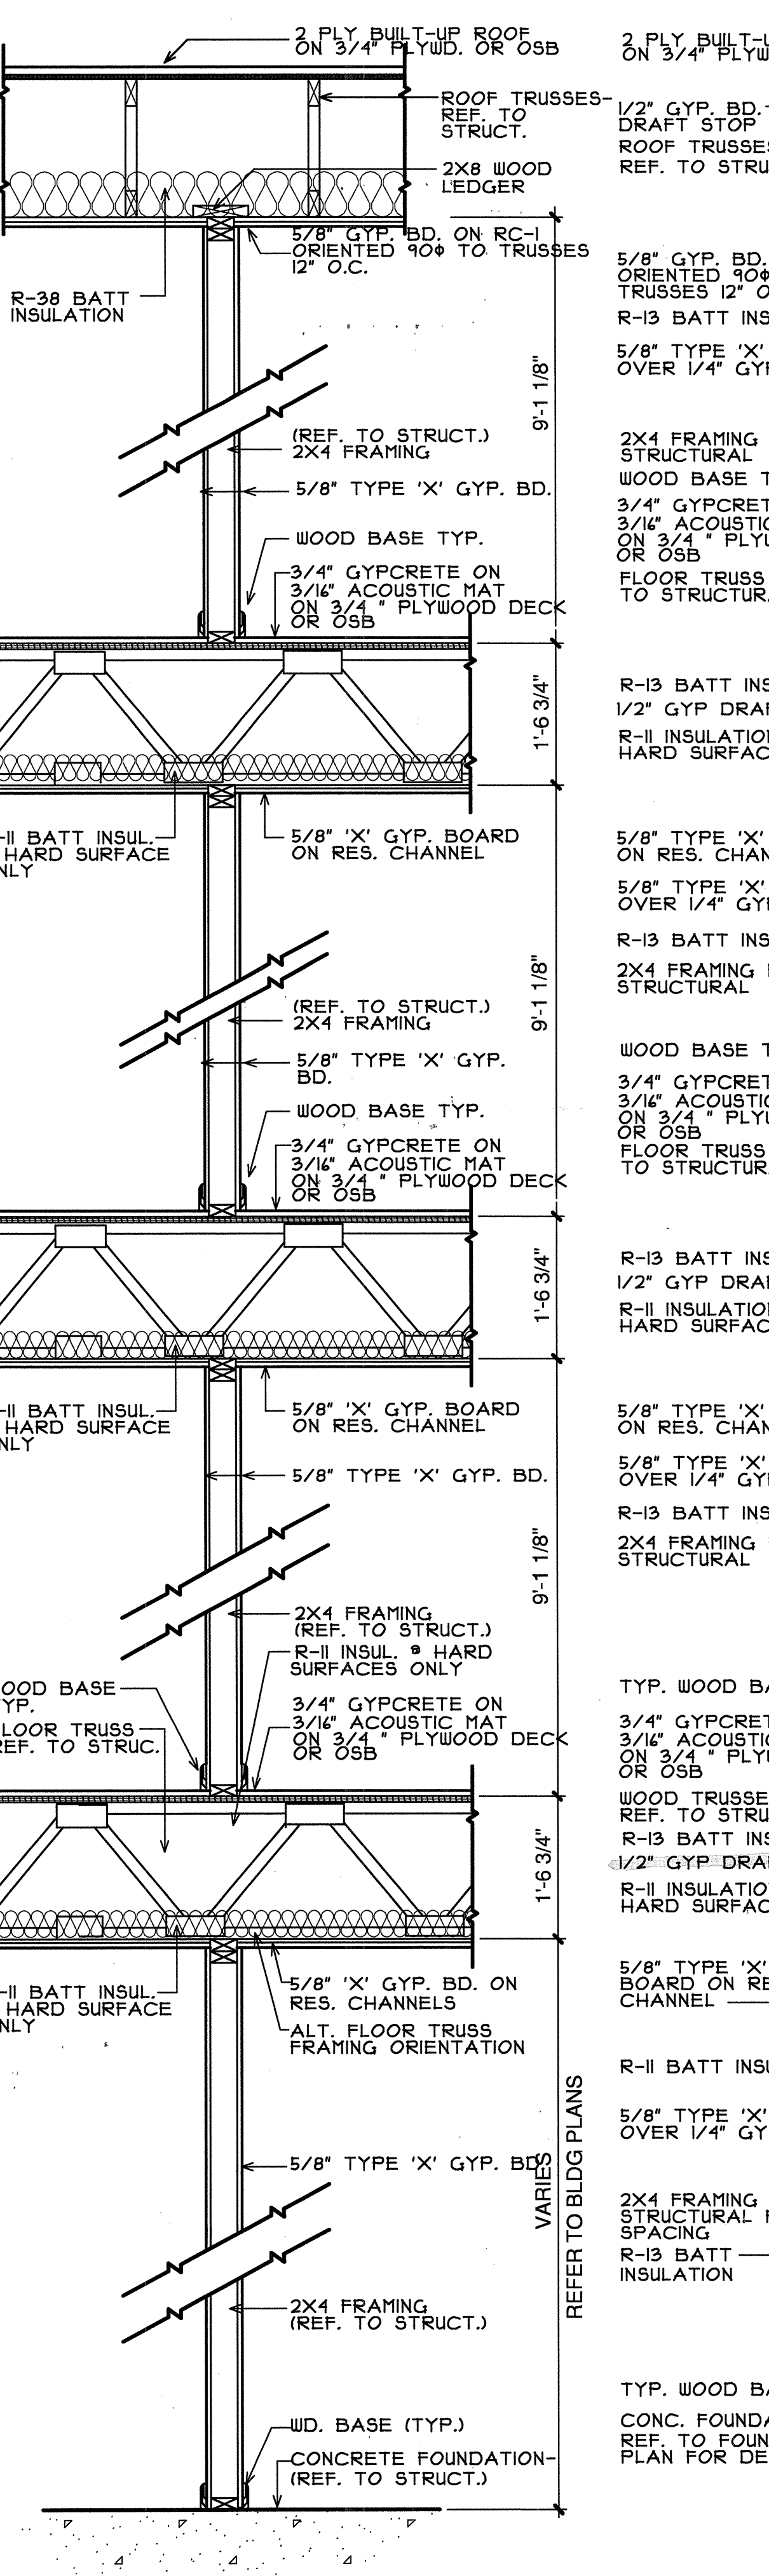


3 4-STORY INT. PARTITION
 3/4"=1'-0"
 FIRE RATINGS:
 ROOF/CLG.-1 HR.-U.L. #P522
 FLOOR/CLG.-1 HR.-U.L. #L550
 WALL-1 HR.-U.L. #U305
 SOUND RATINGS:
 FLOOR CLG.-STC 58
 WITH FLOOR COVERING

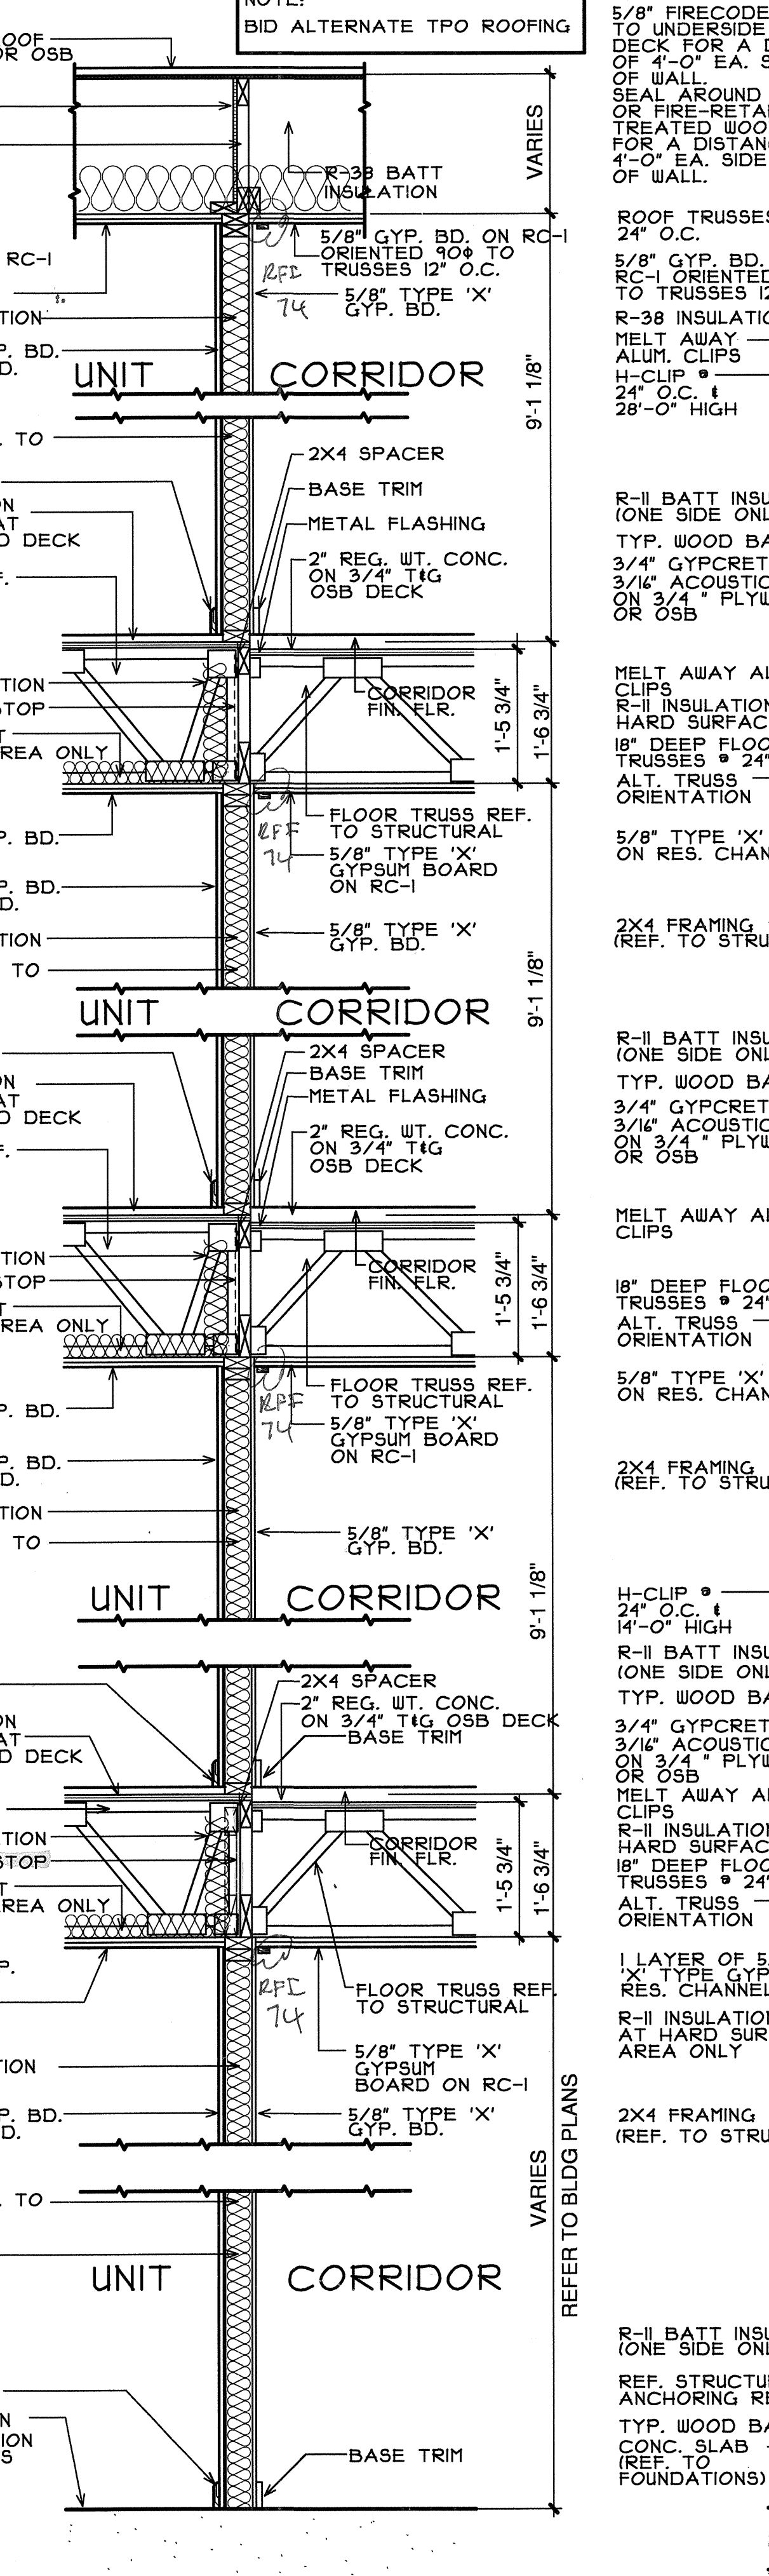

4 CORRIDOR IHR. FIRE PARTITION
 3/4"=1'-0"
 FIRE RATINGS:
 ROOF/CLG.-1 HR.-U.L. #P522
 FLOOR/CLG.-1 HR.-U.L. #L550
 WALL-1 HR.-U.L. U305
 SOUND RATING:
 FLOOR/CLG.-STC 58
 WITH FLOOR COVERING

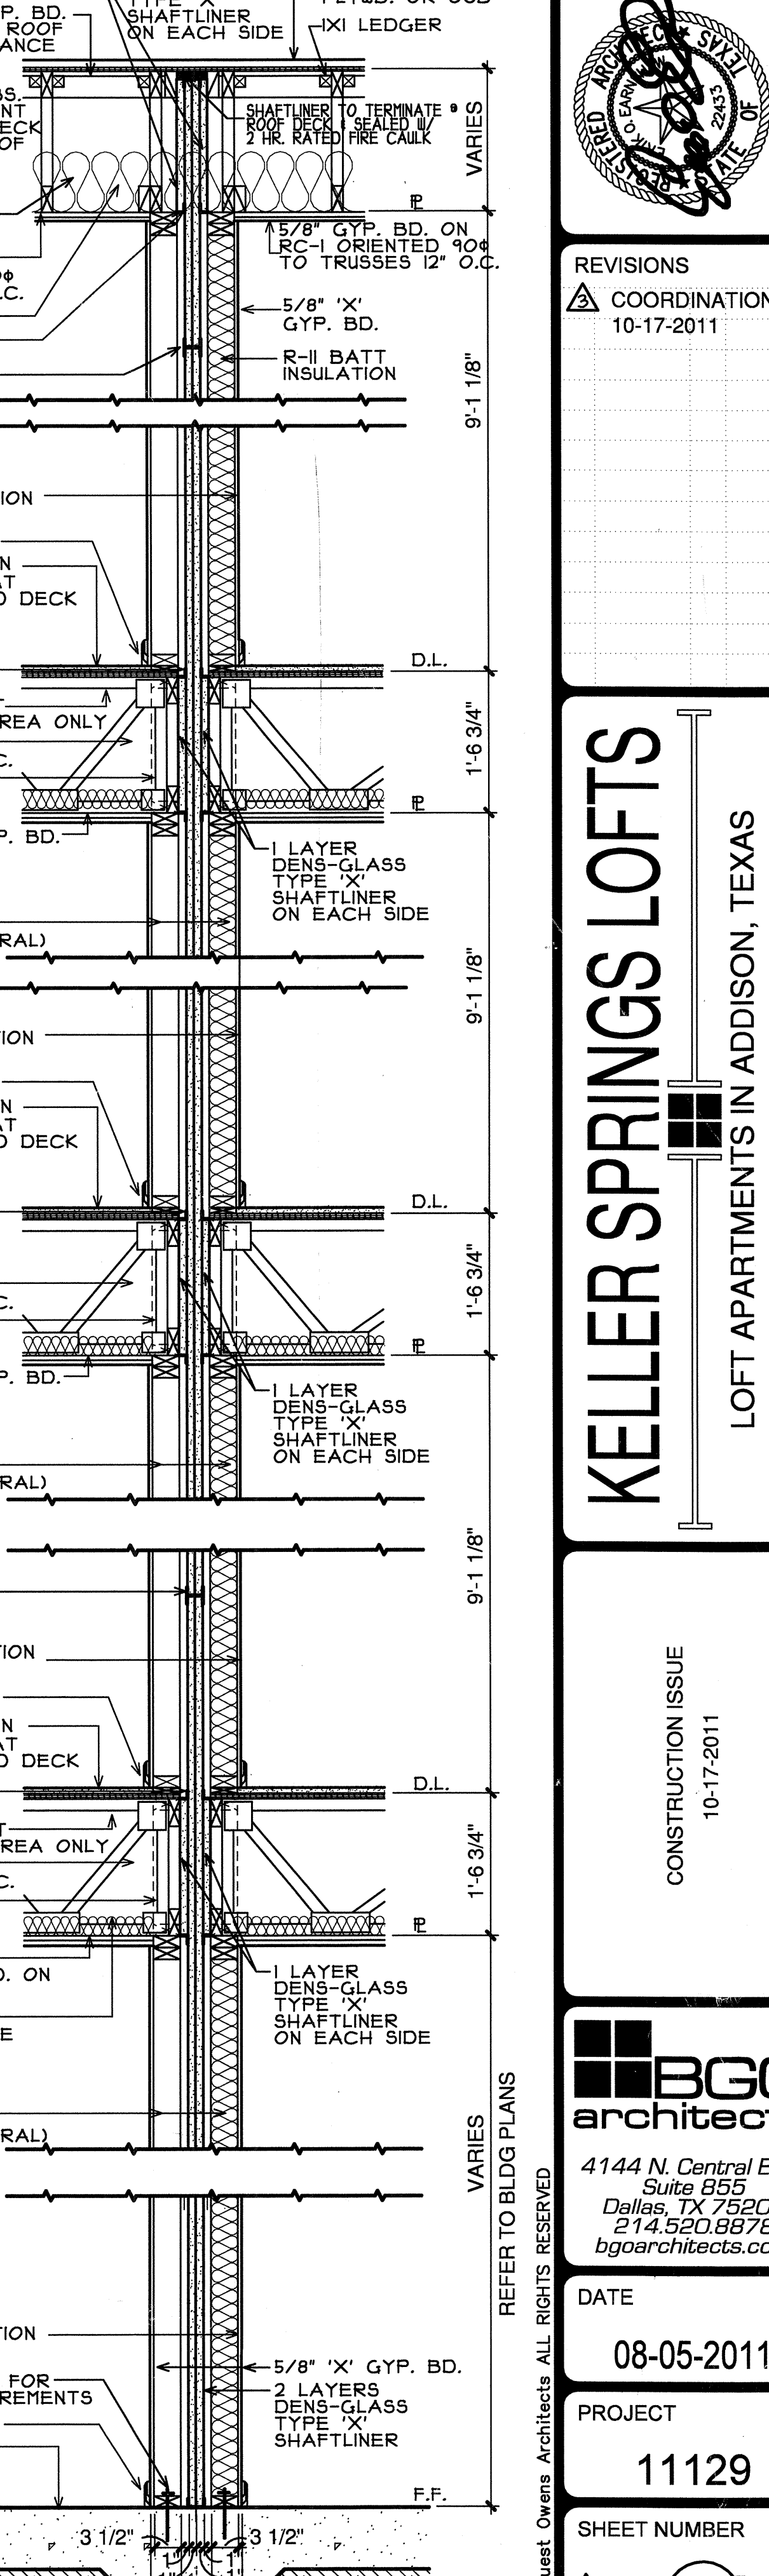

5 52-HR. FIRE WALL PARTITION
 3/4"=1'-0"
 FIRE RATINGS:
 ROOF/CLG.-1 HR.-U.L. #P522
 FLOOR/CLG.-1 HR.-U.L. #L550
 WALL-2 HR.-U.L. U341
 SOUND RATING:
 FLOOR/CLG.-STC 58
 WITH FLOOR COVERING

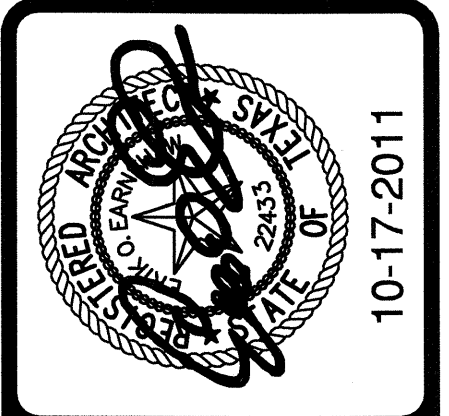

REVISIONS
 COORDINATION
 10-17-2011

KELLER SPRINGS LOFTS
 LOFT APARTMENTS IN ADDISON, TEXAS

CONSTRUCTION ISSUE
 10-17-2011

BGO architects
 4144 N. Central Exp.
 Suite 855
 Dallas, TX 75204
 214.520.8878
 bgoarchitects.com

DATE
 08-05-2011

PROJECT
 11129

SHEET NUMBER

7.1
 4 ST. WALL

COPYRIGHT © Beeler Owens Architects All Rights Reserved