



NOTE:
 BID ALTERNATE TPO ROOFING
 NOTE # ALL FOAM DETAIL LOCATIONS:
 5/8" MAGMA-WALL STUCCO
 ON 1/2" GYP. SHEATHING
 STUCCO ON PELL ON 1/2" GYP. SHEATHING

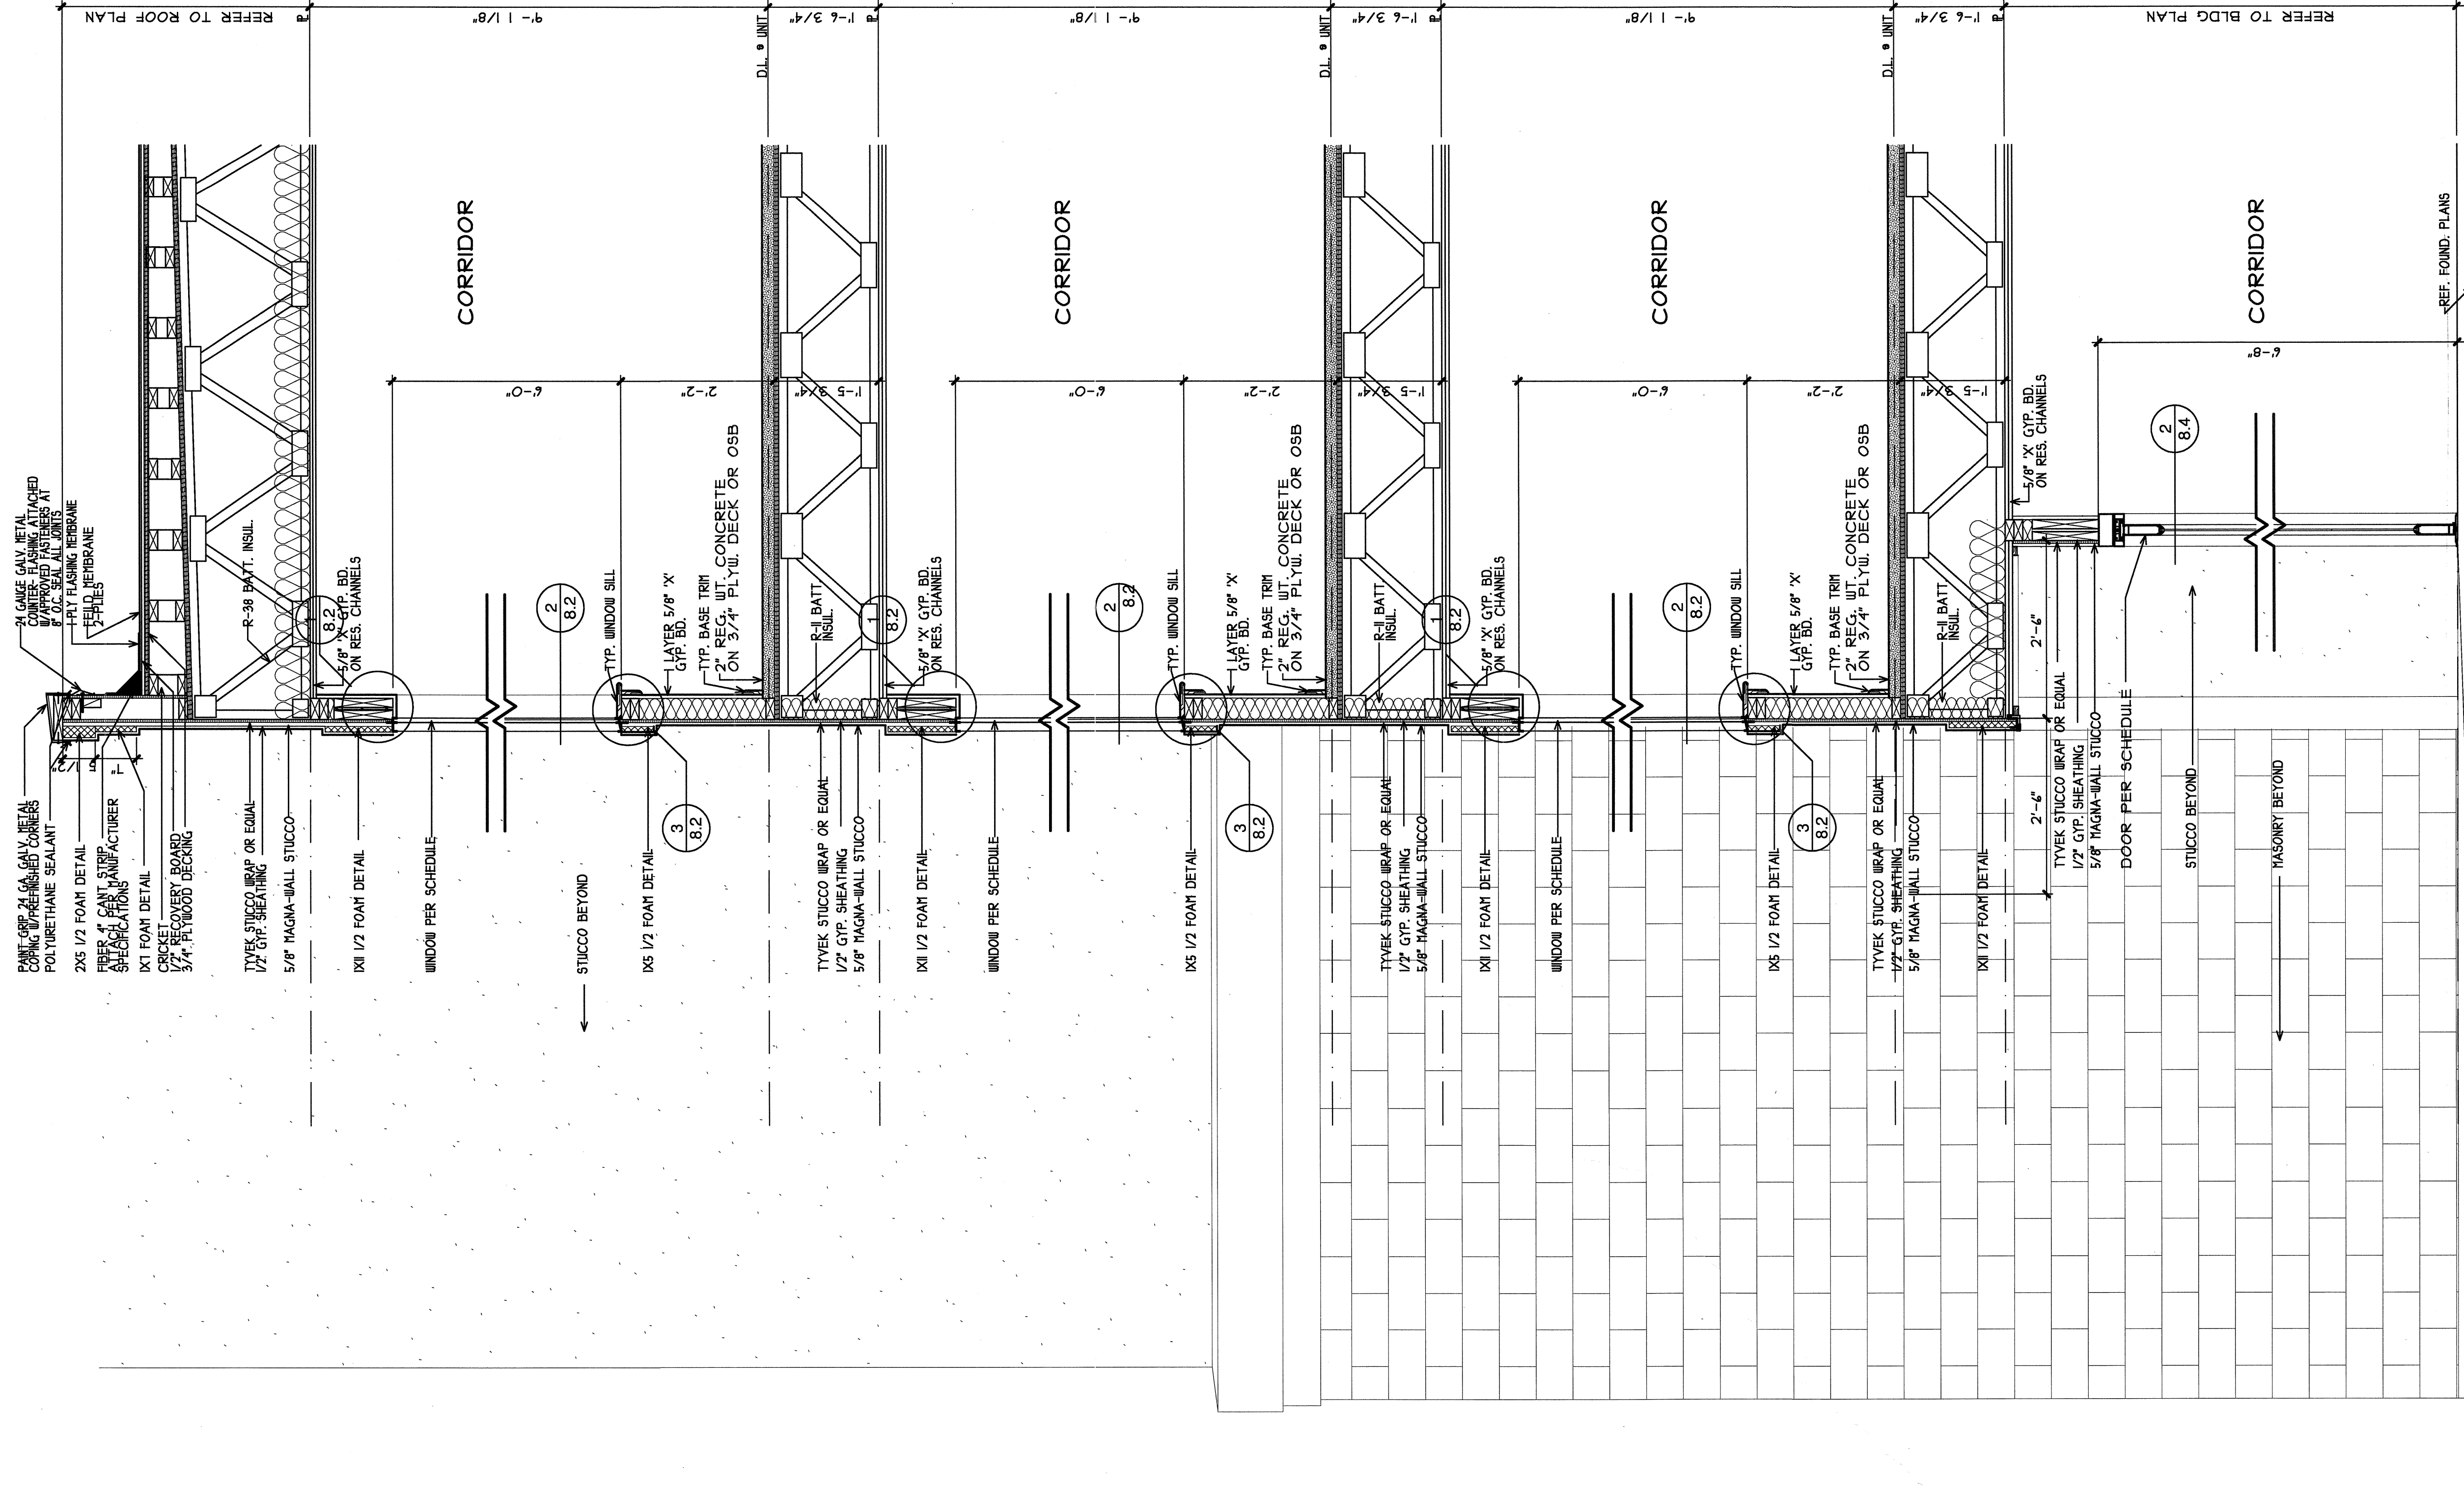

FIRE RATINGS:
 ROOF/CLG-1 HR.-UL #F522
 FLOOR/CLG-1 HR.-UL #L550
 WALL/CLG-1 HR.-UL #W520
 WHER-481'S STUCCO

SOUND RATINGS:
 FLOOR/CLG-STC (210) REQ.†
 WITH FLOOR COVERING

1 4-STORY ENTRY ELEVATOR LOBBY - STUCCO
 3/4"=1'-0"

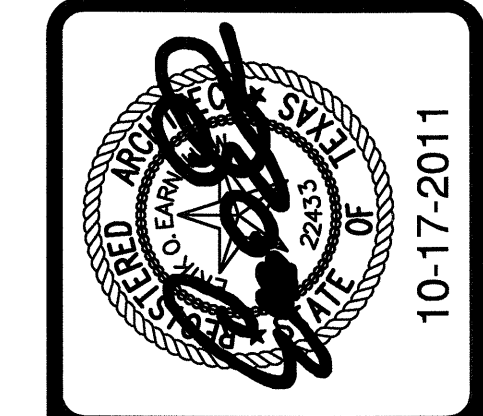

REVISIONS

COORDINATION	10-17-2011
--------------	------------

KELLER SPRINGS LOFTS
 LOFT APARTMENTS IN ADDISON, TEXAS

CONSTRUCTION ISSUE
 10-17-2011

BGO
 architects
 4144 N. Central Expy.
 Suite 855
 Dallas, TX 75204
 214.520.8878
 bgoarchitects.com

DATE
 08-05-2011

PROJECT
 11129

SHEET NUMBER

7.10
 4 ST. WALL

COPYRIGHT © Bessler, Guest, Owens Architects. ALL RIGHTS RESERVED.