



NOTE • ALL FOAM DETAIL LOCATIONS:  
 5/8" MAGNA-WALL STUCCO ON FOAM DETAIL ON 5/8" MAGNA-WALL STUCCO ON FELT ON 1/2" TYVEK STUCCOWRAP ON 1/2" GYP. SHEATHING

NOTE:  
 BID ALTERNATE TPO ROOFING

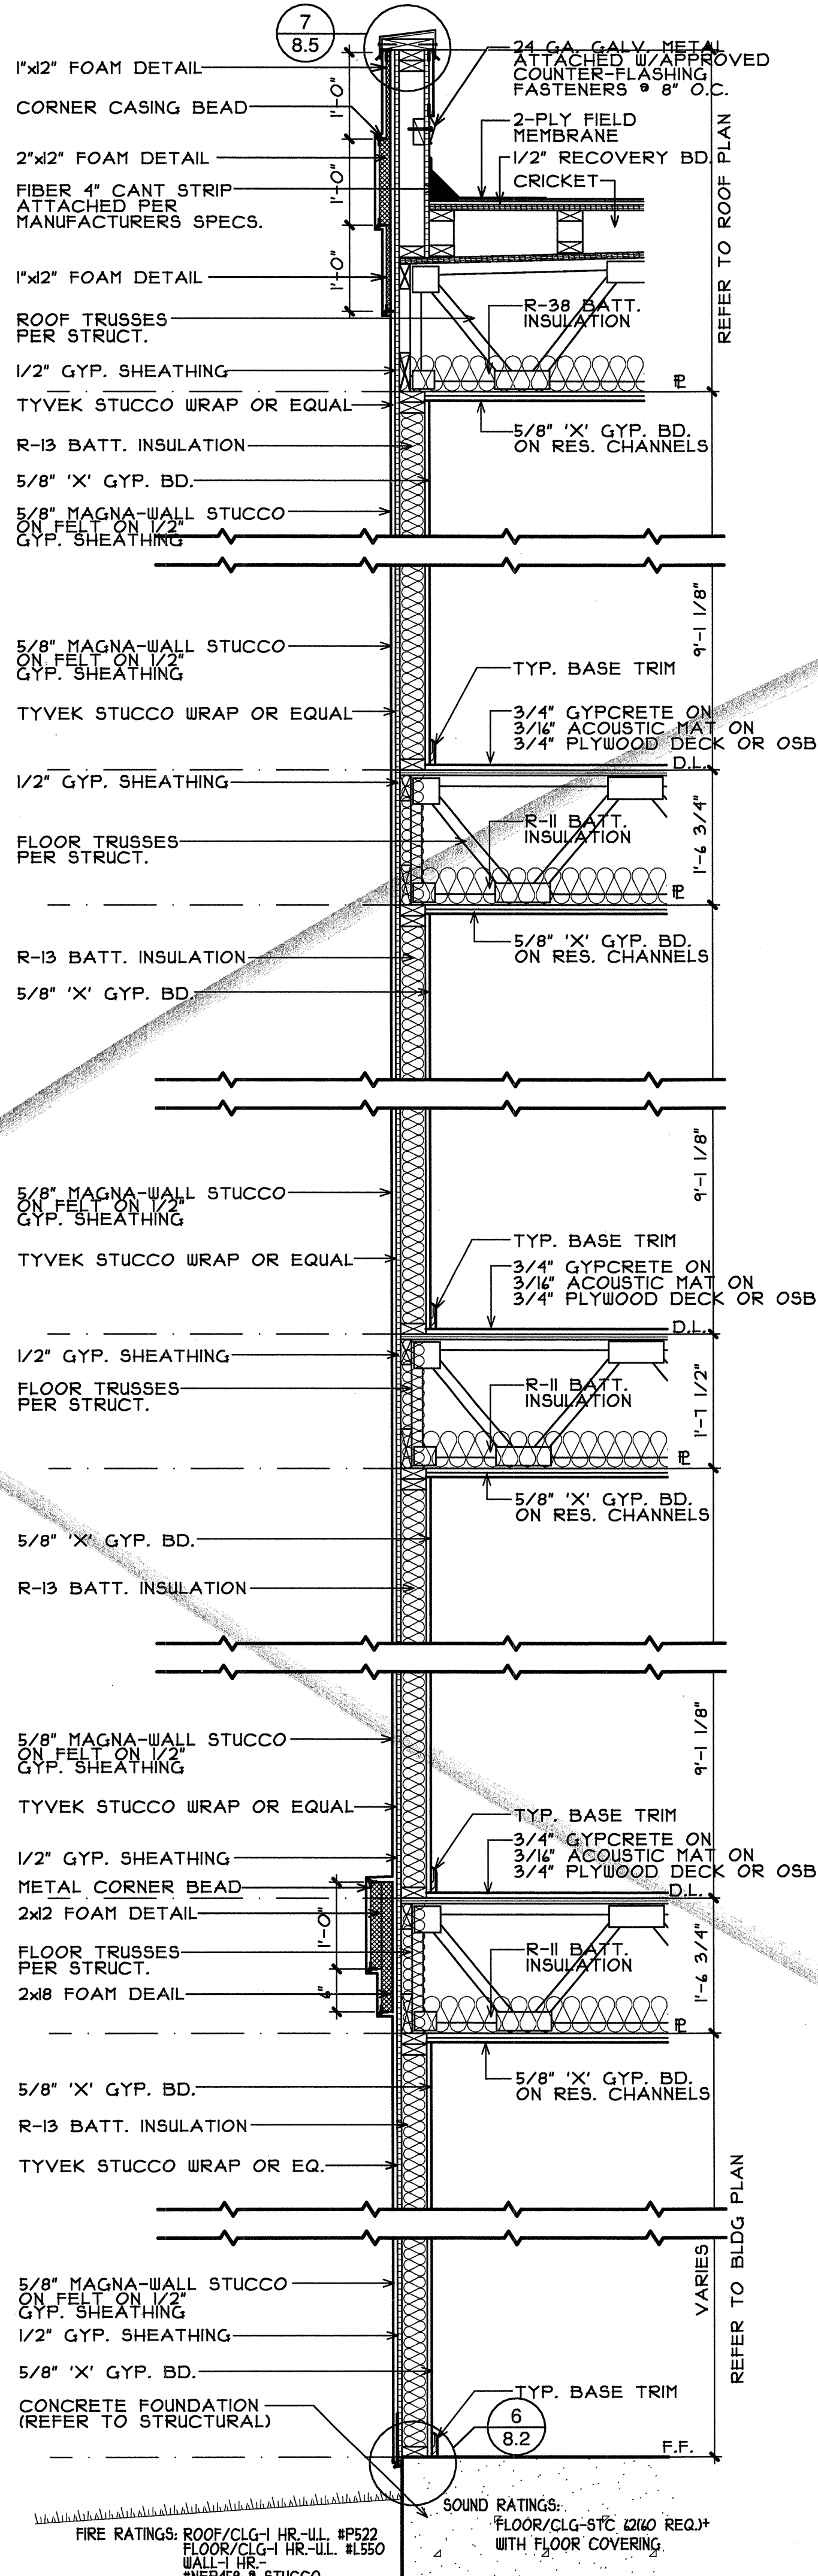

**3 3/4" STORY EXT. STUCCO WALL**

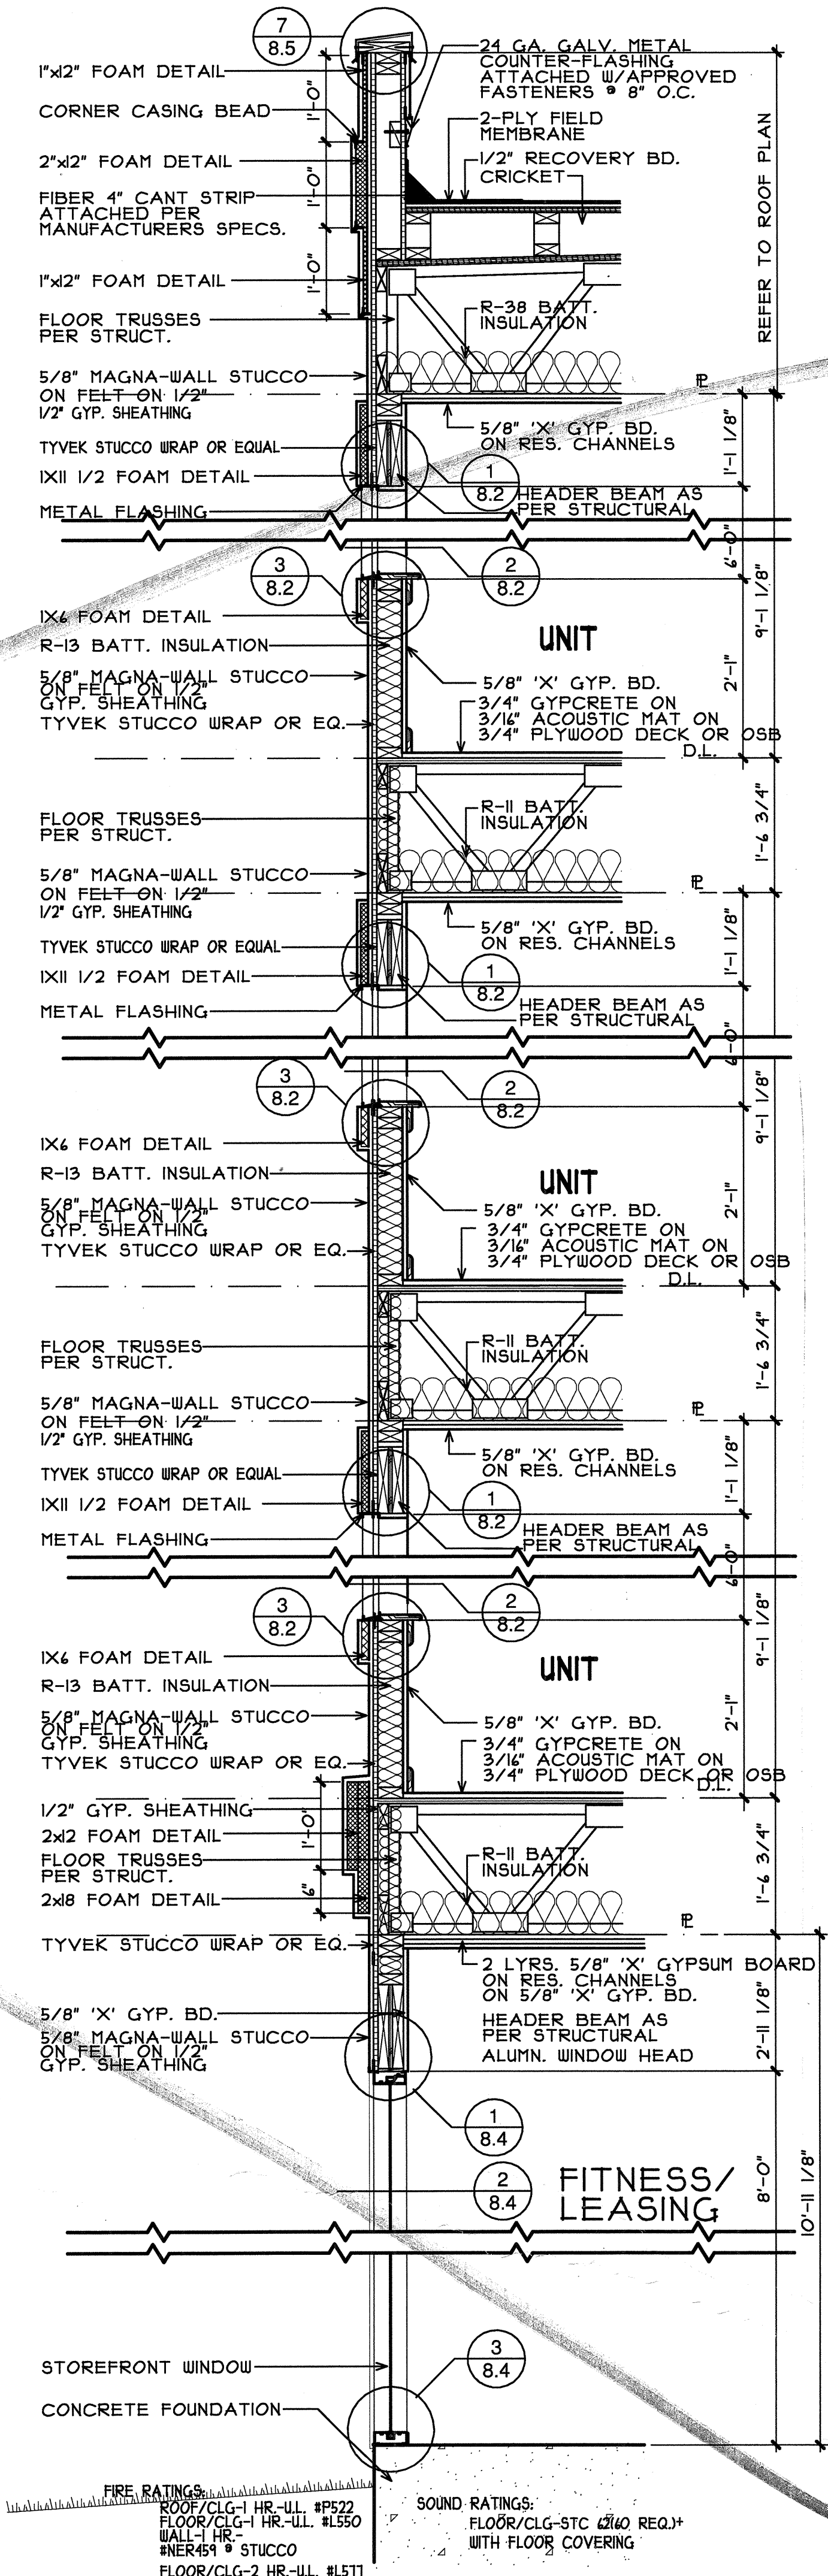

**4 3/4" STORY EXT. STUCCO WALL • CLUB**

**1 NOT USED**  
 3/4"=1'-0"

**2 NOT USED**  
 3/4"=1'-0"



10-17-2011

REVISIONS  
 COORDINATION  
 10-17-2011

**KELLER SPRINGS LOFTS**  
 LOFT APARTMENTS IN ADDISON, TEXAS

CONSTRUCTION ISSUE  
 10-17-2011



4144 N. Central Exp., Suite 855  
 Dallas, TX 75204  
 214.520.8878  
 bgoarchitects.com

DATE  
 08-05-2011

PROJECT  
 11129

SHEET NUMBER

**7.2**

**4 ST. WALL**

COPYRIGHT © Beeler, Owens Architects ALL RIGHTS RESERVED