




1 1-STORY EXT. STUCCO • WINDOW
3/4\"=1'-0\"

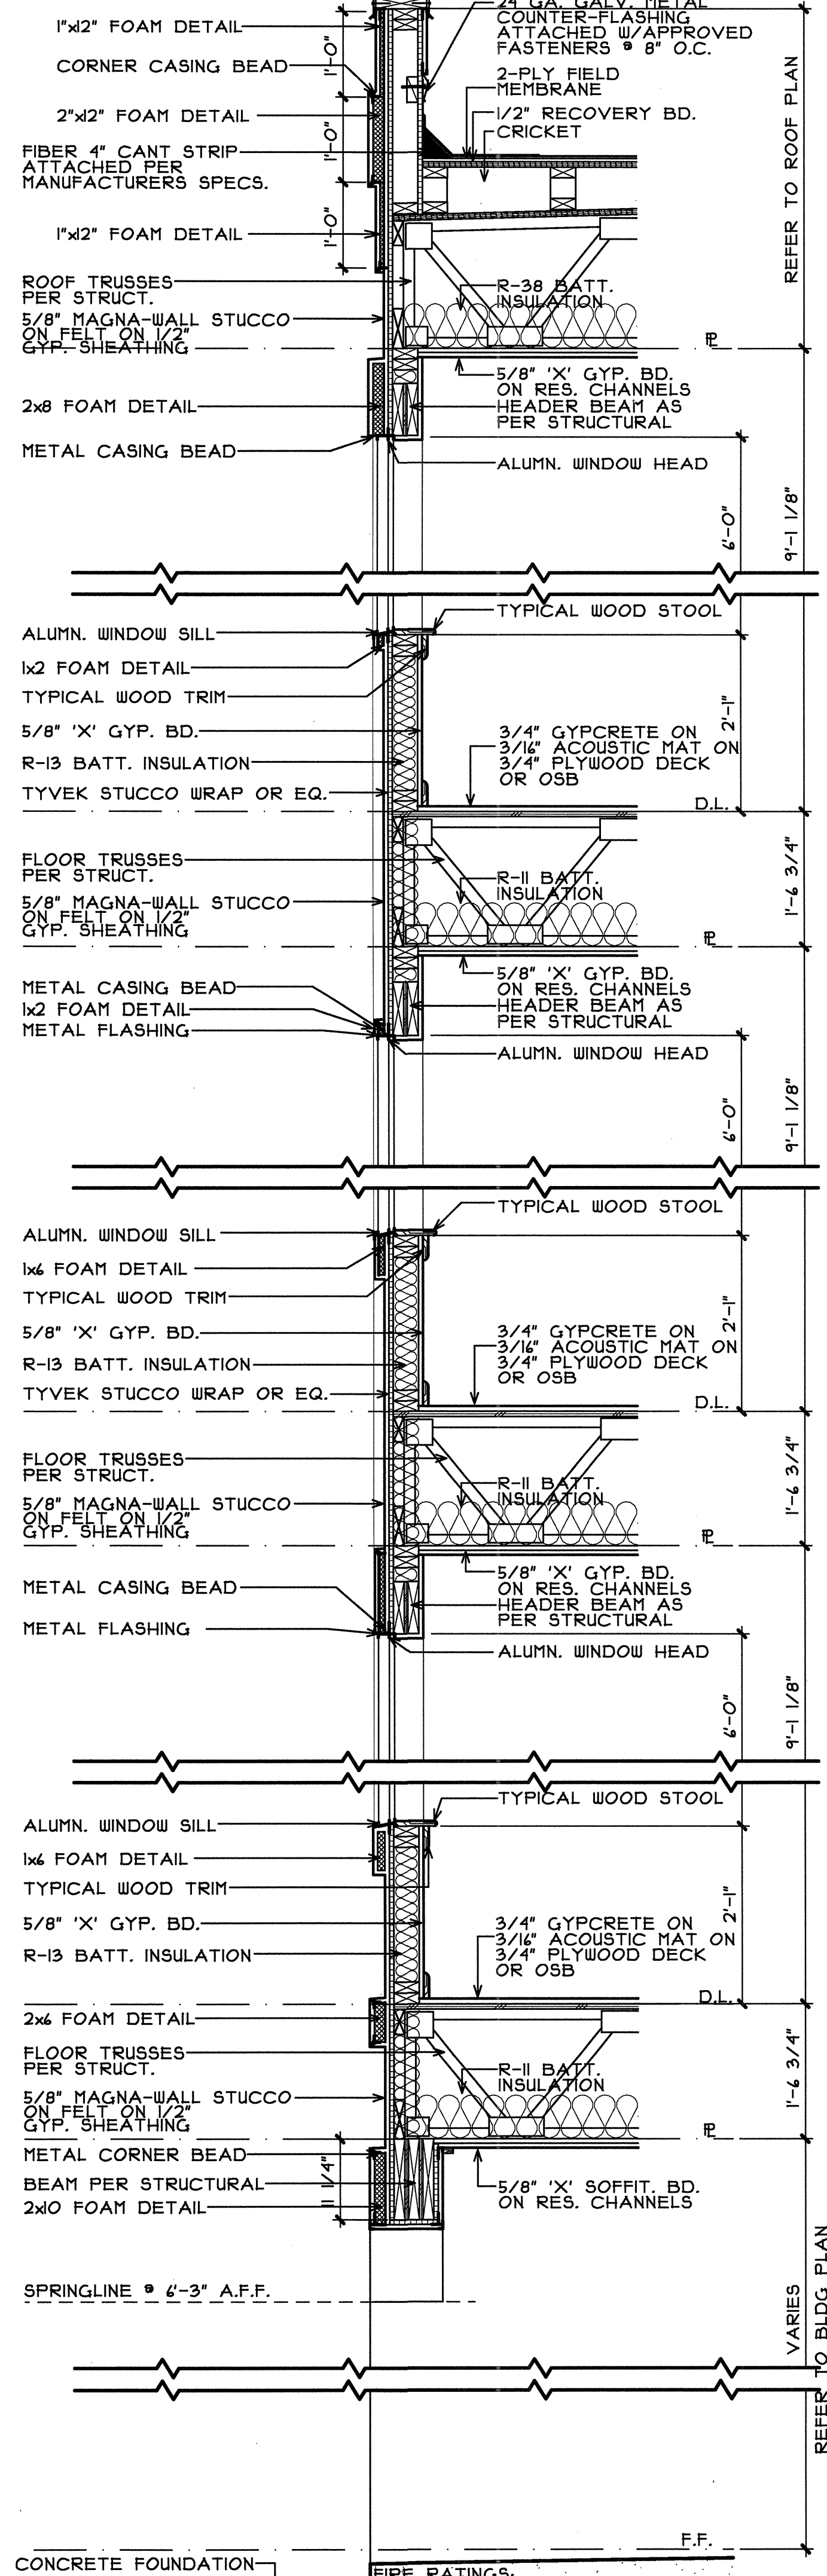


2 1-STORY EXT. STUCCO WALL • CORRIDOR
3/4\"=1'-0\"

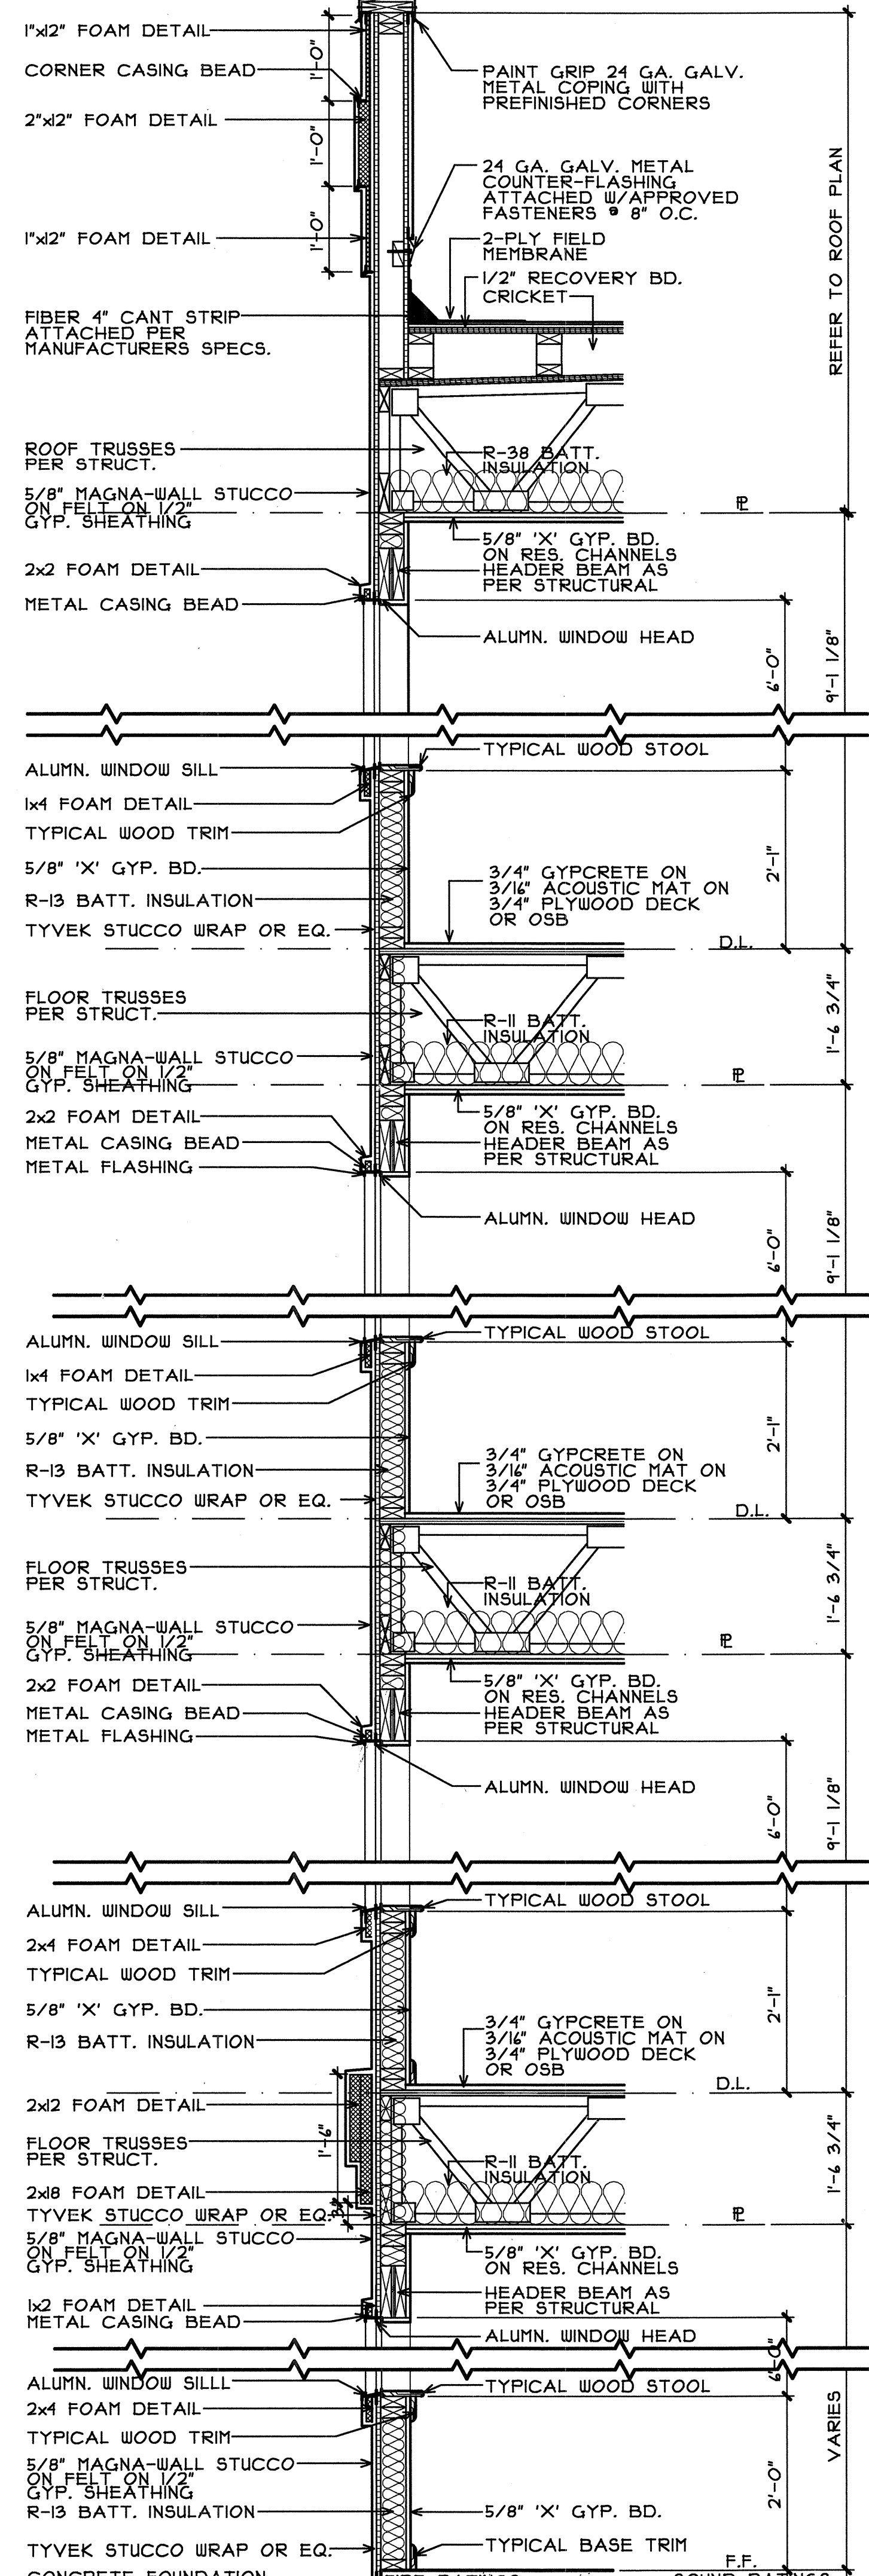

3 1-STORY EXT. WINDOW • STUCCO WALL
3/4\"=1'-0\"

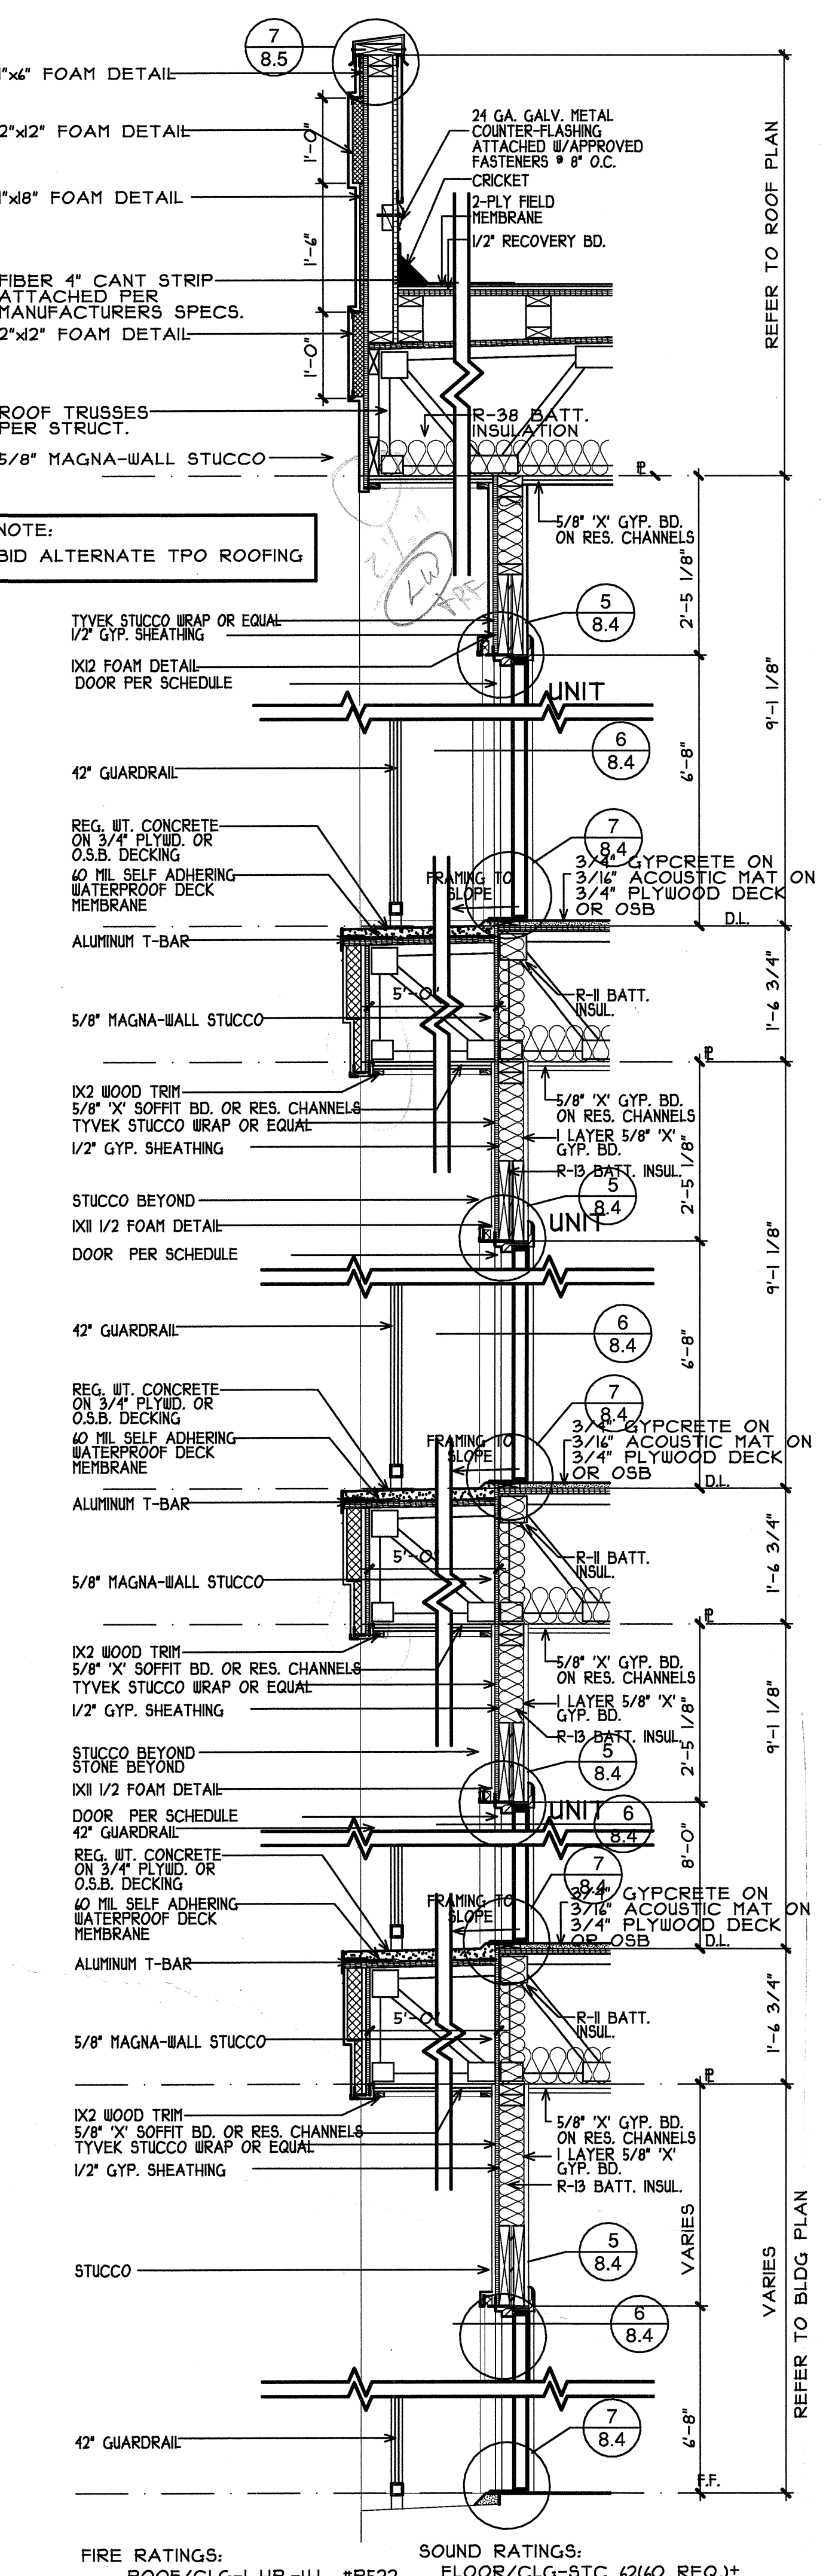

4 1-STORY EXT. - BALCONY
3/4\"=1'-0\"

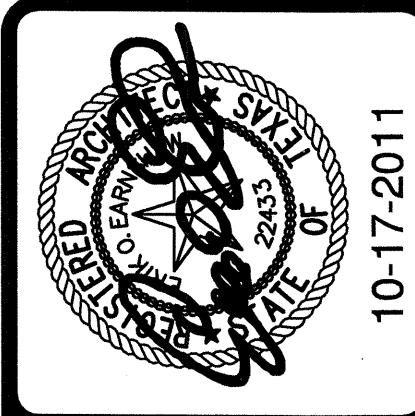

REVISIONS
COORDINATION
10-17-2011

KELLER SPRINGS LOFTS
LOFT APARTMENTS IN ADDISON, TEXAS

CONSTRUCTION ISSUE
10-17-2011



4144 N. Central Exp.
Suite 855
Dallas, TX 75204
214.520.8878
bgoarchitects.com

DATE
08-05-2011

PROJECT
11129

SHEET NUMBER

7.3

4 ST. WALL

COURTYARD

COPYRIGHT © Beeler Owens Architects ALL RIGHTS RESERVED