


NOTE: ALL FOAM DETAIL LOCATIONS:
 5/8" MAGNA-WALL STUCCO MAGNA-WALL STUCCO ON FELT ON 1/2" TYVEK SHEATHING ON 3/4" PLYWOOD DECKING

NOTE: BID ALTERNATE TPO ROOFING

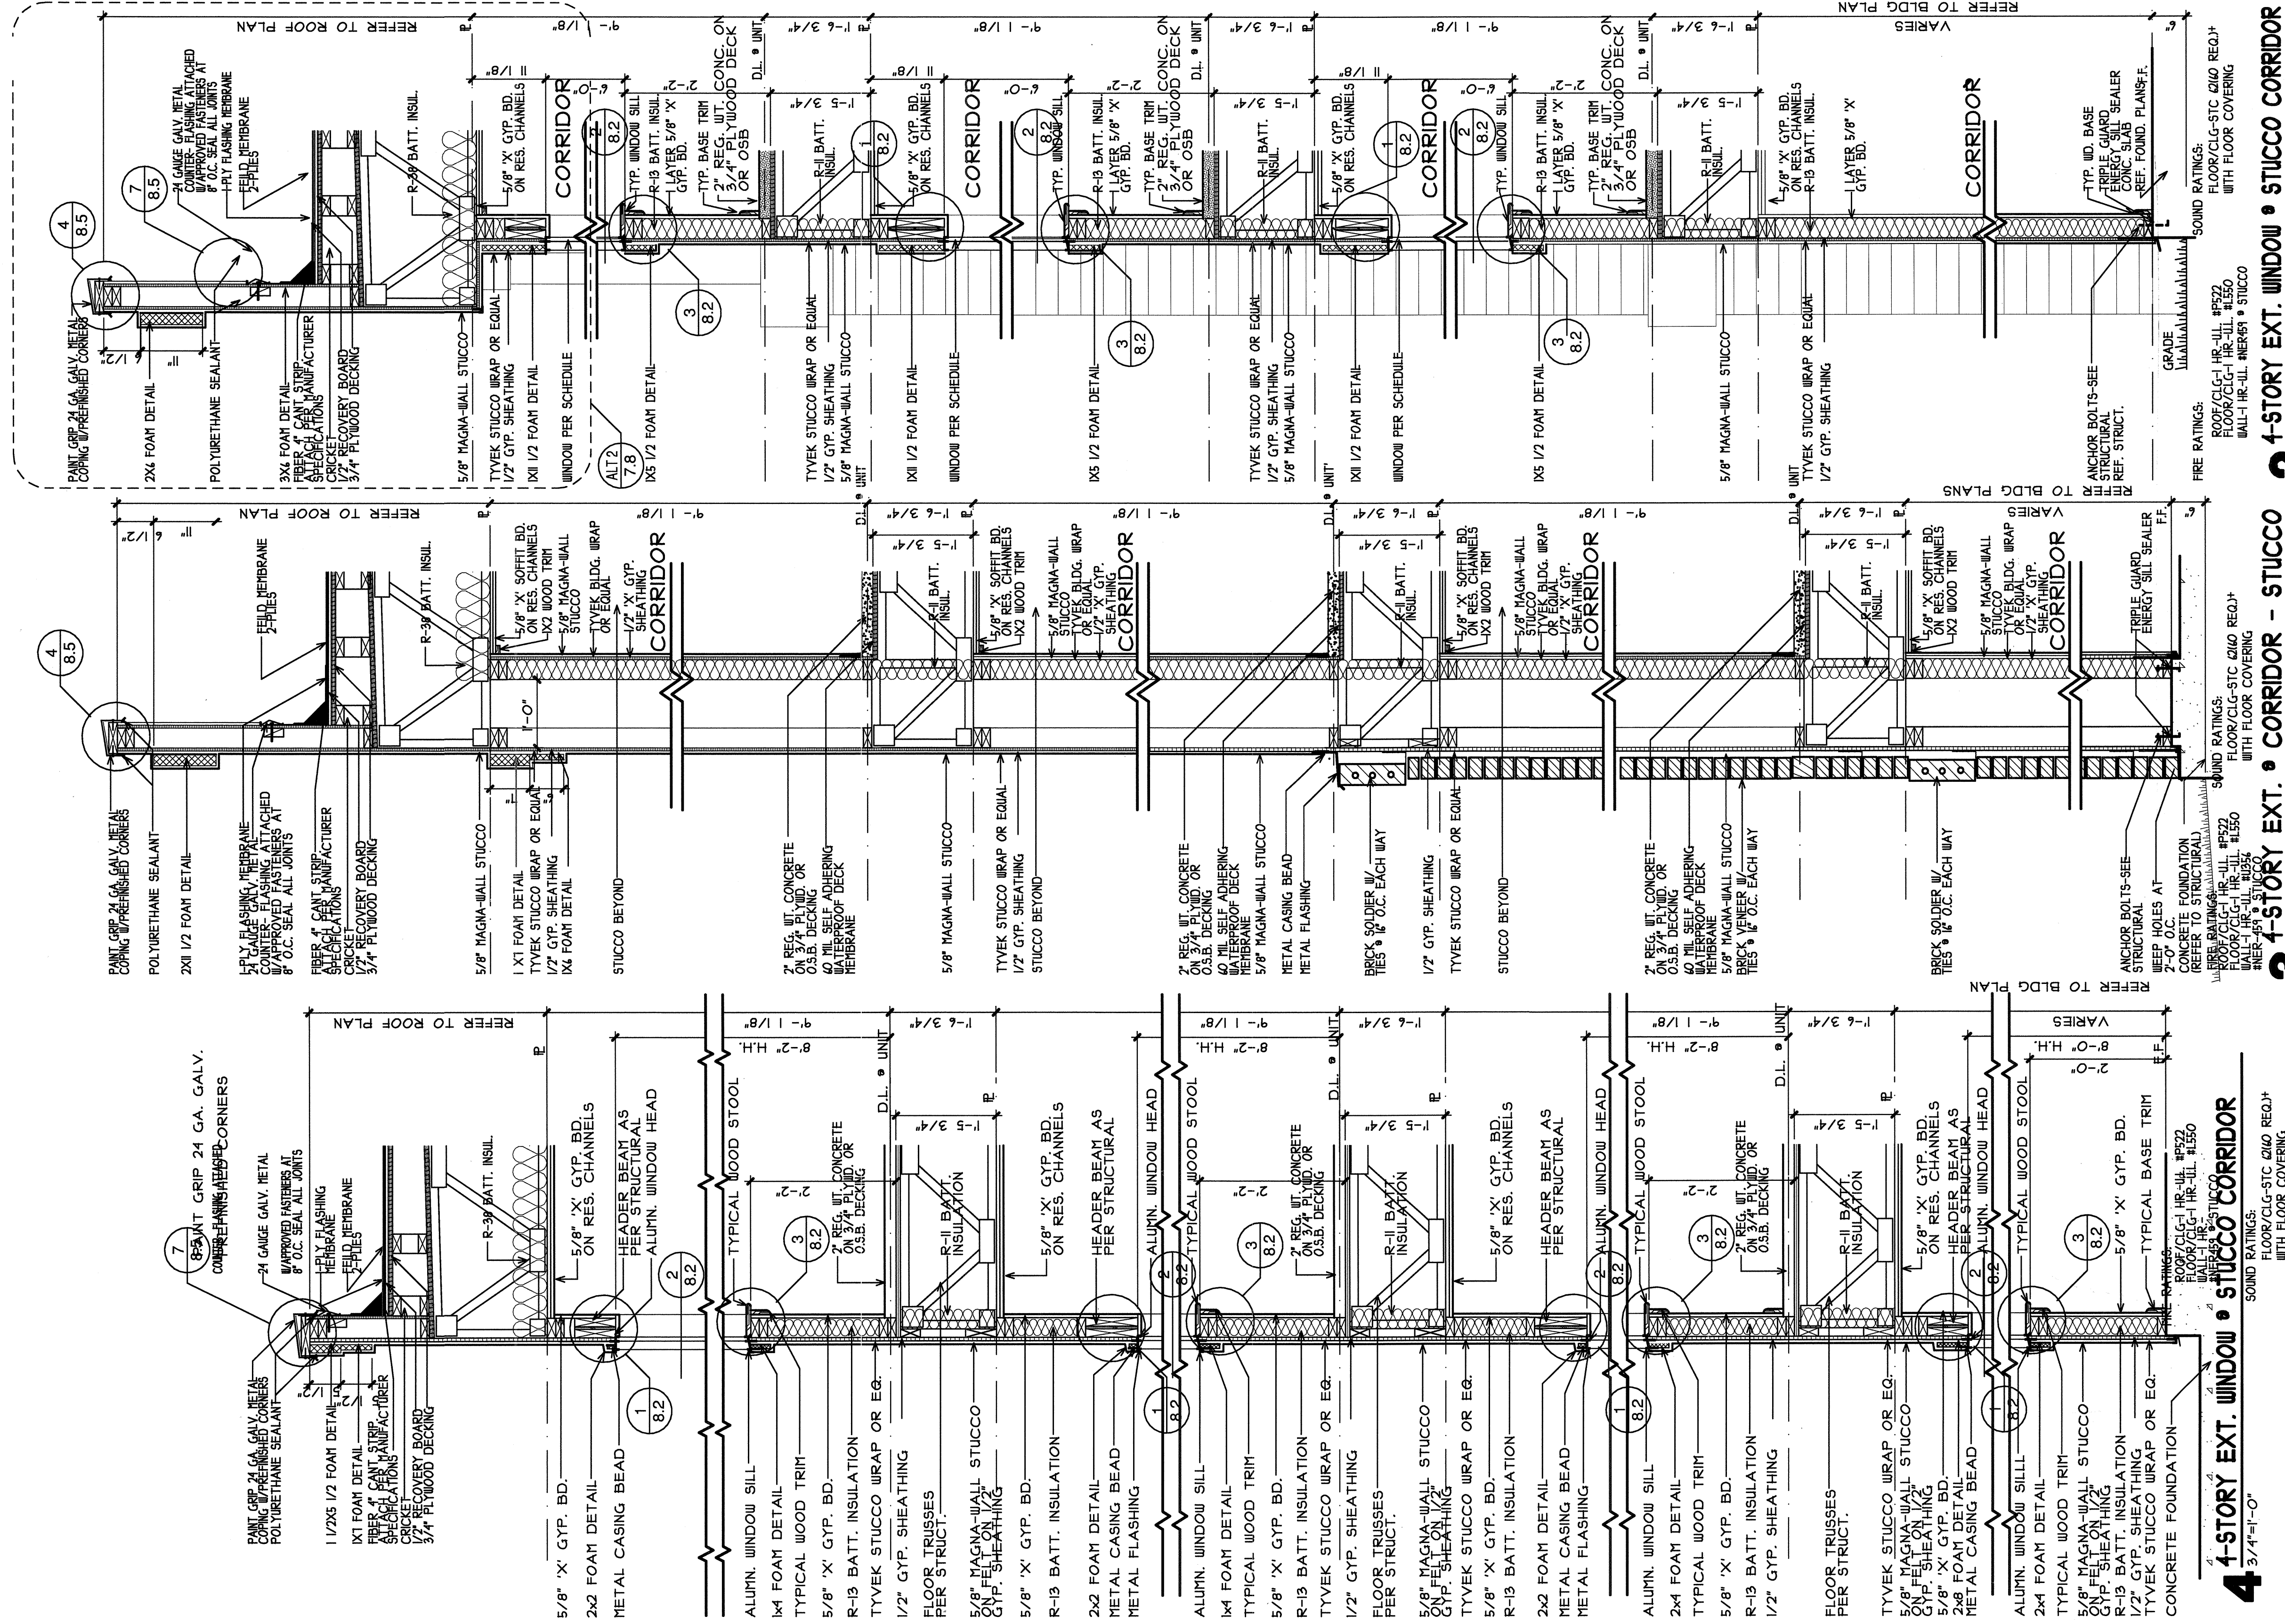

4 4-STORY EXT. WINDOW • STUCCO CORRIDOR
 3/4"=1'-0"
 SOUND RATINGS:
 FLOOR/CLG-STC (MIO REQ.)
 WITH FLOOR COVERING

3 4-STORY EXT. • CORRIDOR - STUCCO
 3/4"=1'-0"
 SOUND RATINGS:
 FLOOR/CLG-STC (MIO REQ.)
 WITH FLOOR COVERING

2 4-STORY EXT. WINDOW • STUCCO CORRIDOR
 3/4"=1'-0"
 SOUND RATINGS:
 FLOOR/CLG-STC (MIO REQ.)
 WITH FLOOR COVERING

1 NOT USED
 N/A

COPYRIGHT © Beeler Guest Owens Architects ALL RIGHTS RESERVED

7.6
 4 ST. WALL

SHEET NUMBER

11129

PROJECT

08-05-2011

DATE

4144 N. Central Exp.
 Suite 855
 Dallas, TX 75204
 214.520.8878
 bgoarchitects.com


BGO
 architects

CONSTRUCTION ISSUE

10-17-2011

KELLER SPRINGS LOFTS
 LOFT APARTMENTS IN ADDISON, TEXAS

REVISIONS
 COORDINATION
 10-17-2011

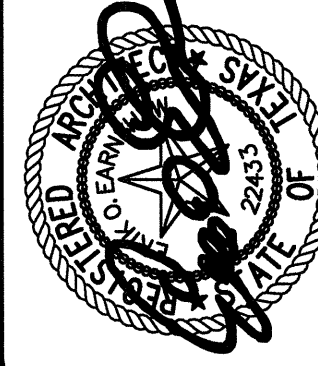

10-17-2011