


NOTE: ALL FOAM DETAIL LOCATIONS:
 5/8\"/>

NOTE:
 BID ALTERNATE TPO ROOFING

FIRE RATINGS:
 ROOF/CLG-1 HR-UL, #P522
 FLOOR/CLG-1 HR-UL, #L550
 WALL-HR-UL, #R691 + STUCCO

SOUND RATINGS:
 FLOOR/CLG-STC 42/60 REQ. +
 WITH FLOOR COVERING


2 4-STORY EXT. - STONE/STUCCO
 3/4\"/>

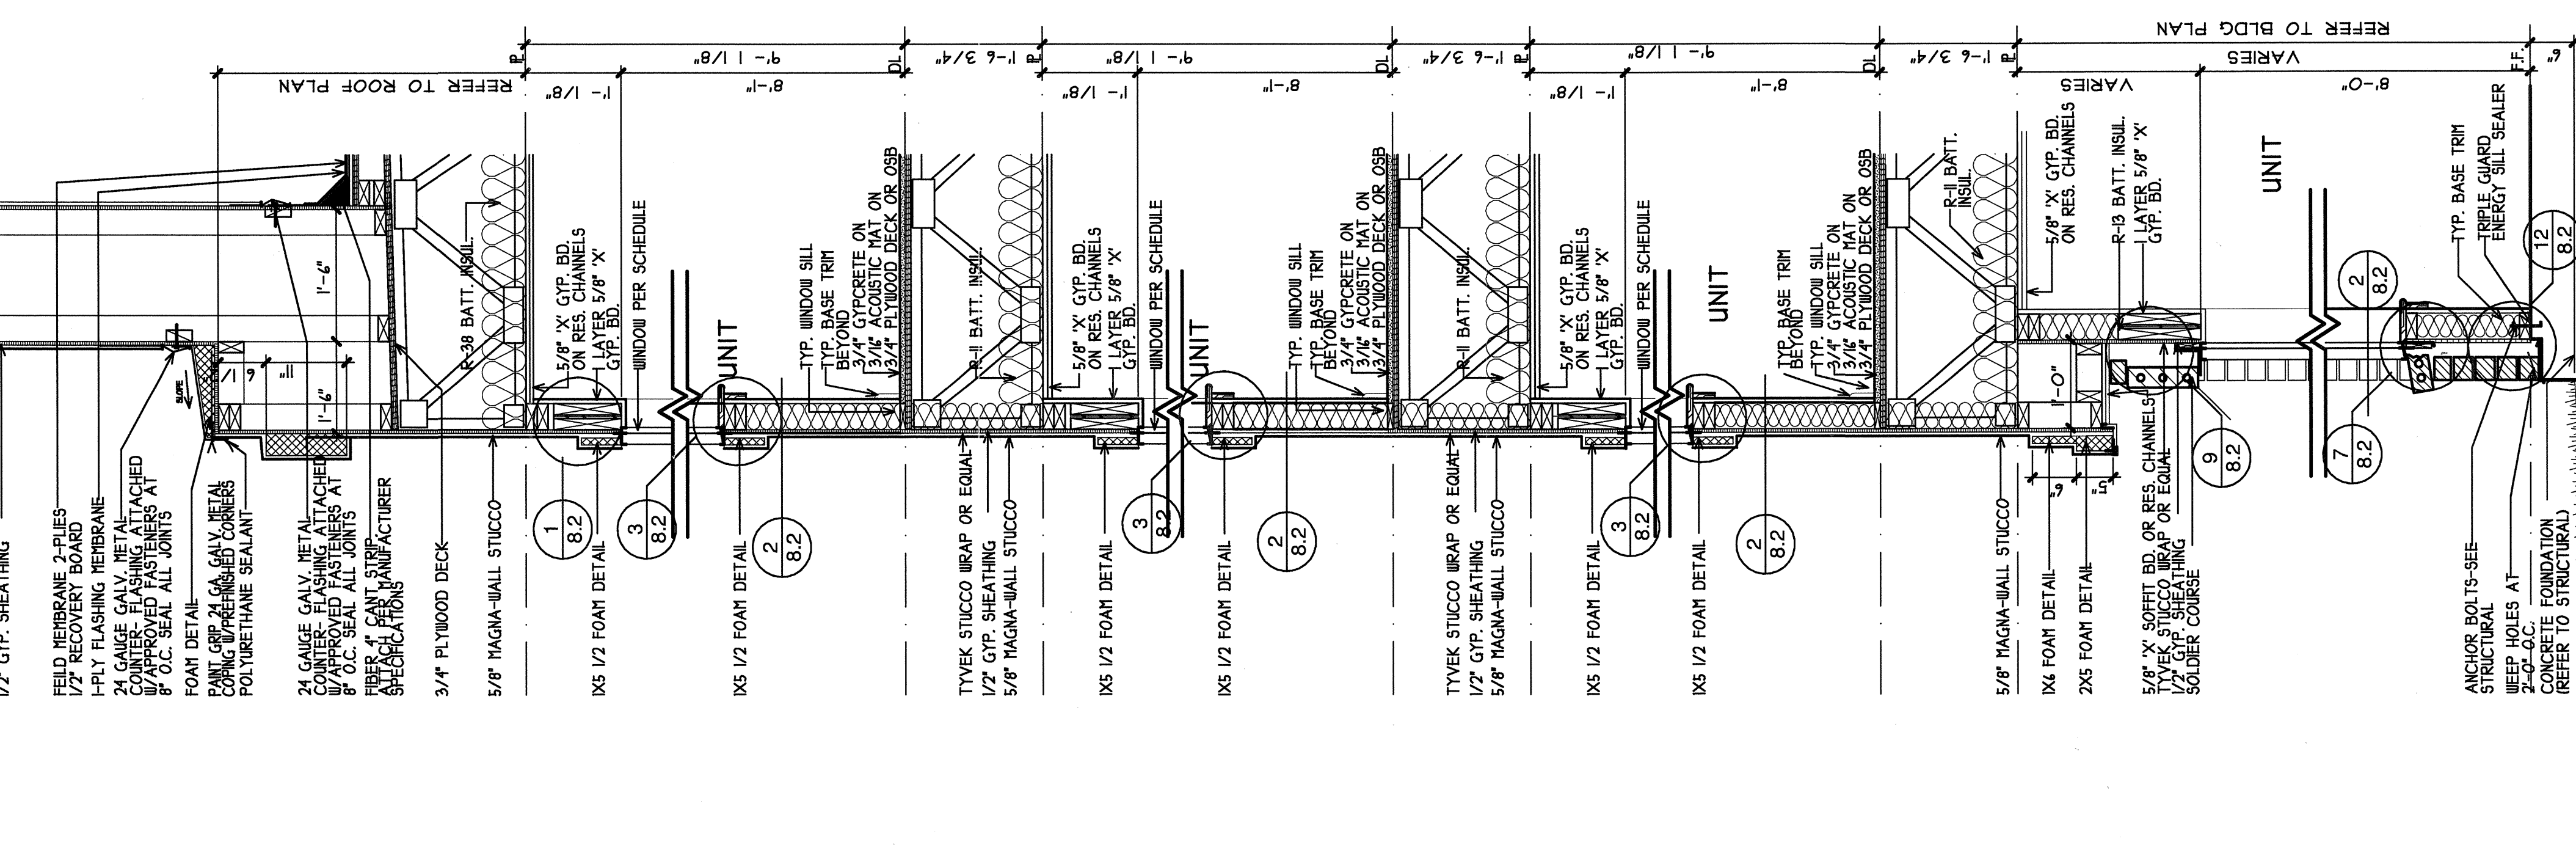

FIRE RATINGS:
 ROOF/CLG-1 HR-UL, #P522
 FLOOR/CLG-1 HR-UL, #L550
 WALL-HR-UL, #R691 + STUCCO

SOUND RATINGS:
 FLOOR/CLG-STC 42/60 REQ. +
 WITH FLOOR COVERING

3 4-STORY EXT. - BALCONY
 3/4\"/>

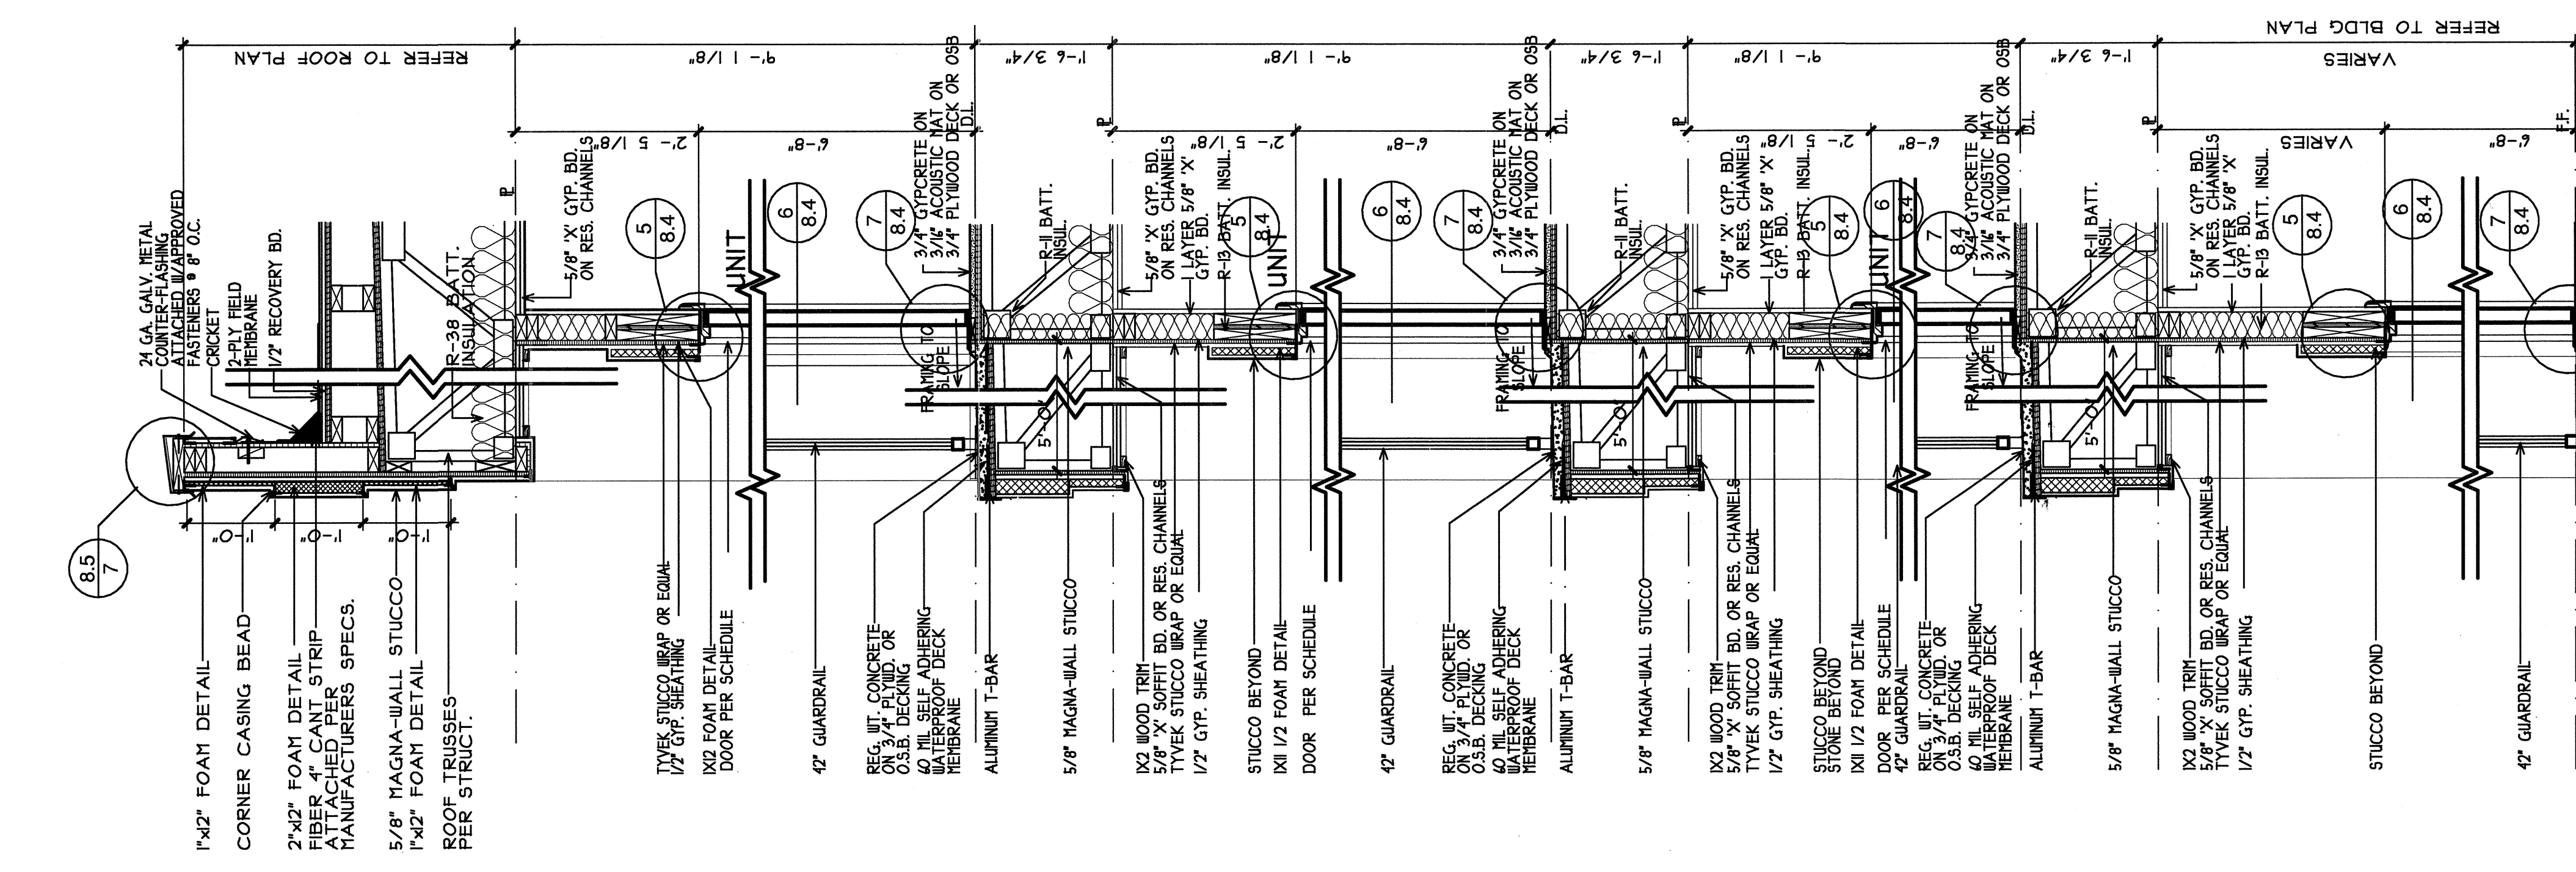

FIRE RATINGS:
 ROOF/CLG-1 HR-UL, #P522
 FLOOR/CLG-1 HR-UL, #L550
 WALL-HR-UL, #R691 + STUCCO

SOUND RATINGS:
 FLOOR/CLG-STC 42/60 REQ. +
 WITH FLOOR COVERING

4 4-STORY EXT. - BALCONY
 3/4\"/>

10-17-2011

REVISIONS
 COORDINATION
 10-17-2011

KELLER SPRINGS LOFTS
 LOFT APARTMENTS IN ADDISON, TEXAS

CONSTRUCTION ISSUE
 10-17-2011

BGO
 architects
 4144 N. Central Expy.
 Suite 855
 Dallas, TX 75204
 214.520.8878
 bgoarchitects.com

DATE
 08-05-2011

PROJECT
 11129

SHEET NUMBER
7.9

4 ST. WALL

COPYRIGHT © Beeler, Guest, Owens Architects. ALL RIGHTS RESERVED