




5 UNIT ENTRY DOOR JAMB • CORRIDOR
SCALE: 3/4"=1'-0"

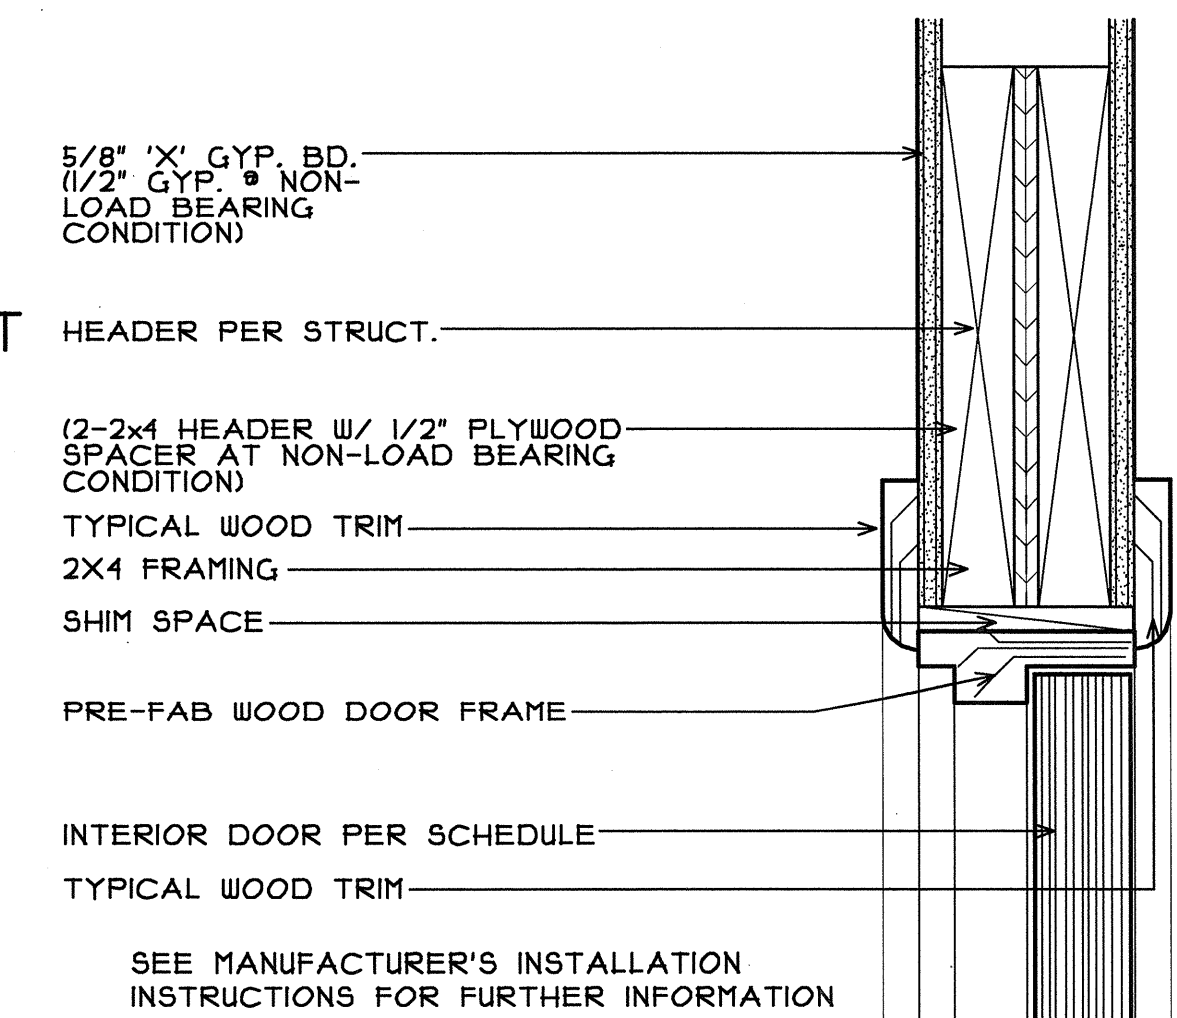


9 INTERIOR DOOR HEAD
SCALE: 3/4"=1'-0"

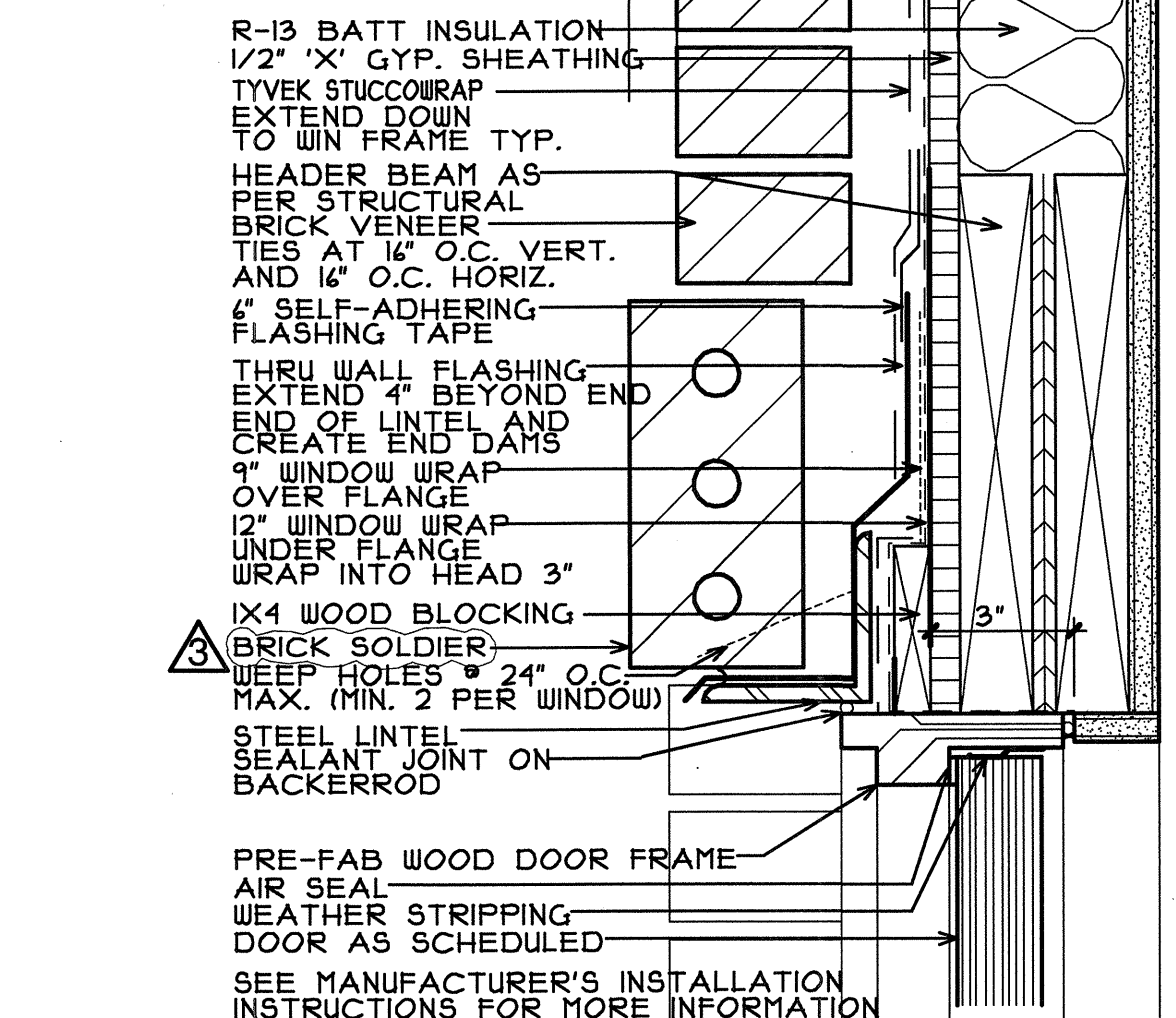


13 DOOR HEAD • BRICK
SCALE: 3/4"=1'-0"

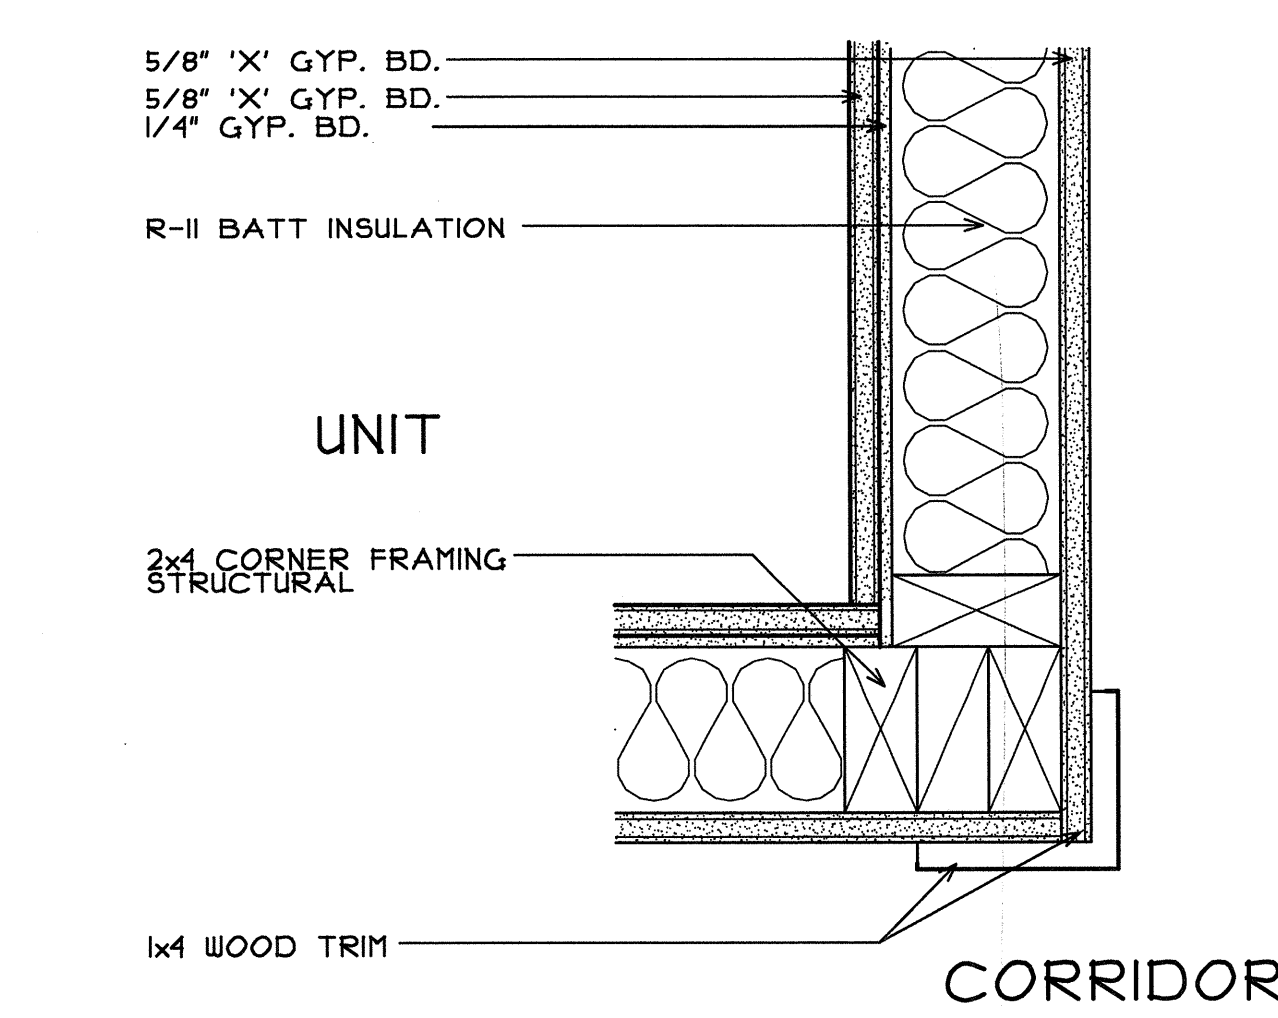


17 CORNER AT CORRIDOR
SCALE: 3/4"=1'-0"

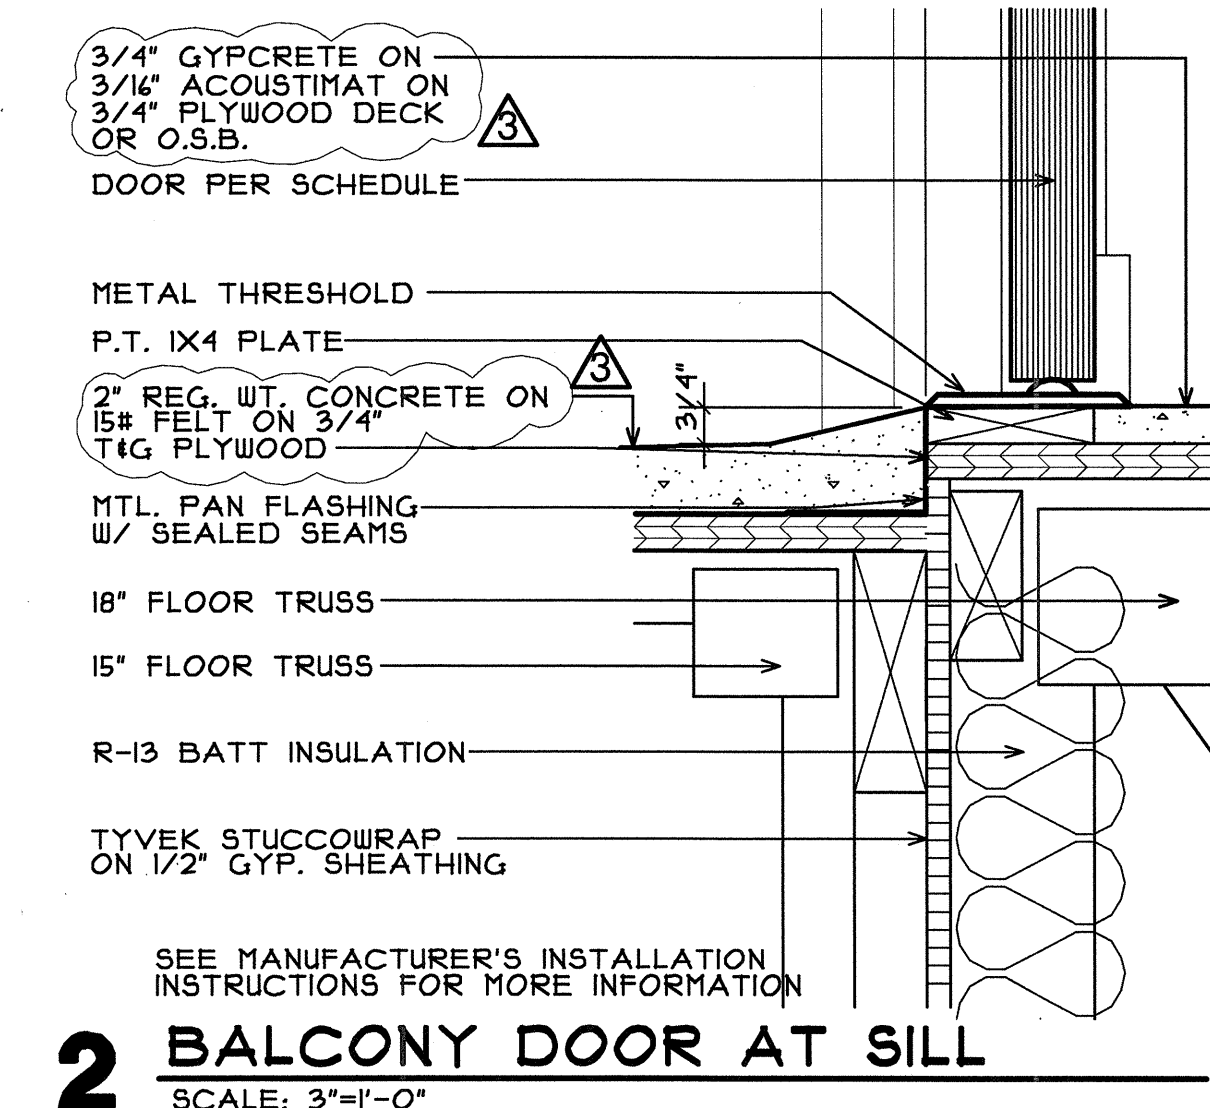


2 BALCONY DOOR AT SILL
SCALE: 3/4"=1'-0"

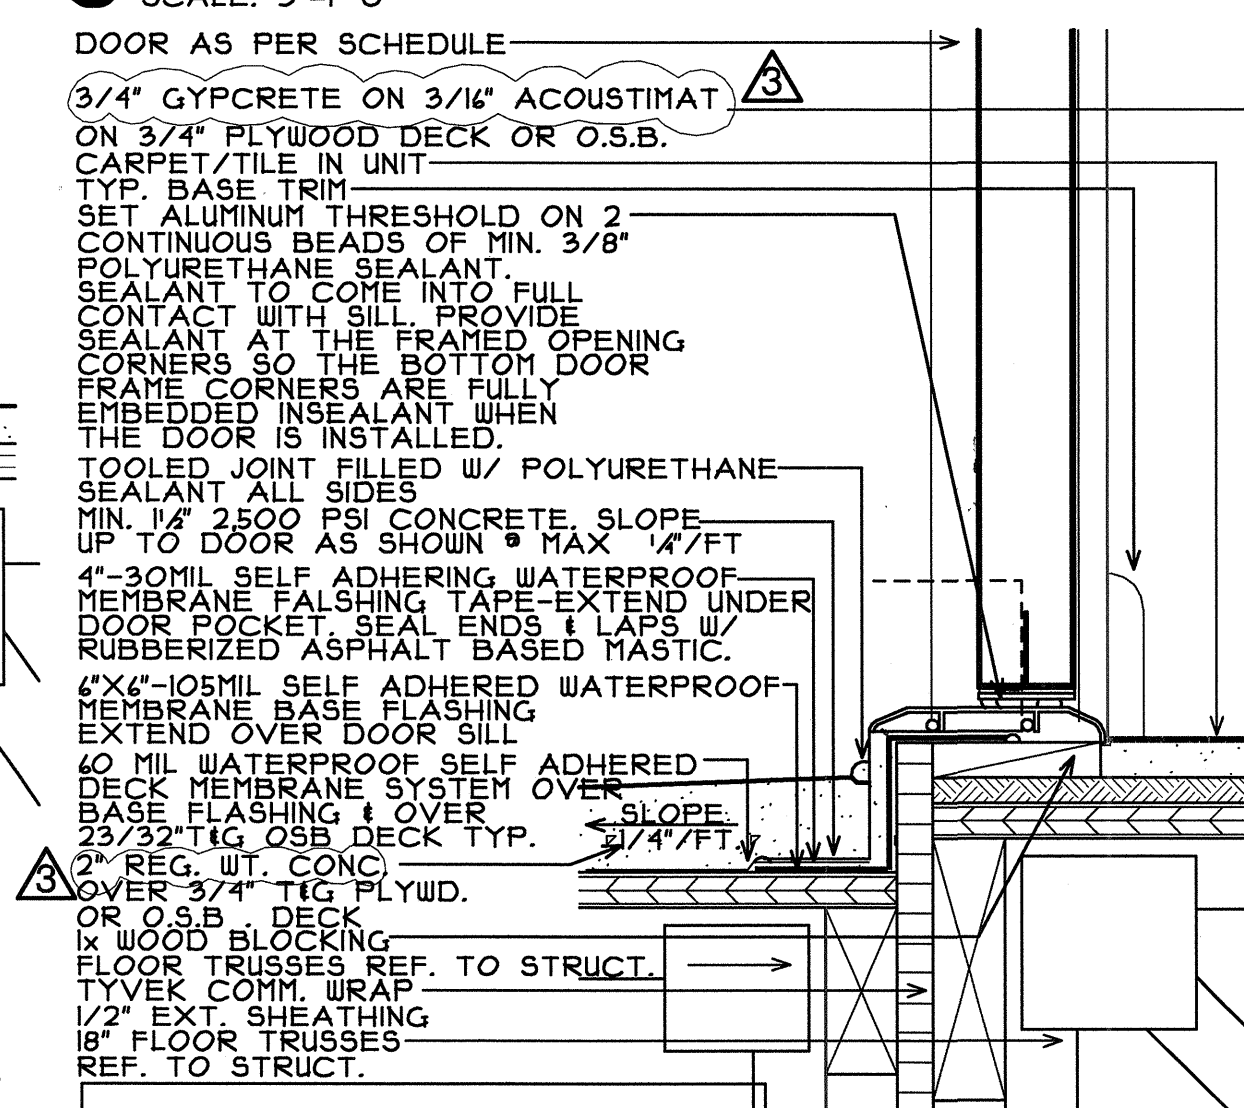


6 UNIT ENTRY DOOR SILL • BALCONY
SCALE: 3/4"=1'-0"

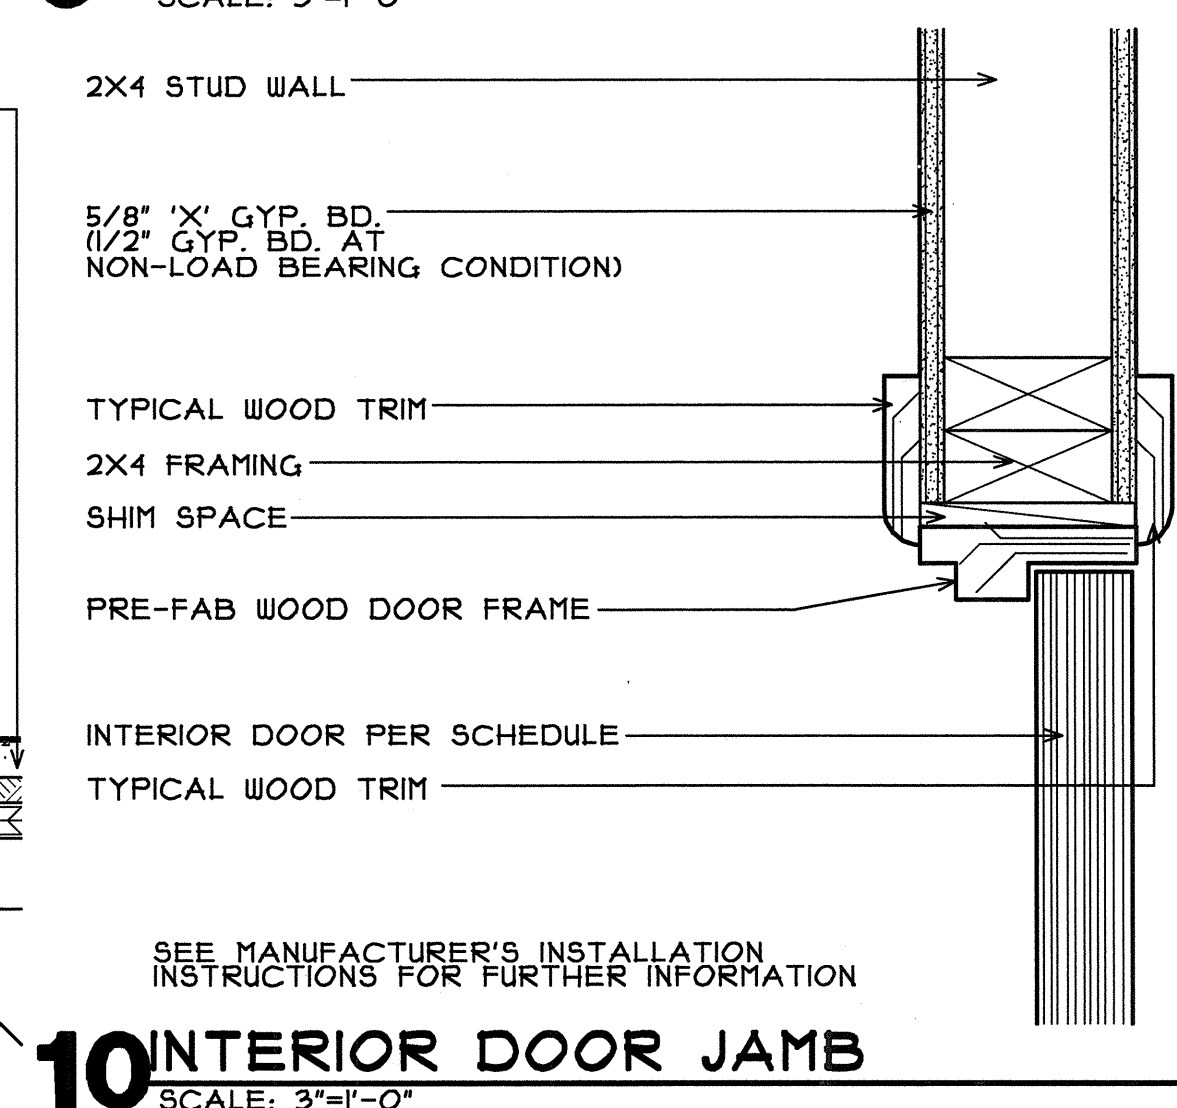


10 INTERIOR DOOR JAMB
SCALE: 3/4"=1'-0"

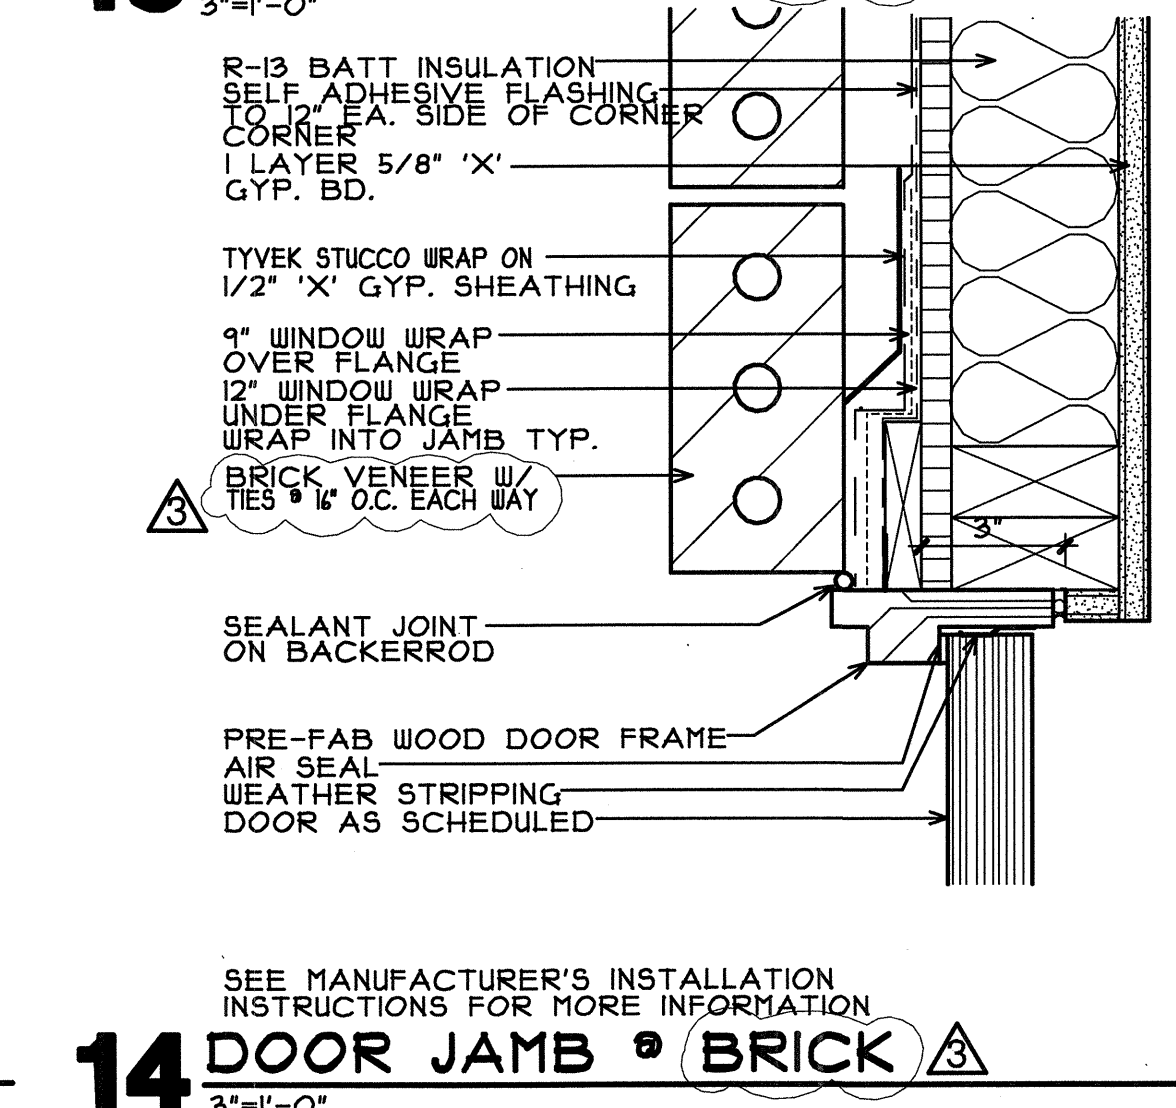


14 DOOR JAMB • BRICK
SCALE: 3/4"=1'-0"

 


19 UNIT / CORRIDOR • SILL
SCALE: 3/4"=1'-0"

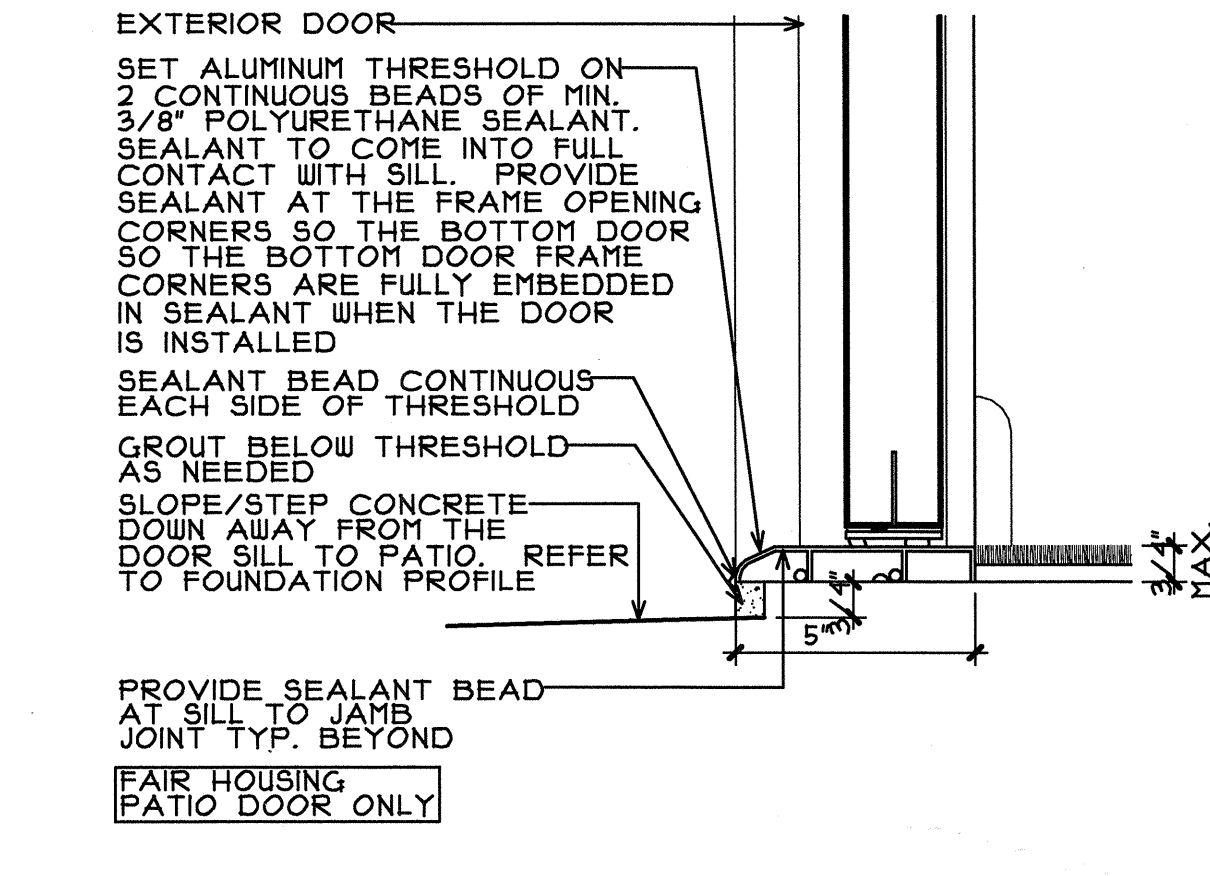


3 FAIR HOUSING PATIO DOOR THRESHOLD
SCALE: 3/4"=1'-0"

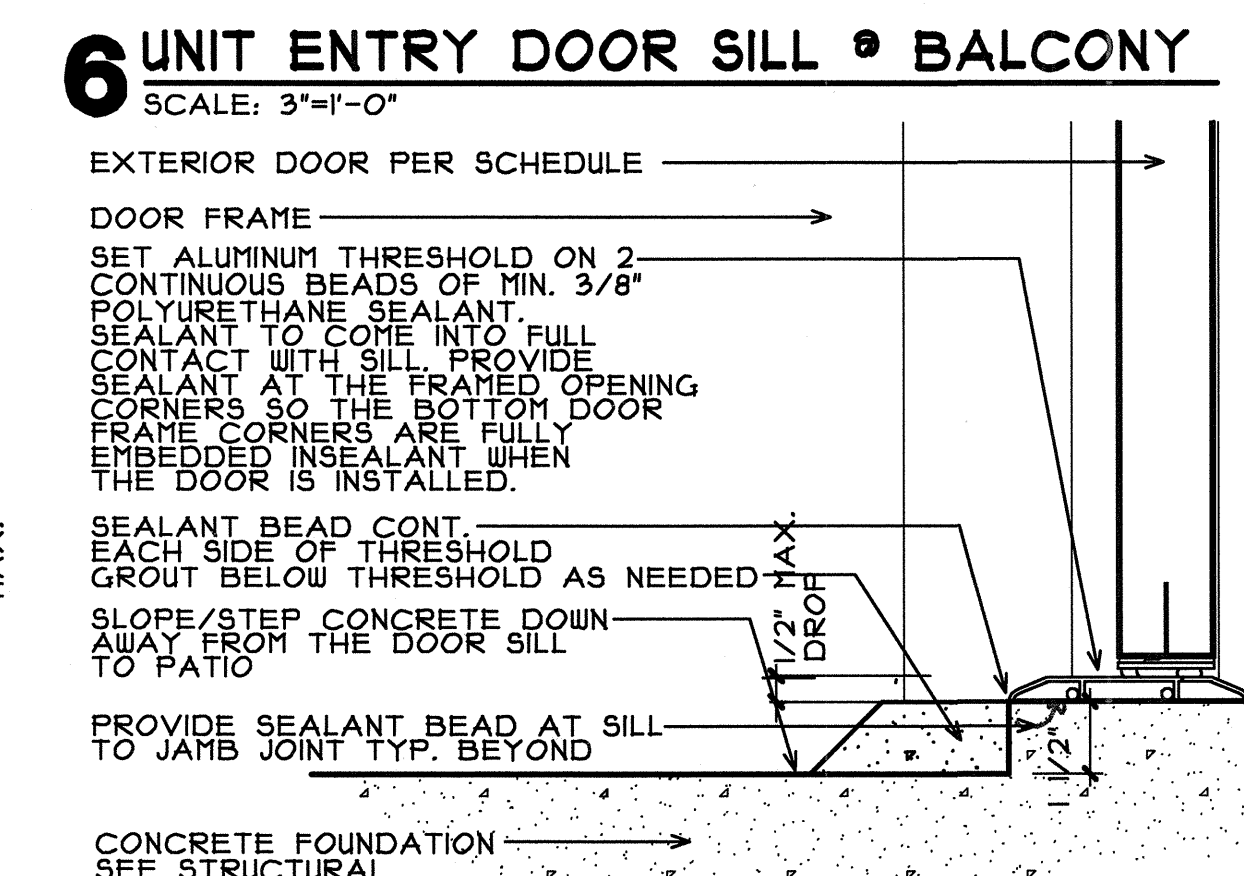


7 ENTRY DOOR SILL • BALCONY
SCALE: 3/4"=1'-0"

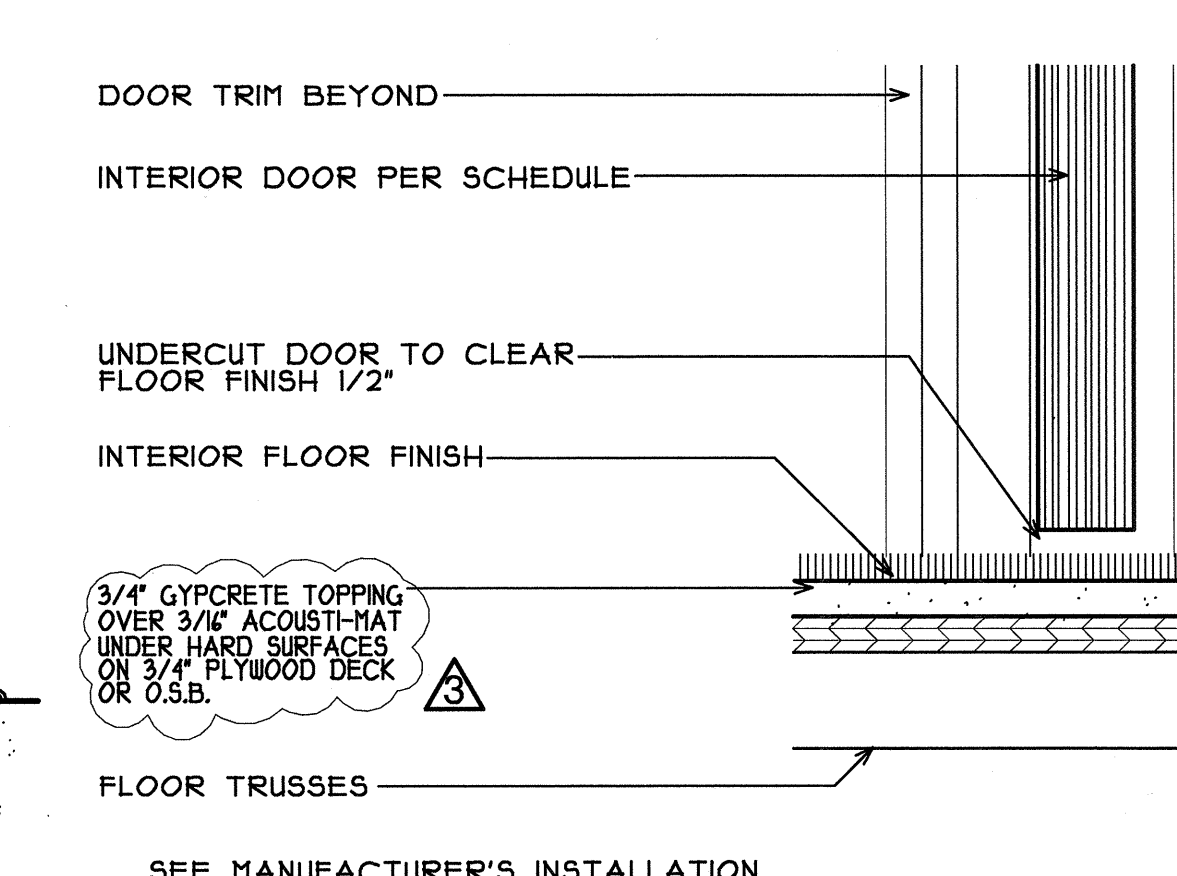


11 INTERIOR DOOR SILL
SCALE: 3/4"=1'-0"

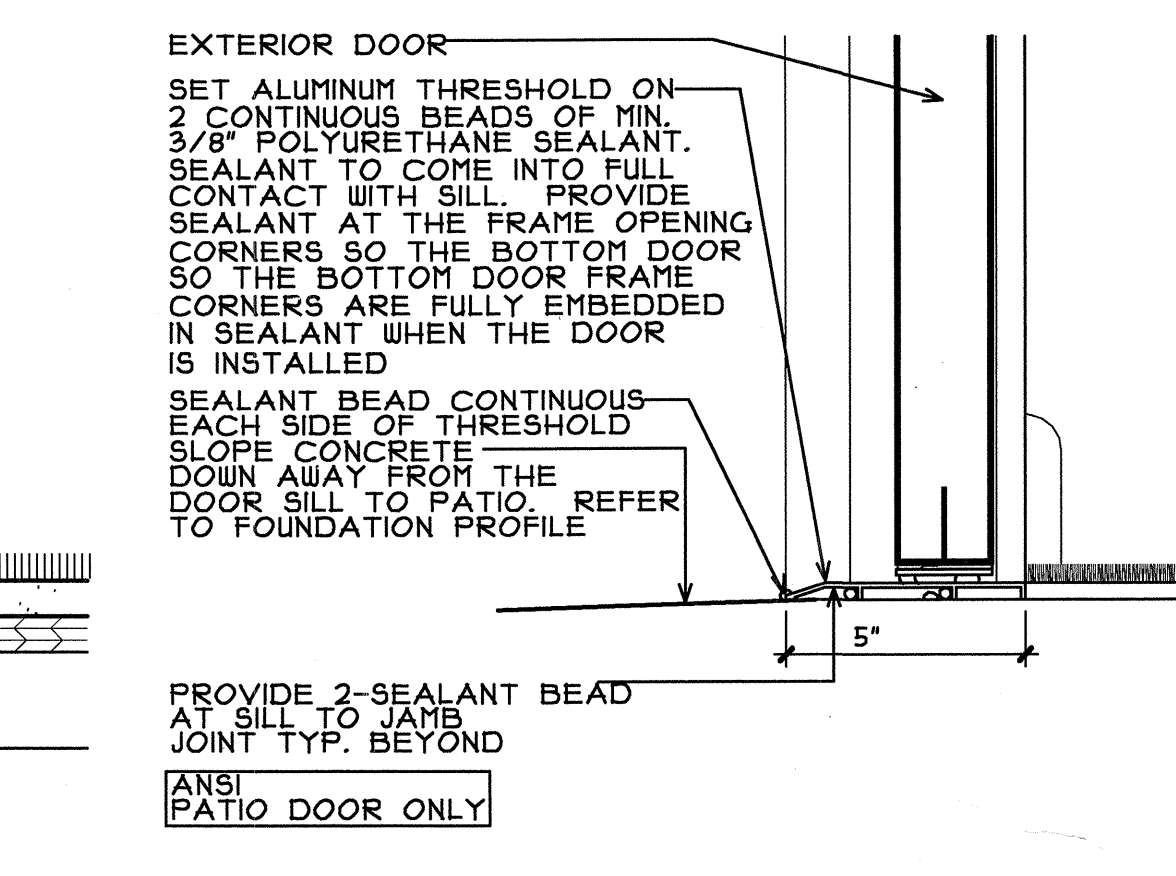


15 ANSI PATIO DOOR THRESHOLD
NOT TO SCALE

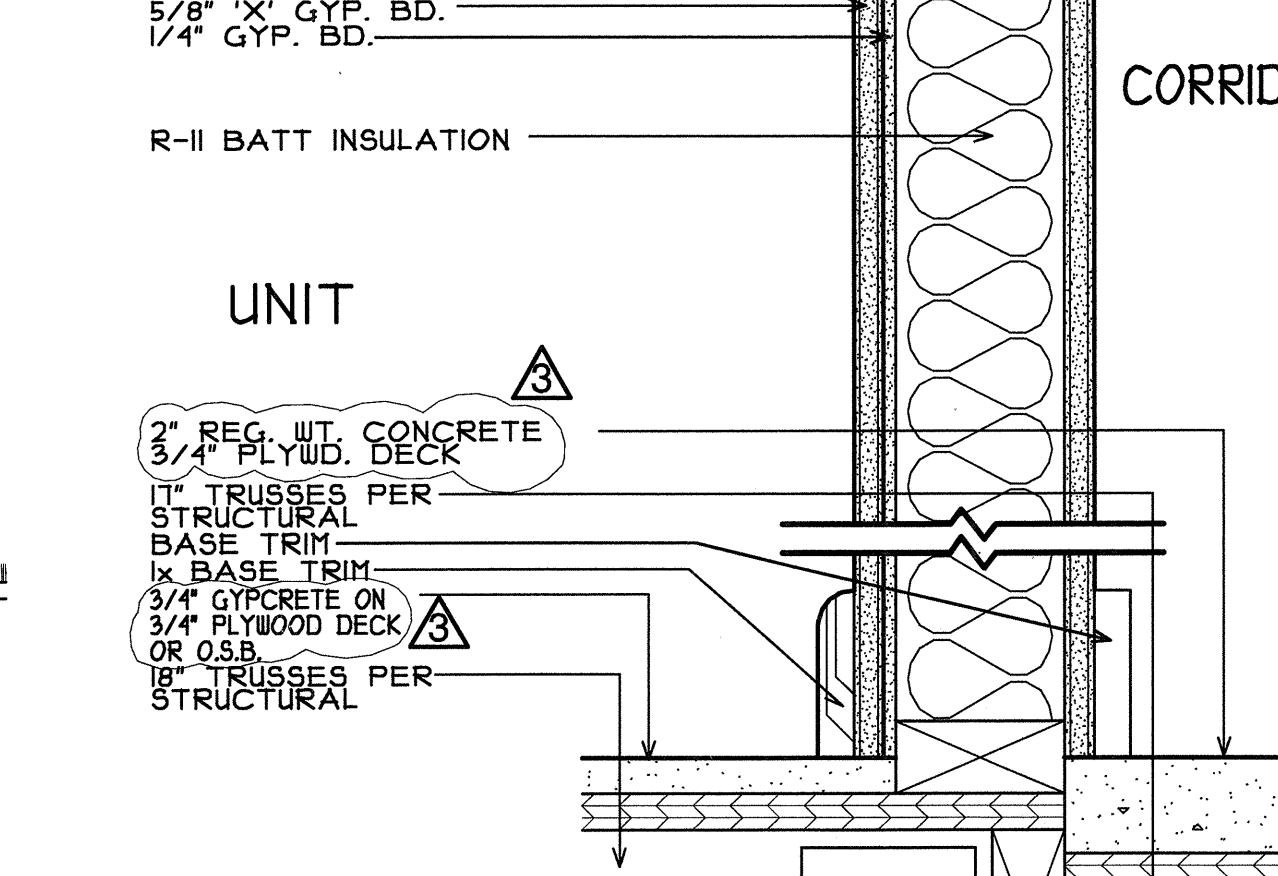


20 BRICK TIE DETAIL
SCALE: 3/4"=1'-0"

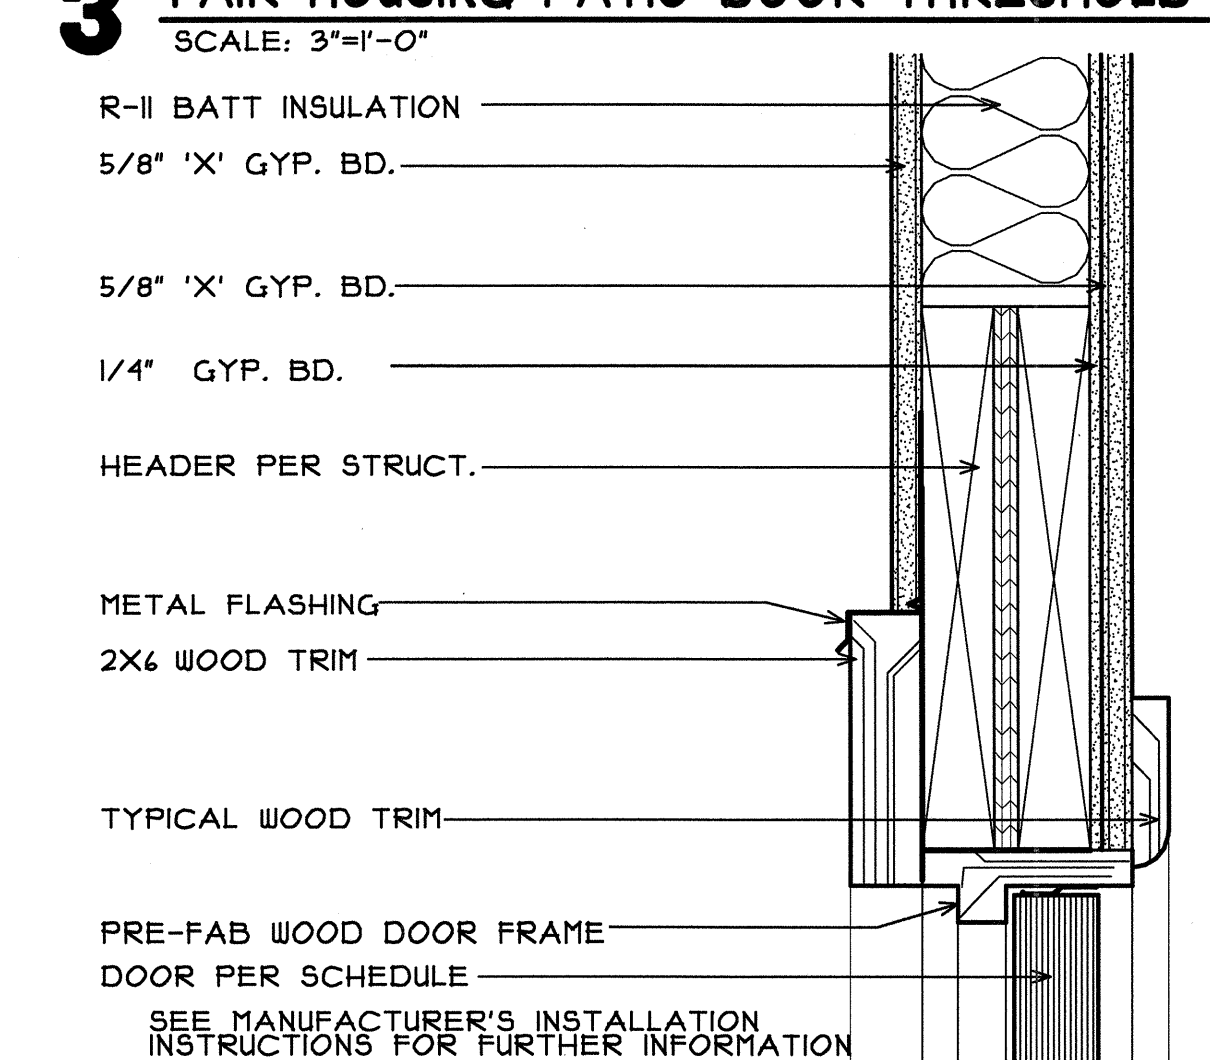


4 UNIT ENTRY DOOR HEAD • CORRIDOR
SCALE: 3/4"=1'-0"

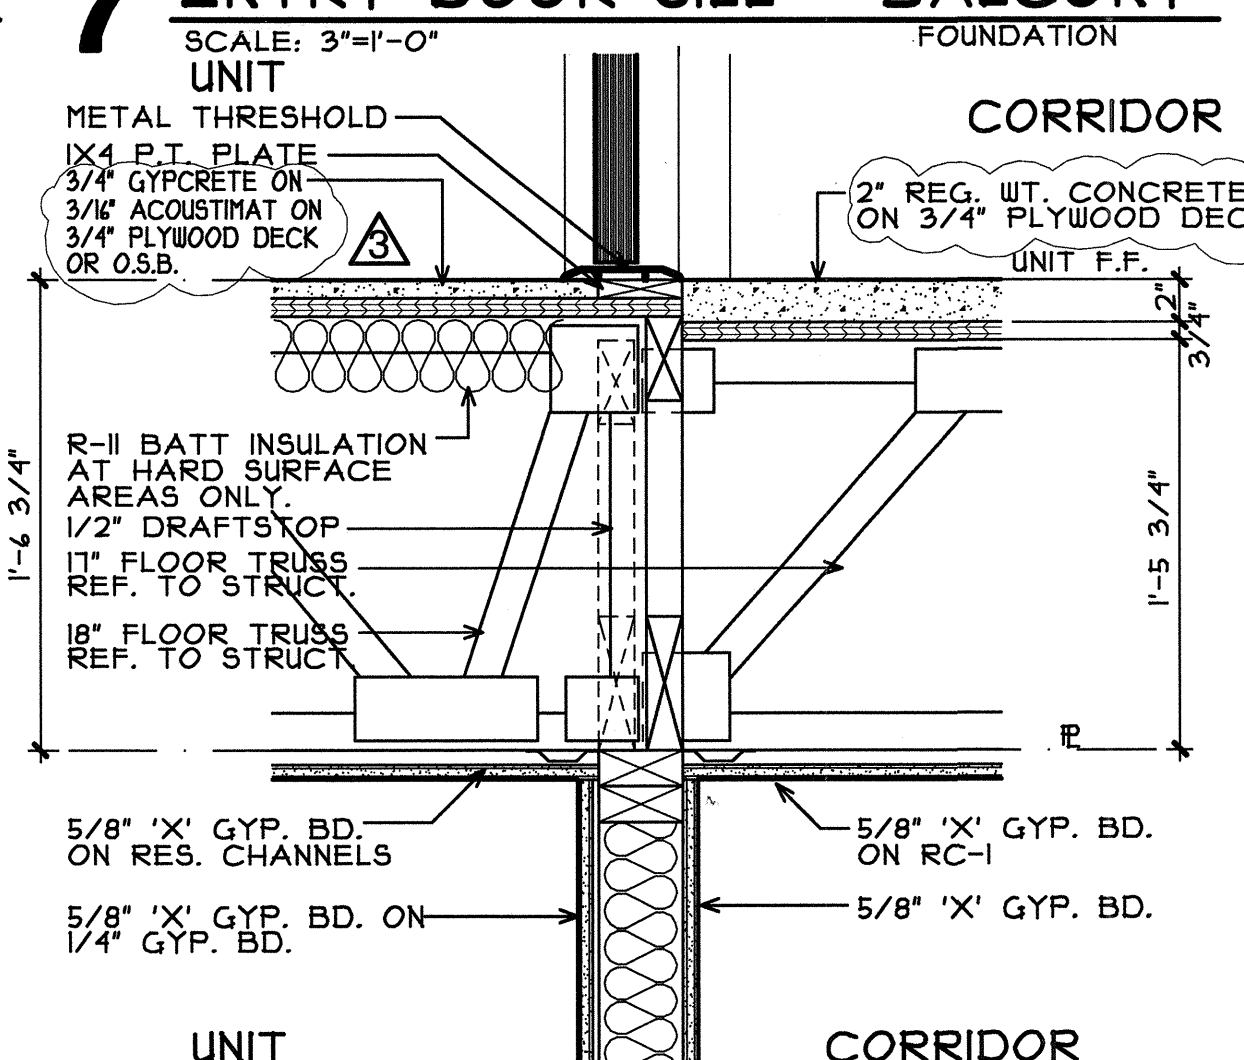


8 CORRIDOR/UNIT TRANSITION
SCALE: 1/2"=1'-0"

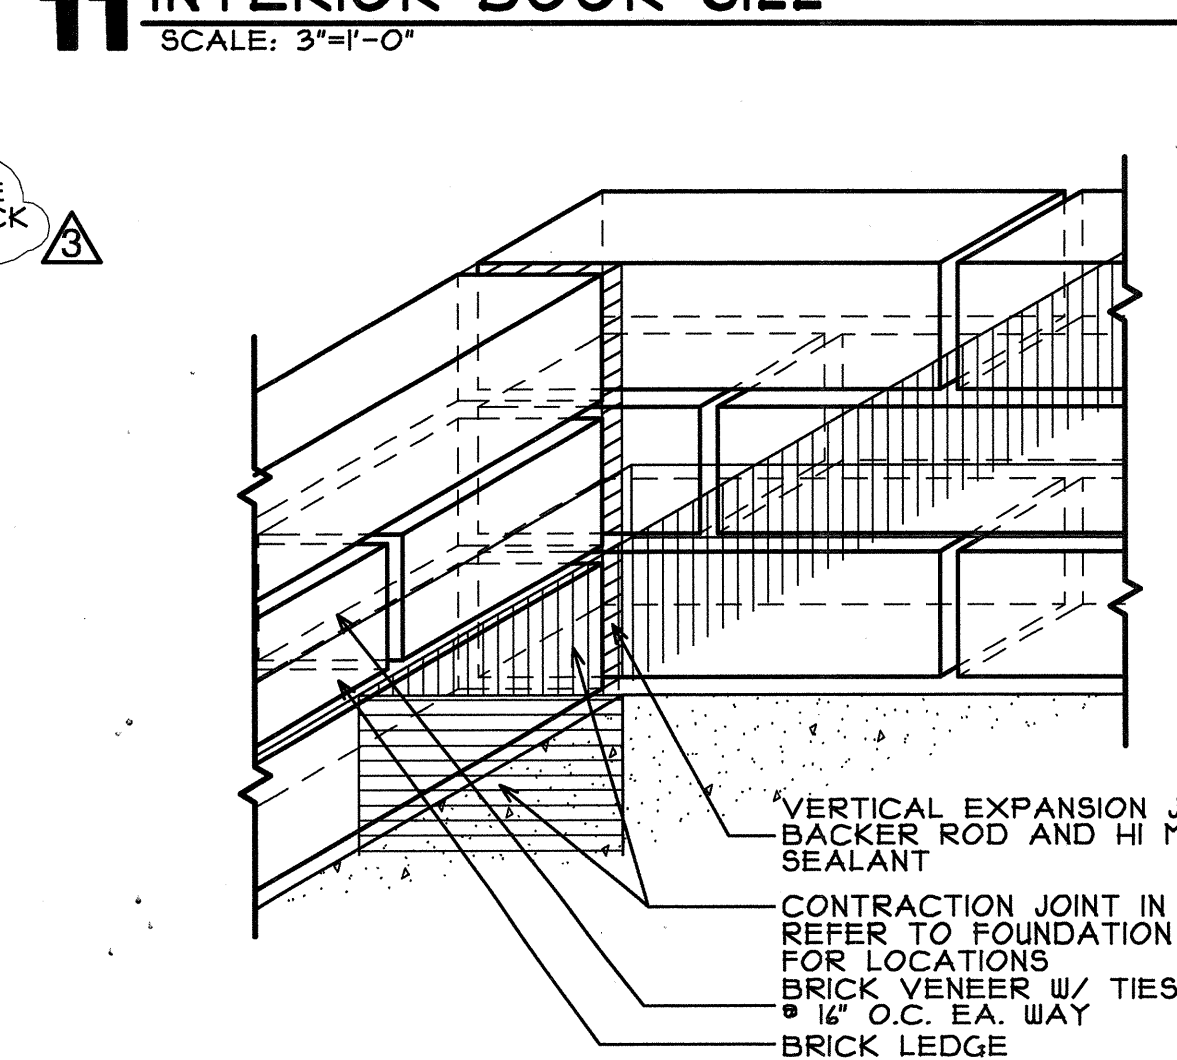


12 EXPANSION JOINT AT CORNER
SCALE: 3/4"=1'-0"

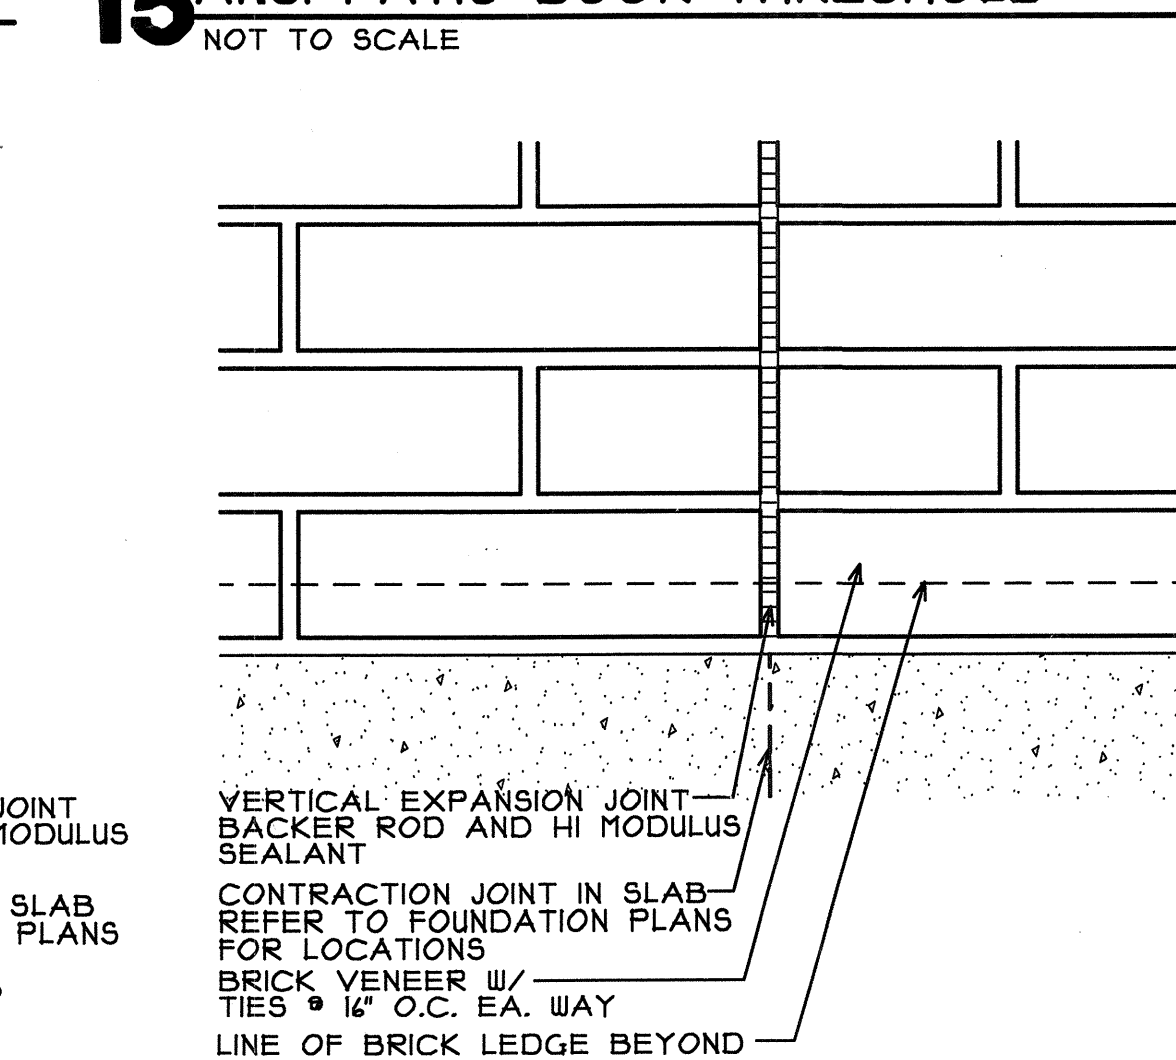

16 EXPANSION JOINT IN WALL
SCALE: 3/4"=1'-0"

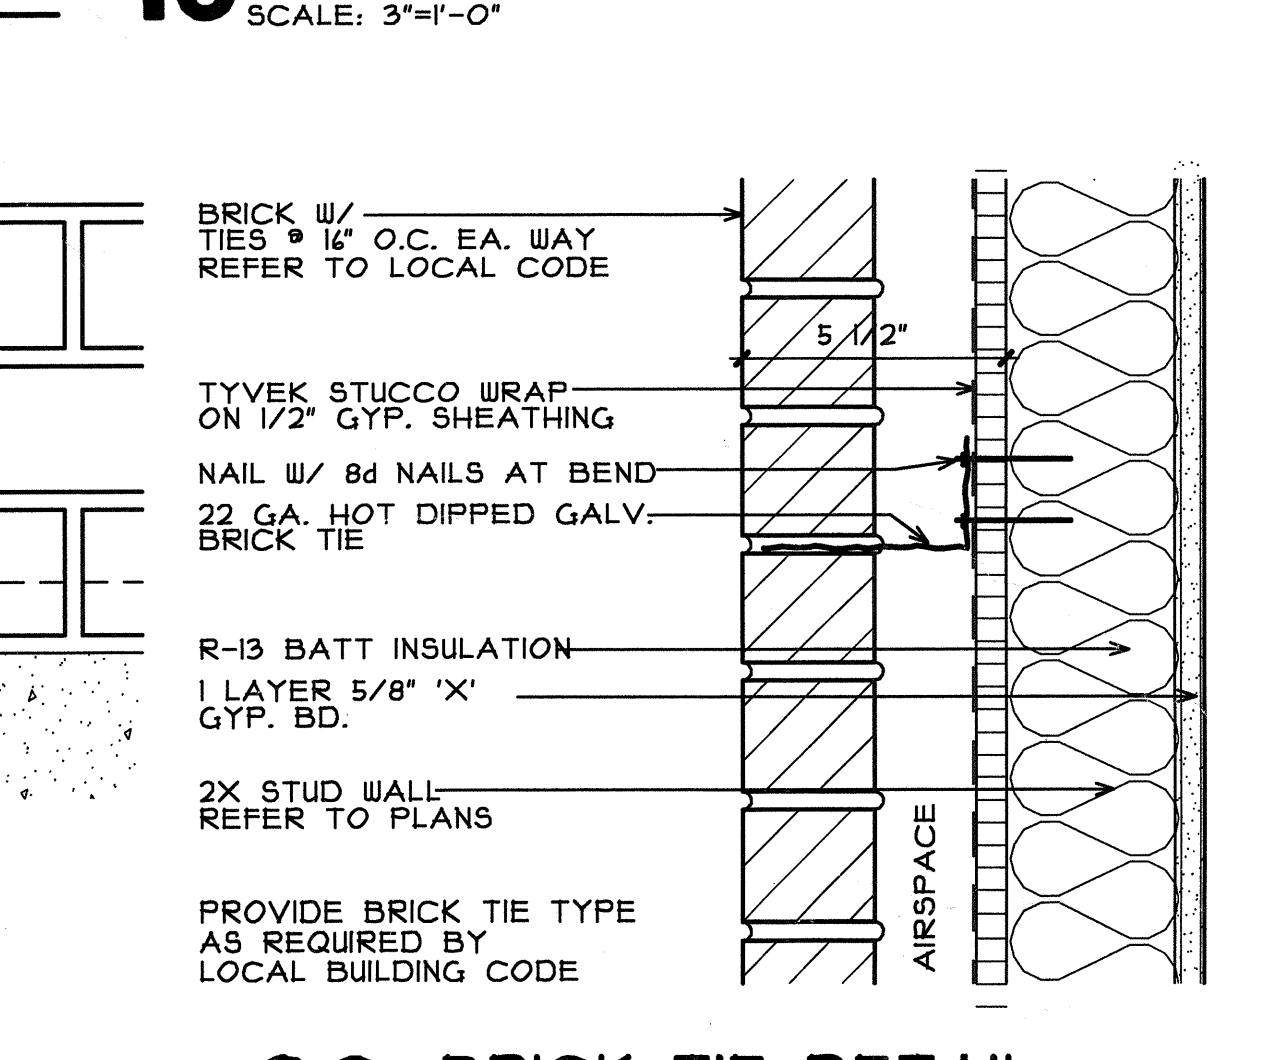

20 BRICK TIE DETAIL
SCALE: 3/4"=1'-0"

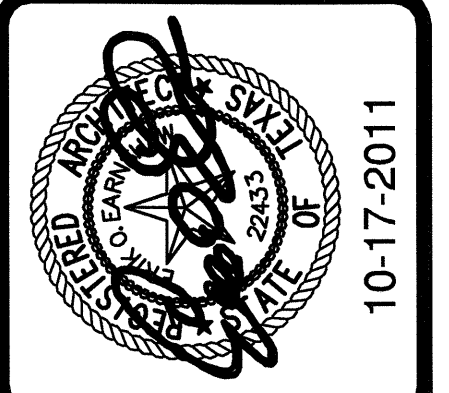

REVISIONS
COORDINATION
10-17-2011

KELLER SPRINGS LOFTS
LOFT APARTMENTS IN ADDISON, TEXAS

CONSTRUCTION ISSUE
10-17-2011

BGO architects

4144 N. Central Expy.
Suite 855
Dallas, TX 75204
214.520.8878
bgoarchitects.com

DATE
08-05-2011

PROJECT
11129

SHEET NUMBER

8.3

DETAILS

COPYRIGHT © Beiler Guest Owens Architects ALL RIGHTS RESERVED