

10-17-2011

REVISIONS  
COORDINATION  
10-17-2011

**KELLER SPRINGS LOFTS**  
LOFT APARTMENTS IN ADDISON, TEXAS

CONSTRUCTION ISSUE  
10-17-2011

**BGO**  
architects

4144 N. Central Expy.  
Suite 855  
Dallas, TX 75204  
214.520.8878  
bgoarchitects.com


DATE  
08-05-2011

PROJECT  
11129


SHEET NUMBER

**8.6**  
AWNING DETAILS

COPYRIGHT © Beeler, Guest, Owens Architects ALL RIGHTS RESERVED

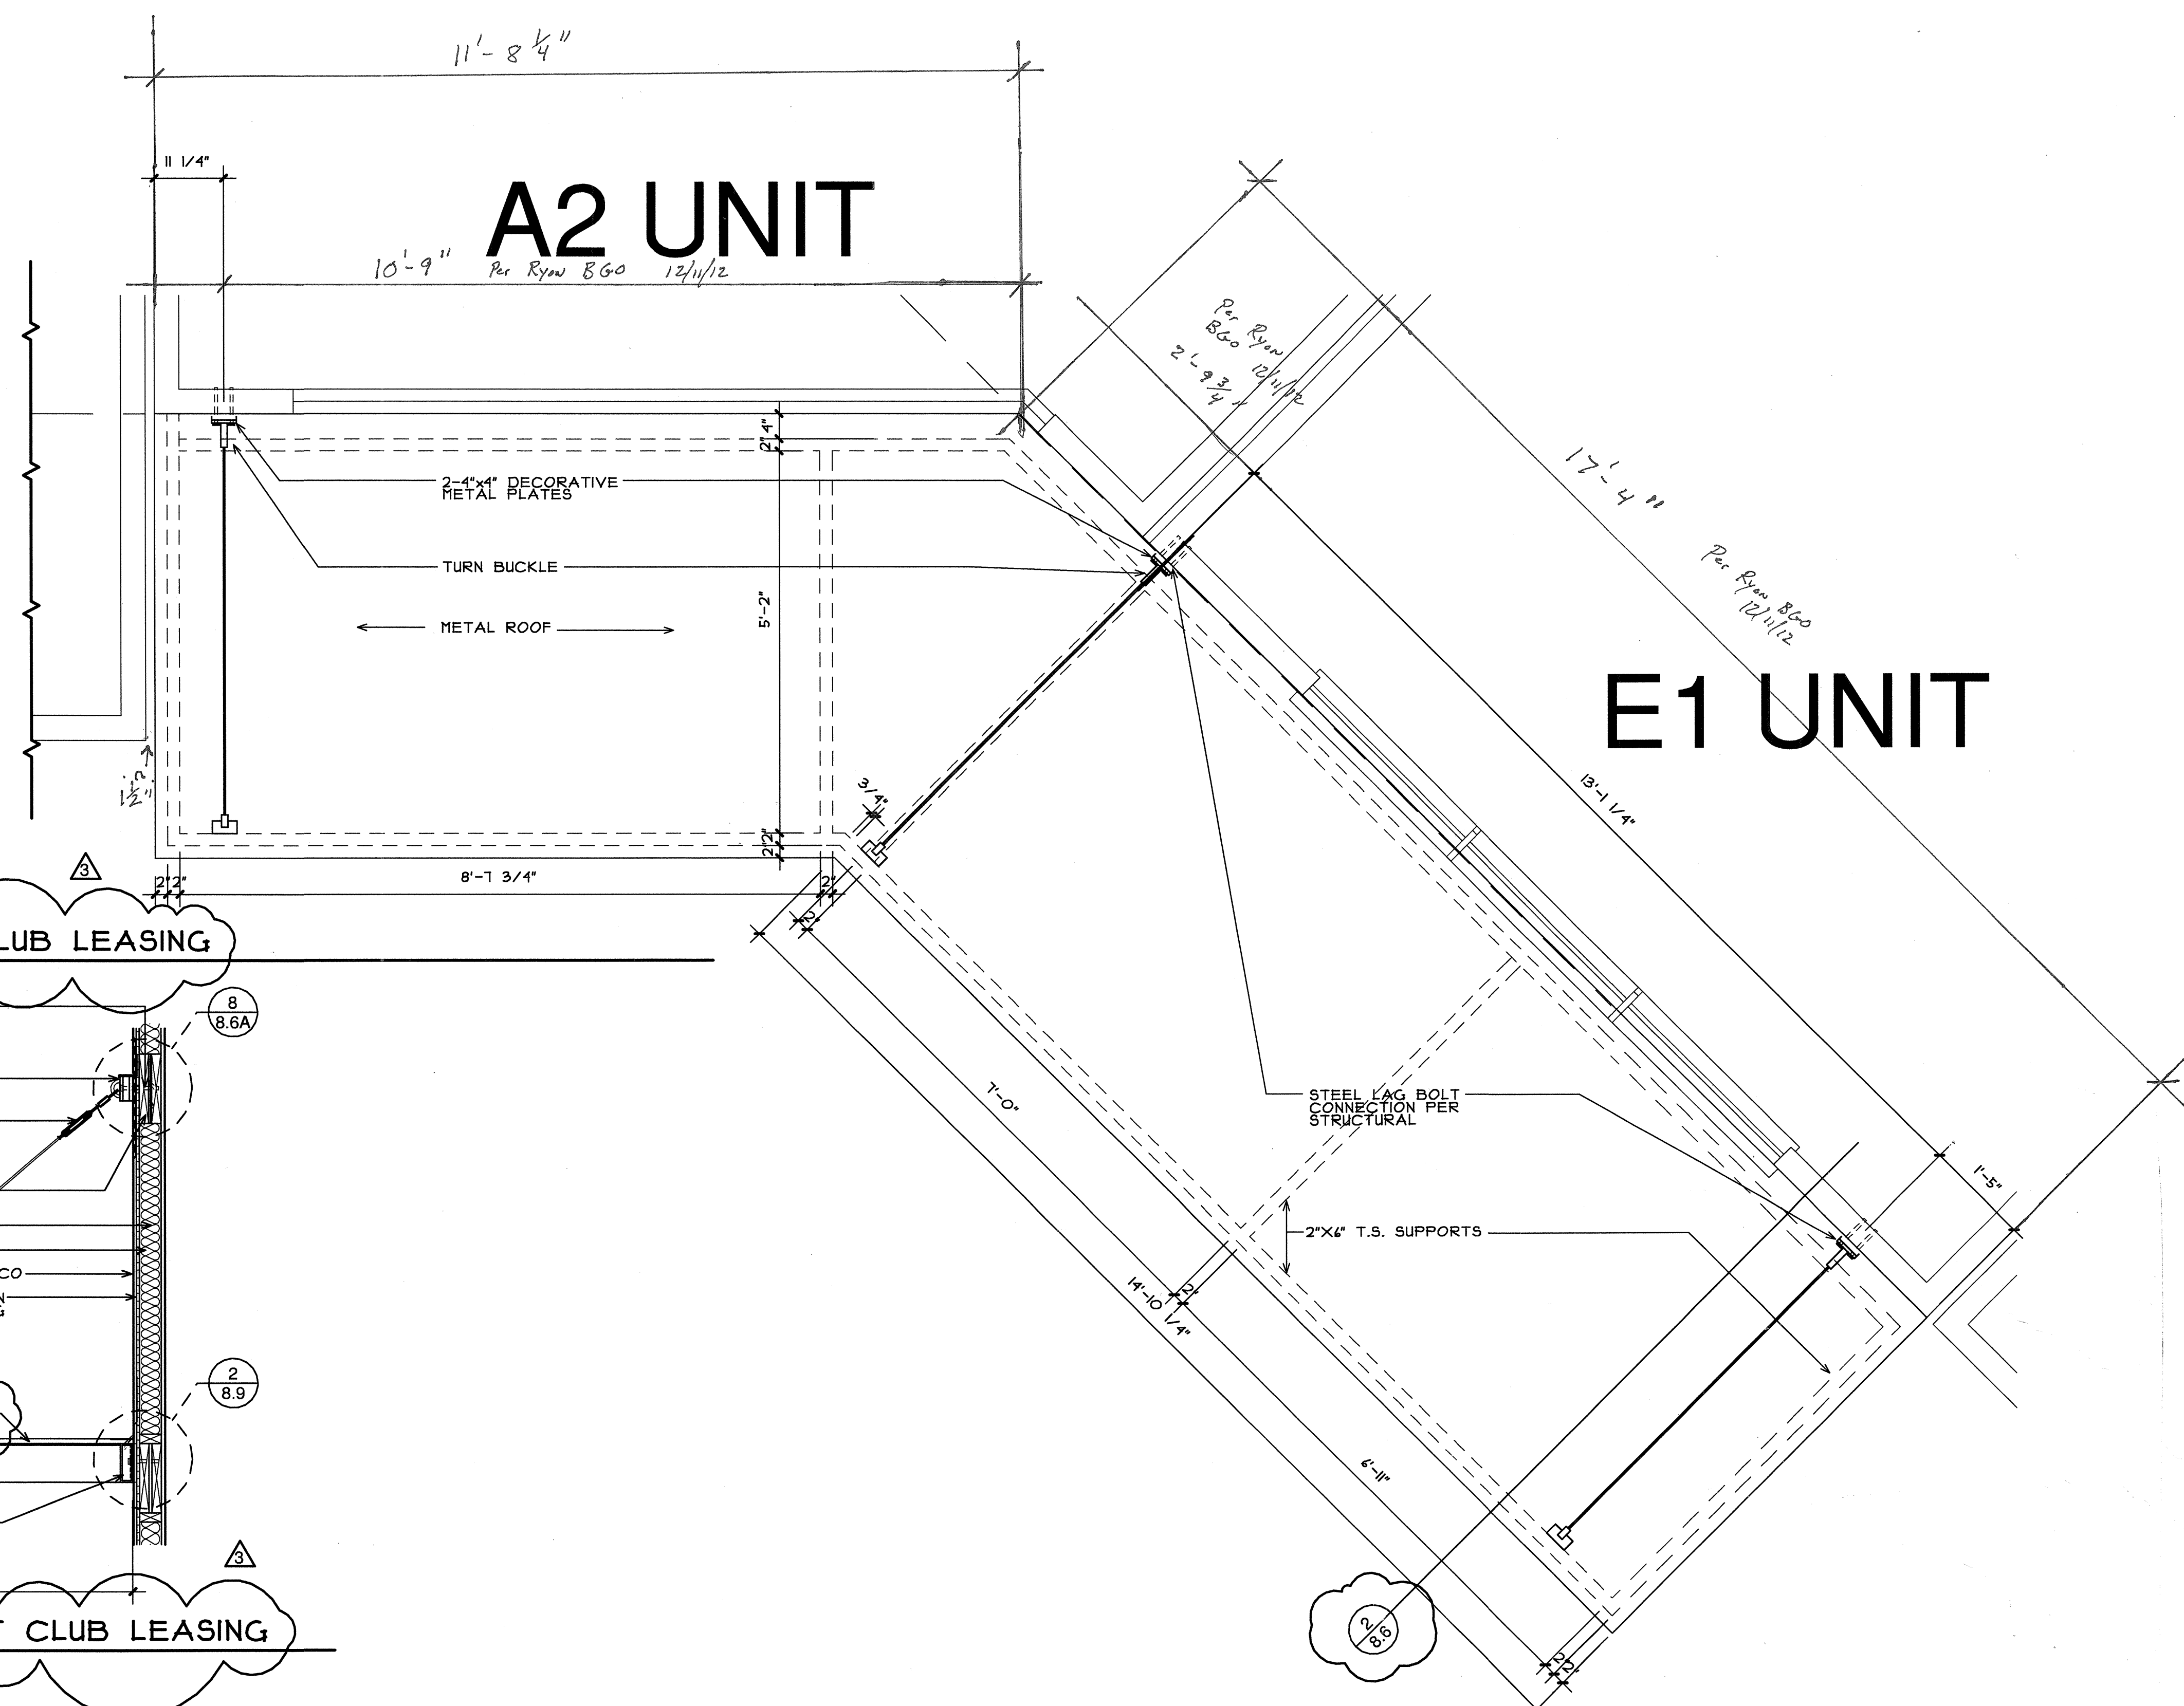

**1 AWNING PLAN - AT CLUB LEASING**  
SCALE 3/4"=1'-0"

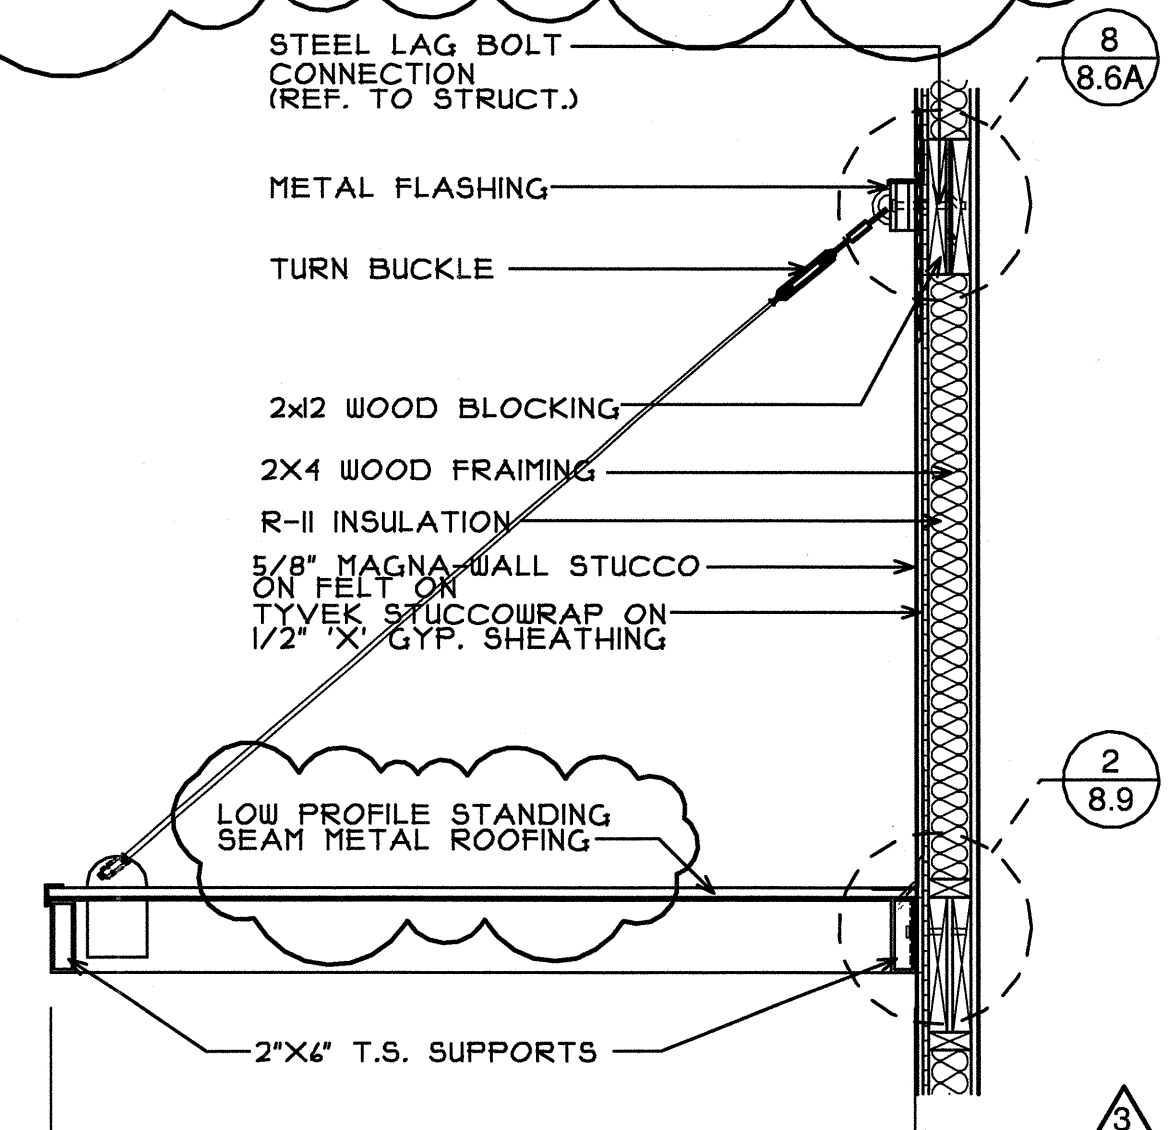

**2 AWNING SECTION - AT CLUB LEASING**  
SCALE 3/4"=1'-0"

