




**1 EXPANSION JOINT @ HEAD**  
SCALE: 3"=1'-0"

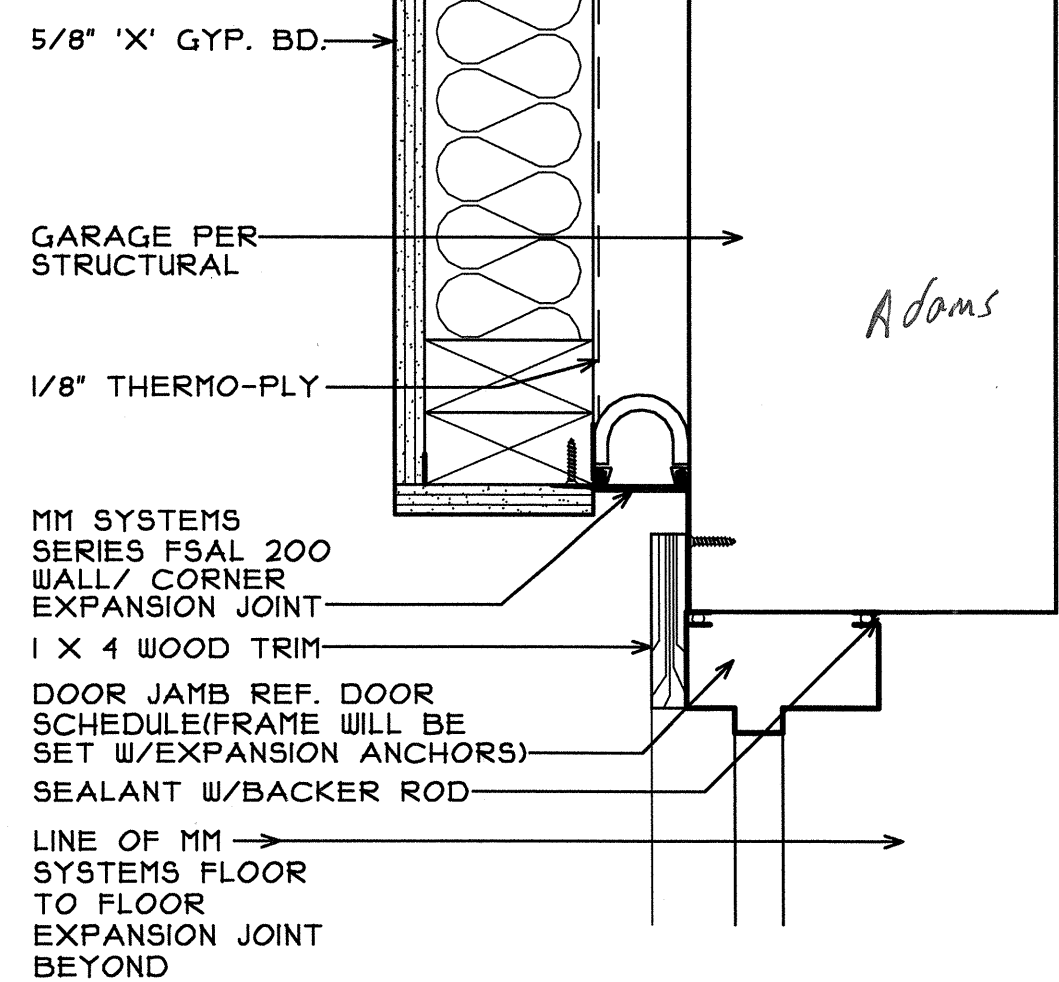


**2 EXPANSION JOINT @ JAMB**  
SCALE: 3"=1'-0"

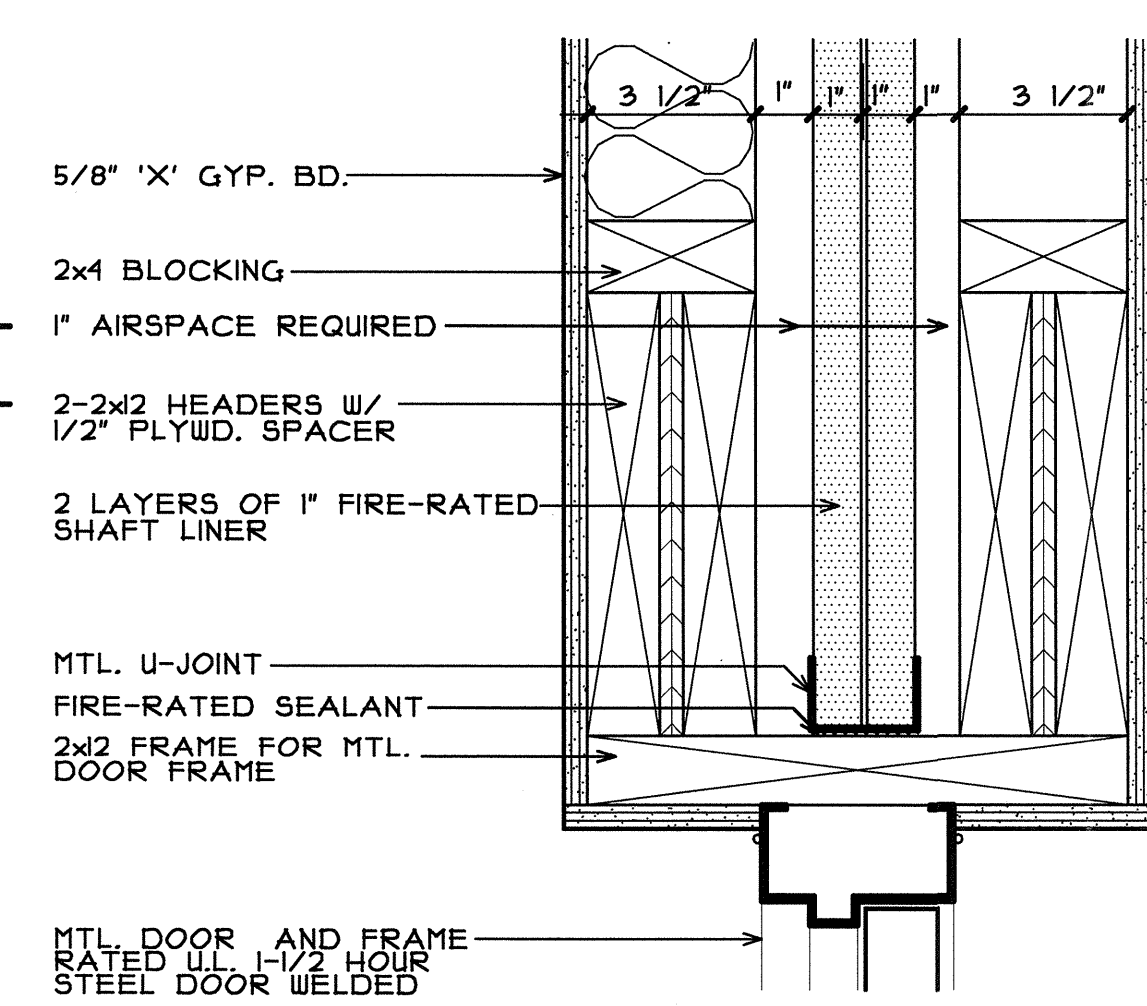


**5 DOOR HEAD @ 2 HR WALL**  
SCALE: 3"=1'-0"

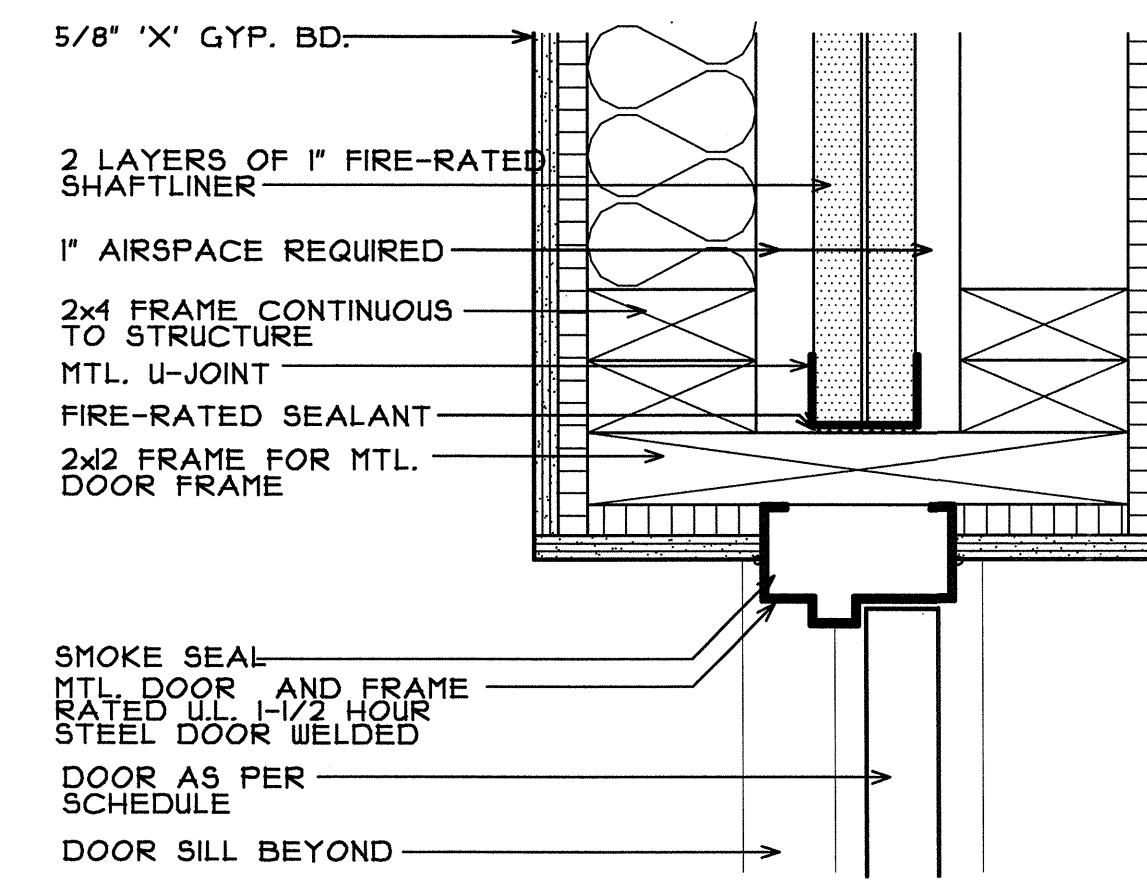


**6 DOOR JAMB @ 2 HR WALL**  
SCALE: 3"=1'-0"

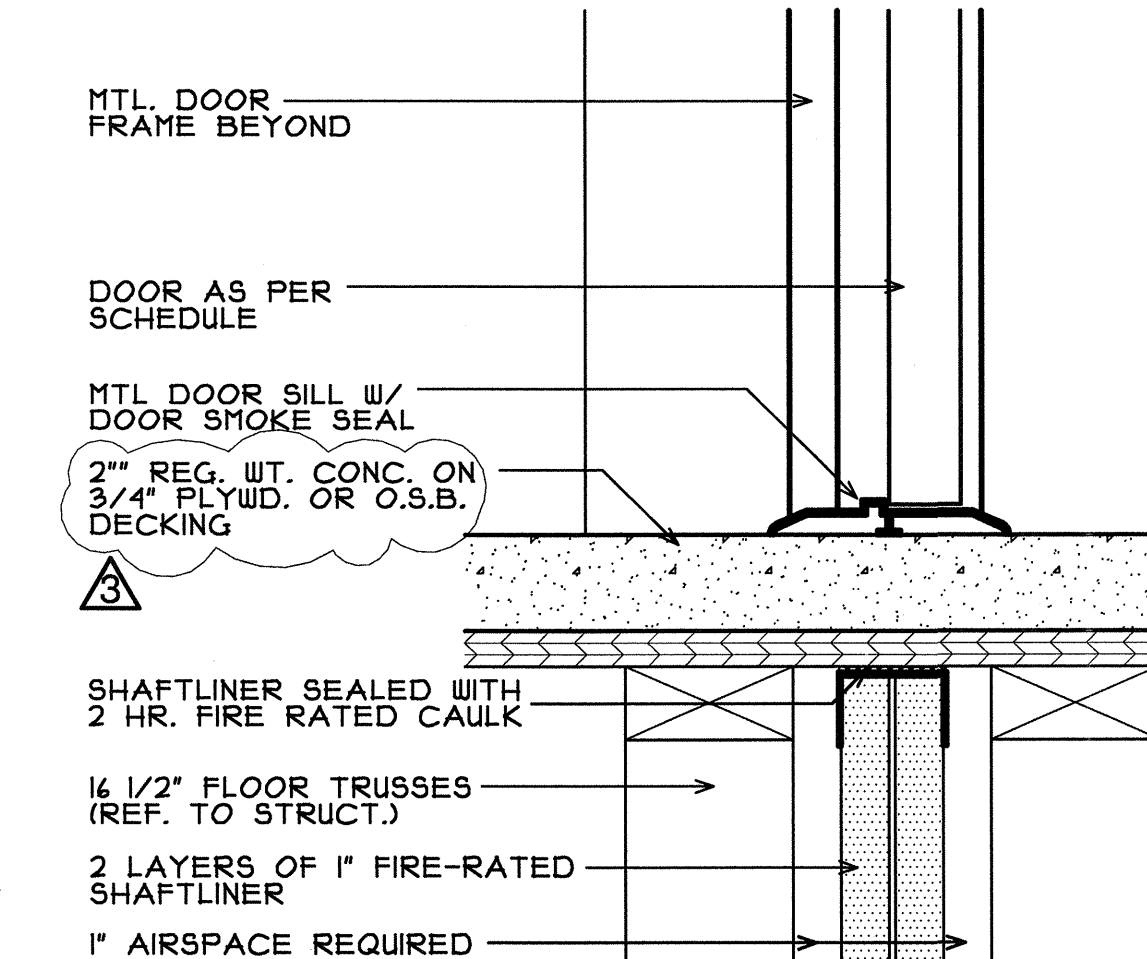


**7 DOOR SILL @ 2 HR WALL**  
SCALE: 3"=1'-0"

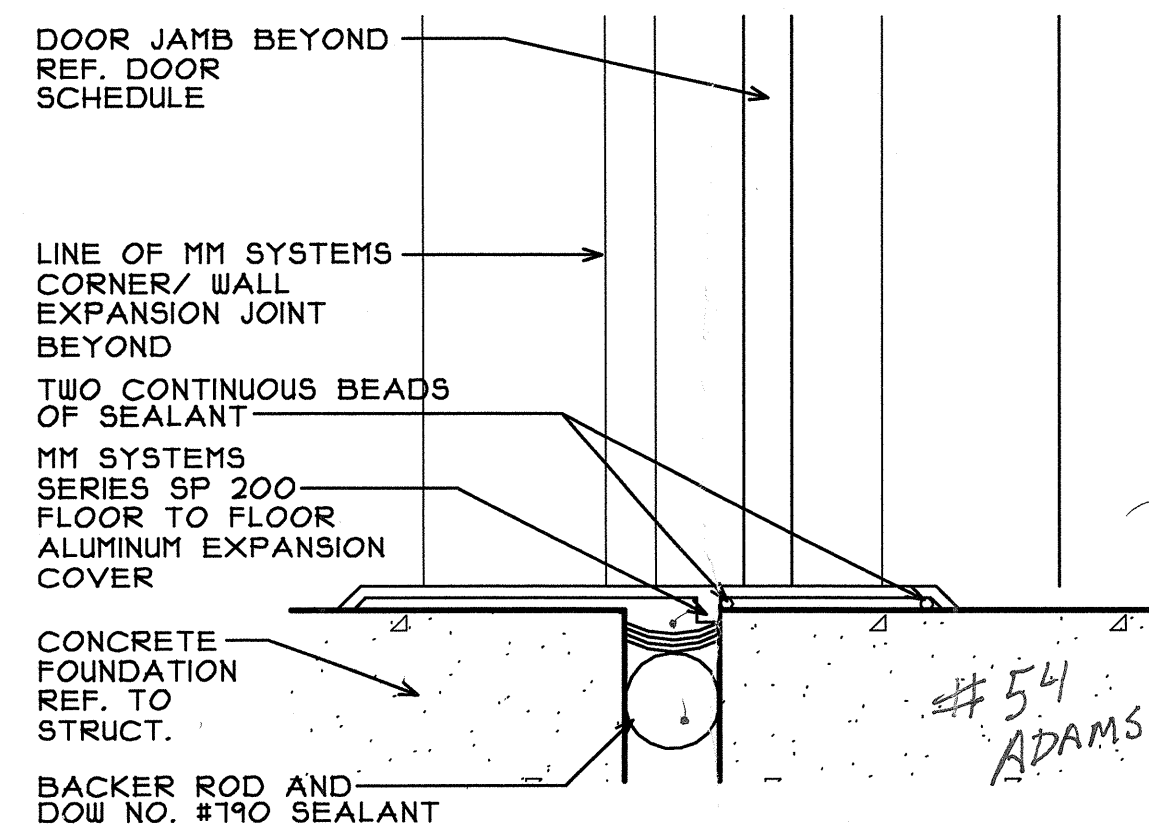


**4 EXPANSION JOINT @ SILL**  
SCALE: 3"=1'-0"

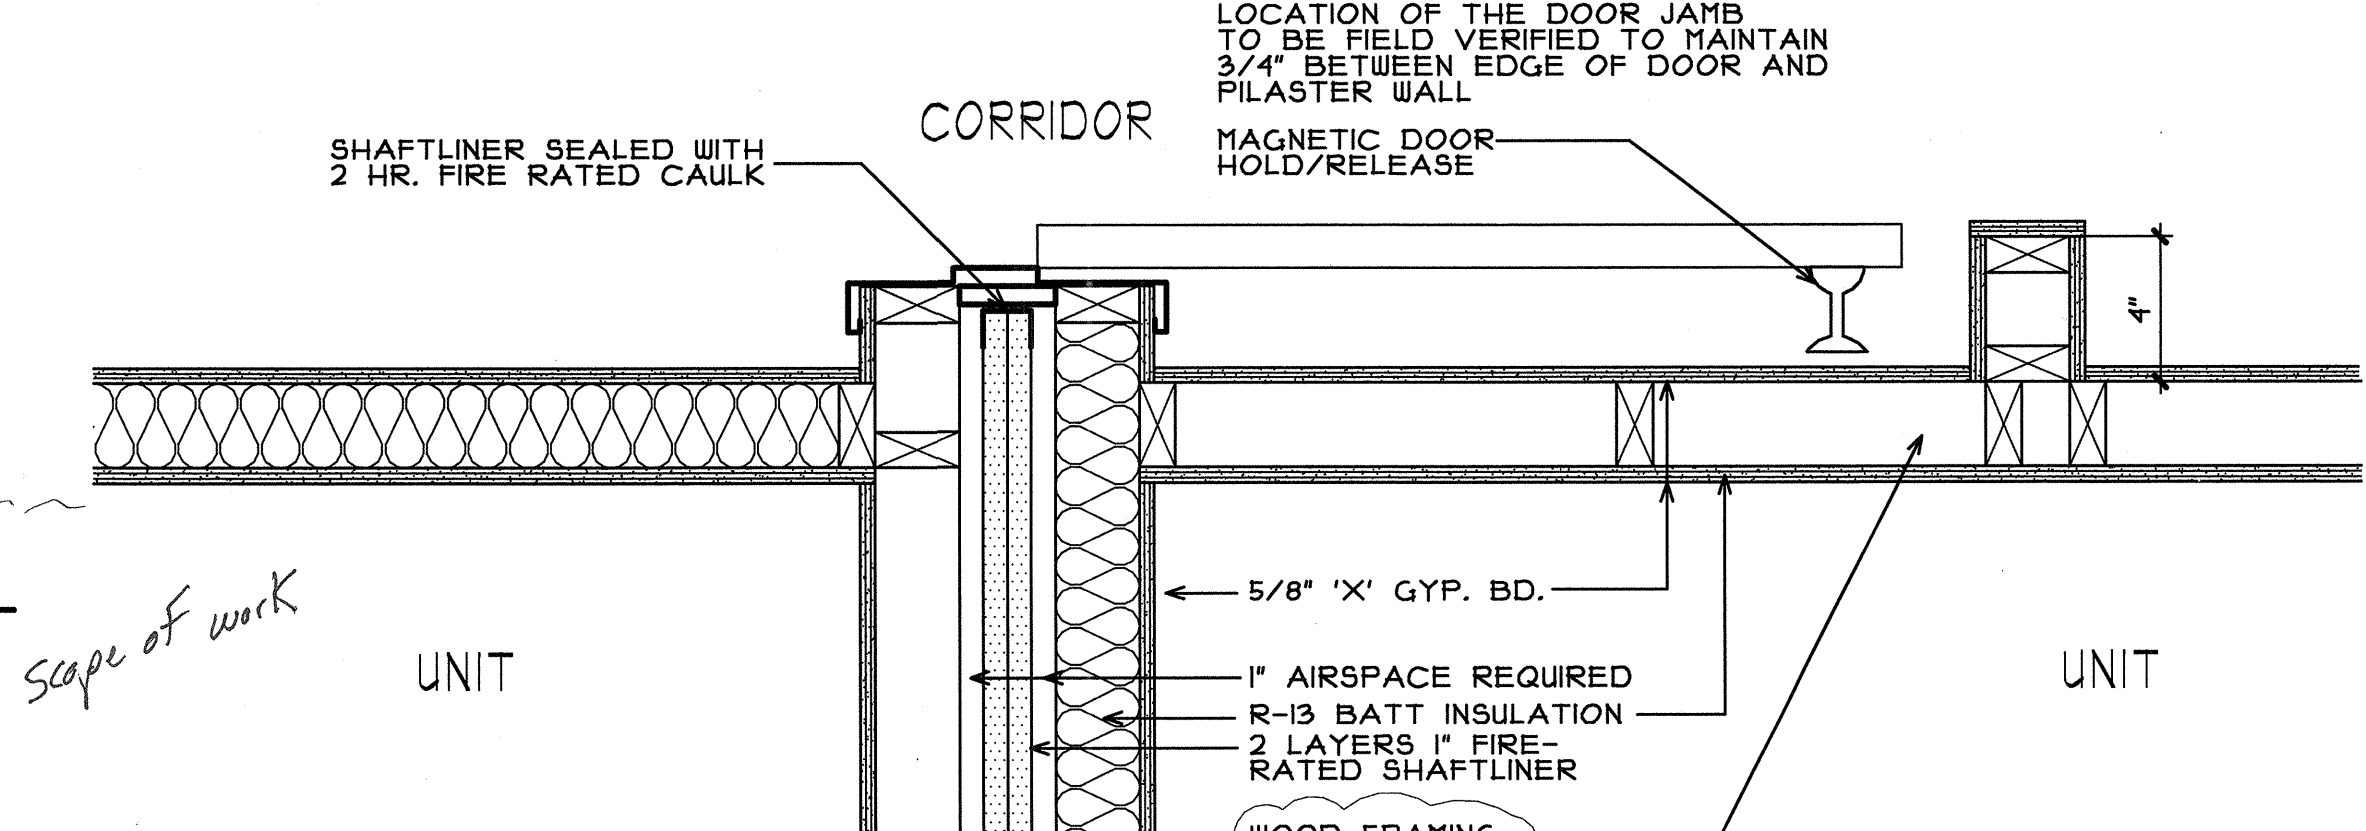


**8 PILASTER @ 2 HR WALL**  
SCALE: 3"=1'-0"

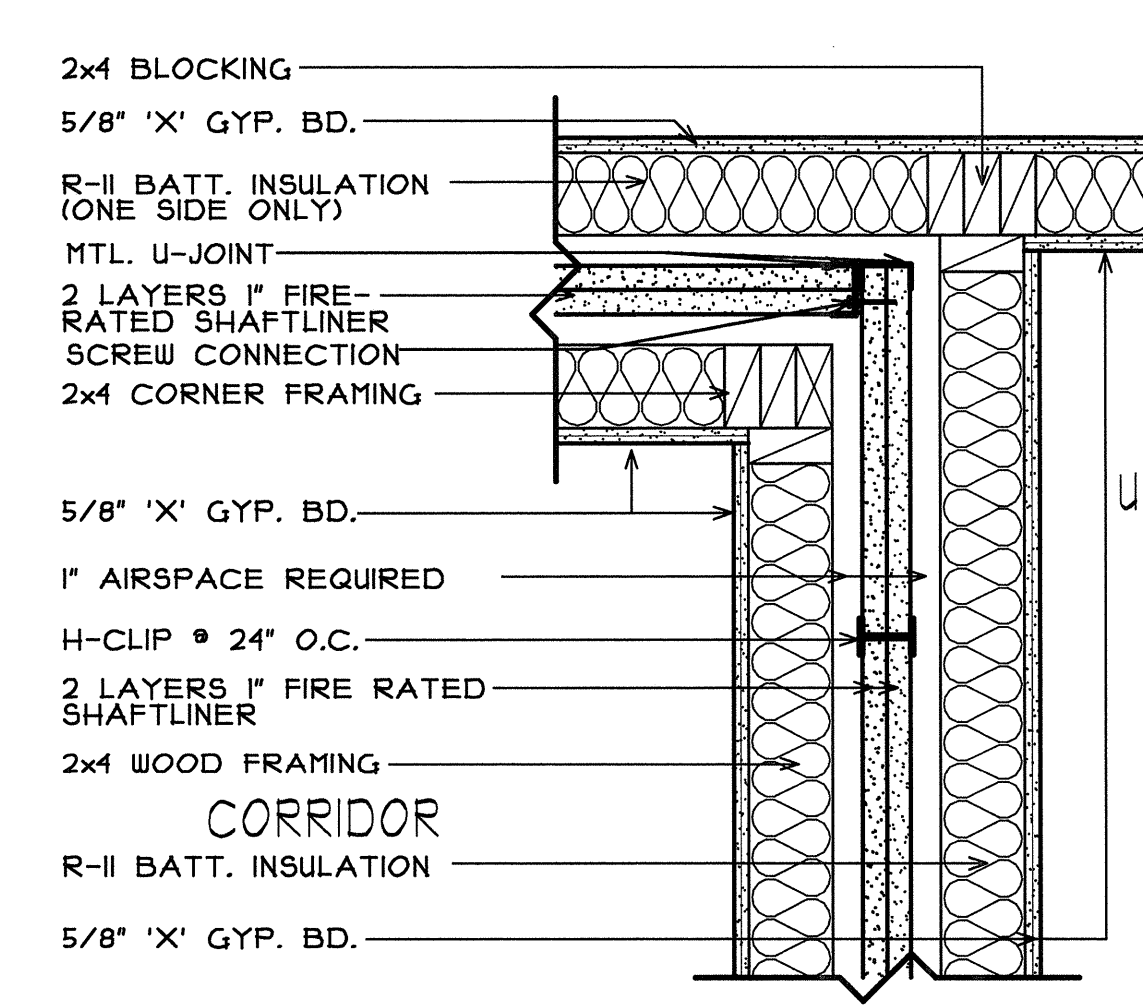


**9 CORRIDOR INSIDE CORNER @ 2 HR SEP. WALL**  
SCALE: 3"=1'-0"

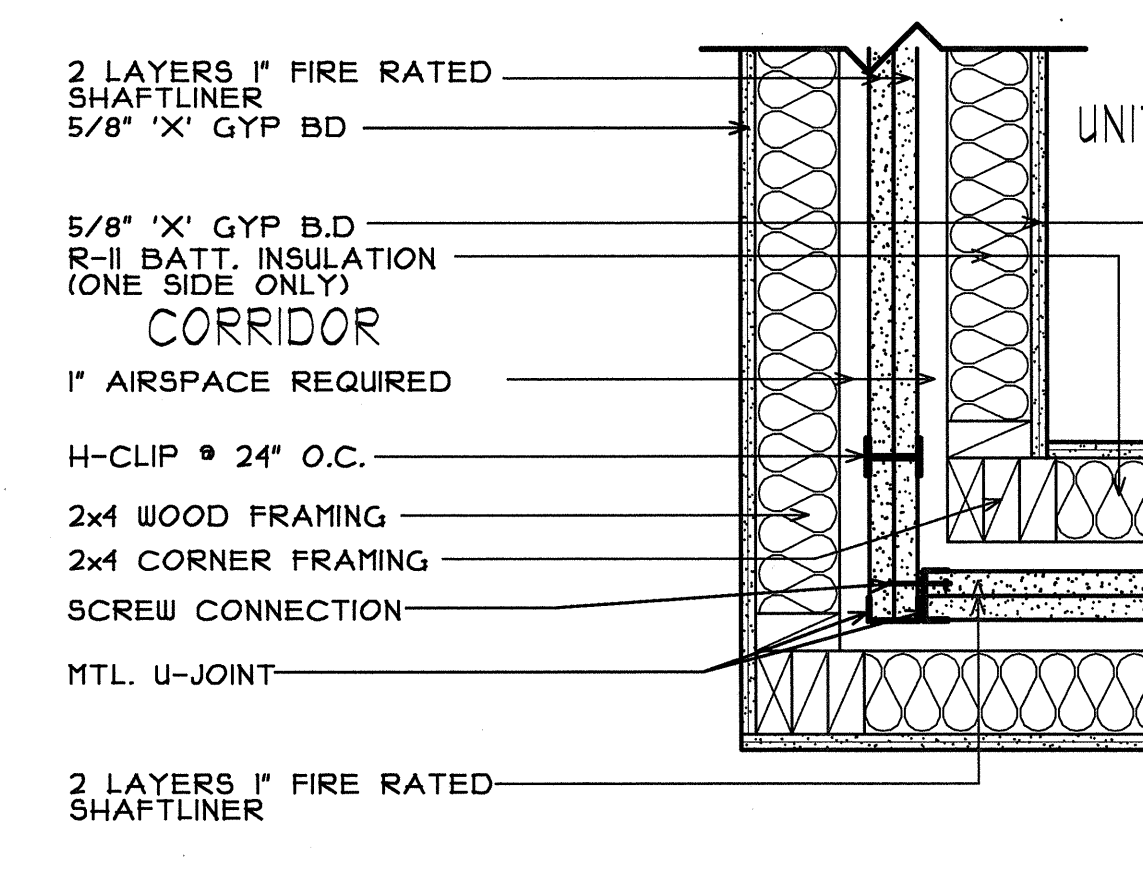

**10 CORRIDOR OUTSIDE CORNER @ 2 HR SEP. WALL**  
SCALE: 3"=1'-0"

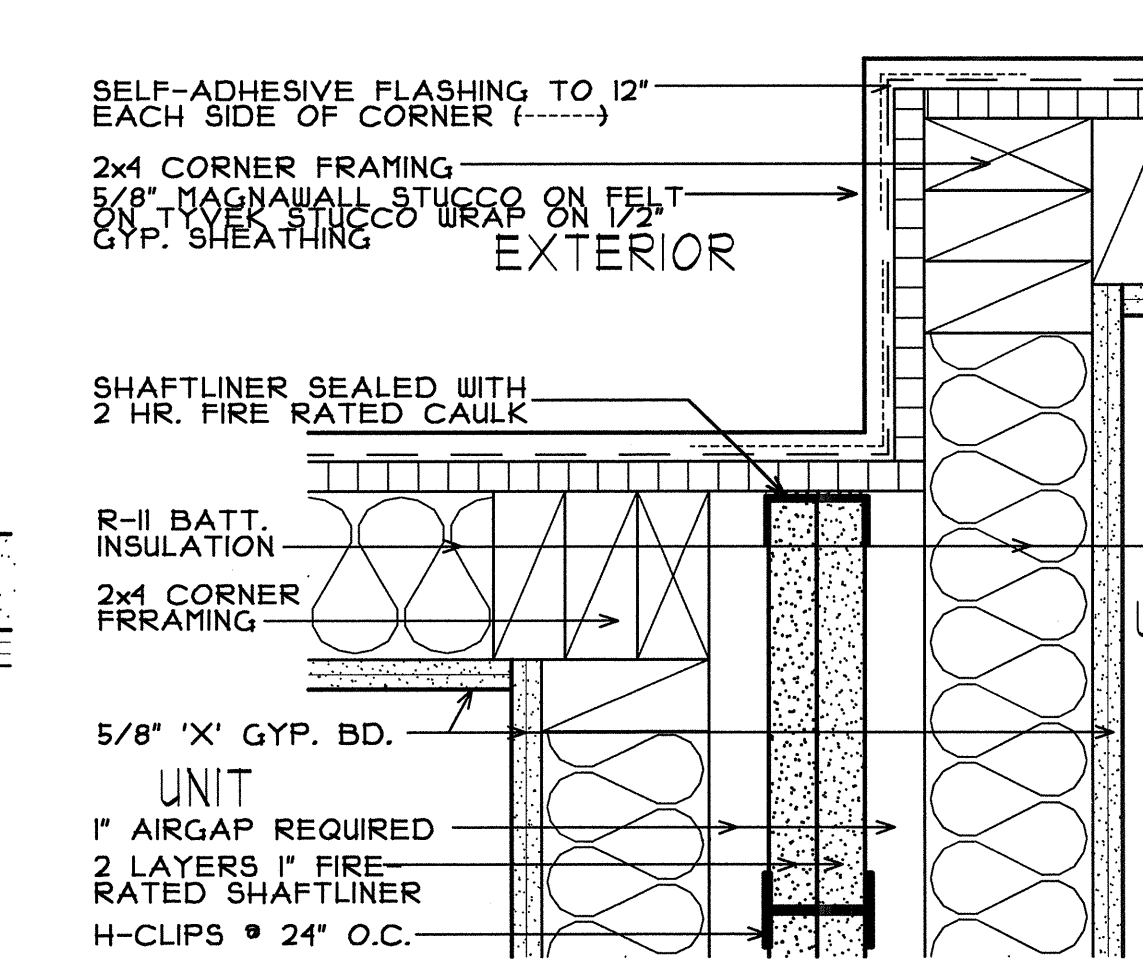


**11 STUCCO INSIDE CORNER @ 2 HR. SEP. WALL**  
SCALE: 3"=1'-0"

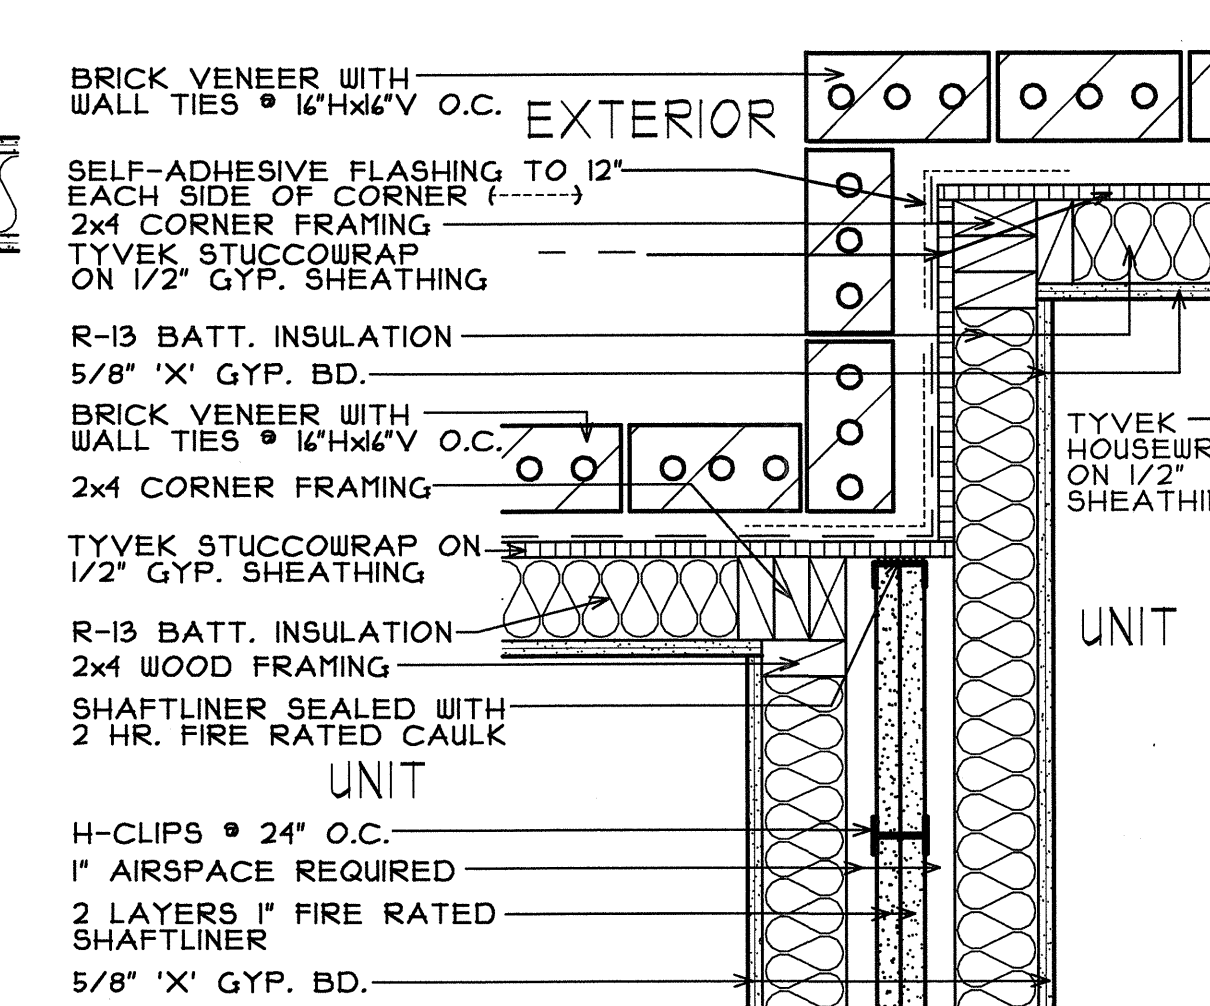


**13 BRICK @ 2HR SEP. WALL**  
SCALE: 3"=1'-0"




**15 BRICK INSIDE CORNER**  
SCALE: 3"=1'-0"

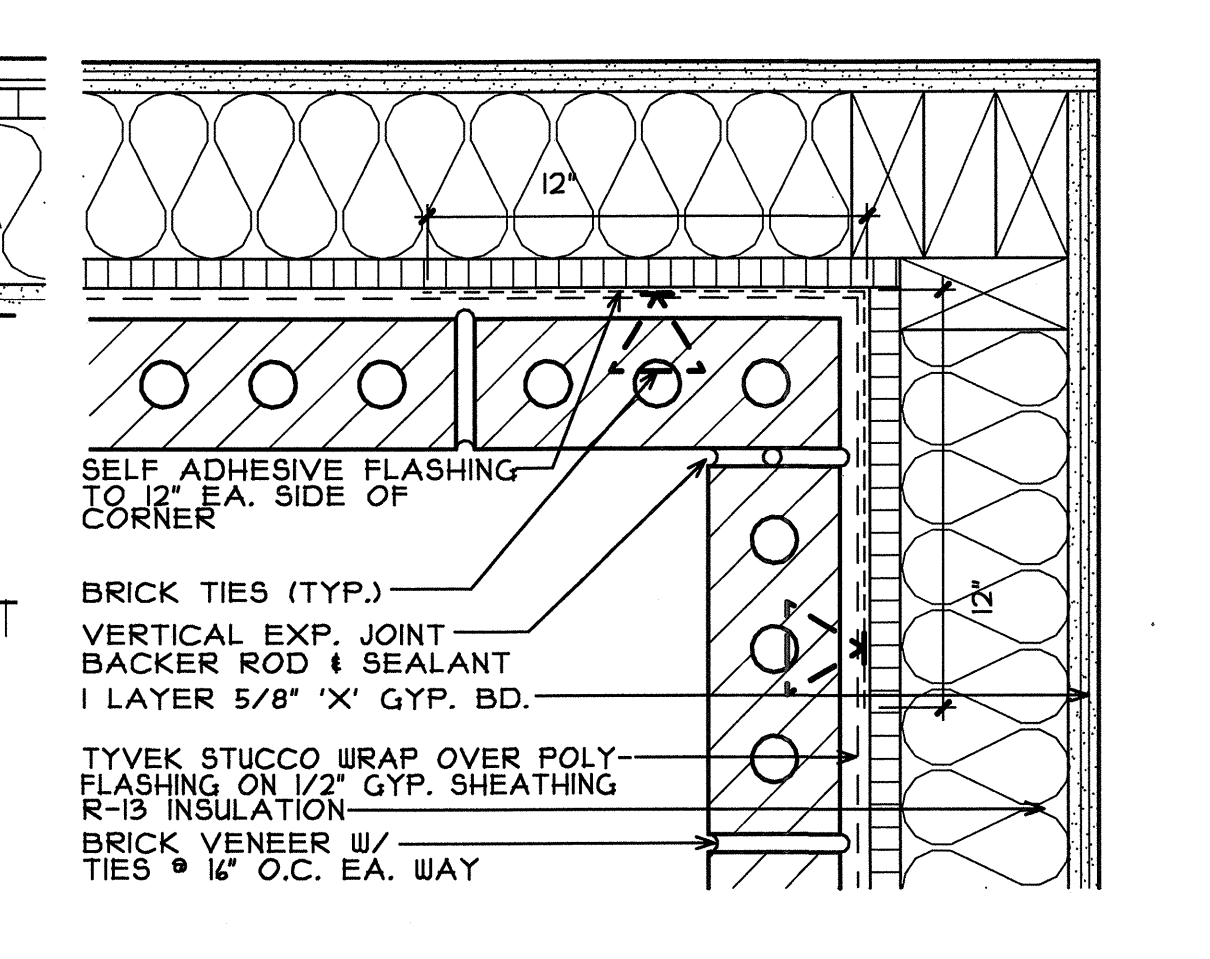


**16 BRICK OUTSIDE CORNER**  
SCALE: 3"=1'-0"

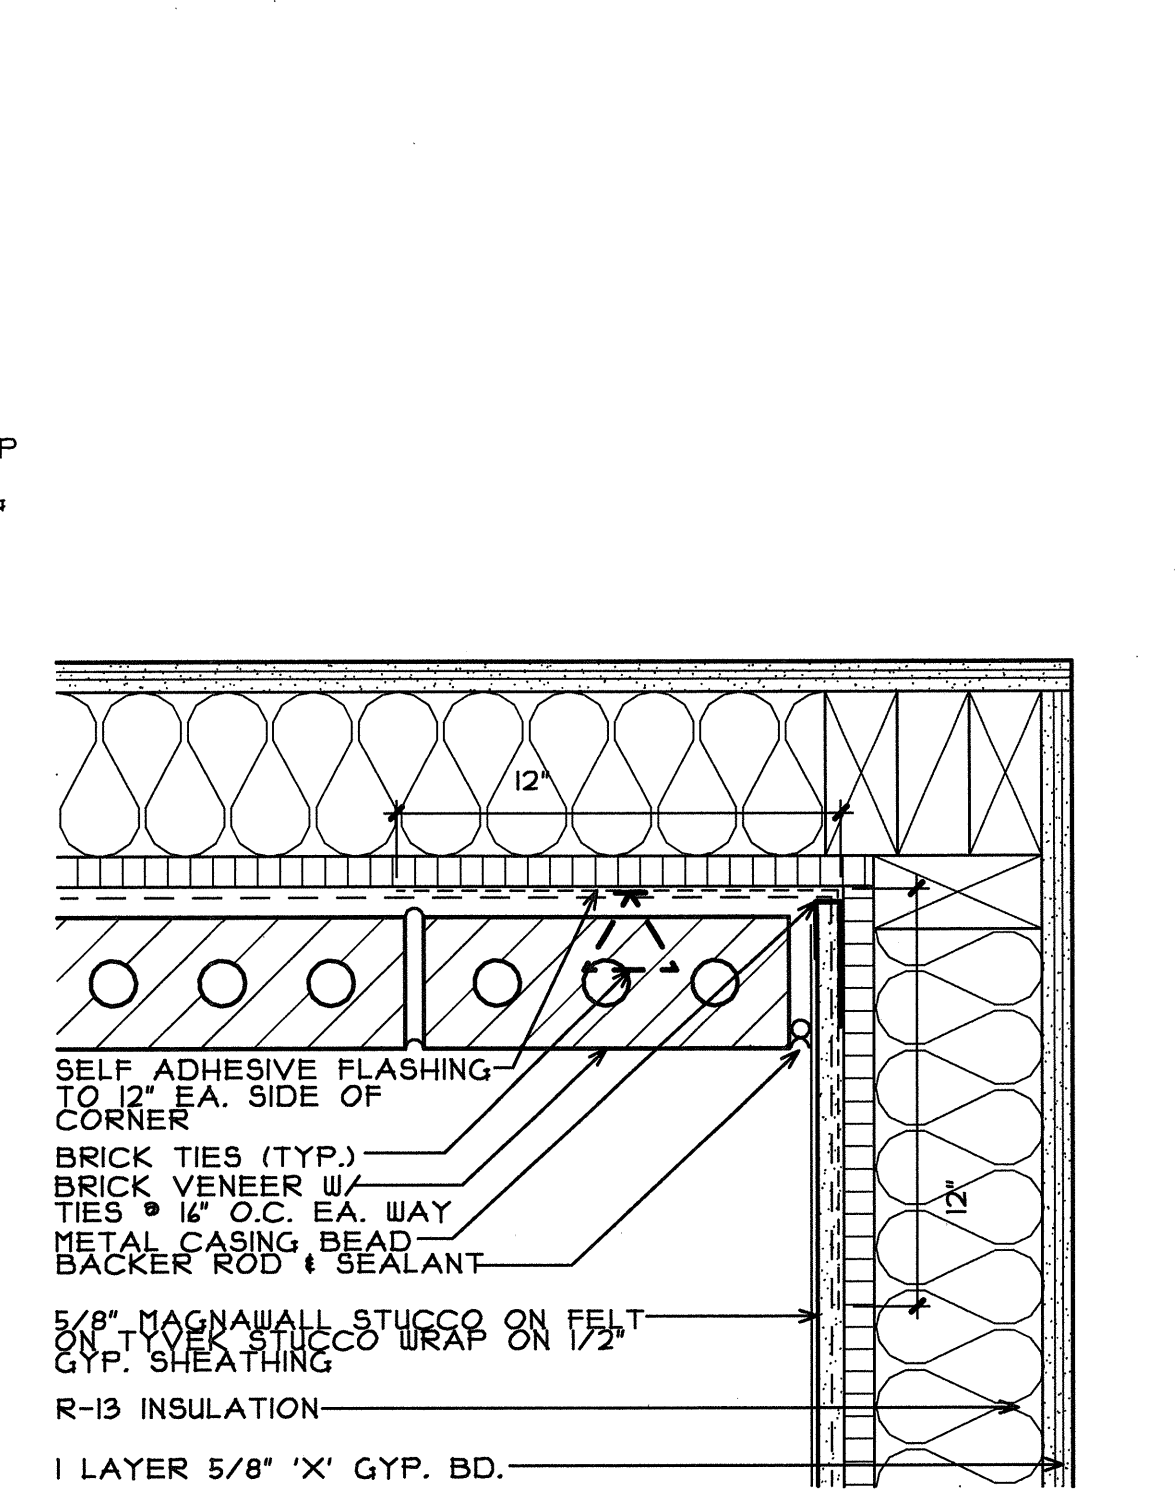


**17 BRICK/STUCCO INSIDE CORNER**  
SCALE: 3"=1'-0"

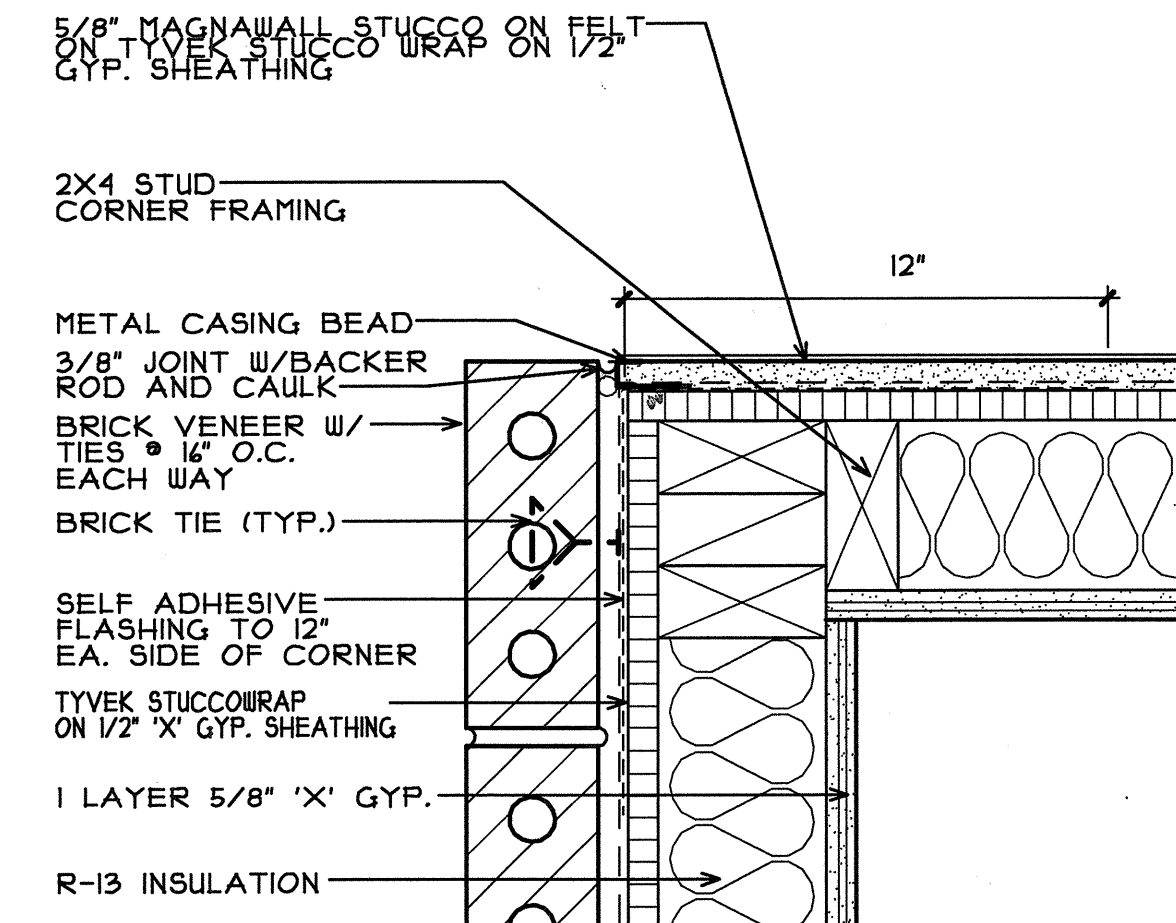

**18 BRICK/STUCCO OUTSIDE CORNER**  
SCALE: 3"=1'-0"

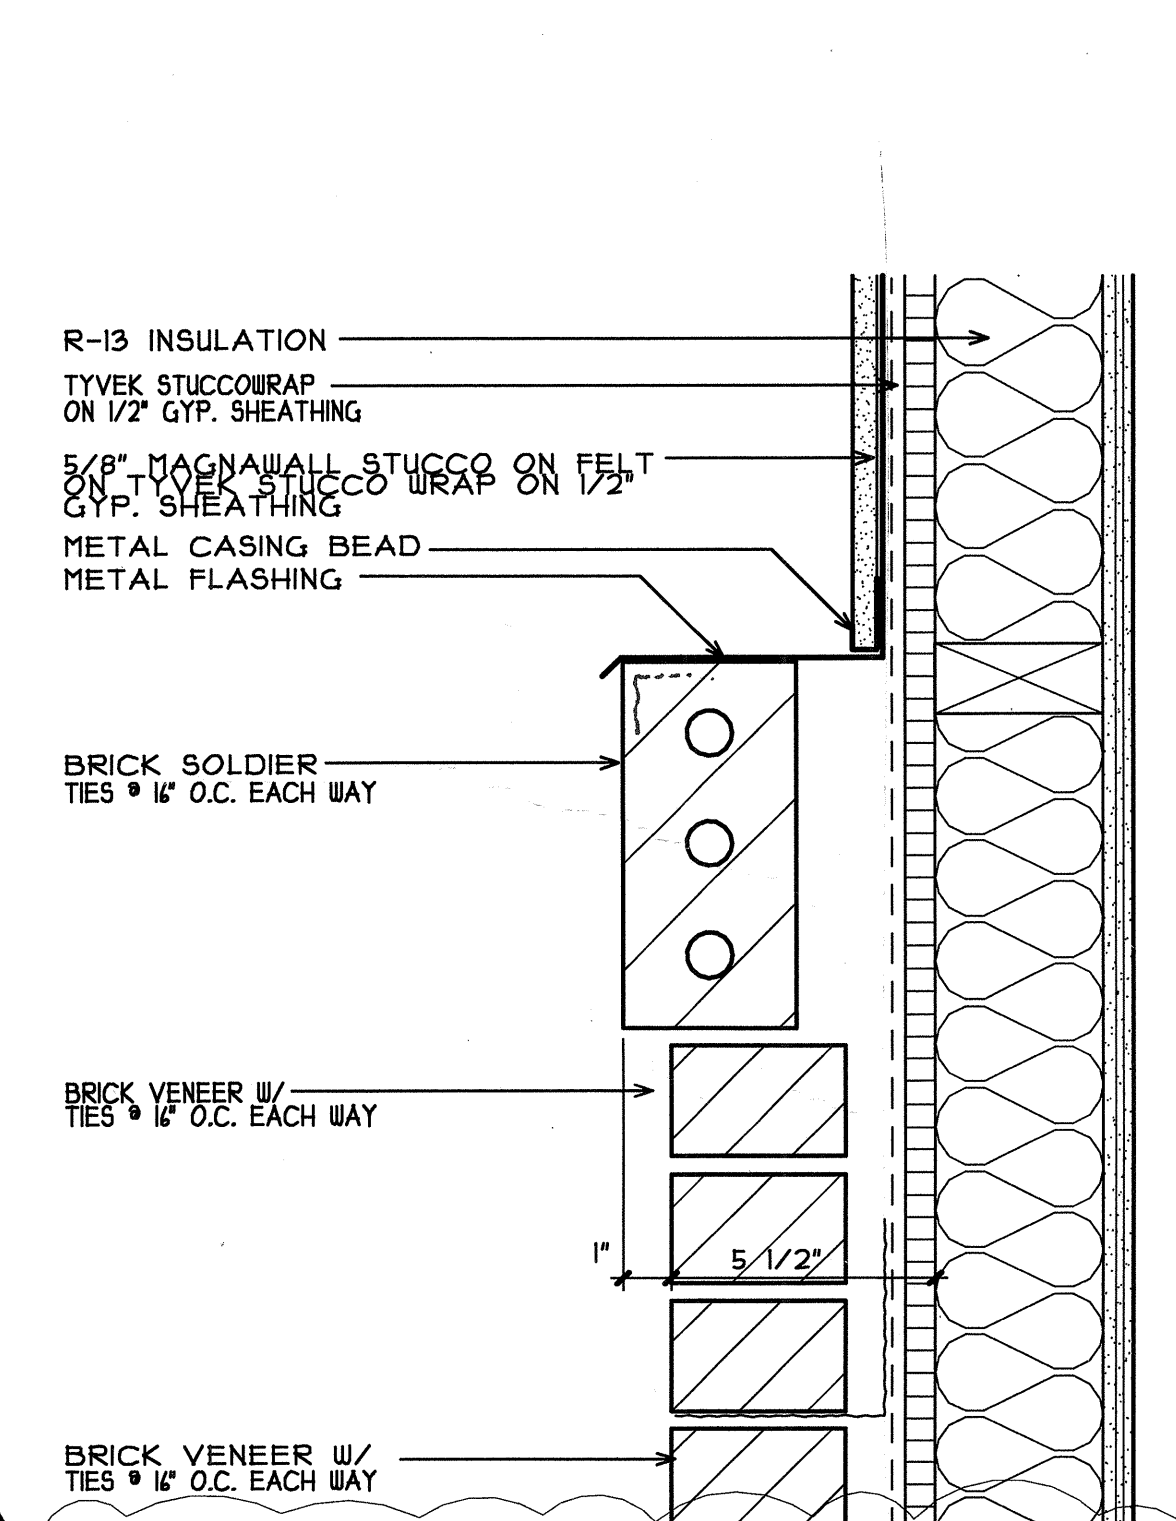

**19 STUCCO/BRICK TRANSITION**  
SCALE: 3"=1'-0"

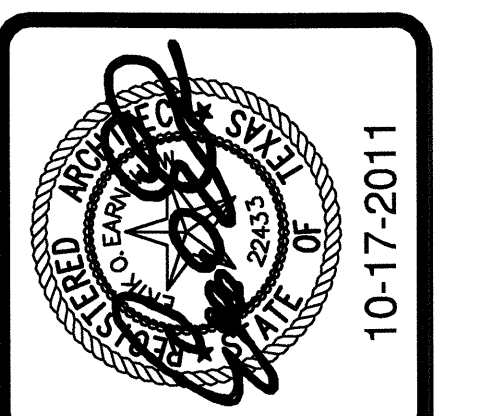

REVISIONS  
COORDINATION  
10-17-2011

**KELLER SPRINGS LOFTS**  
LOFT APARTMENTS IN ADDISON, TEXAS

CONSTRUCTION ISSUE  
10-17-2011

**BGO architects**  
4144 N. Central Expy. Suite 855  
Dallas, TX 75204  
214.520.8878  
bgoarchitects.com

DATE  
08-05-2011  
PROJECT  
11129  
SHEET NUMBER

**8.7**  
DETAILS

COPYRIGHT © Beiler Guest Owens Architects ALL RIGHTS RESERVED