

10-17-2011

REVISIONS

COORDINATION 10-17-2011

KELLER SPRINGS LOFTS

LOFT APARTMENTS IN ADDISON, TEXAS

CONSTRUCTION ISSUE 10-17-2011



4144 N. Central Expy. Suite 855 Dallas, TX 75204 214.520.8878 bgoarchitects.com

DATE

08-05-2011


PROJECT

11129


SHEET NUMBER

8.8 DETAILS


COPYRIGHT © Beeler, Guest, Owens Architects ALL RIGHTS RESERVED

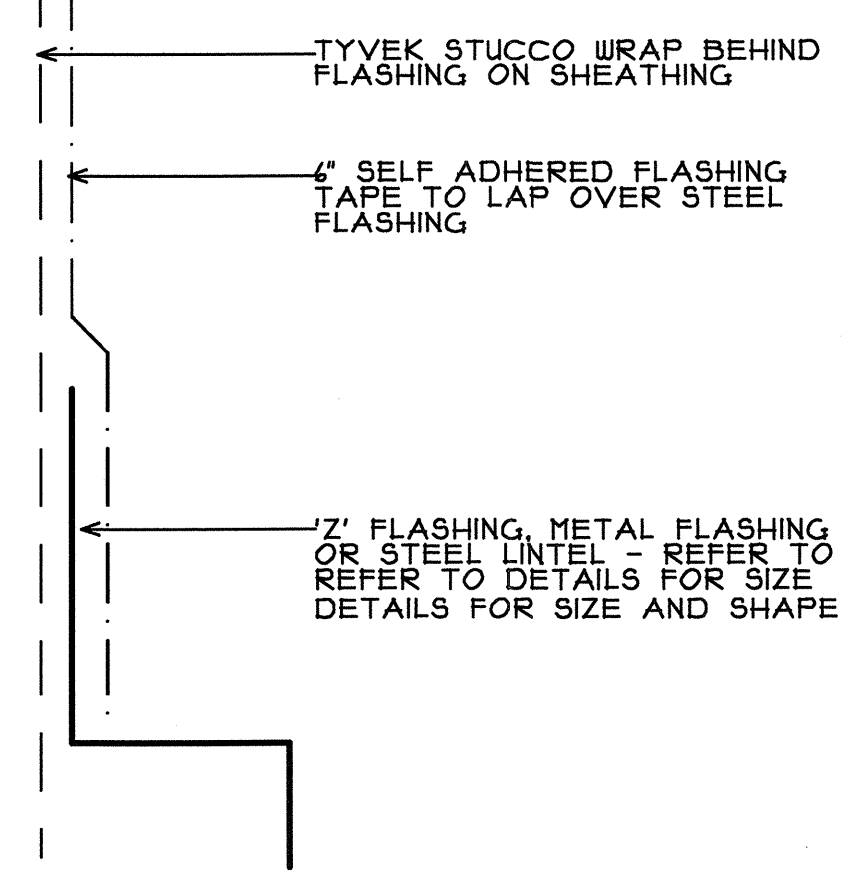


**12 WATERTABLE FLASHING**  
SCALE: NTS

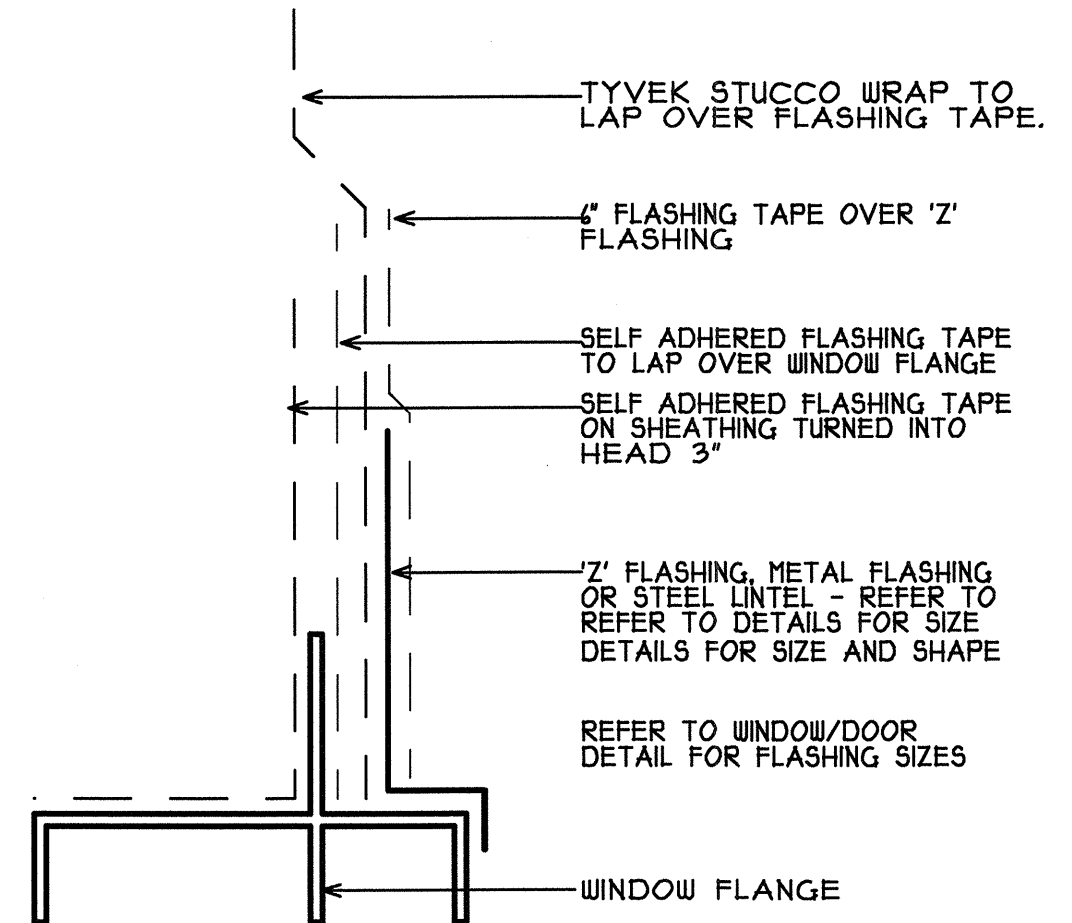


**13 WINDOW/DOOR HEAD FLASHING**  
SCALE: NTS

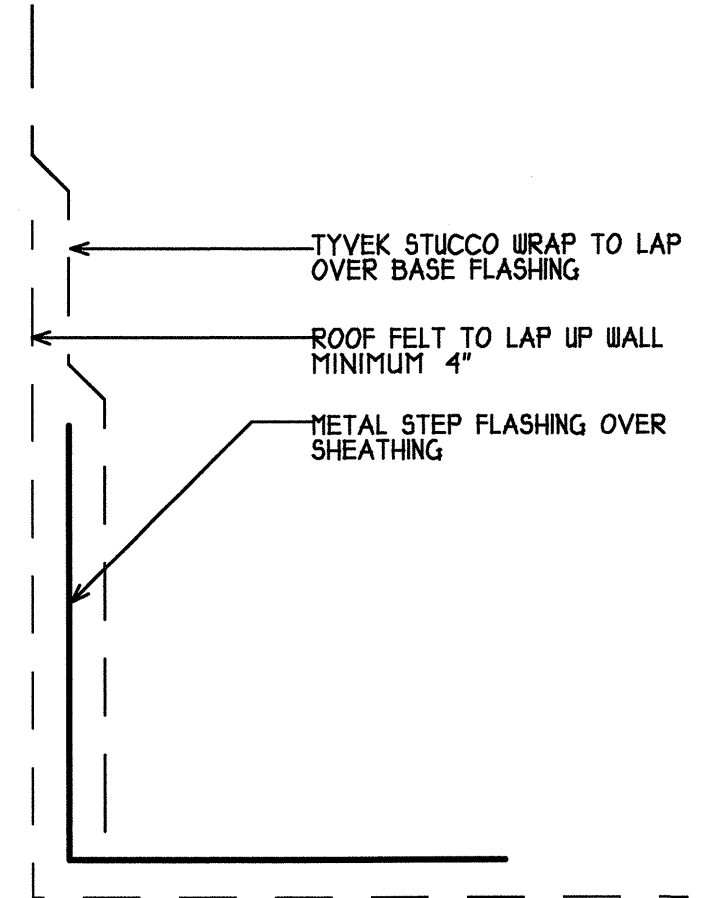


**14 BASE FLASHING**  
SCALE: NTS

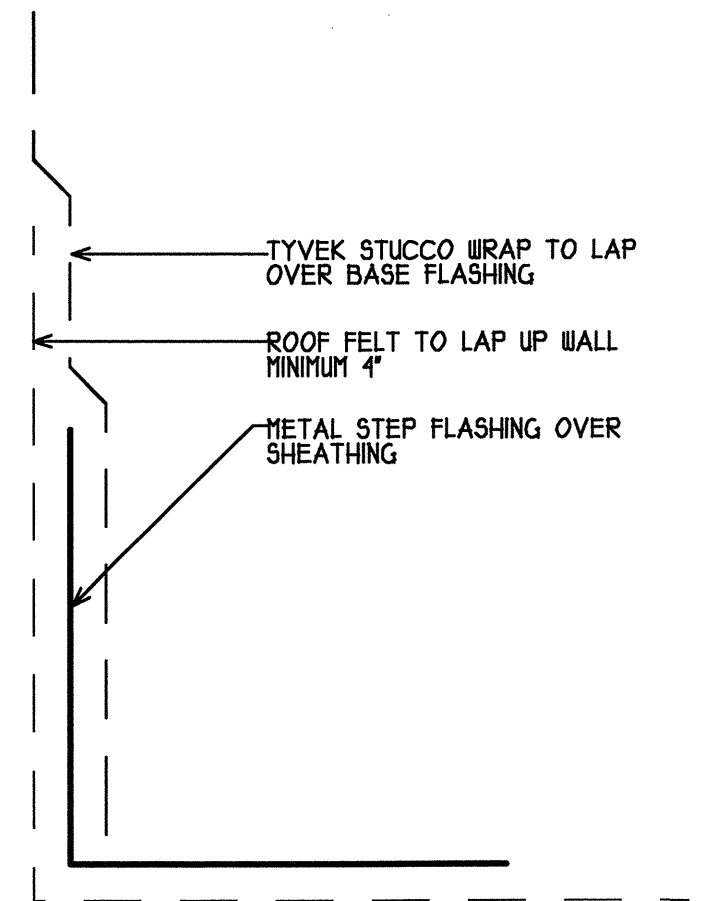


**15 BASE FLASHING**  
SCALE: NTS

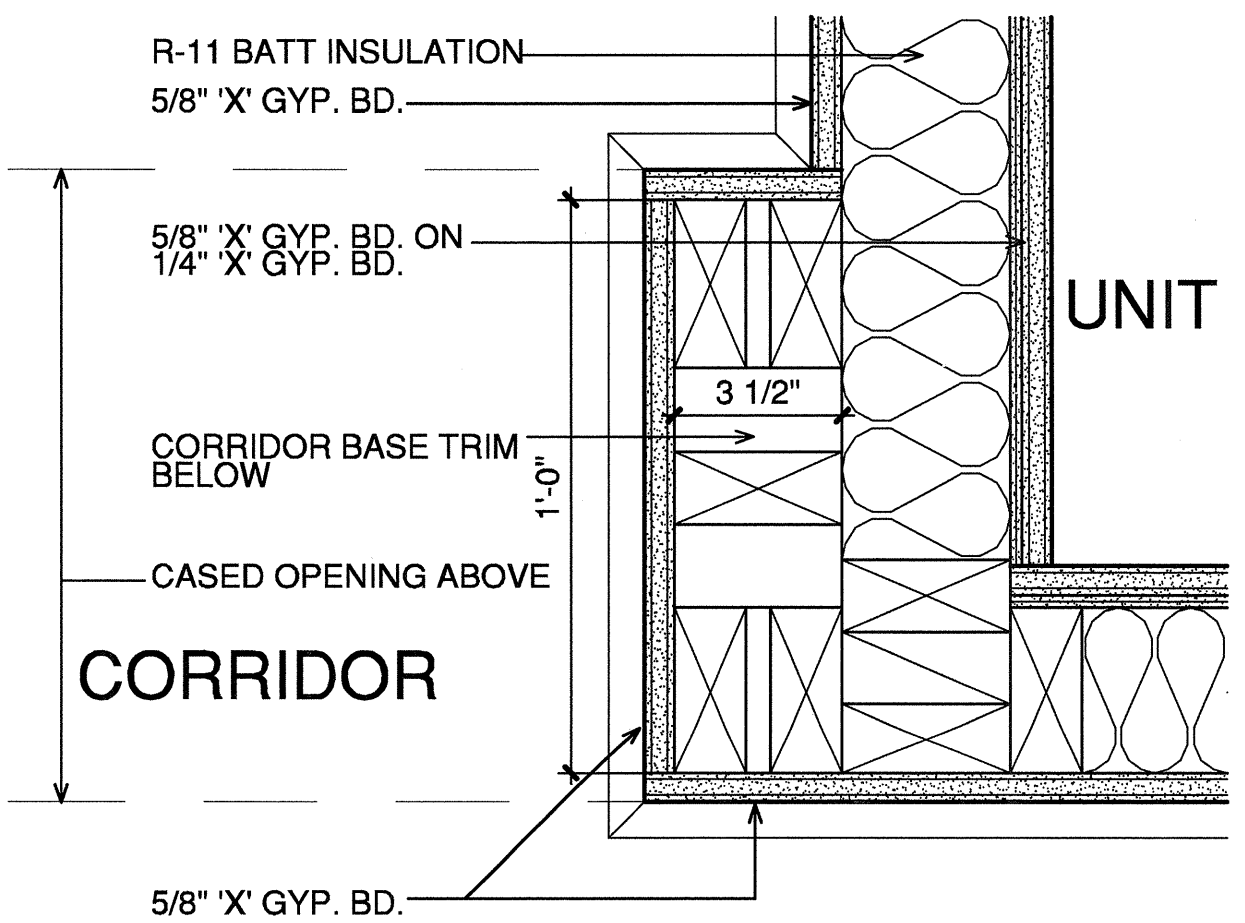


**8 CORRIDOR PILASTER @ CORNER**  
SCALE: 3\"/>

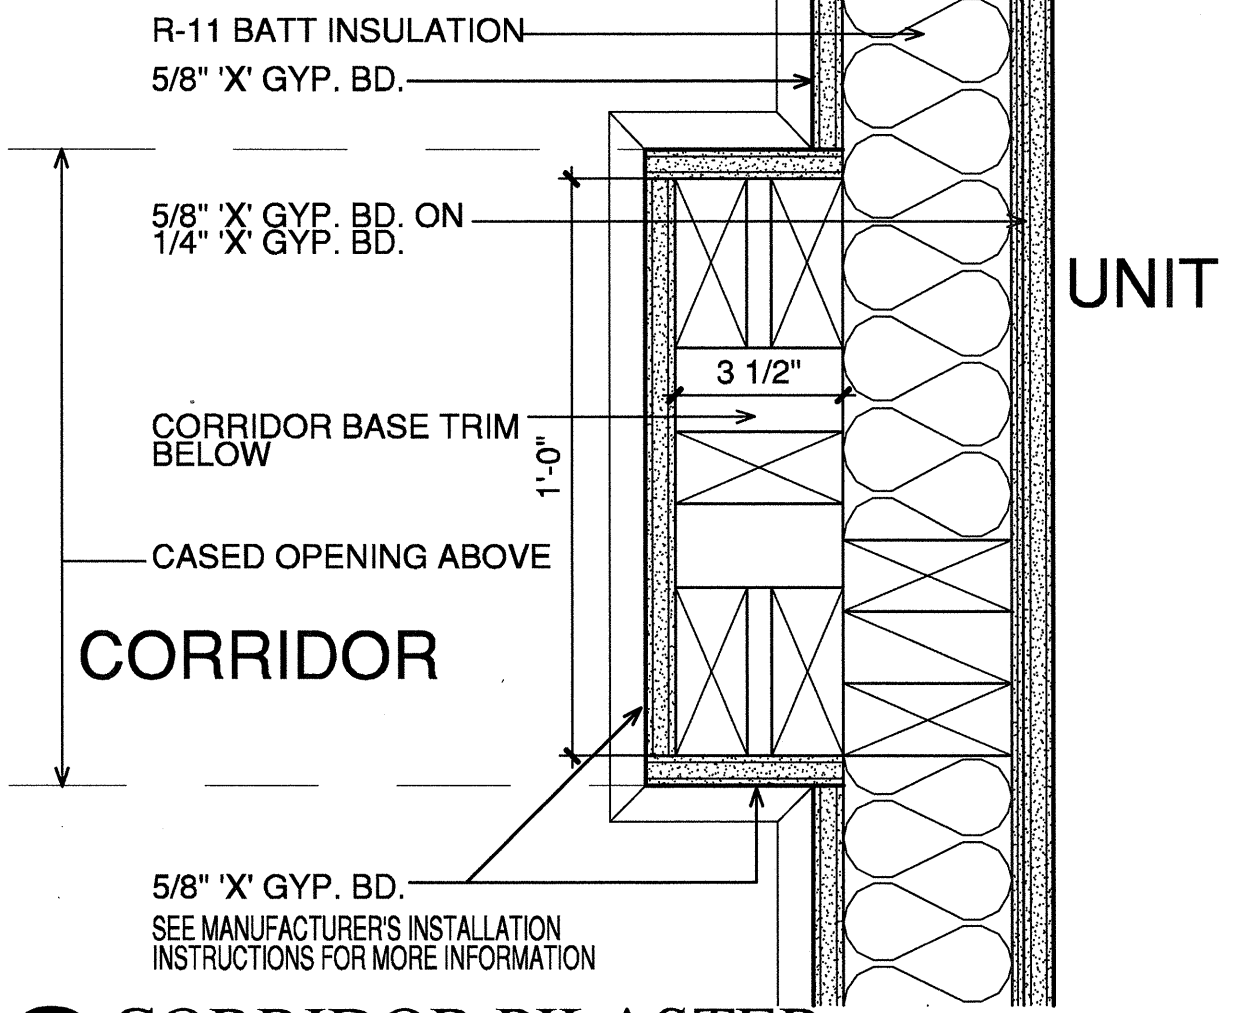


**9 CORRIDOR PILASTER**  
SCALE: 3\"/>

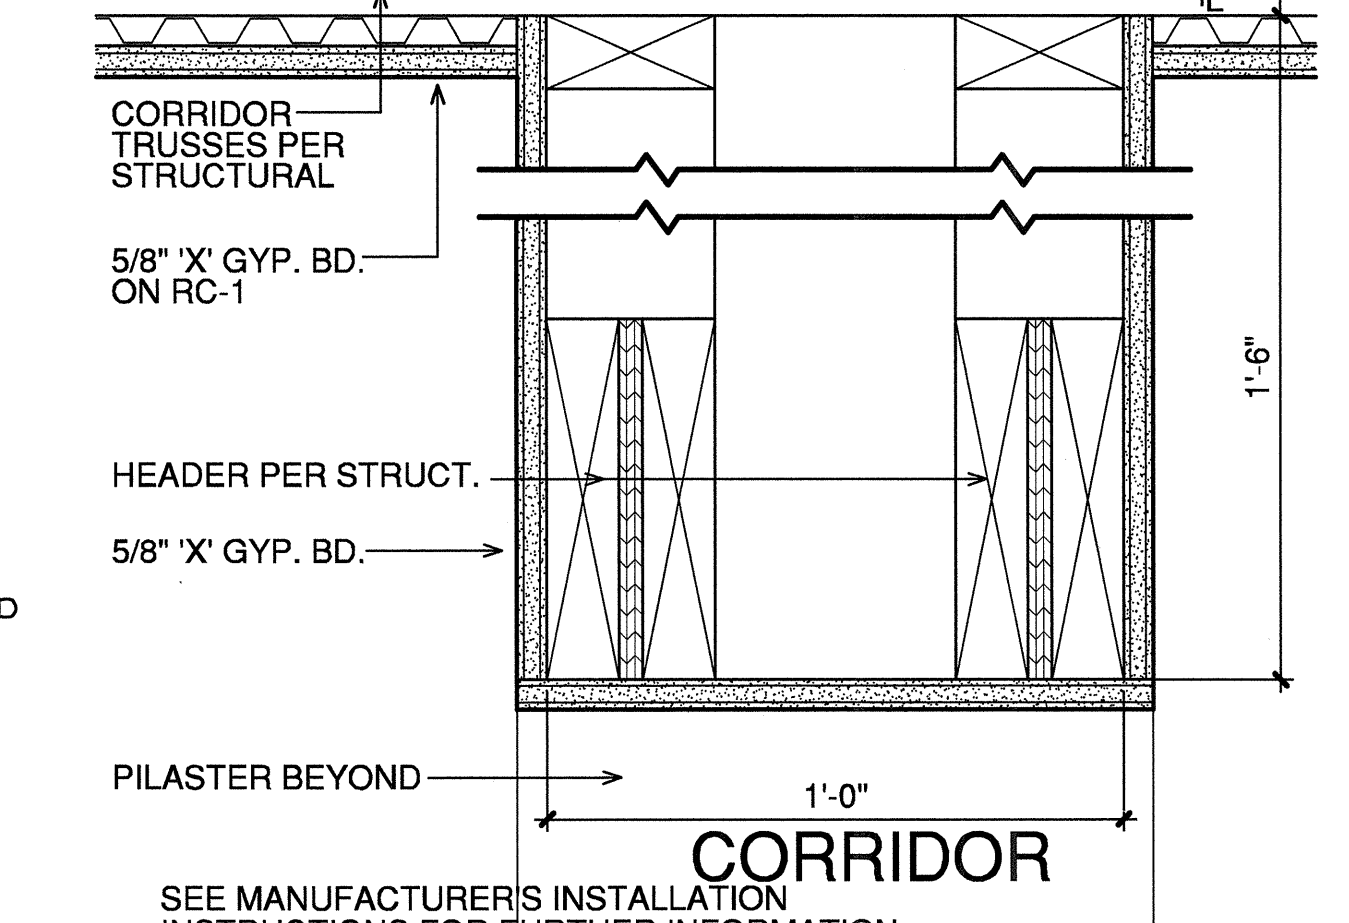


**10 CORRIDOR HEADER @ PILASTER**  
SCALE: 3\"/>

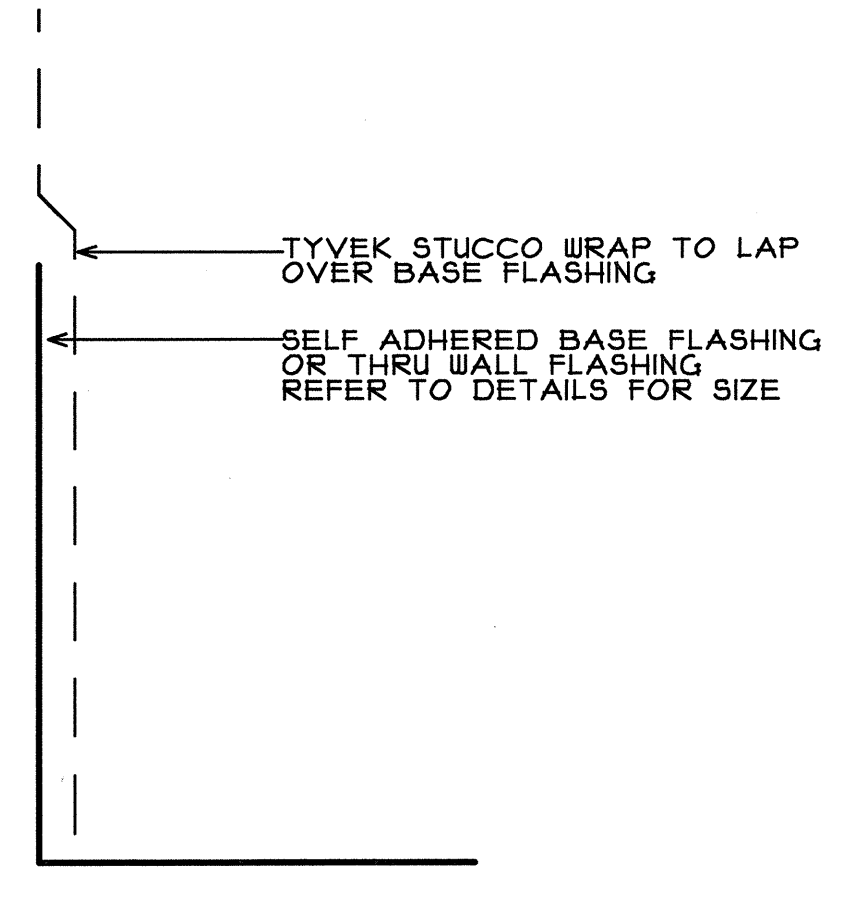


**11 BASE FLASHING**  
SCALE: NTS

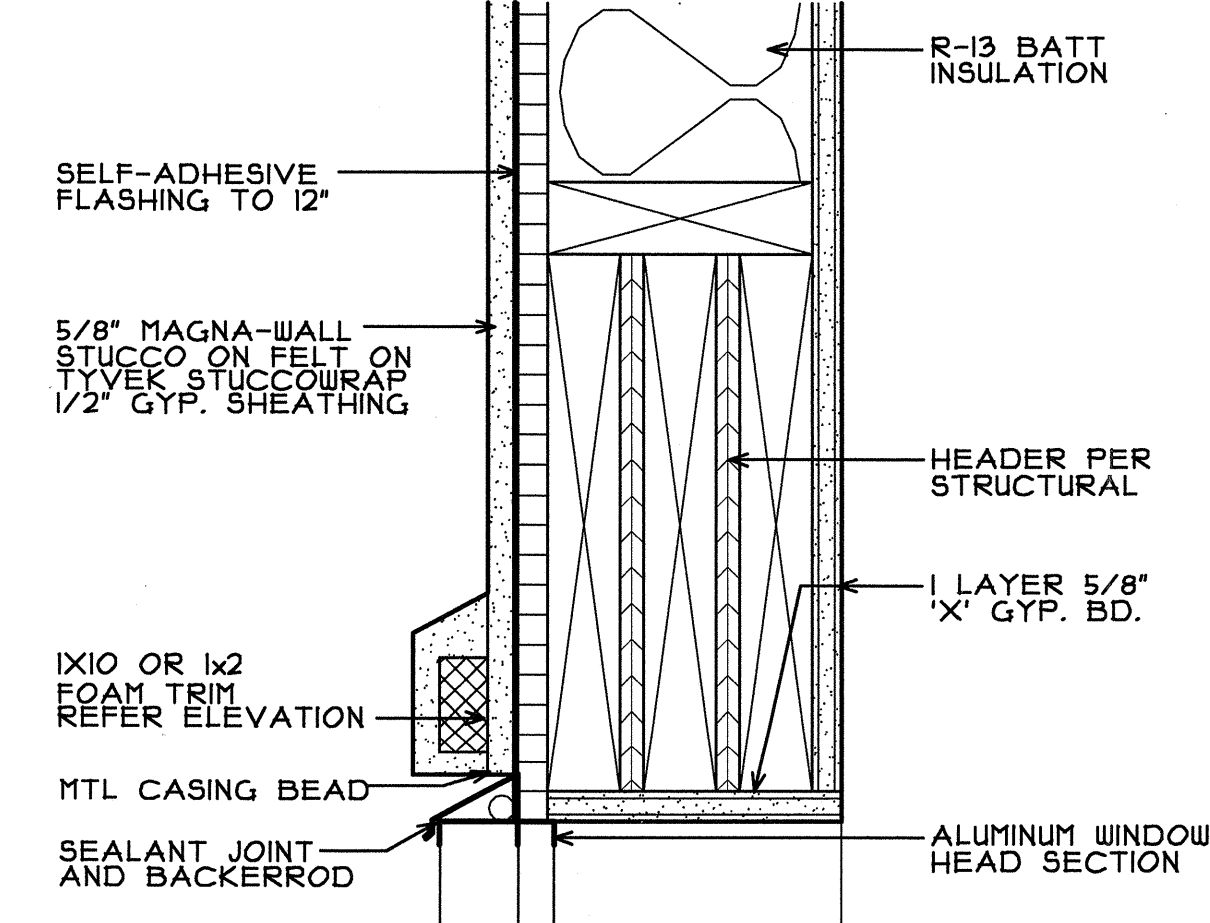


**4 WINDOW HEAD AT STAIR/STUCCO**  
SCALE: 3\"/>

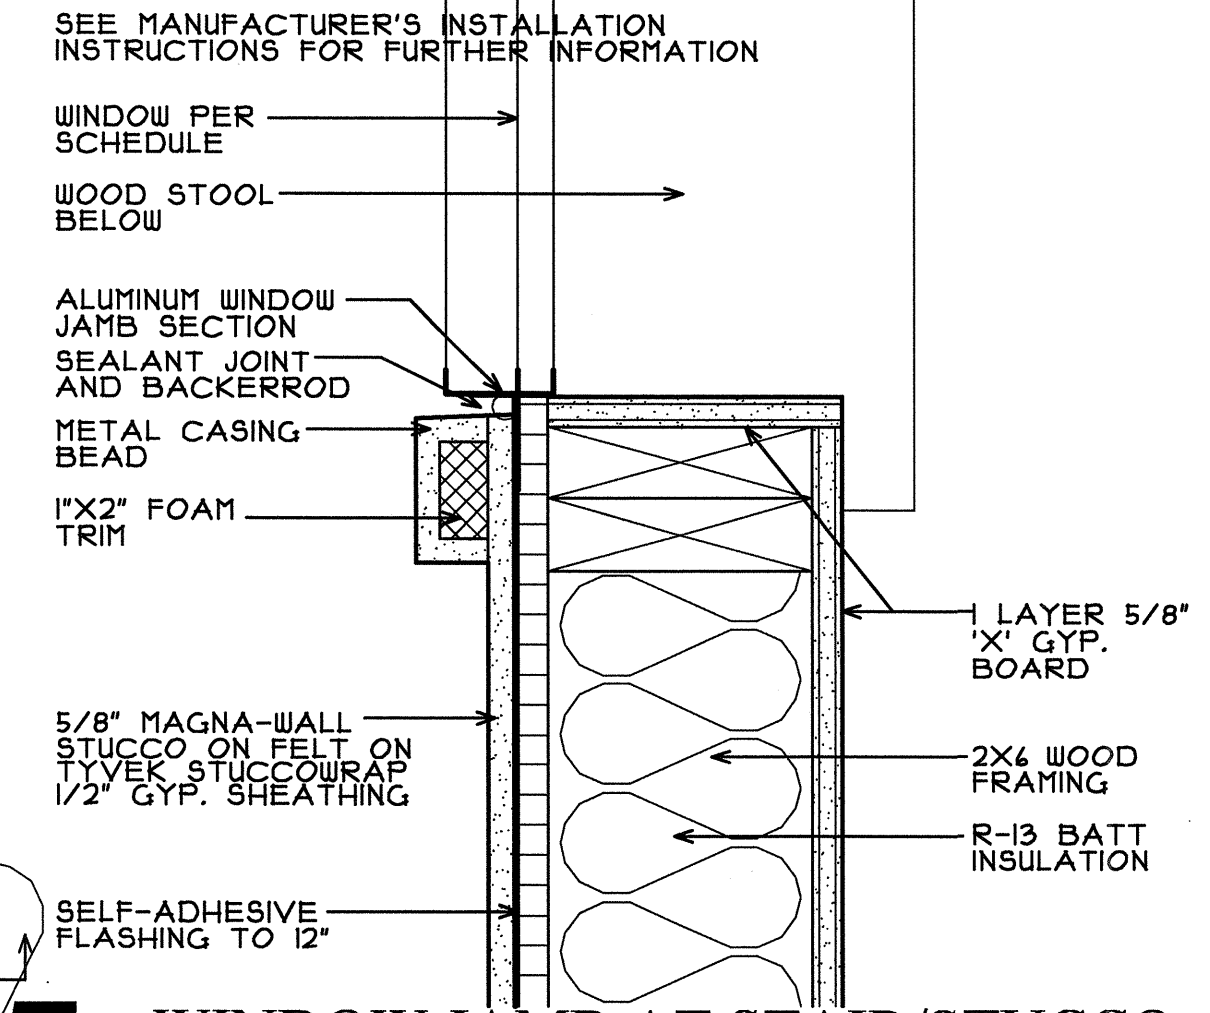


**5 WINDOW JAMB AT STAIR/STUCCO**  
SCALE: 3\"/>

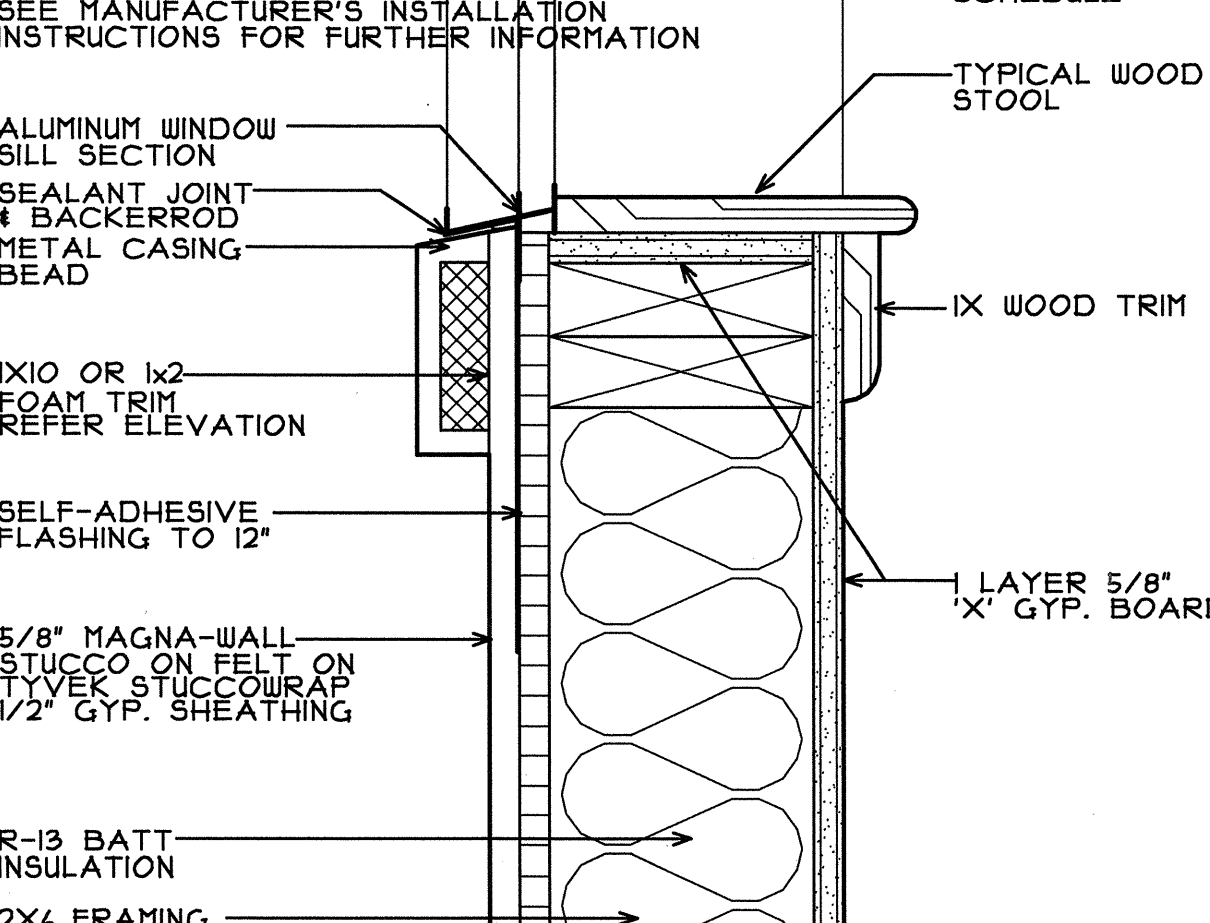


**6 WINDOW SILL AT STAIR/STUCCO**  
SCALE: 3\"/>

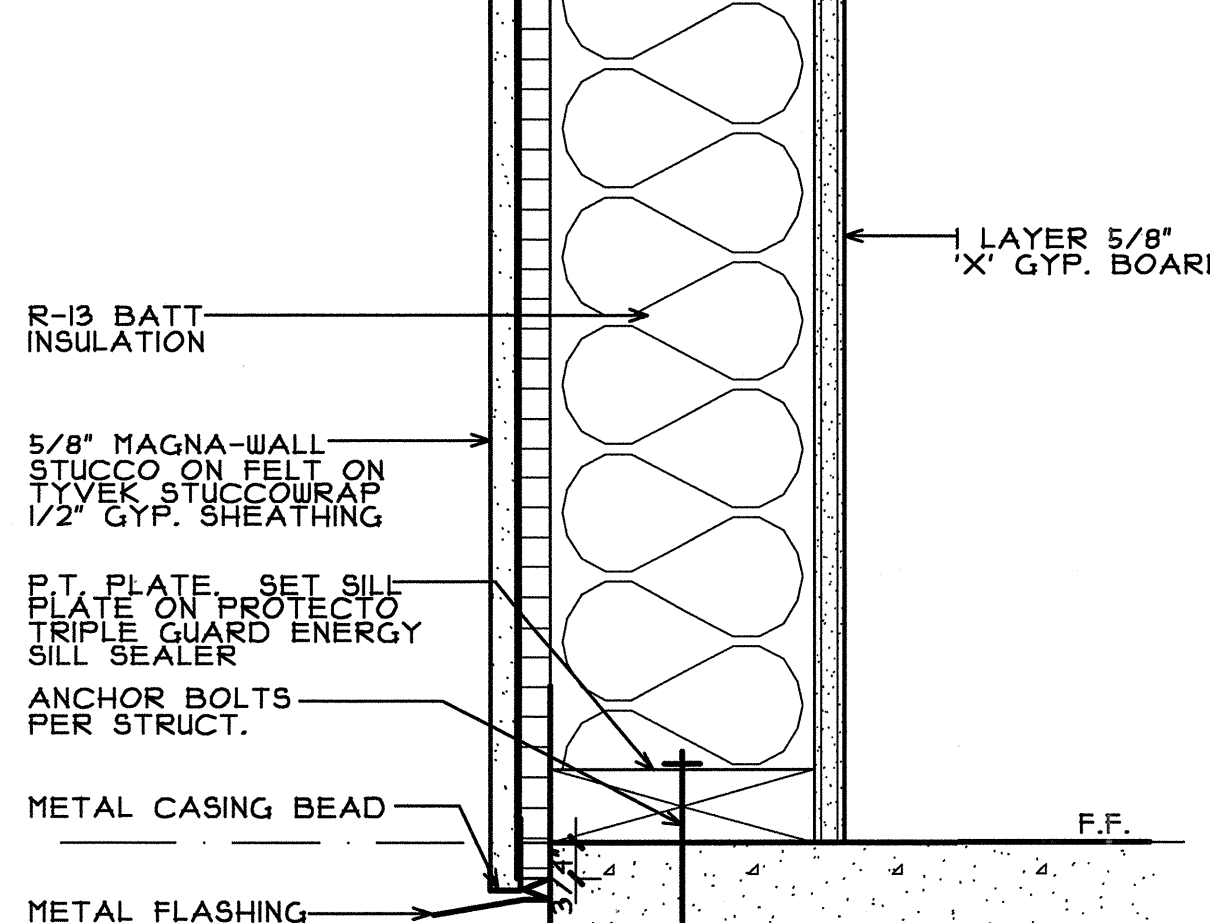

**7 F.F. PLATE AT STAIR/STUCCO**  
SCALE: 3\"/>

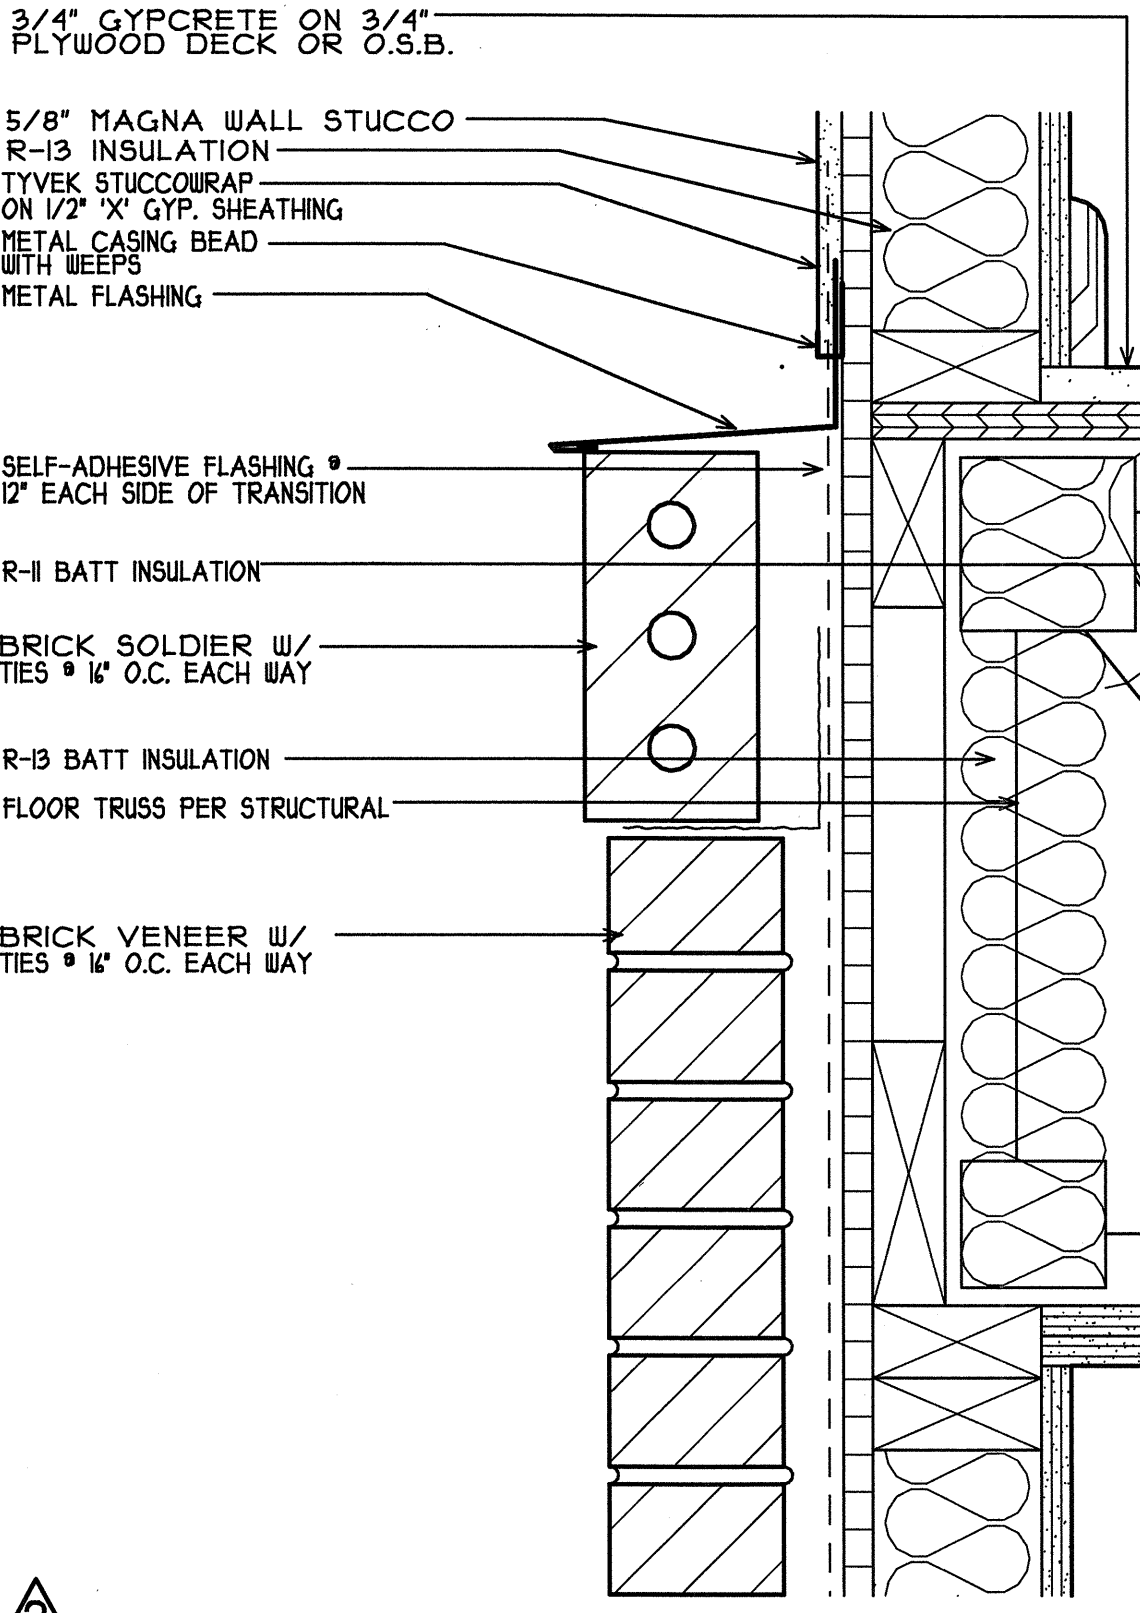

**2 BRICK/STUCCO TRANSITION**  
SCALE: 3\"/>

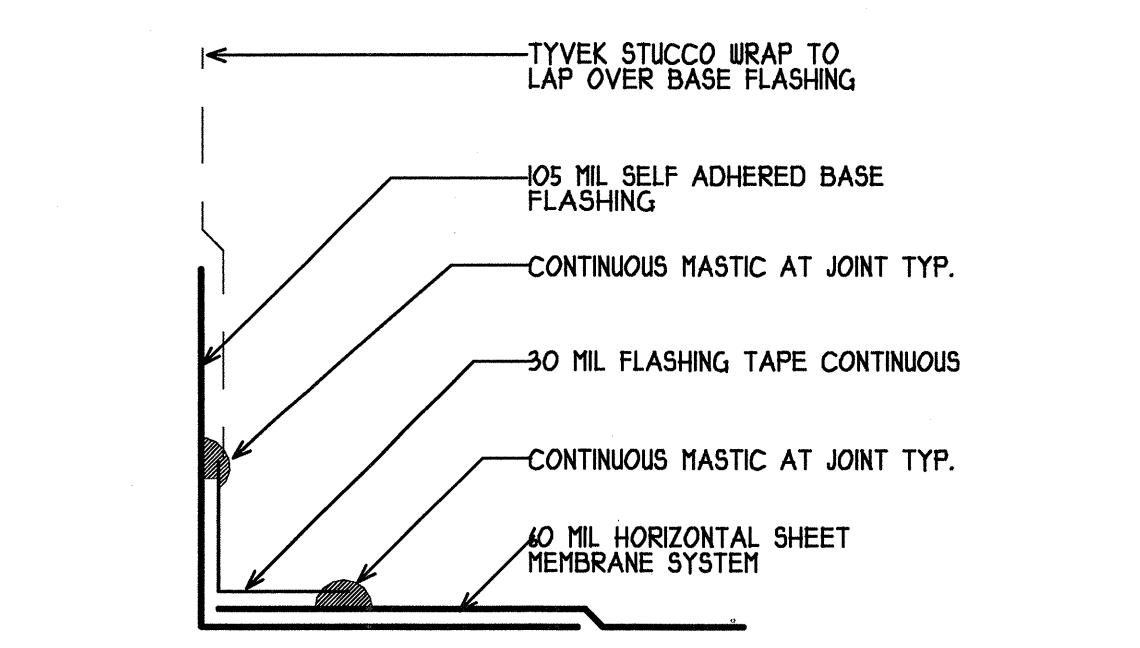

**3 WINDOW/DOOR HEAD FLASHING**  
SCALE: NTS