




1 METAL FIN CONNECTION - MASONRY
6"=1'-0"

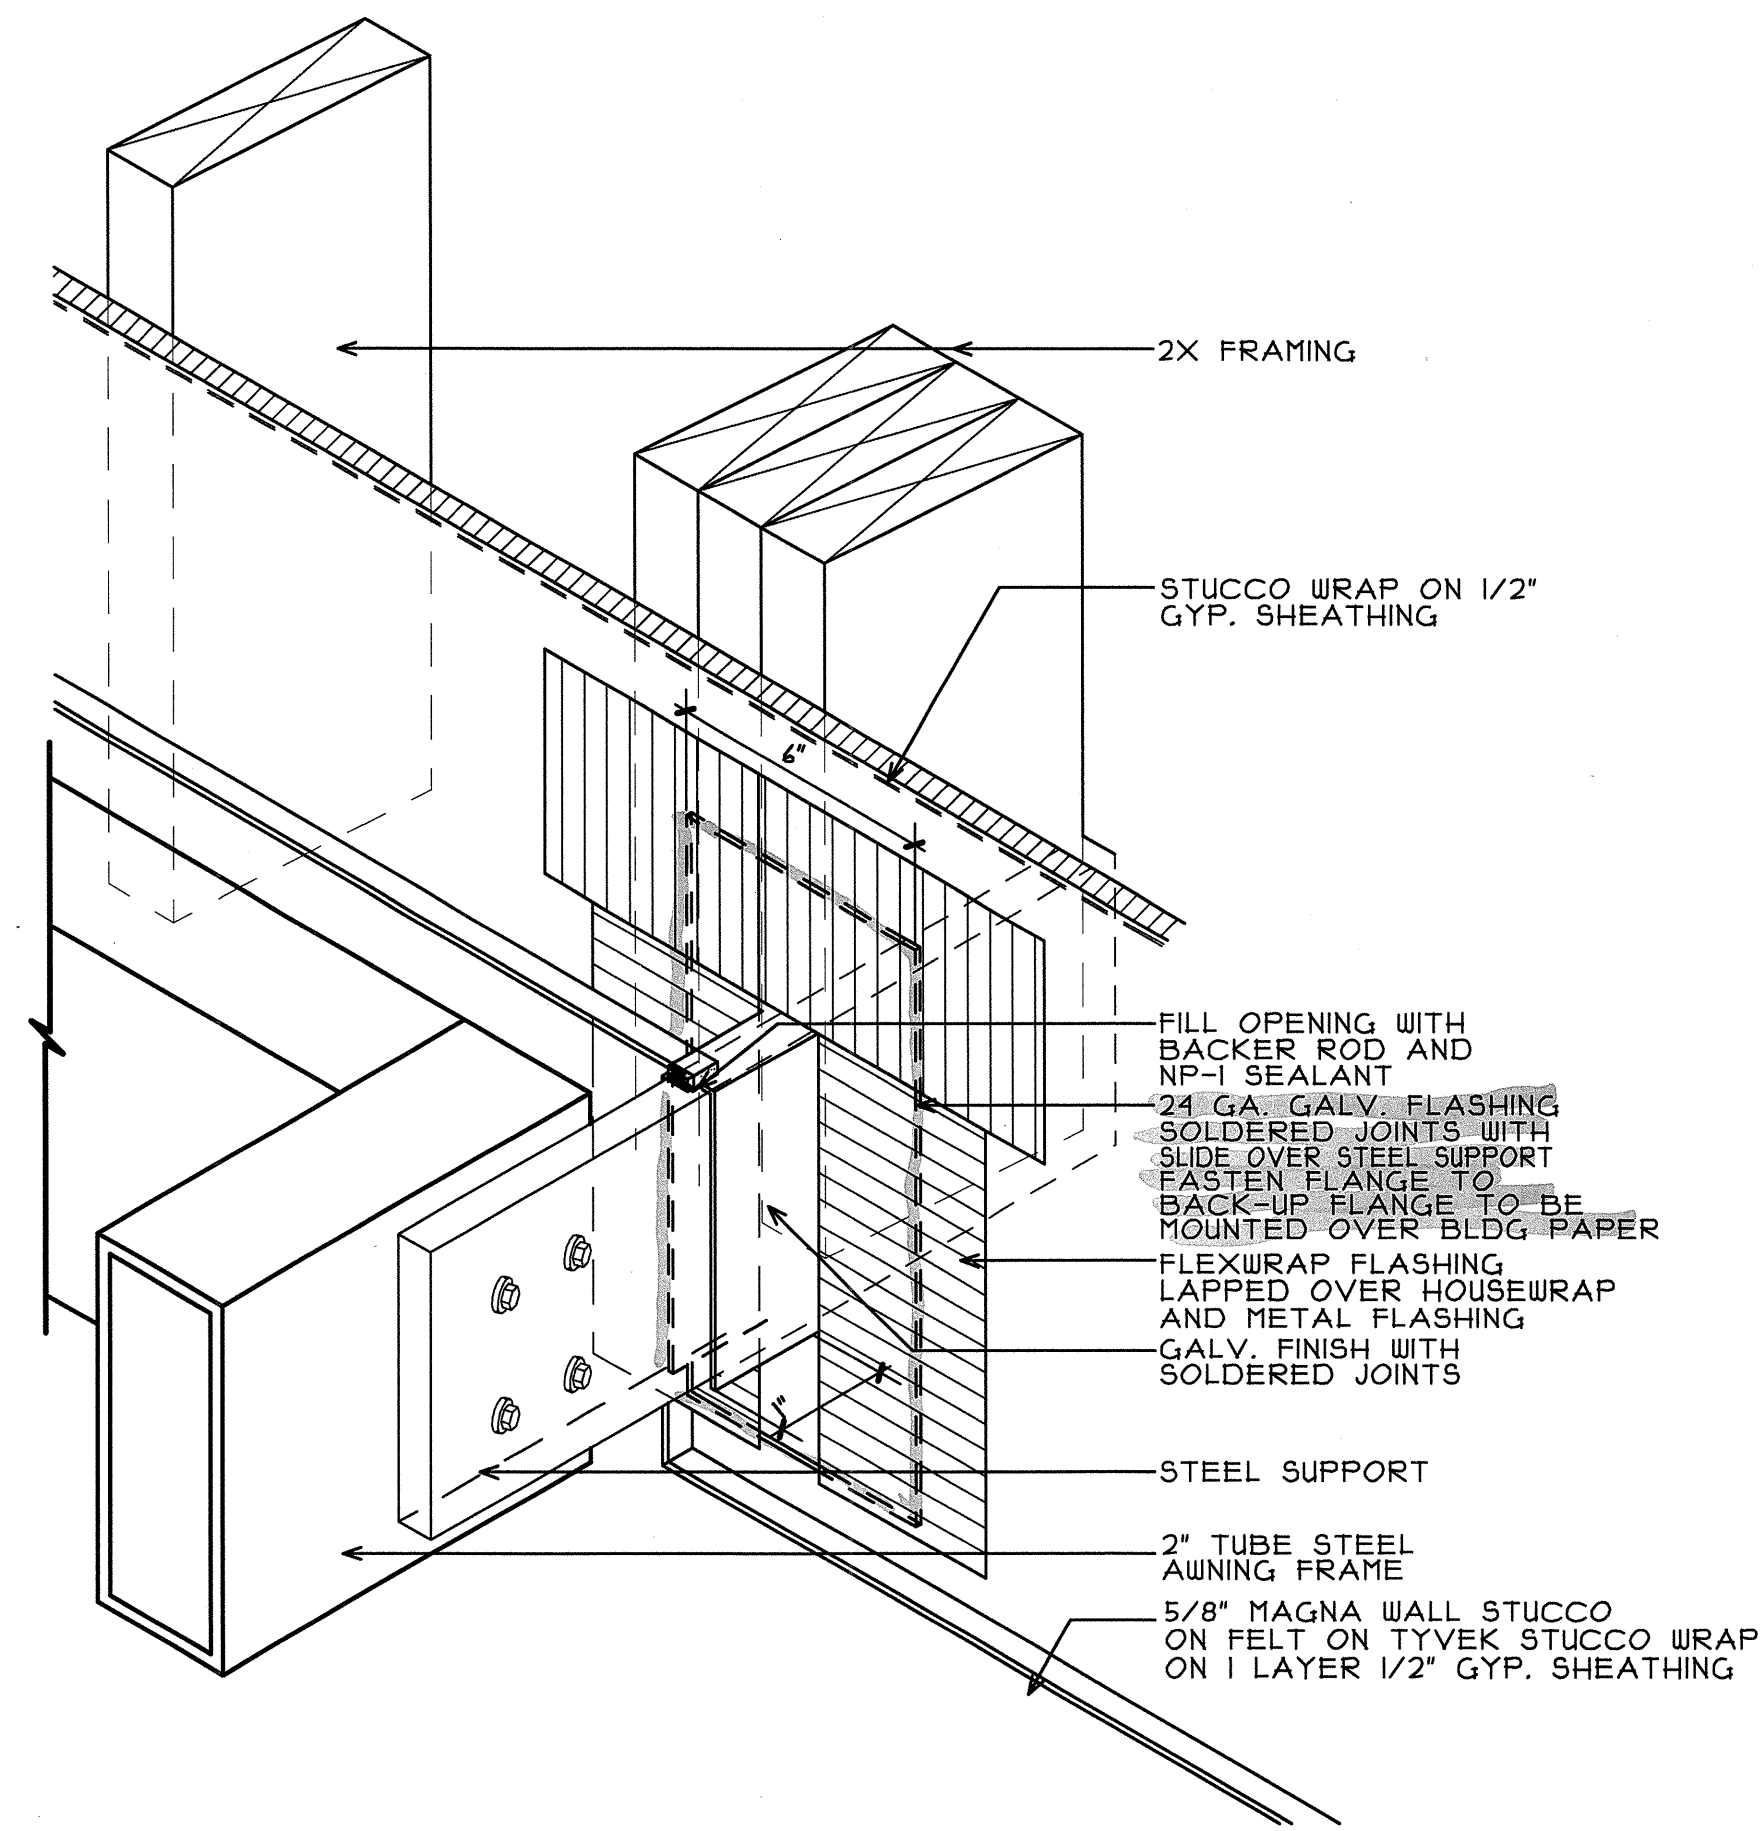

2 METAL FIN CONNECTION - STUCCO
6"=1'-0"

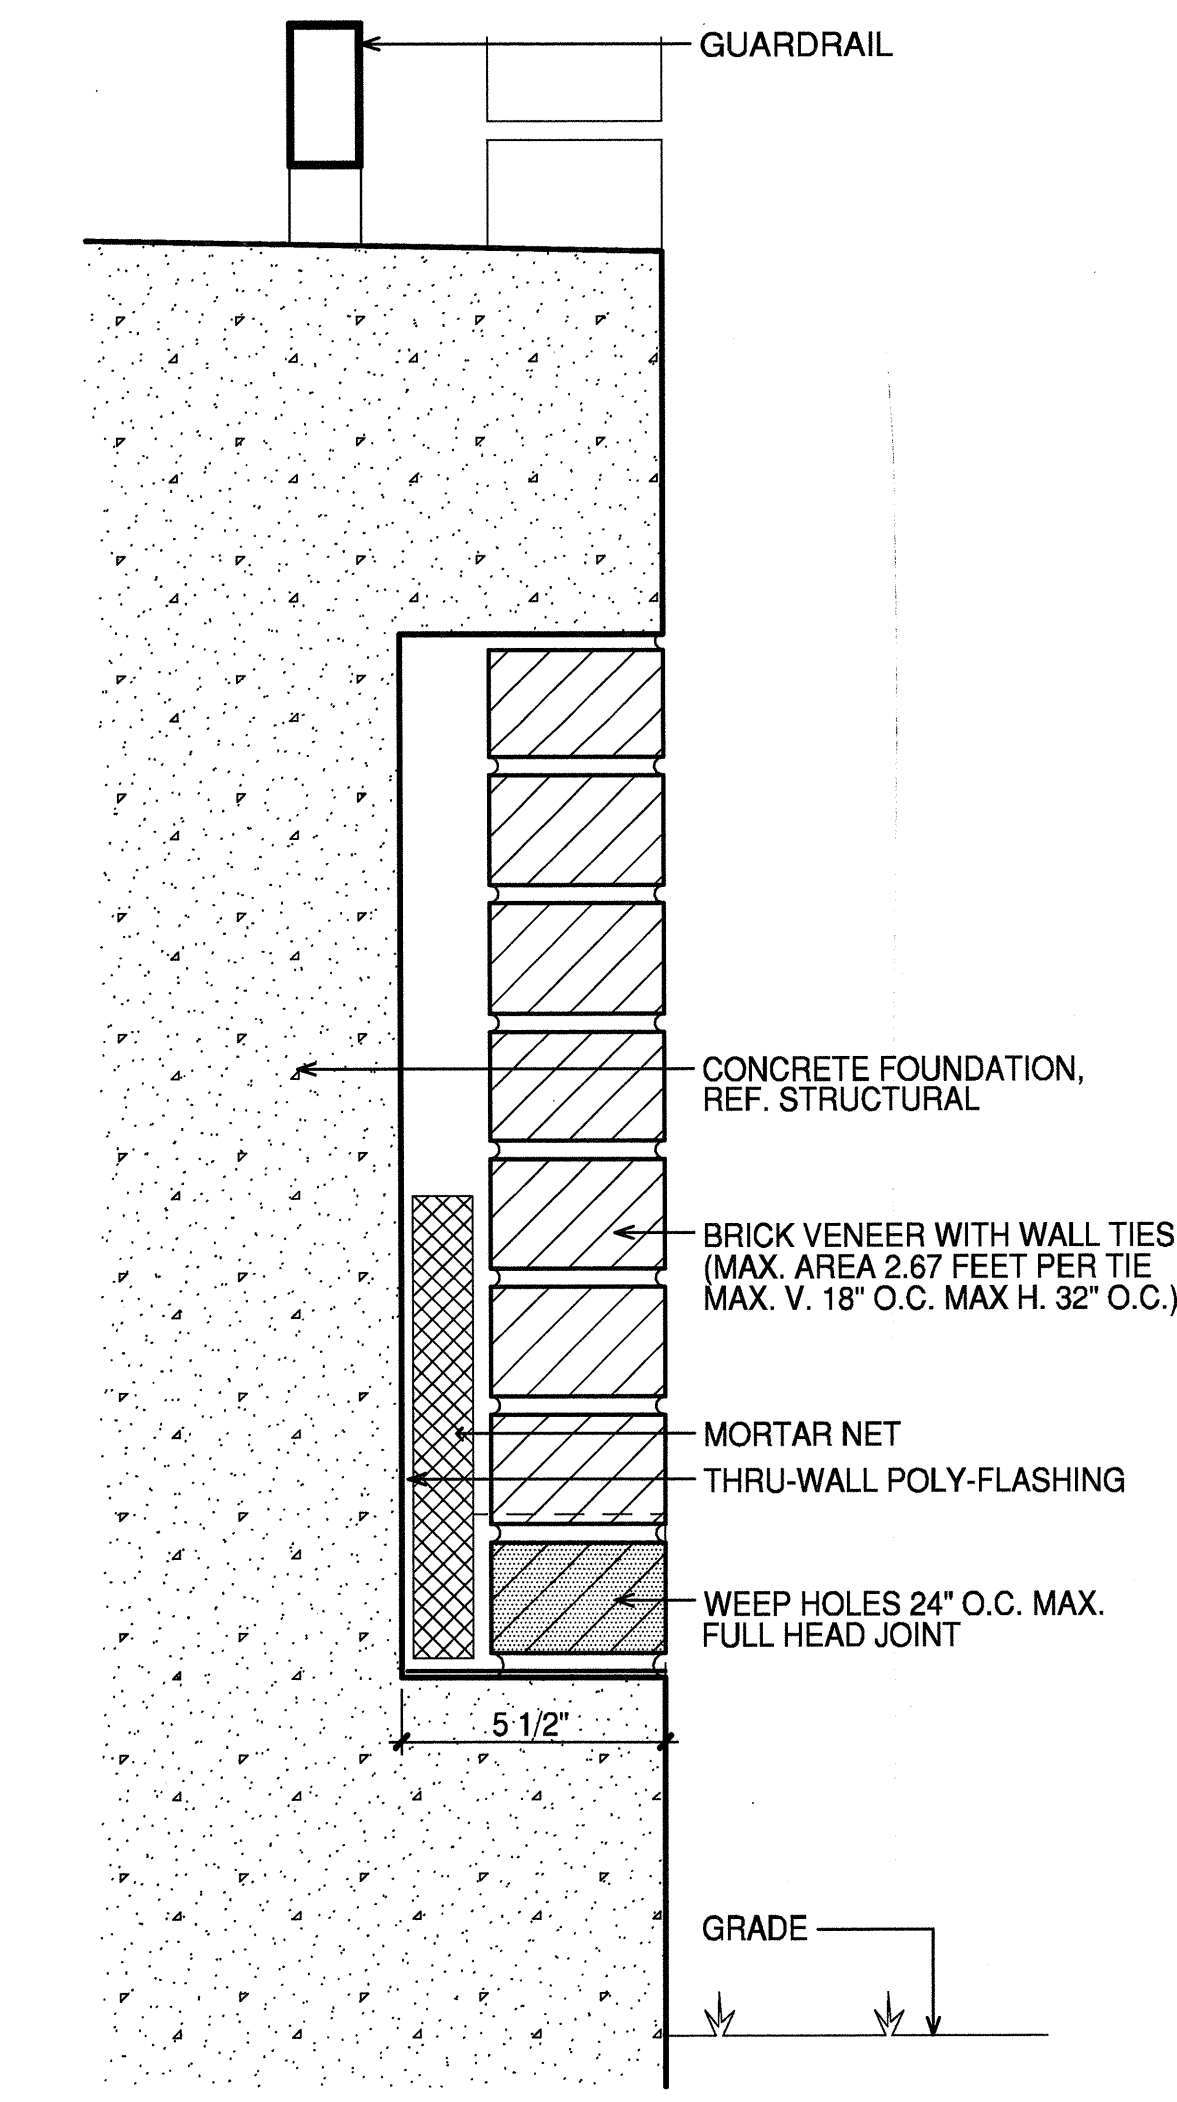

20 BALCONY
SCALE: 3"=1'-0"

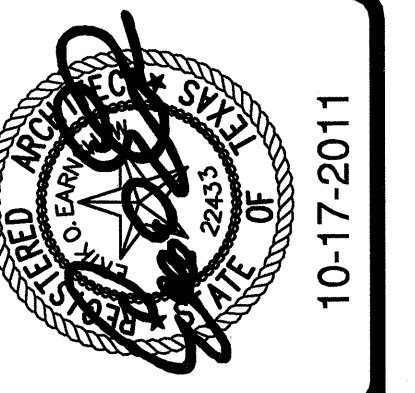

REVISIONS

KELLER SPRINGS LOFTS
LOFT APARTMENTS IN ADDISON, TEXAS

CONSTRUCTION ISSUE
10-17-2011

BGO
architects
4144 N. Central Expy.
Suite 855
Dallas, TX 75204
214.520.8878
bgoarchitects.com

DATE
08-05-2011

PROJECT
11129

SHEET NUMBER

8.9

DETAILS

COPYRIGHT © Beeler, Guest, Owens Architects ALL RIGHTS RESERVED