



REVISIONS

OWNER ANS/FHA COMMENTS	09-13-2011
COORDINATION	10-17-2011
OWNER ID REVISIONS	02-13-2012

# KELLER SPRINGS LOFTS

LOFT APARTMENTS IN ADDISON, TEXAS

CONSTRUCTION ISSUE  
10-17-2011

**BGO** architects  
4144 N. Central Exp.  
Suite 855  
Dallas, TX 75204  
214.520.8878  
bgoarchitects.com

DATE  
08-05-2011


PROJECT  
11129

SHEET NUMBER

**9.1**

**CLUB PLAN**

NOTE:  
ALL STEEL BEAMS AND COLUMNS TO BE 1-HR RATED/PROTECTED BY FIRE PROOFING SPRAY/INTERSEMENT PAINT WITHIN THE WALL AND FLOOR ASSEMBLIES

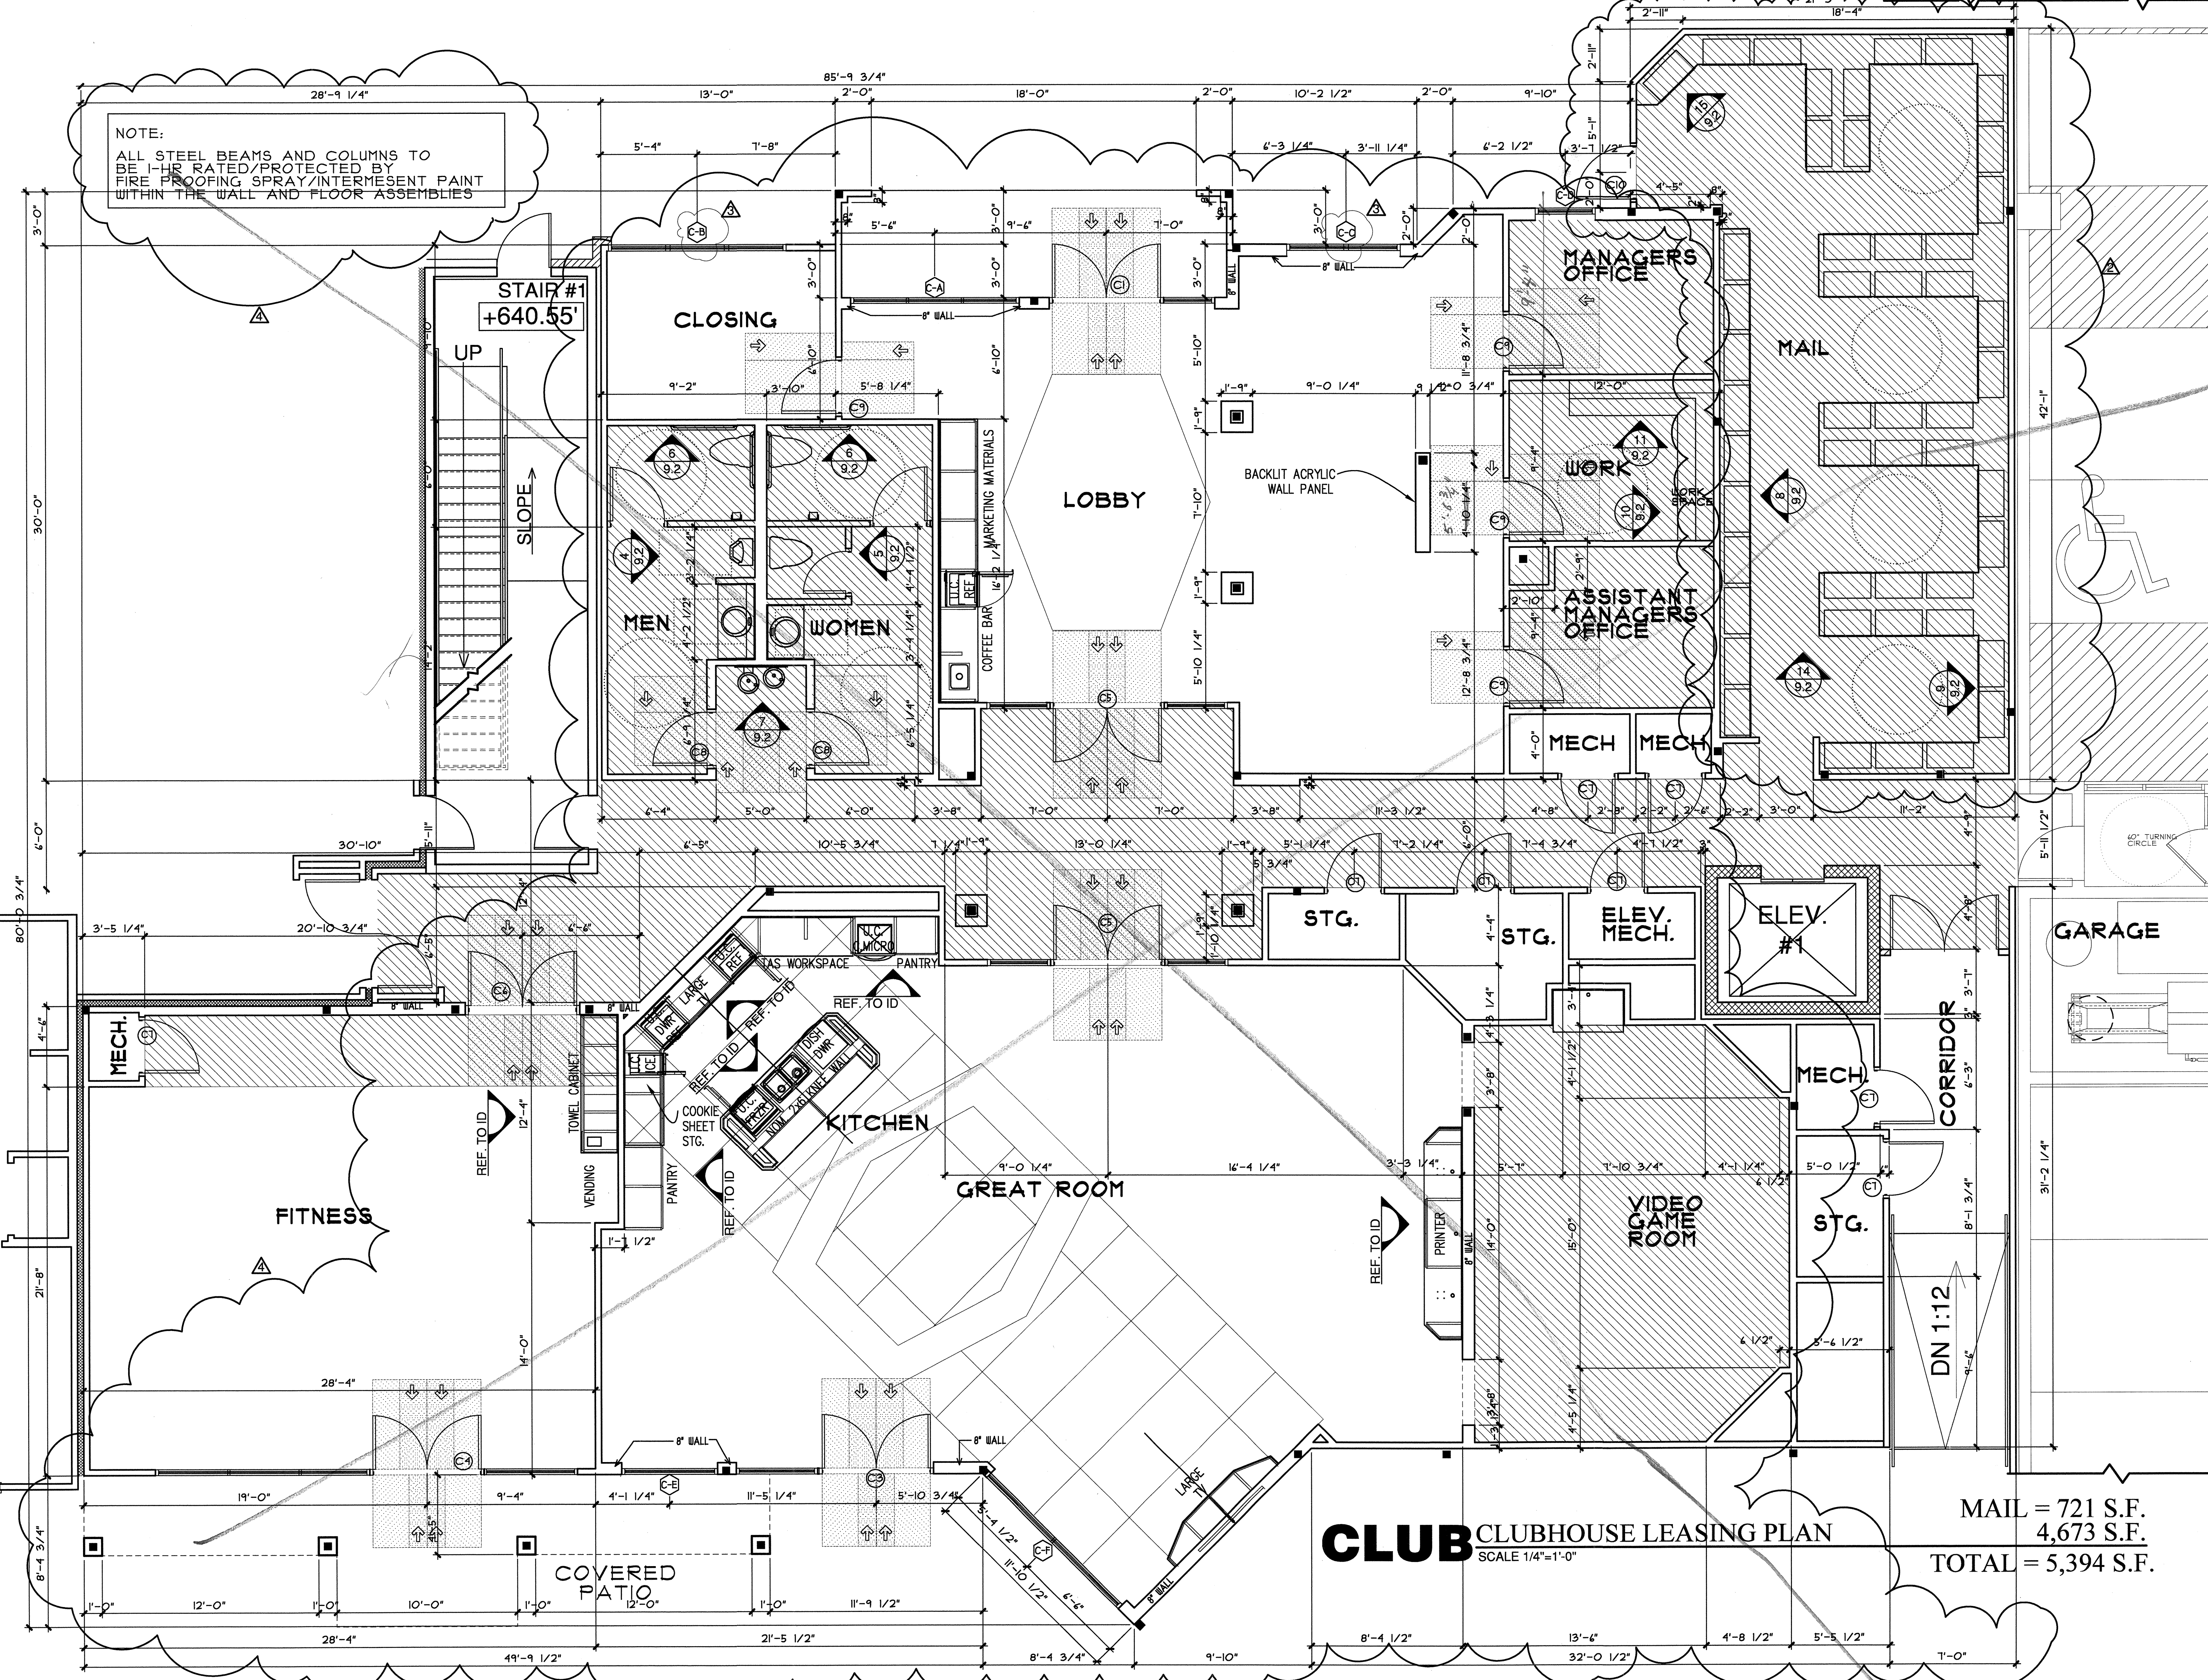

## CLUB CLUBHOUSE LEASING PLAN

SCALE 1/4"=1'-0"

MAIL = 721 S.F.  
4,673 S.F.  
TOTAL = 5,394 S.F.

COPYRIGHT © Beeler, Guest Owners Architects, ALL RIGHTS RESERVED.