

REVISIONS	
OWNER	ANSI/FHA COMMENTS 09-13-2011
COORDINATION	10-17-2011
OWNER	ID REVISIONS 02-13-2012
COORDINATION	02-29-2012

# KELLER SPRINGS LOFTS

LOFT APARTMENTS IN ADDISON, TEXAS

CONSTRUCTION ISSUE  
10-17-2011



4144 N. Central Expy.  
Suite 855  
Dallas, TX 75204  
214.520.8878  
bgoarchitects.com

DATE  
08-05-2011


PROJECT  
11129

SHEET NUMBER

**9.1**

**CLUB PLAN**

NOTE:  
ALL STEEL BEAMS AND COLUMNS TO BE 1-HR RATED/PROTECTED BY FIRE PROOFING SPRAY/INTERSEMENT PAINT WITHIN THE WALL AND FLOOR ASSEMBLIES

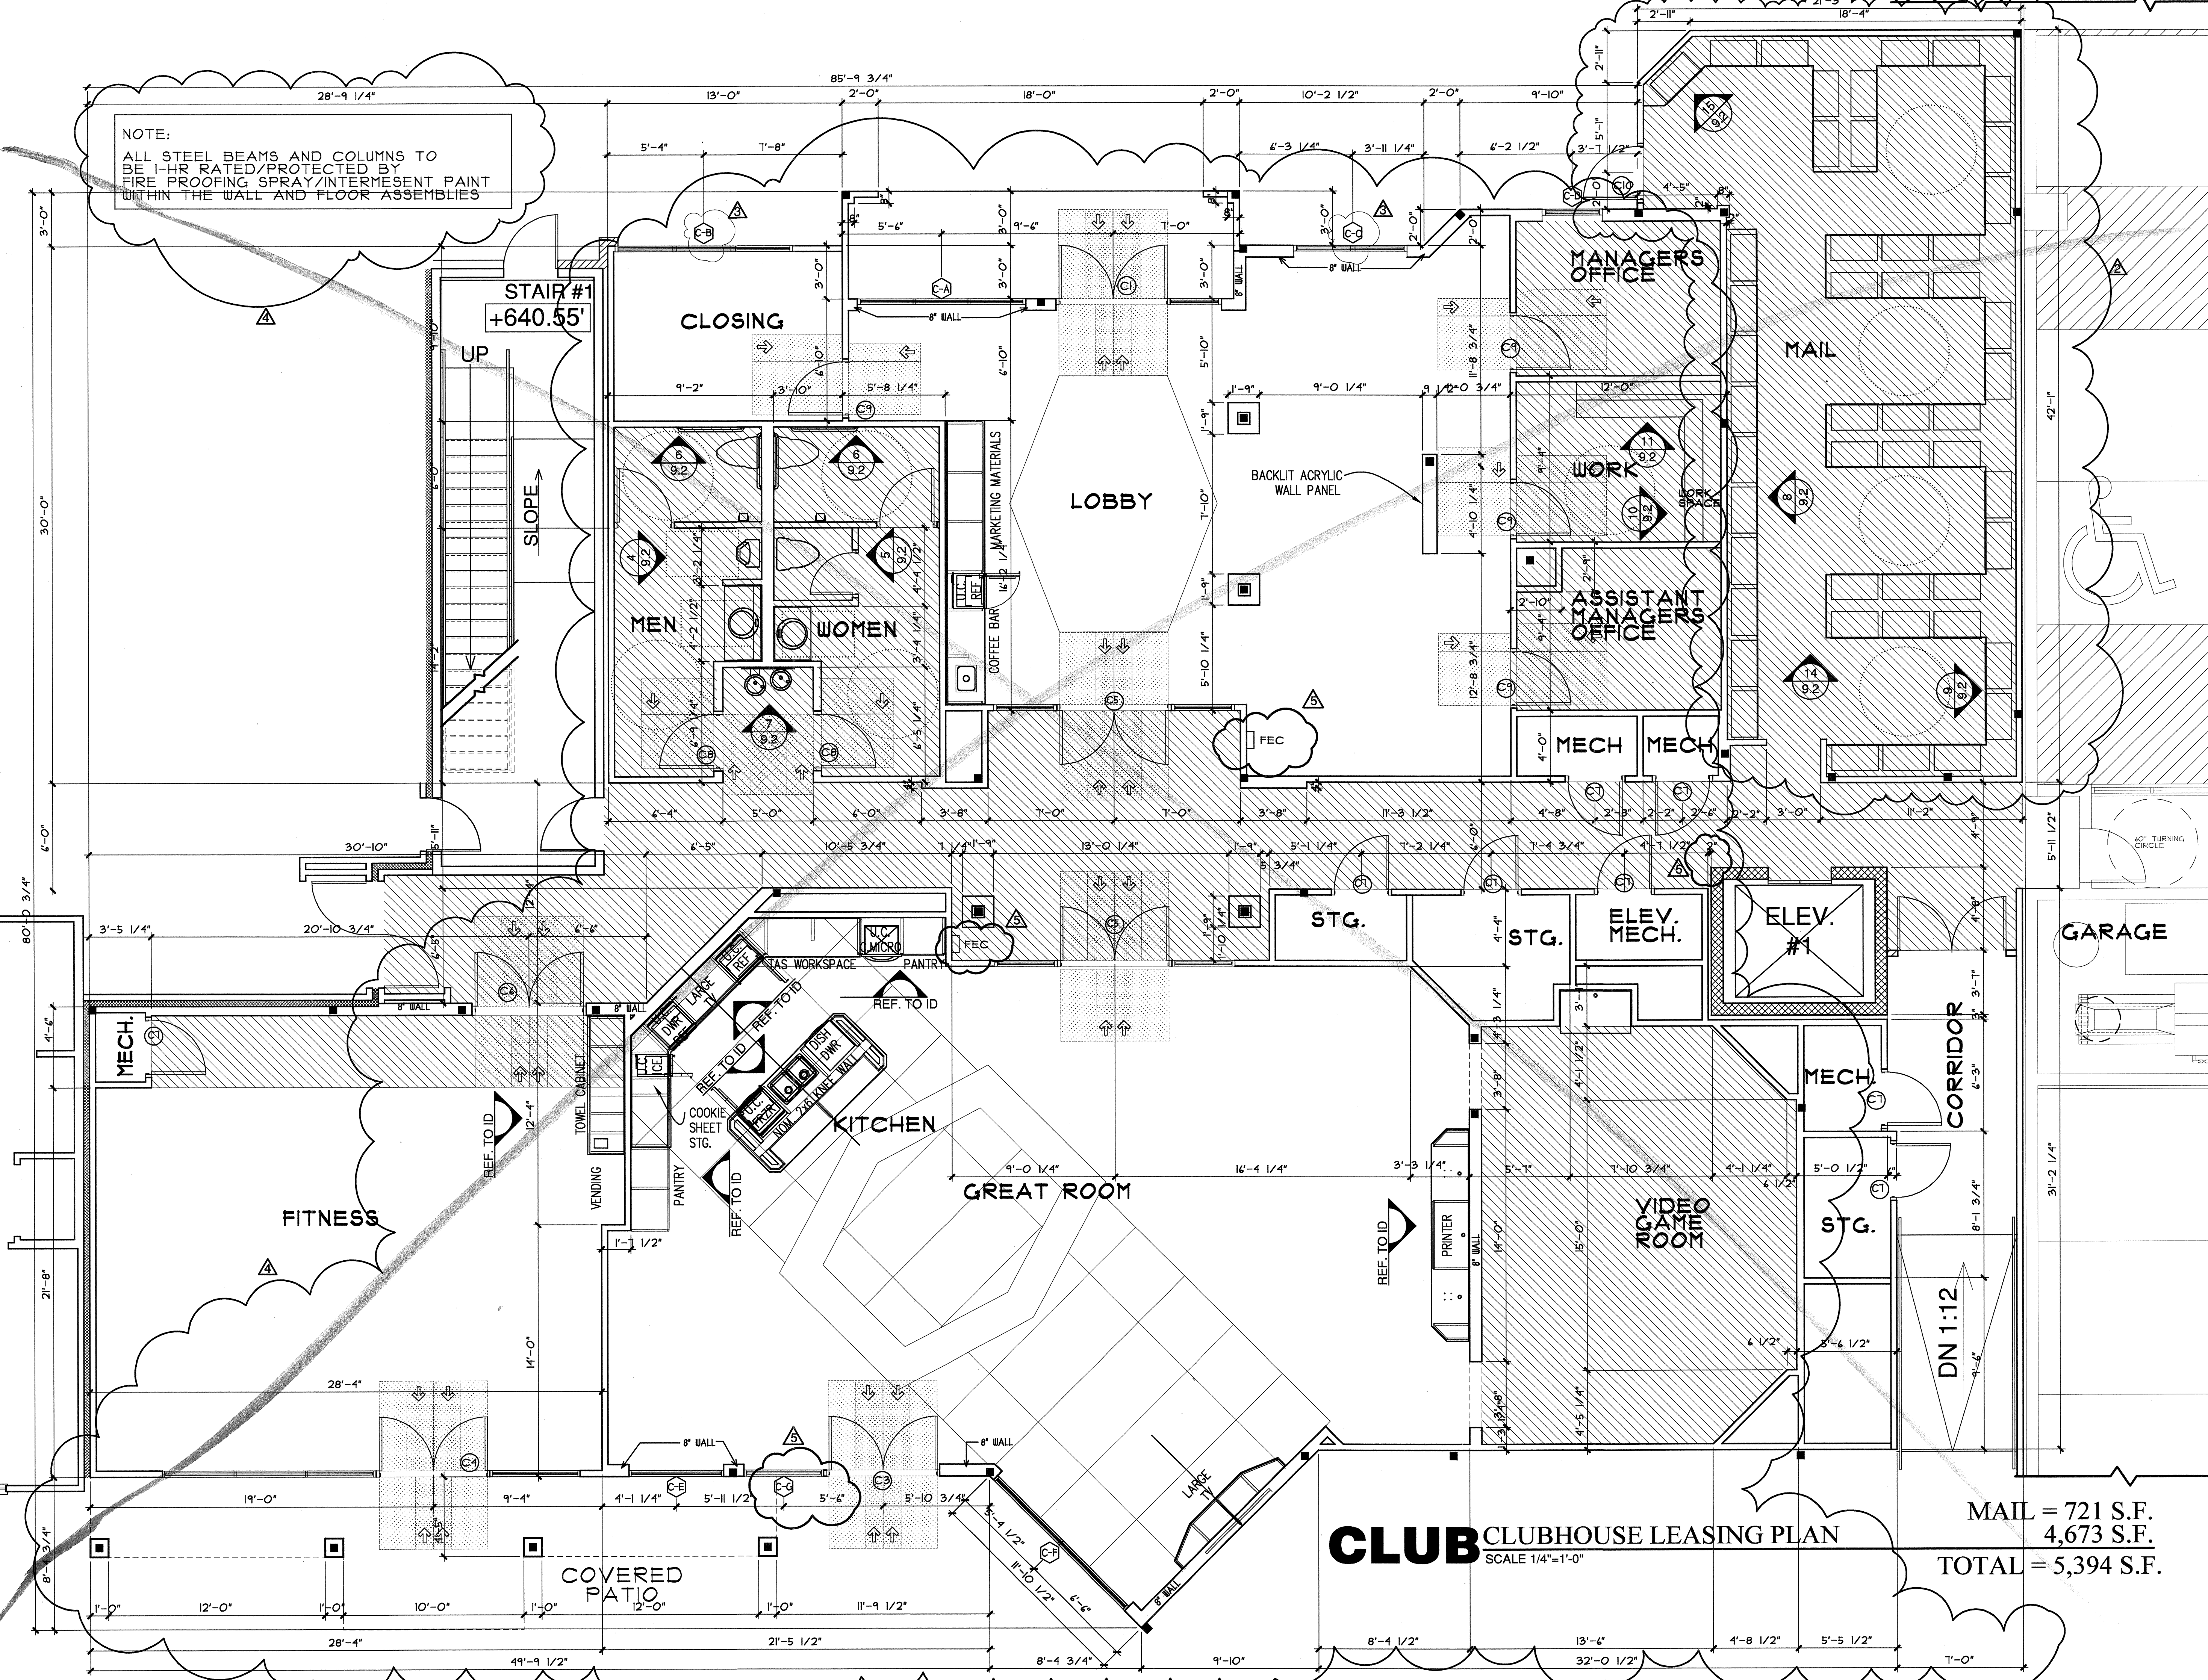

## CLUB CLUBHOUSE LEASING PLAN

SCALE 1/4"=1'-0"

MAIL = 721 S.F.  
4,673 S.F.  
TOTAL = 5,394 S.F.

COPYRIGHT © Beeler, Guest, Owens Architects, ALL RIGHTS RESERVED.