



10-17-2011

REVISIONS

**KELLER SPRINGS LOFTS**

LOFT APARTMENTS IN ADDISON, TEXAS

CONSTRUCTION ISSUE  
10-17-2011



4144 N. Central Expy.  
Suite 035  
Dallas, TX 75204  
214.520.8878  
bgoarchitects.com

DATE  
08-05-2011


PROJECT  
11129

SHEET NUMBER

**9.1**

**CLUB PLAN**

NOTE:  
ALL STEEL BEAMS AND COLUMNS TO  
BE 1-HR RATED/PROTECTED BY  
FIRE PROOFING SPRAY WITHIN  
THE WALL AND FLOOR ASSEMBLIES

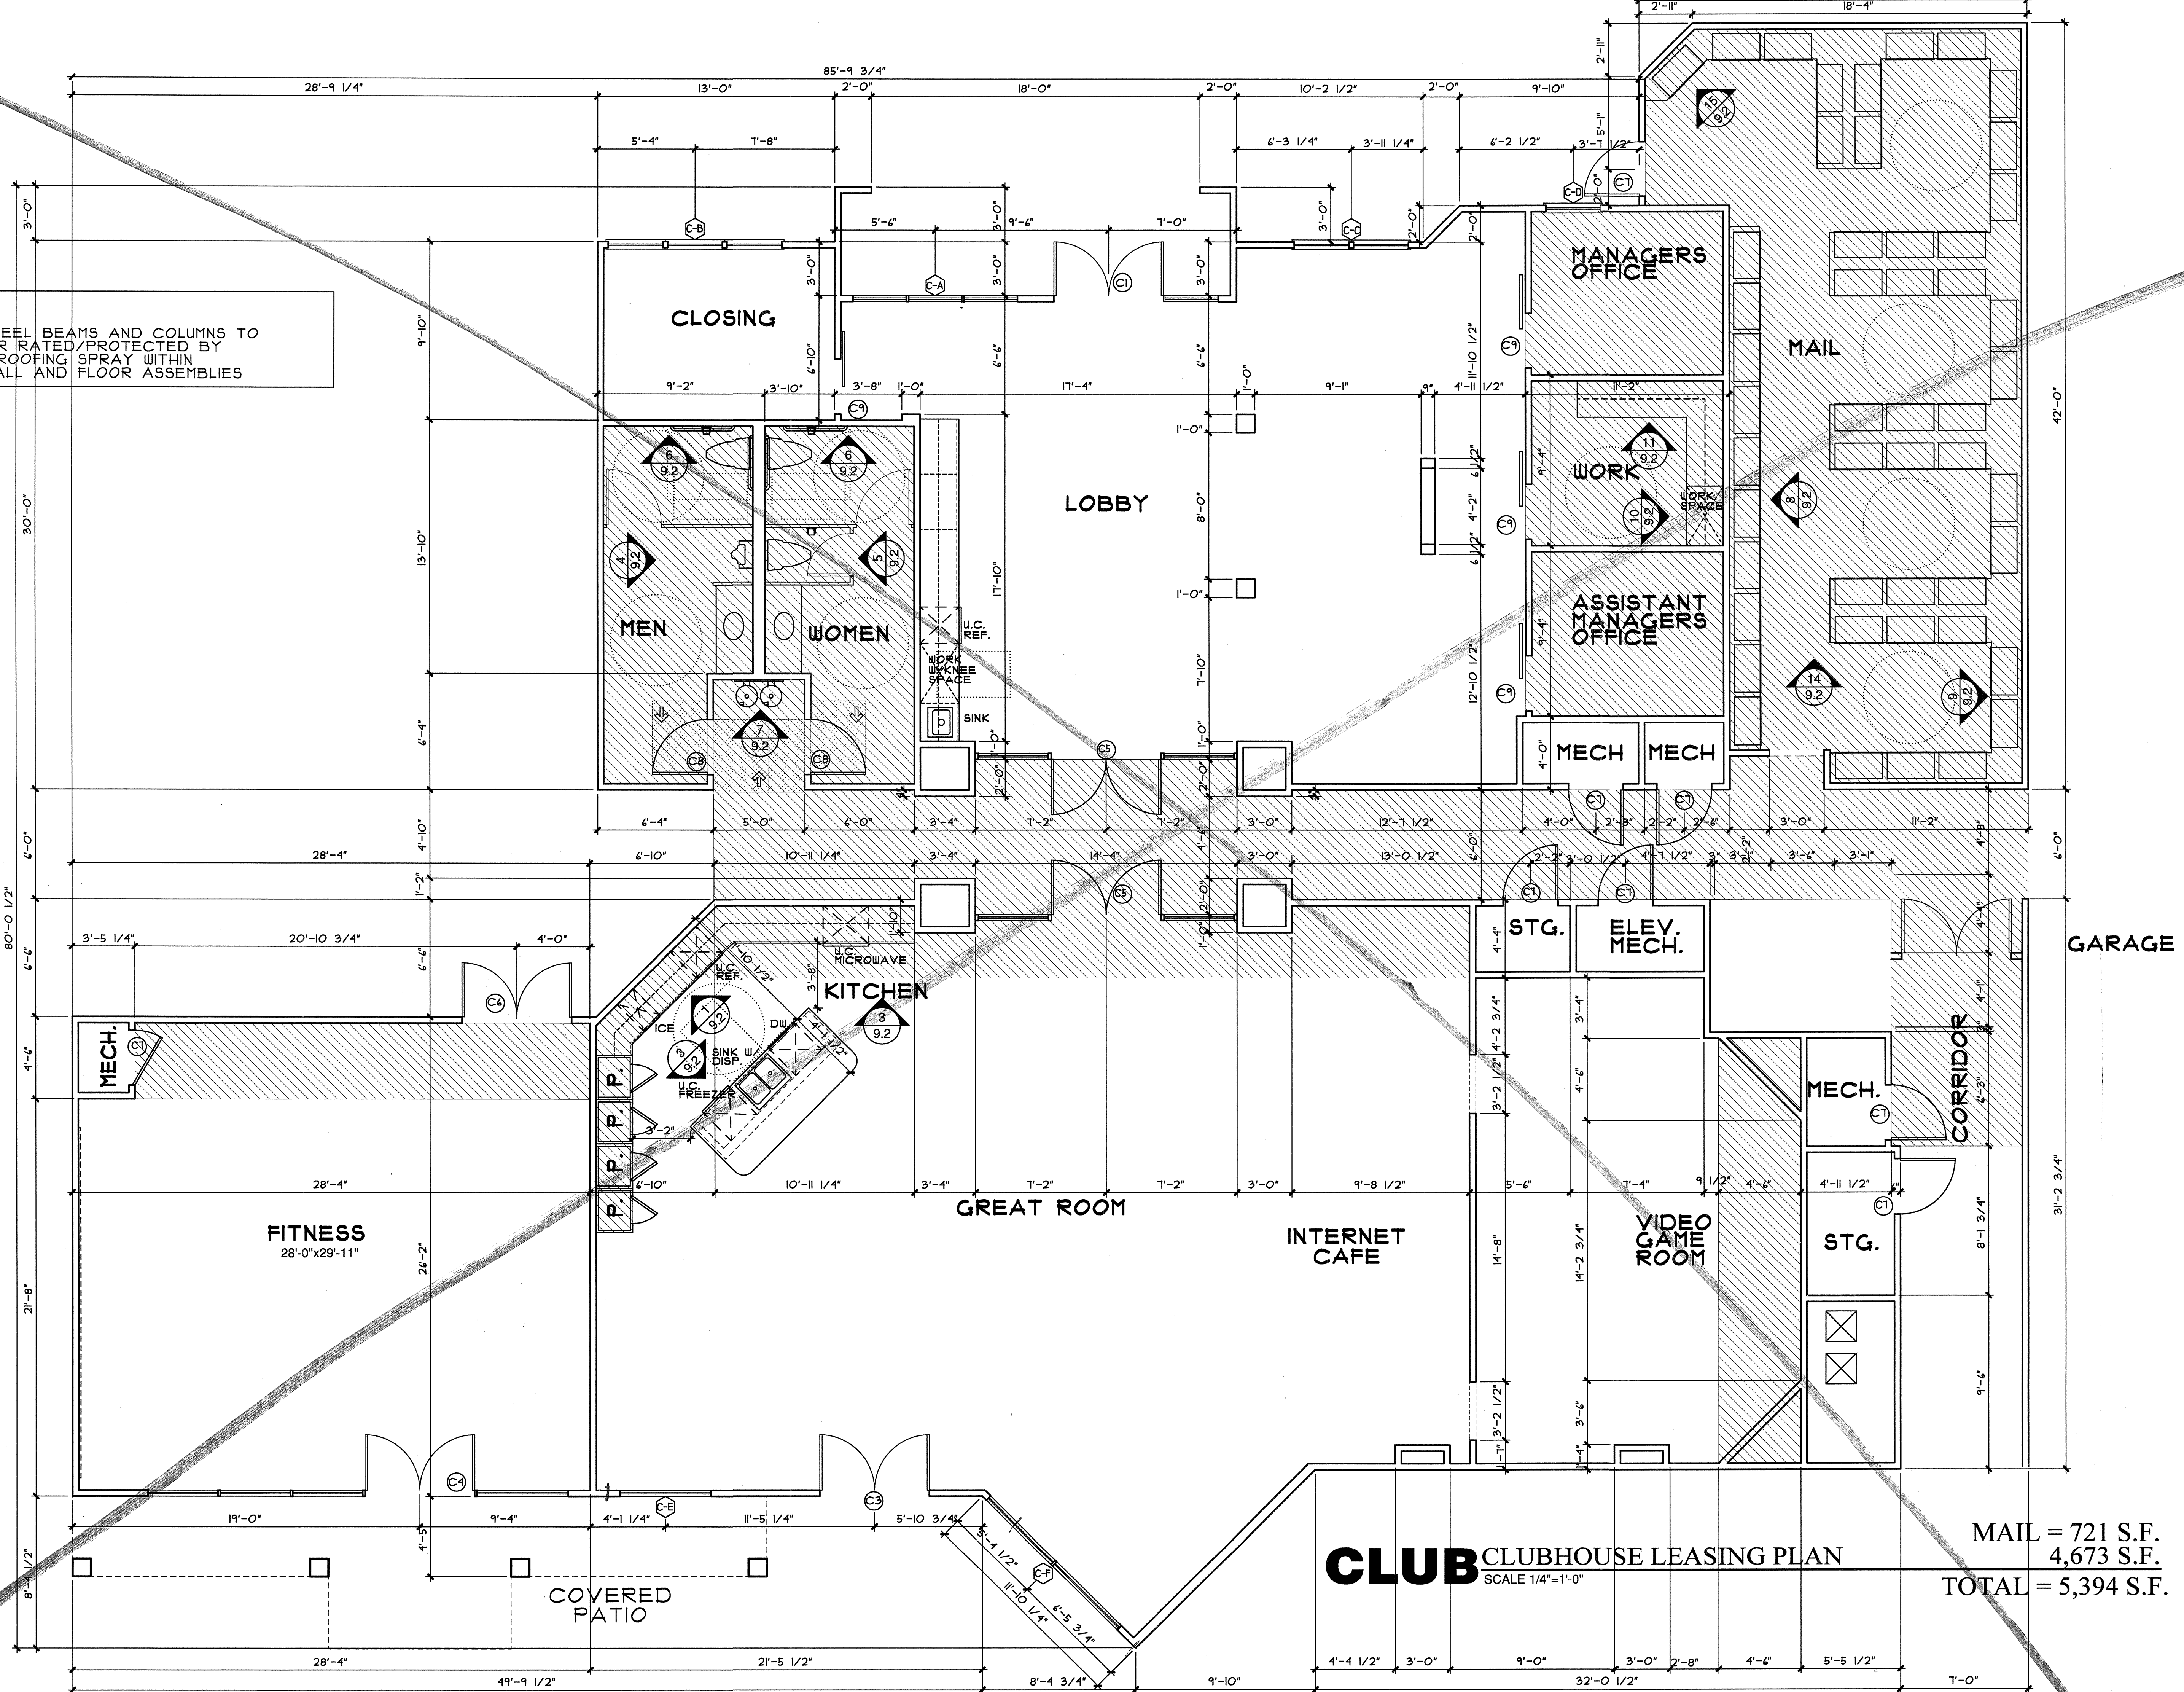

**CLUB** CLUBHOUSE LEASING PLAN  
SCALE 1/4"=1'-0"

MAIL = 721 S.F.  
4,673 S.F.  
TOTAL = 5,394 S.F.

COPYRIGHT © Beeler Guest Owners Architects ALL RIGHTS RESERVED