



10-17-2011

REVISIONS

OWNER ANSI/FHA COMMENTS 09-13-2011
COORDINATION 10-17-2011

KELLER SPRINGS LOFTS

LOFT APARTMENTS IN ADDISON, TEXAS

CONSTRUCTION ISSUE 10-17-2011



4144 N. Central Expy. Suite 855 Dallas, TX 75204 214.520.8878 bgoarchitects.com


DATE 08-05-2011

PROJECT 11129 SHEET NUMBER

9.2


CLUB INTERIOR

COPYRIGHT © Beeler Guest Owens Architects ALL RIGHTS RESERVED

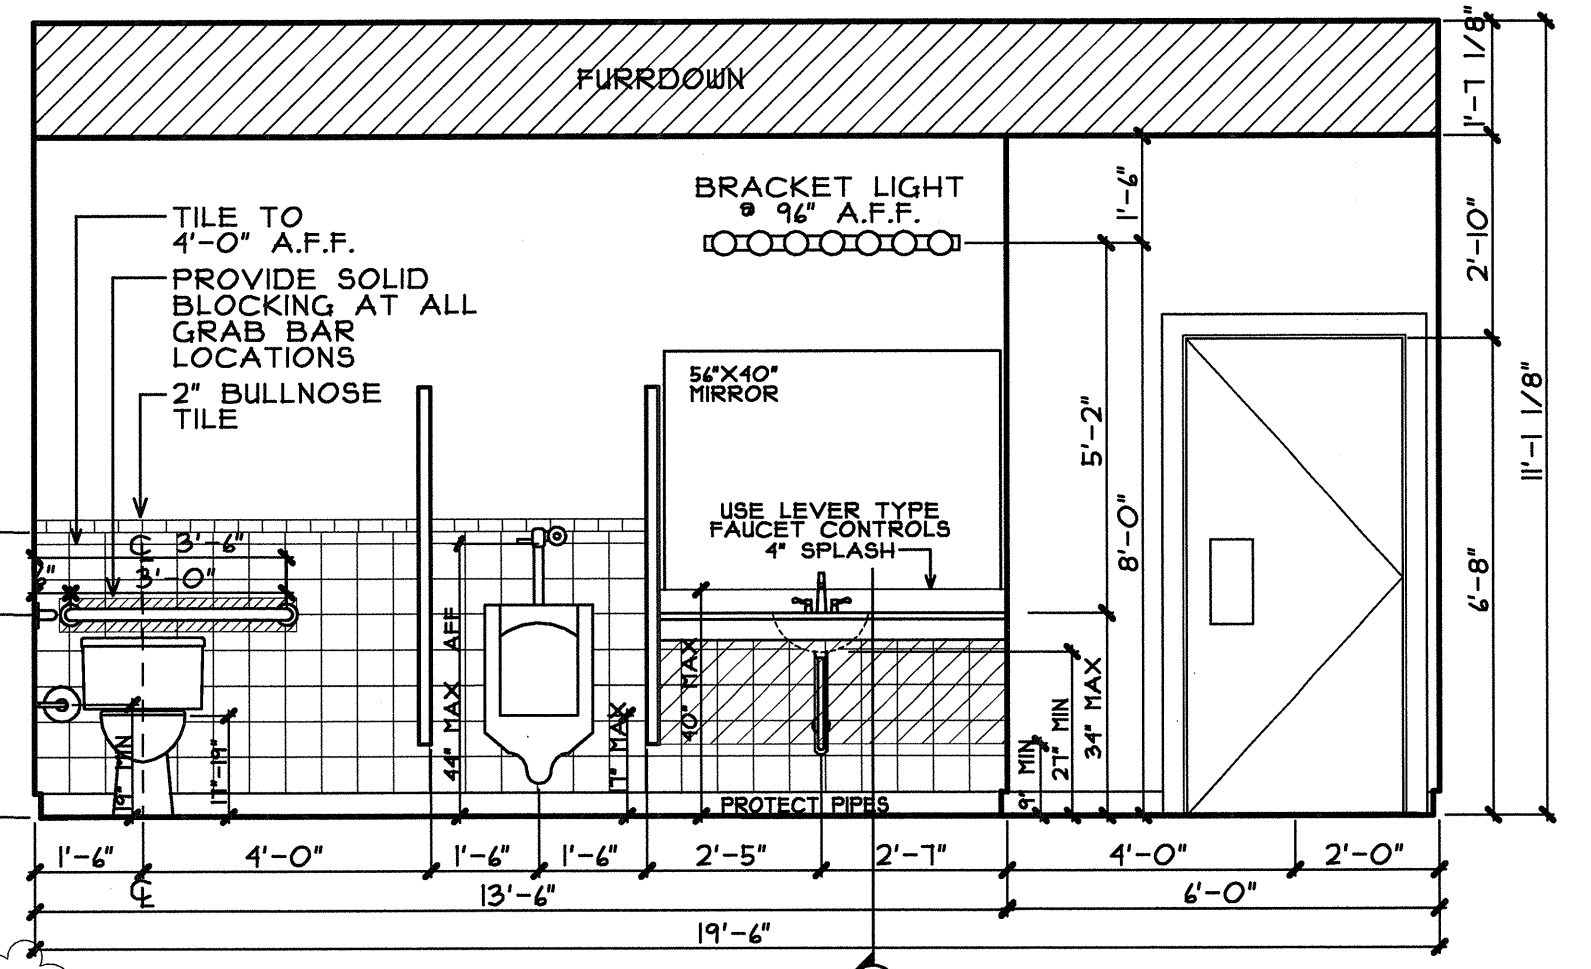


4 MEN'S RESTROOM SCALE: 3/8"=1'-0"

NOTE: WATER SUPPLY AND DRAIN PIPES SHALL BE INSULATED AND COVERED TO PROTECT AGAINST BURNS AND ABRASION. PER ANSI 4.20.4 TAS 4.24.6

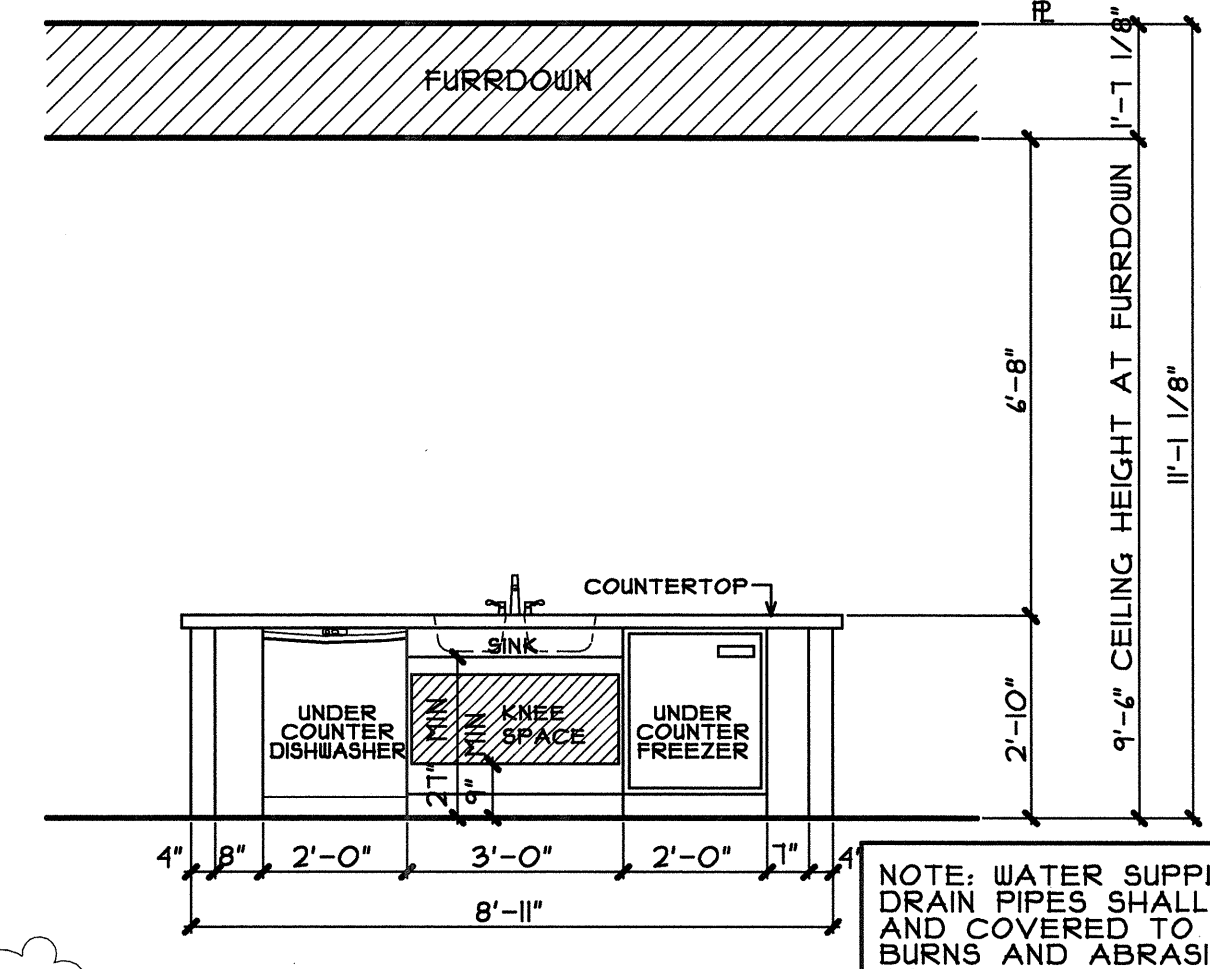


3 KITCHEN SCALE: 3/8"=1'-0"


NOTE: WATER SUPPLY AND DRAIN PIPES SHALL BE INSULATED AND COVERED TO PROTECT AGAINST BURNS AND ABRASION. PER ANSI 4.20.4 TAS 4.24.6

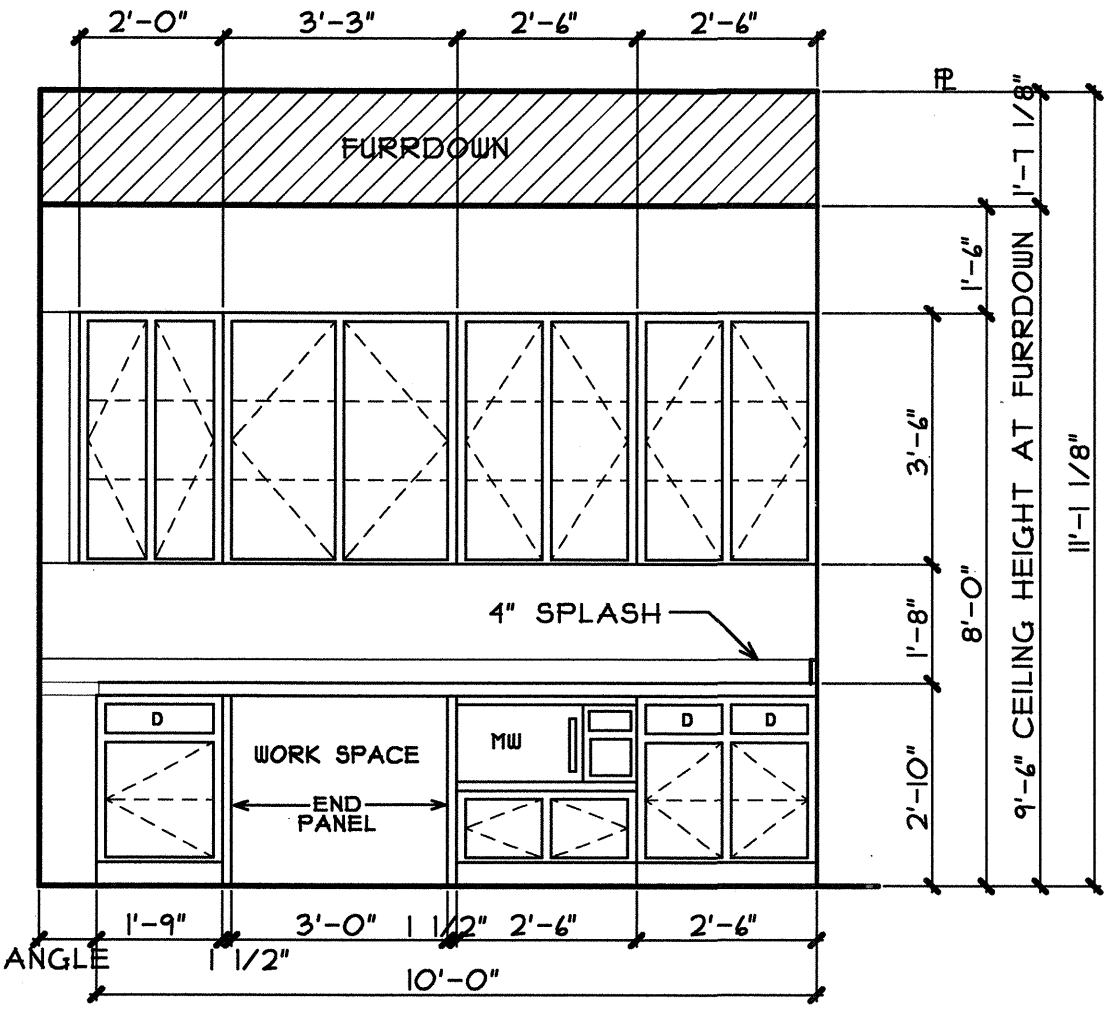


2 KITCHEN SCALE: 3/8"=1'-0"

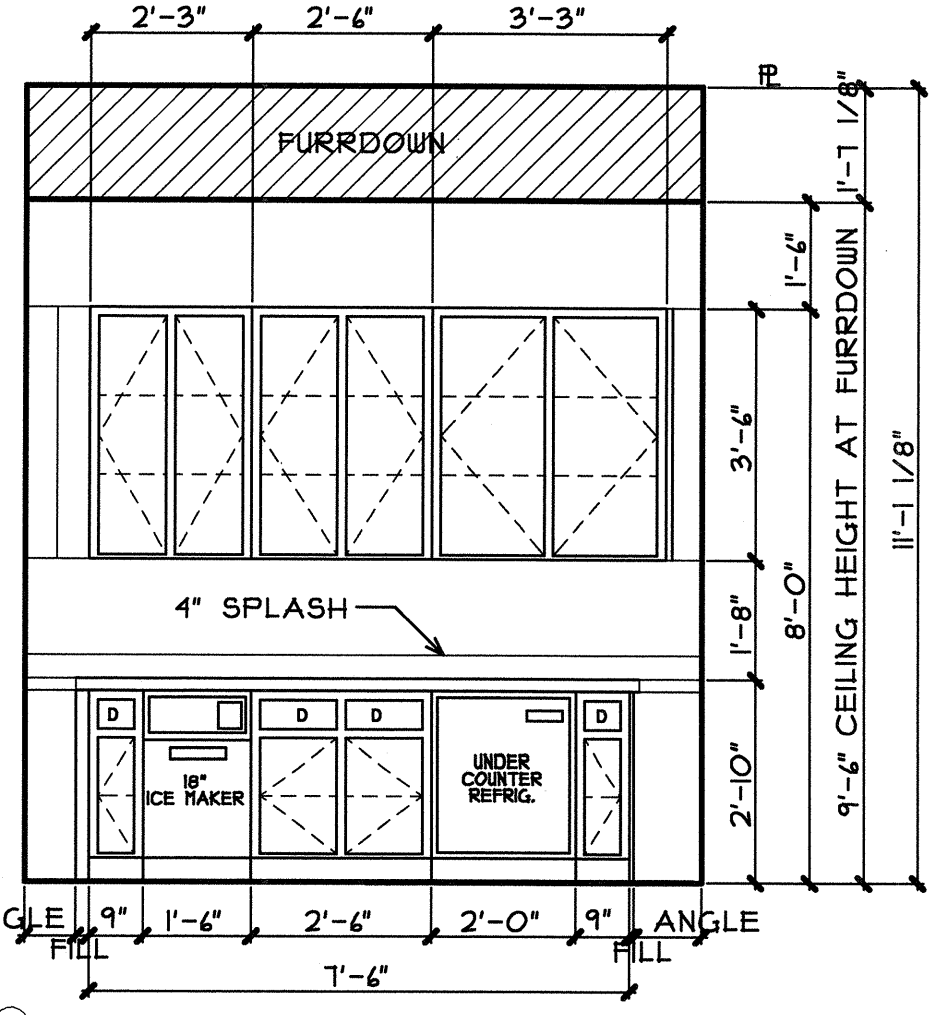


1 KITCHEN SCALE: 3/8"=1'-0"

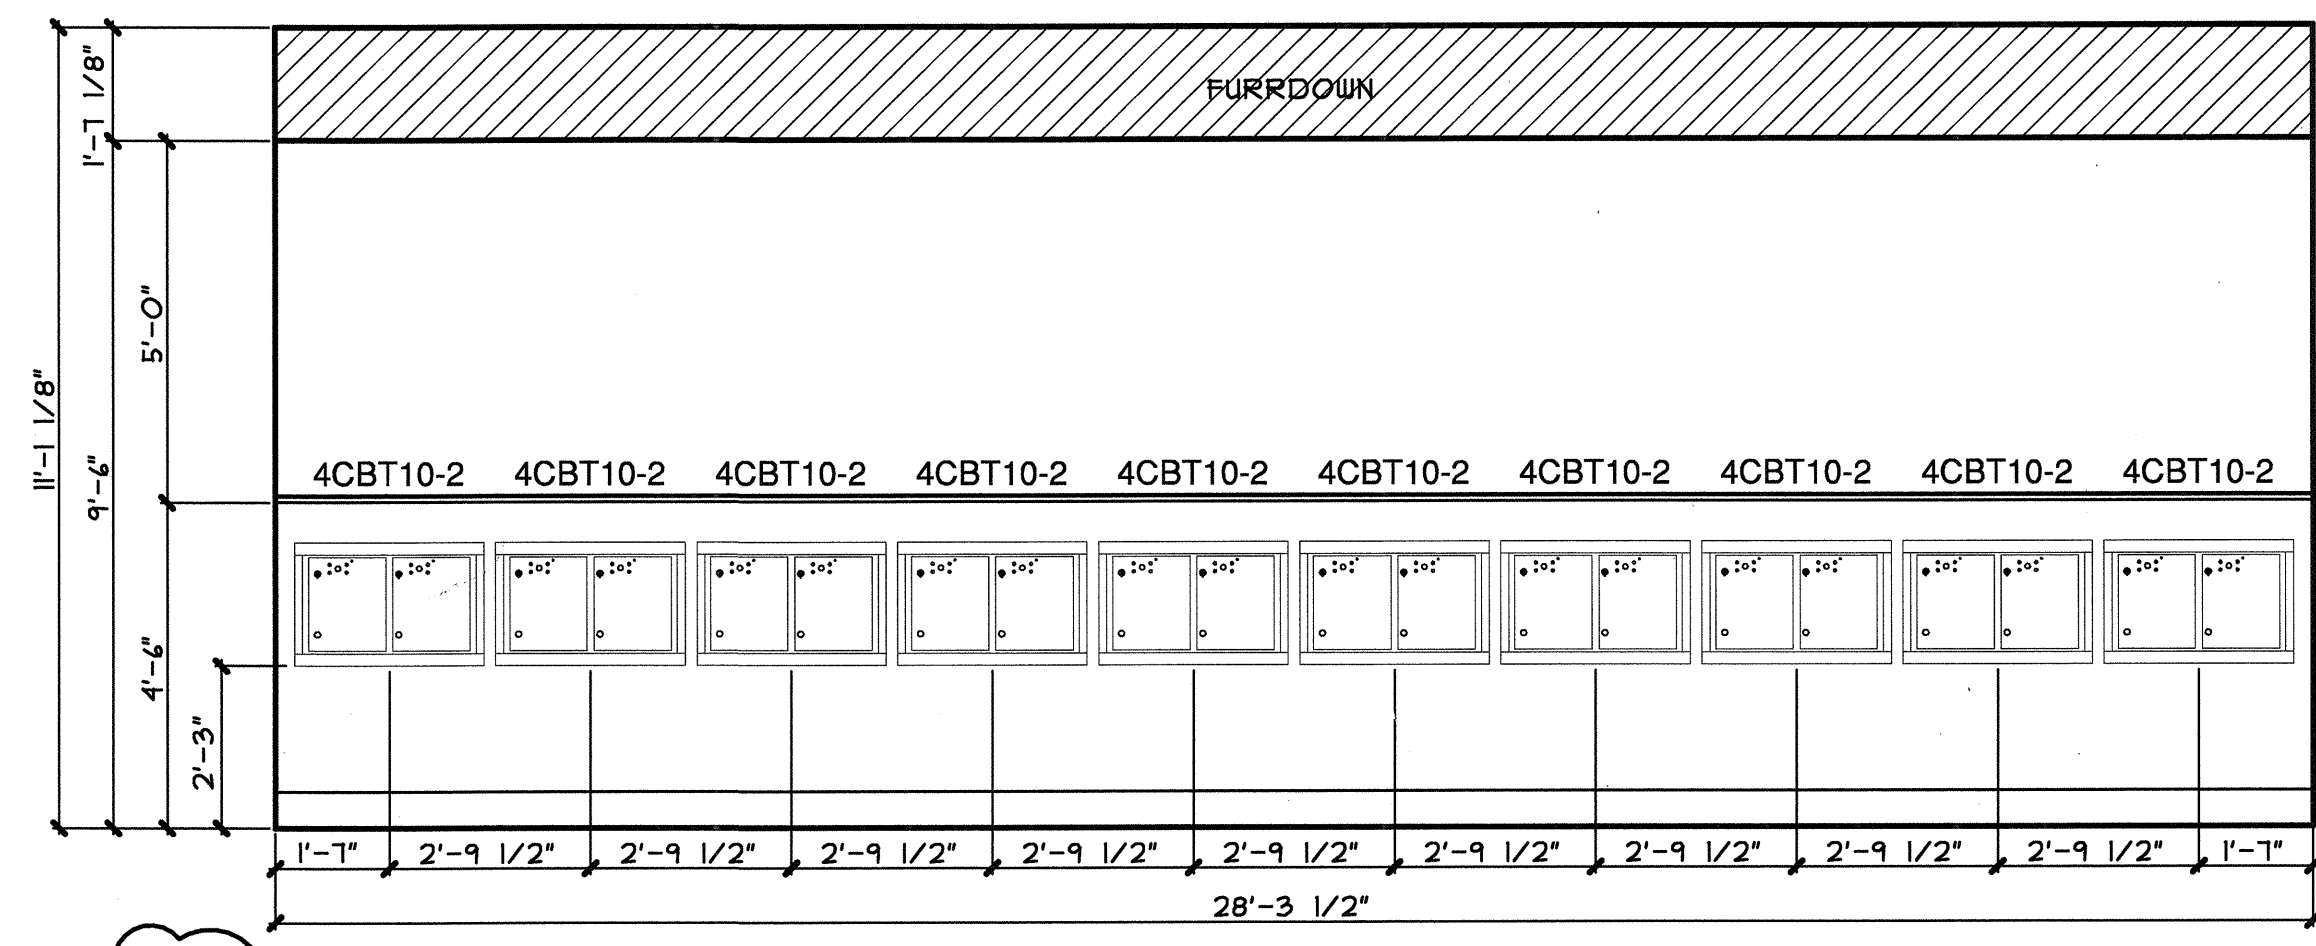


8 MAIL ROOM KIOSK SCALE: 3/8"=1'-0"

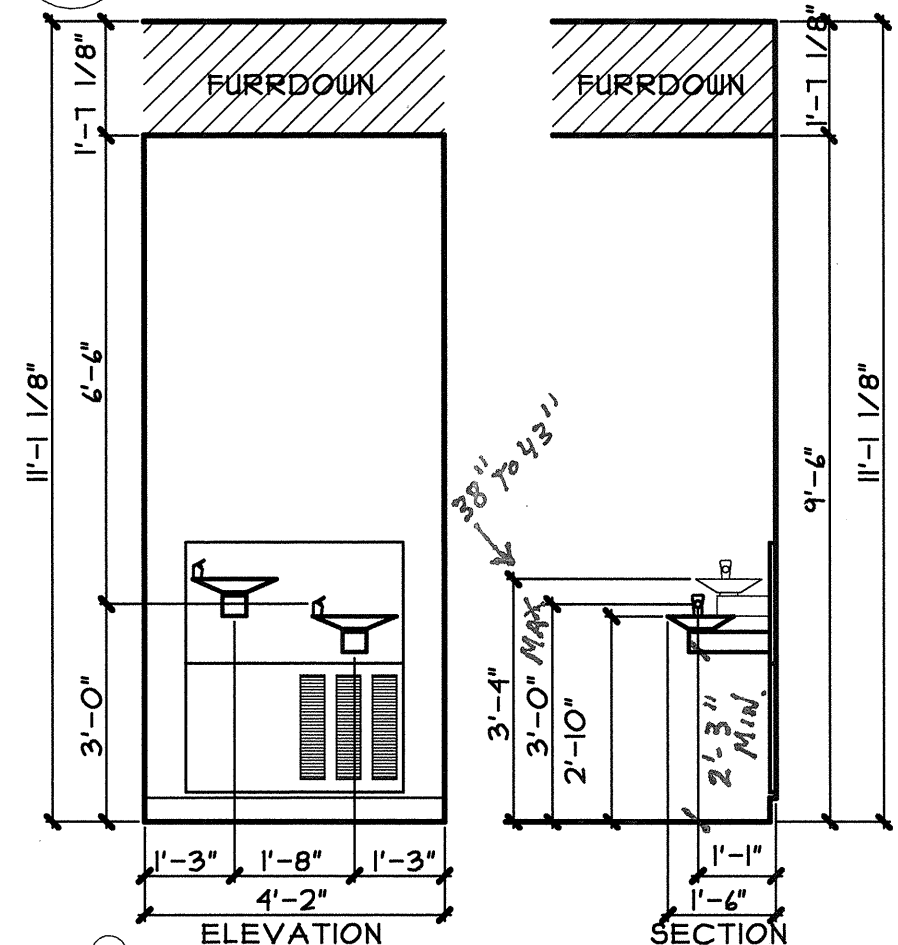


7 WATER FOUNTAIN SCALE: 3/8"=1'-0"

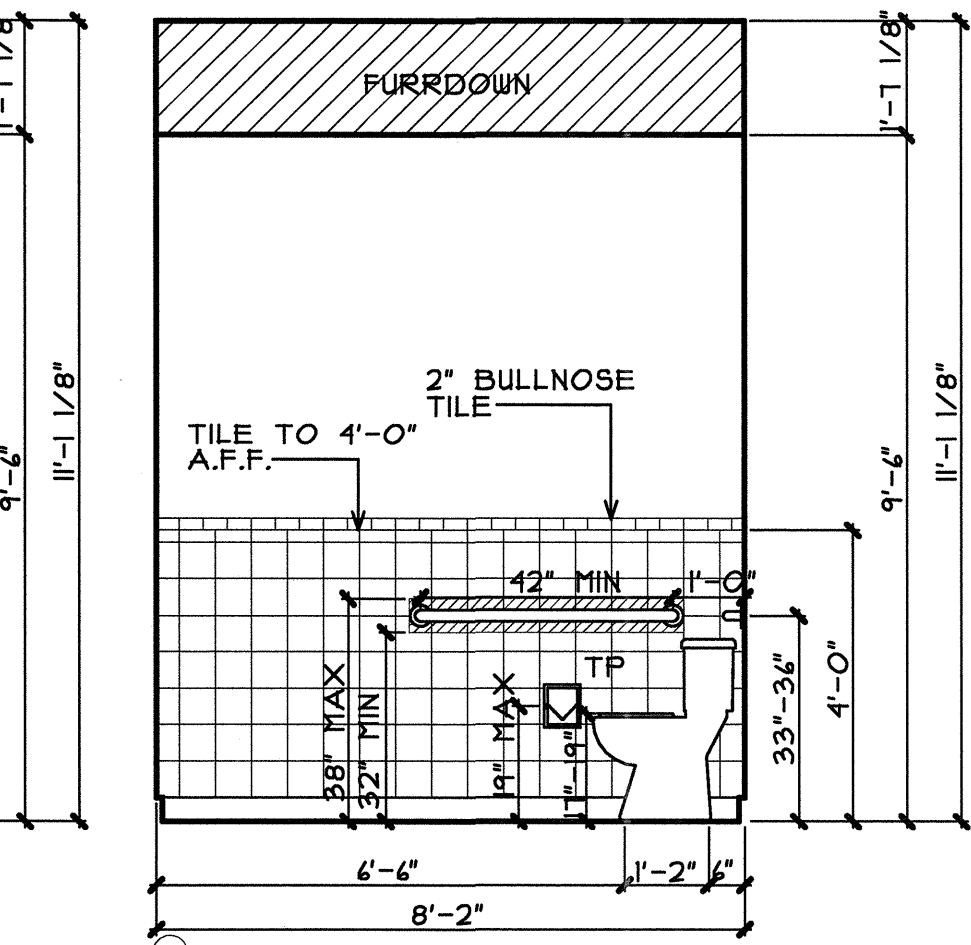

6 RESTROOM SCALE: 3/8"=1'-0"

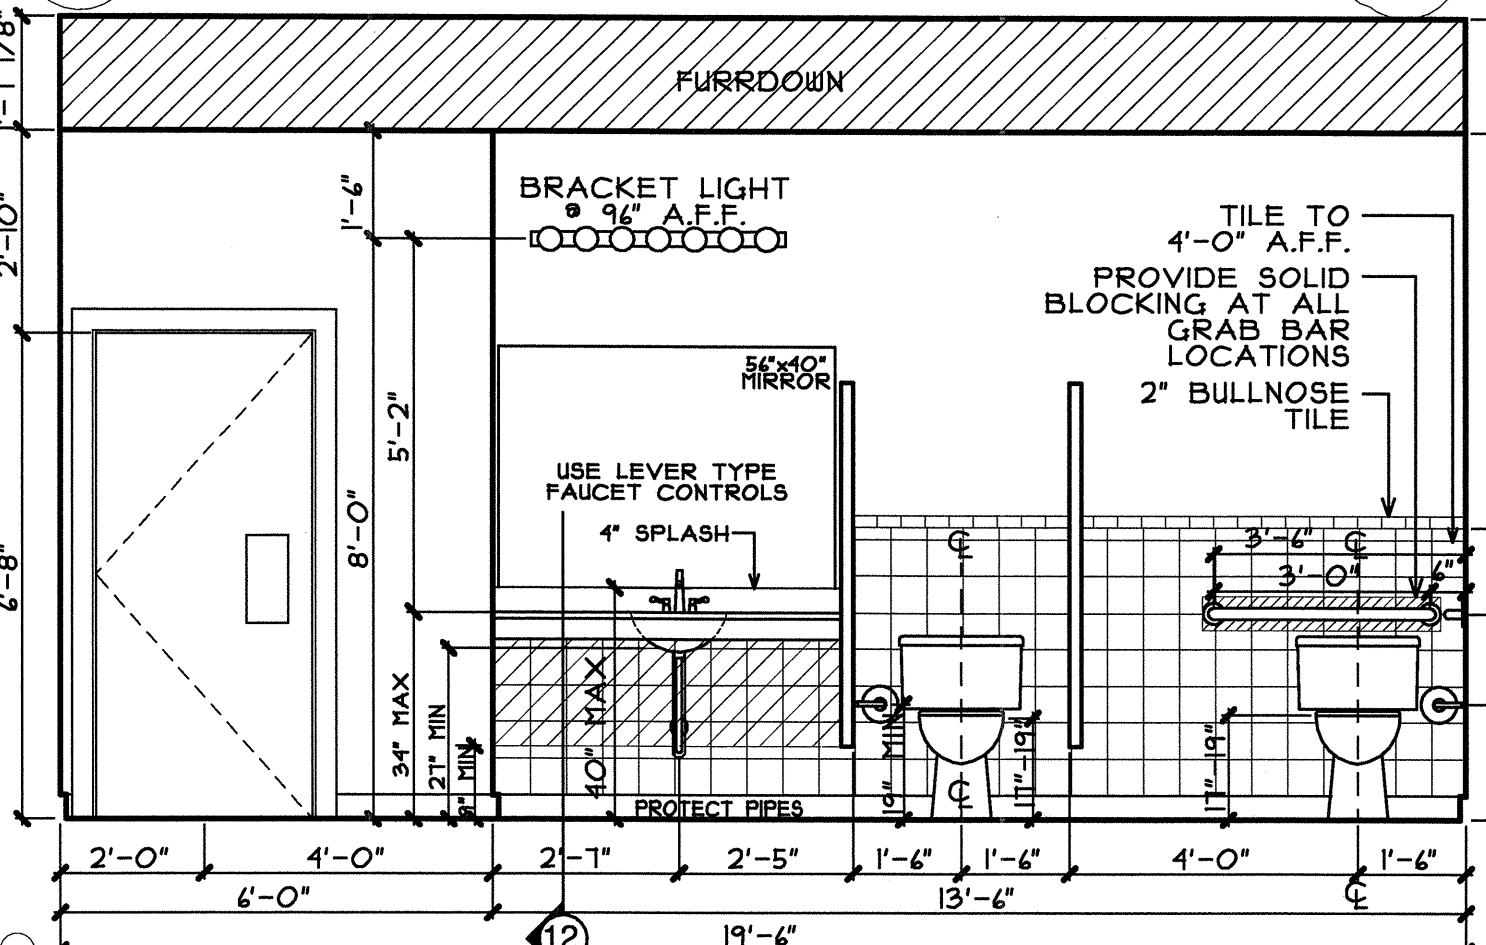


5 WOMEN'S RESTROOM SCALE: 3/8"=1'-0"

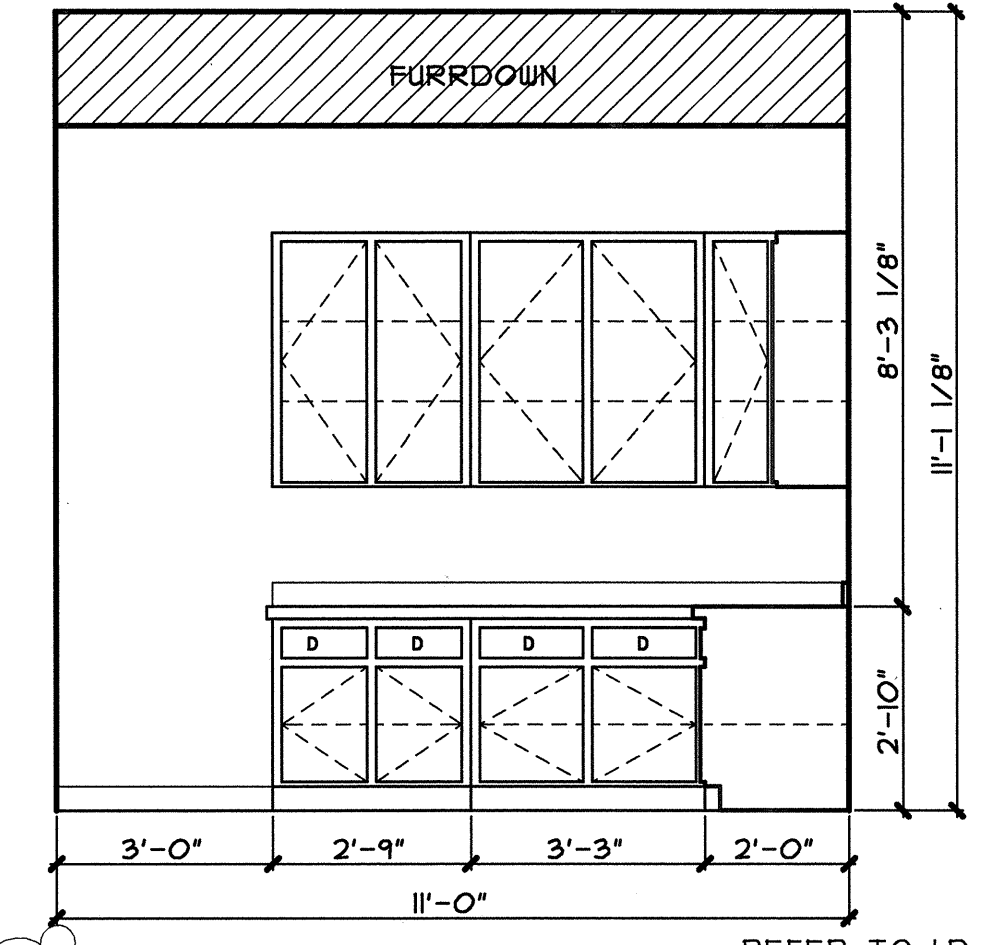


11 WORK ROOM SCALE: 3/8"=1'-0"

REFER TO I.D.

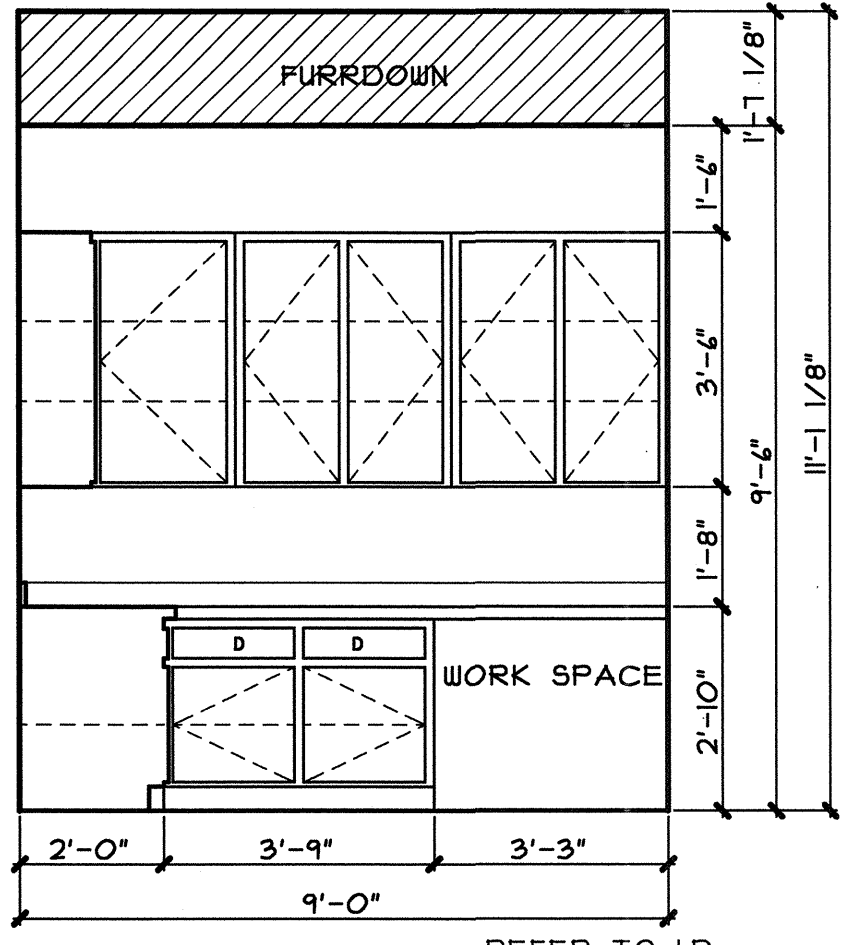


10 WORK ROOM SCALE: 3/8"=1'-0"


REFER TO I.D.

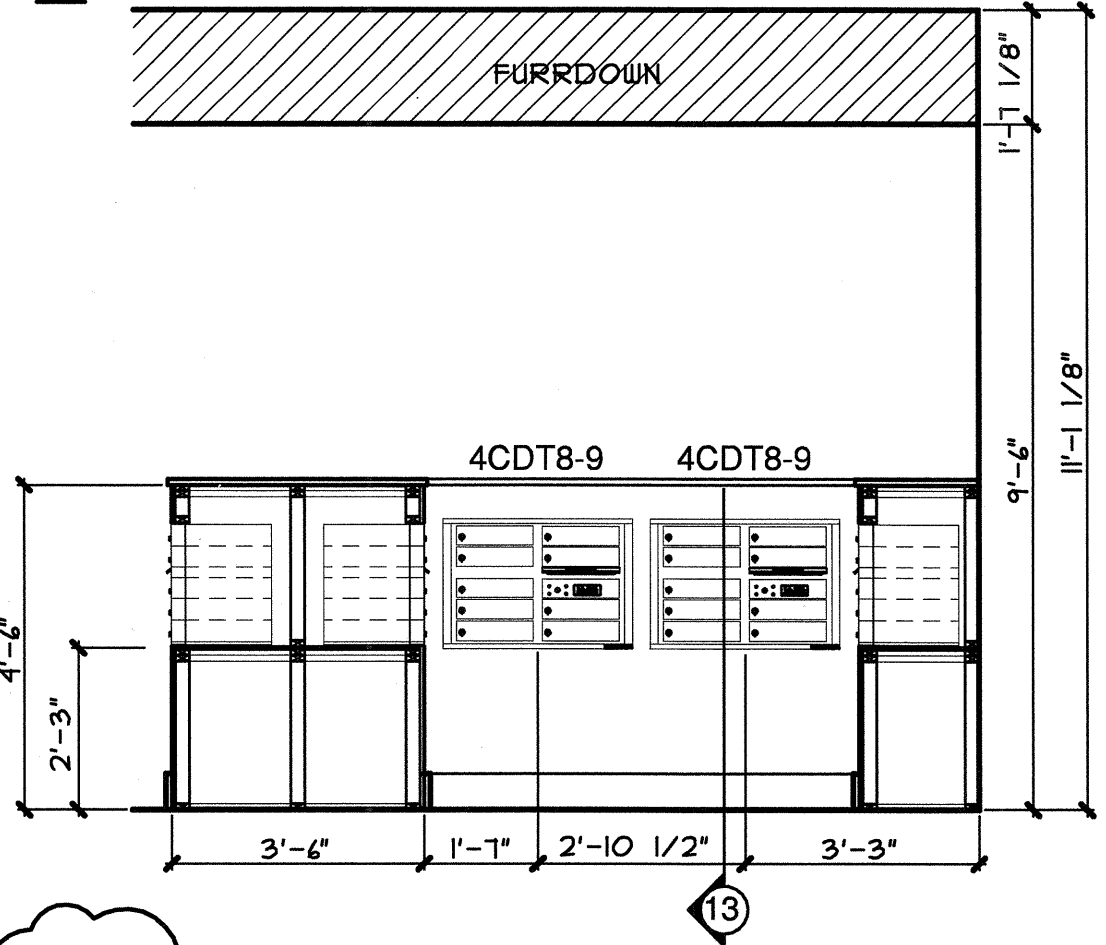


9 MAIL ROOM KIOSK SCALE: 3/8"=1'-0"

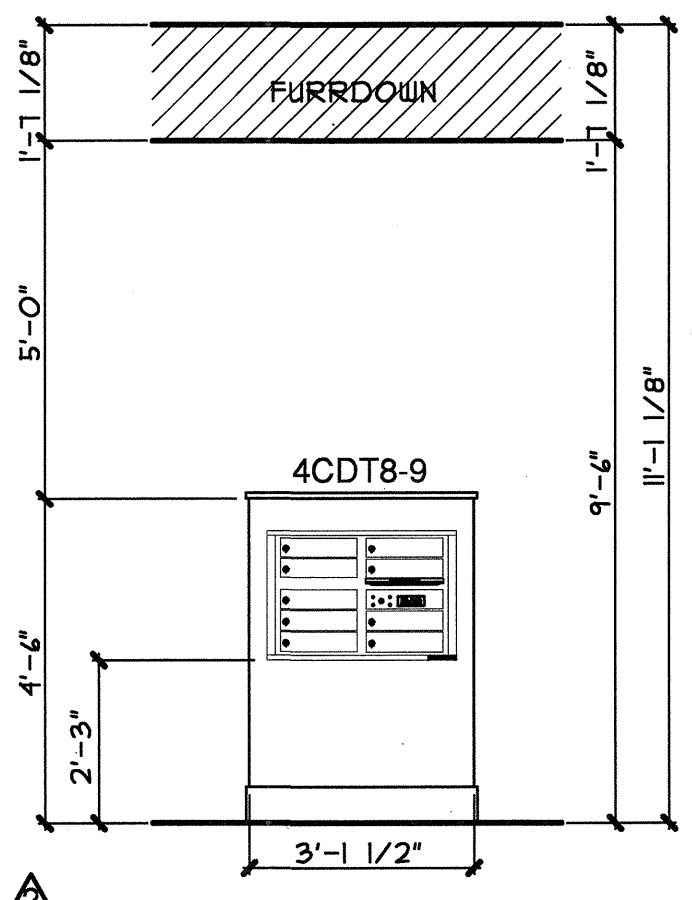


15 MAIL ROOM KIOSK SCALE: 3/8"=1'-0"

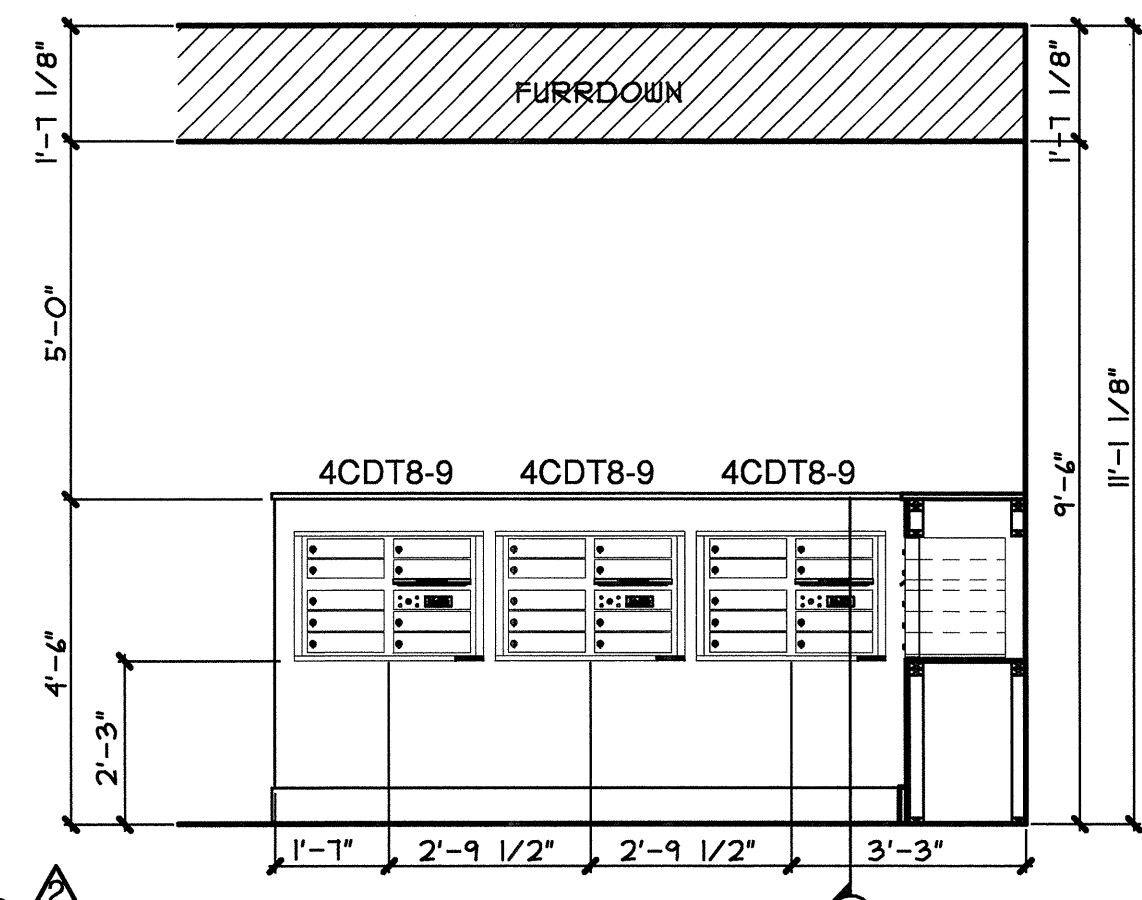

14 MAIL ROOM KIOSK SCALE: 3/8"=1'-0"

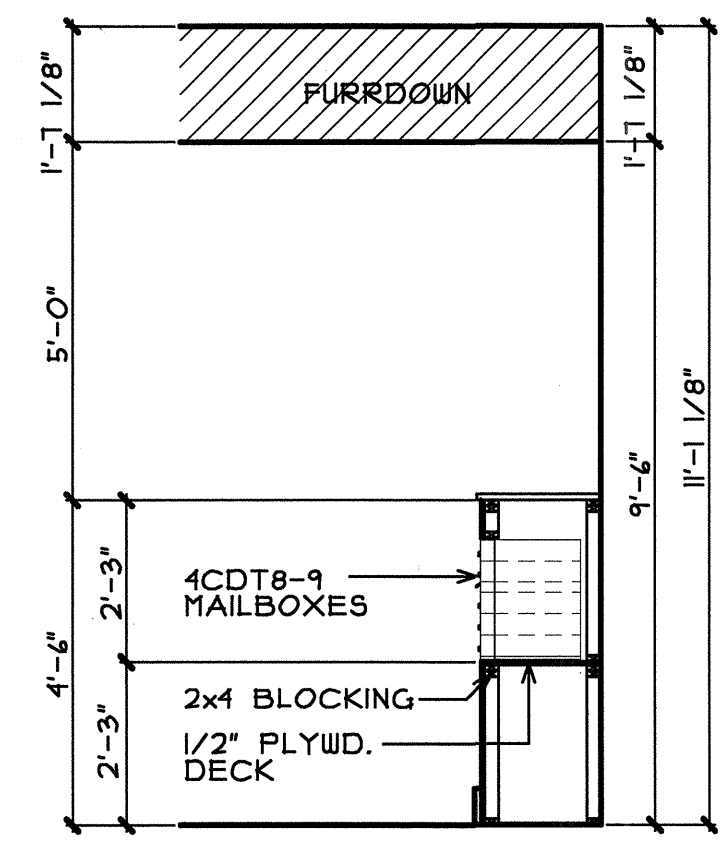

13 SECTION @ MAILBOXES SCALE: 3/8"=1'-0"

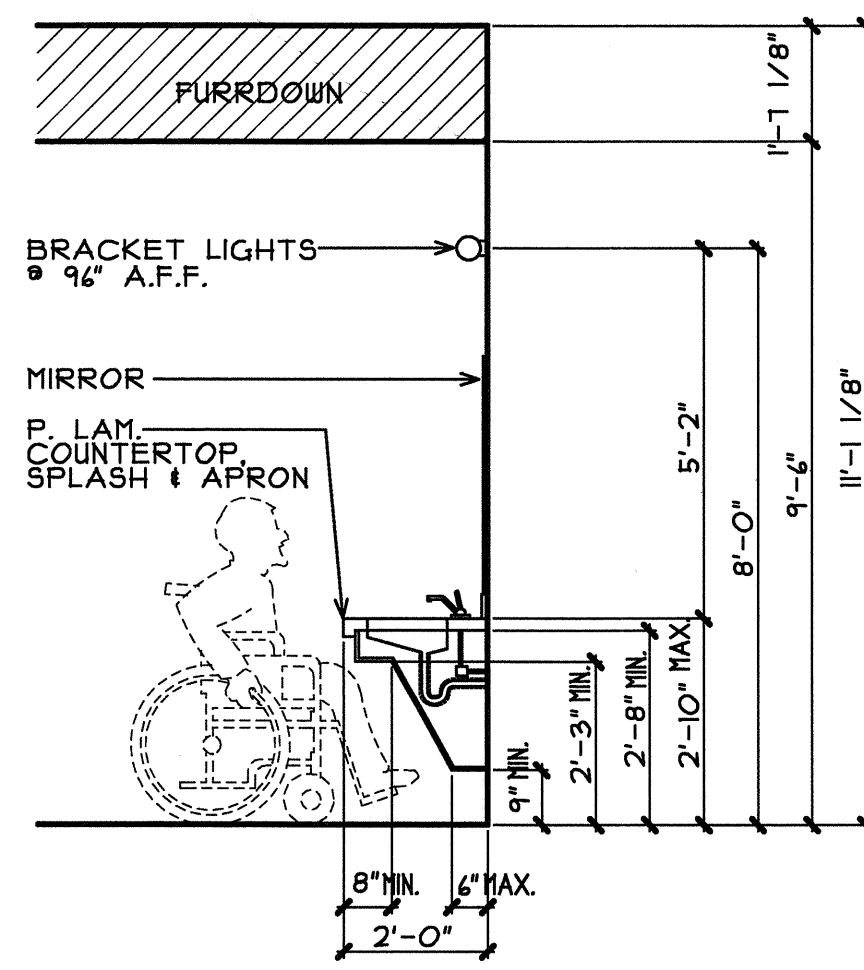

12 REMOVEABLE CABINET AT SINKS SCALE: 3/8"=1'-0"