
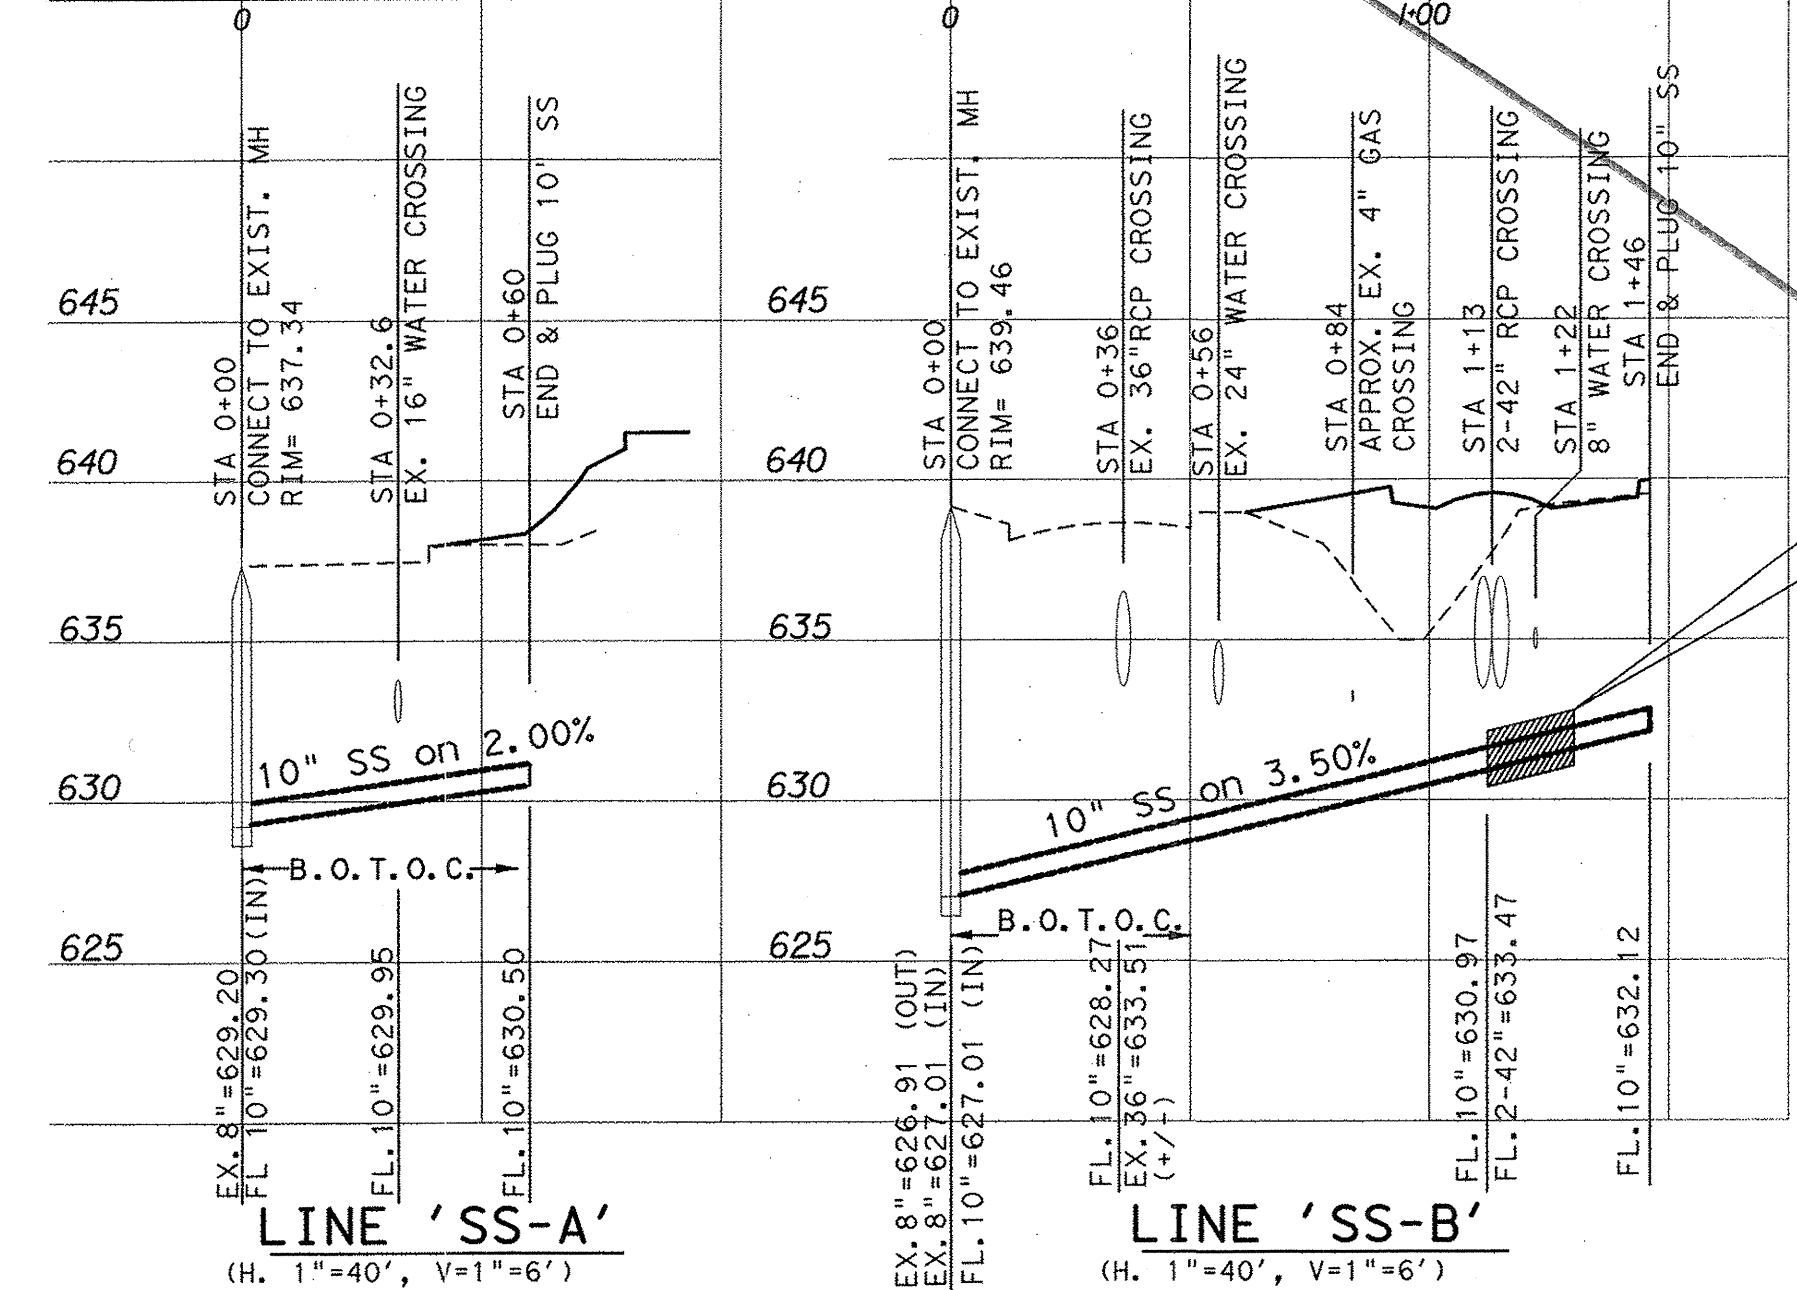



CAUTION!!
 EXIST. GAS MAIN IN AREA
 CONTACT TEXAS ONE CALL
 1-800-245-4545
 48 HOURS PRIOR TO
 CONSTRUCTION

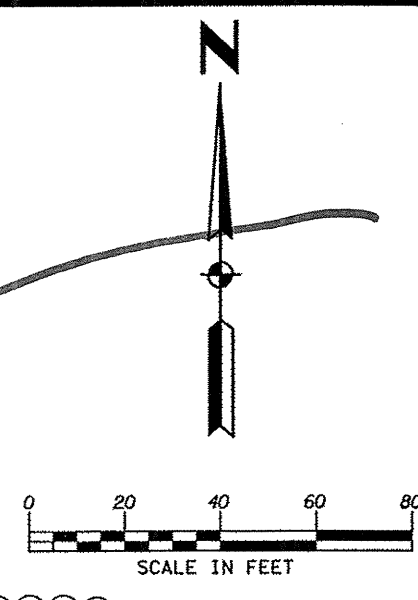

BENCH MARKS:
 BM5
 SQUARE CUT ON INLET, SOUTHWEST CORNER OF RATLIFF LANE AND ADDISON ROAD.
 ELEVATION 637.20
 BM8
 SQUARE CUT ON INLET, SOUTHWEST CORNER OF AIRPORT PKWY. AND QUORUM DRIVE.
 ELEVATION 631.15
 BM1
 BRASS DISK FOUND AT NORTHWEST CORNER OF INLET, SOUTHWEST CORNER OF KELLER SPRINGS AND ADDISON ROAD.
 ELEVATION 638.91

Kimley-Horn and Associates, Inc.
 2000 Ross Street, Suite 200
 Dallas, TX 75201-9818
 Phone: 972-770-8800
 Fax: 972-770-8800

Revision	Date
1	REVISED WATER SERVICE AND FIRE SERVICE NOTES
2	RELOCATED FIRE HYDRANTS PER TOWN & REVISED LINE SS-B

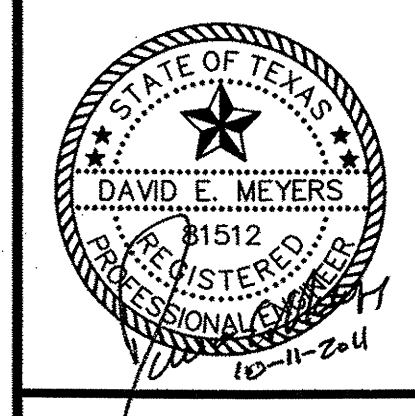

Keller Springs Lofts
 Loft Apartments in Addison
 Town of Addison, Texas

WATER AND WASTEWATER
 PLAN - PROFILE

DATE: OCTOBER 11, 2011
 DESIGN: KHA
 DRAWN: KHA
 CHECKED: KHA
 KHA NO.: 064362003
 CITY NO.:
 SHEET
C10