

CAUTION!!
 EXIST. GAS MAIN IN AREA
 CONTACT TEXAS ONE CALL
 1-800-245-4545
 48 HOURS PRIOR TO
 CONSTRUCTION

PROPOSED POWER POLE (TYPICAL)
 (REFER TO ELECTRICAL PLANS BY OTHERS)

VERIFY LOCATION OF EXISTING GAS MAIN PRIOR TO PLACING POWER POLES

PROPOSED BOLLARDS (TYPICAL)
 (REFER TO ELECTRICAL PLANS BY OTHERS)

PROPOSED SINGLE PHASE TRANSFORMER (TYPICAL)
 (REFER TO ELECTRICAL PLANS BY OTHERS)

EXISTING POWER POLE TO BE RELOCATED

EXISTING POWER POLE TO BE REMOVED

PROPOSED POWER POLE (TYPICAL)
 (REFER TO ELECTRICAL PLANS BY OTHERS)

EXISTING UNDERGROUND ELECTRICAL TO BE ABANDONED

PROPOSED POWER POLE (TYPICAL)
 (REFER TO ELECTRICAL PLANS BY OTHERS)

PROPOSED SWITCH GEAR
 (REFER TO ELECTRICAL PLANS BY OTHERS)

PROPOSED THREE PHASE TRANSFORMER
 (REFER TO ELECTRICAL PLANS BY OTHERS)

PROPOSED SINGLE PHASE TRANSFORMER (TYPICAL)
 (REFER TO ELECTRICAL PLANS BY OTHERS)

PROPOSED SINGLE PHASE TRANSFORMER (TYPICAL)
 (REFER TO ELECTRICAL PLANS BY OTHERS)

NOTE:

THIS PLAN IS FOR INFORMATION ONLY. SEE ELECTRICAL SITE PLAN PROVIDED BY JORDAN & SKALA AND SCHEMATIC DESIGN PROVIDED BY ONCOR FOR ELECTRICAL DESIGN INCLUDING PRIMARIES AND METER BANK LOCATIONS.

POWER POLE COORDINATES:

POLE#	NORTHING	EASTING
P1	5231.4687	5137.3653
P2	5230.7169	5299.7169
P3	5230.8269	5411.0117
P4	5230.9763	5485.1045
P5	5226.2535	5563.8478
P6	5125.3917	5555.7196
P7	5085.3118	5555.3903
P8	5042.4552	5555.1847
P11	4989.3960	4778.1064
P12	5029.7737	4778.1064
P13	5073.3003	4776.1447
P14	5132.3670	4771.4433

BENCH MARKS:

BMS
 SQUARE CUT ON INLET, SOUTHWEST CORNER OF RATLIFF LANE AND ADDISON ROAD.
 ELEVATION 637.20


BMS
 SQUARE CUT ON INLET, SOUTHWEST CORNER OF AIRPORT PKWY. AND QUORUM DRIVE.
 ELEVATION 631.15

BM1
 BRASS DISK FOUND AT NORTHWEST CORNER OF INLET, SOUTHWEST CORNER OF KELLER SPRINGS AND ADDISON ROAD.
 ELEVATION 638.91

Kimley-Horn and Associates, Inc.
 2070 Park Center Drive, Suite 900
 Dallas, TX 75208-9988
 Phone: 714.763.8988
 Fax: 714.763.8989
 No. 105

Revision: 1
 REVISION TRANSFORMERS AND POWER POLE LAYOUTS

Date: 9/19/11

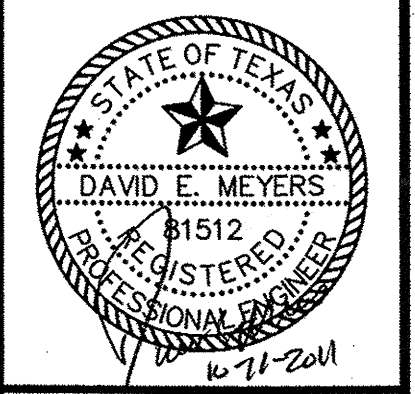

Keller Springs Lofts
 Loft Apartments in Addison
 Town of Addison, Texas

ELECTRICAL SITE PLAN

DATE: OCTOBER 11, 2011
 DESIGN: KHA
 DRAWN: KHA
 CHECKED: KHA
 KHA NO.: 064362003
 CITY NO.:

SHEET

C10a