



NOTE: SEE SHEET C15 FOR GENERAL NOTES.

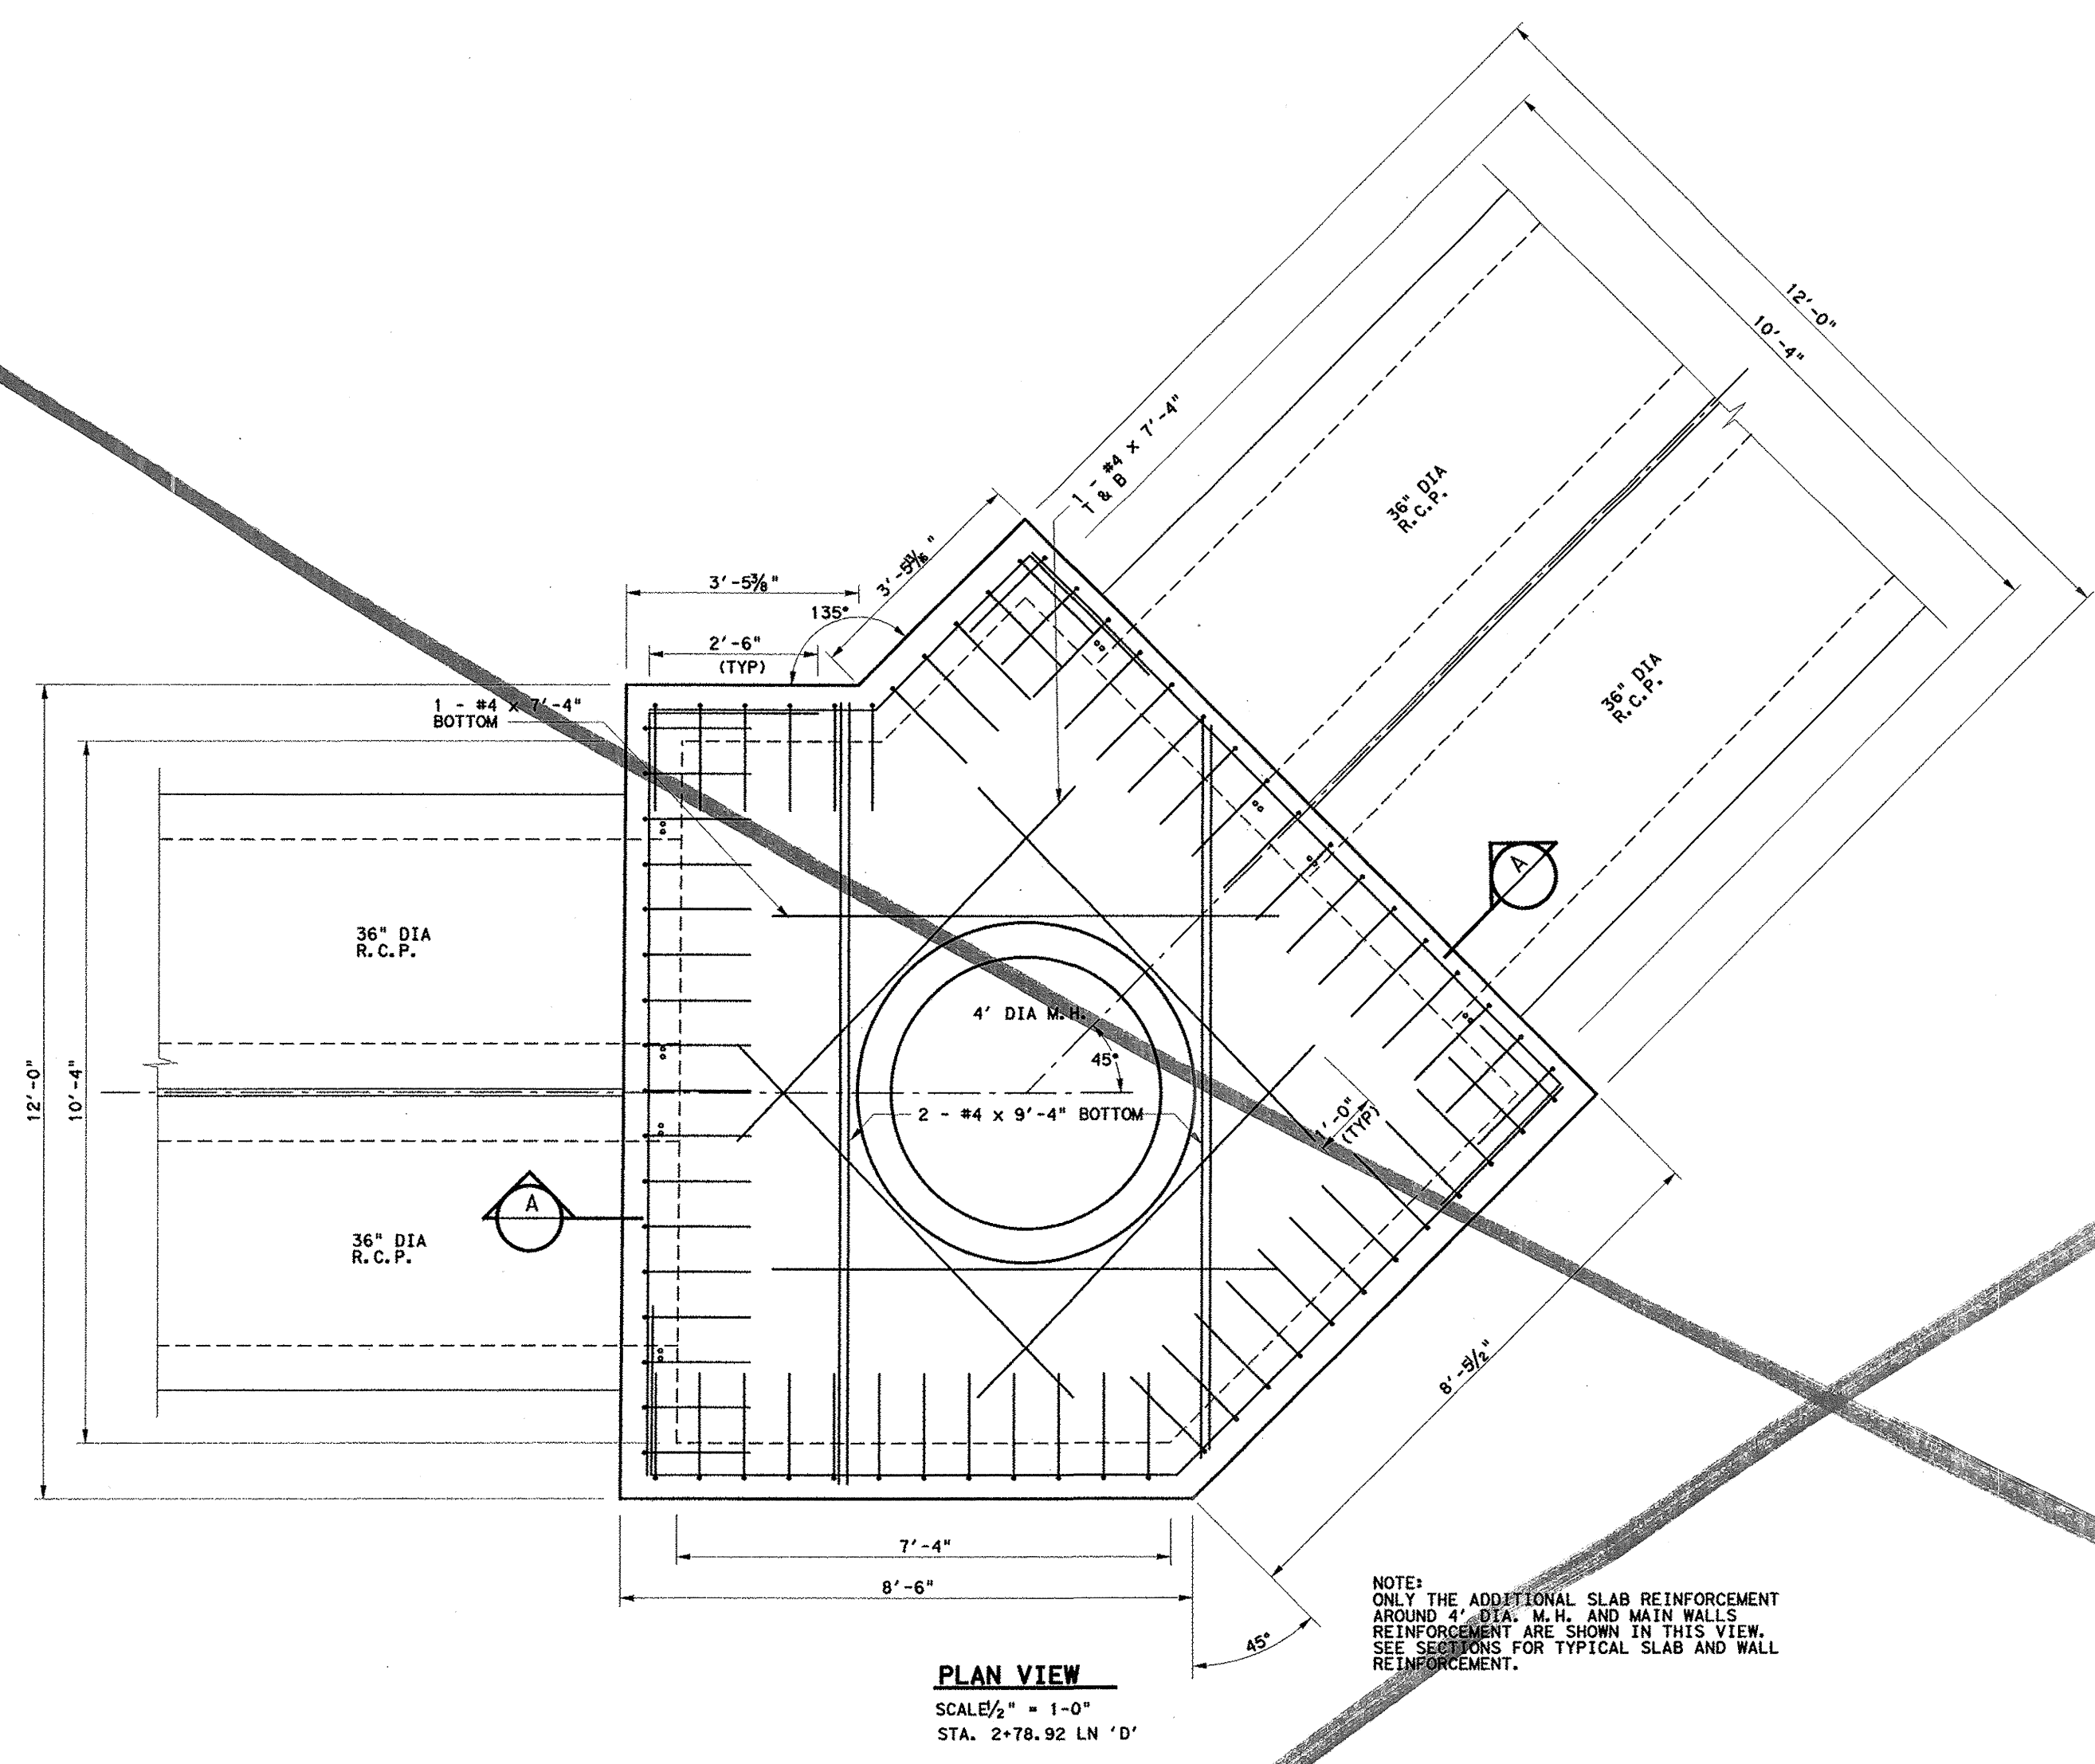


PLAN VIEW
SCALE: 1/2" = 1'-0"
STA. 2+78.92 LN 'D'

NOTE: ONLY THE ADDITIONAL SLAB REINFORCEMENT AROUND 4' DIA. M.H. AND MAIN WALLS REINFORCEMENT ARE SHOWN IN THIS VIEW. SEE SECTIONS FOR TYPICAL SLAB AND WALL REINFORCEMENT.

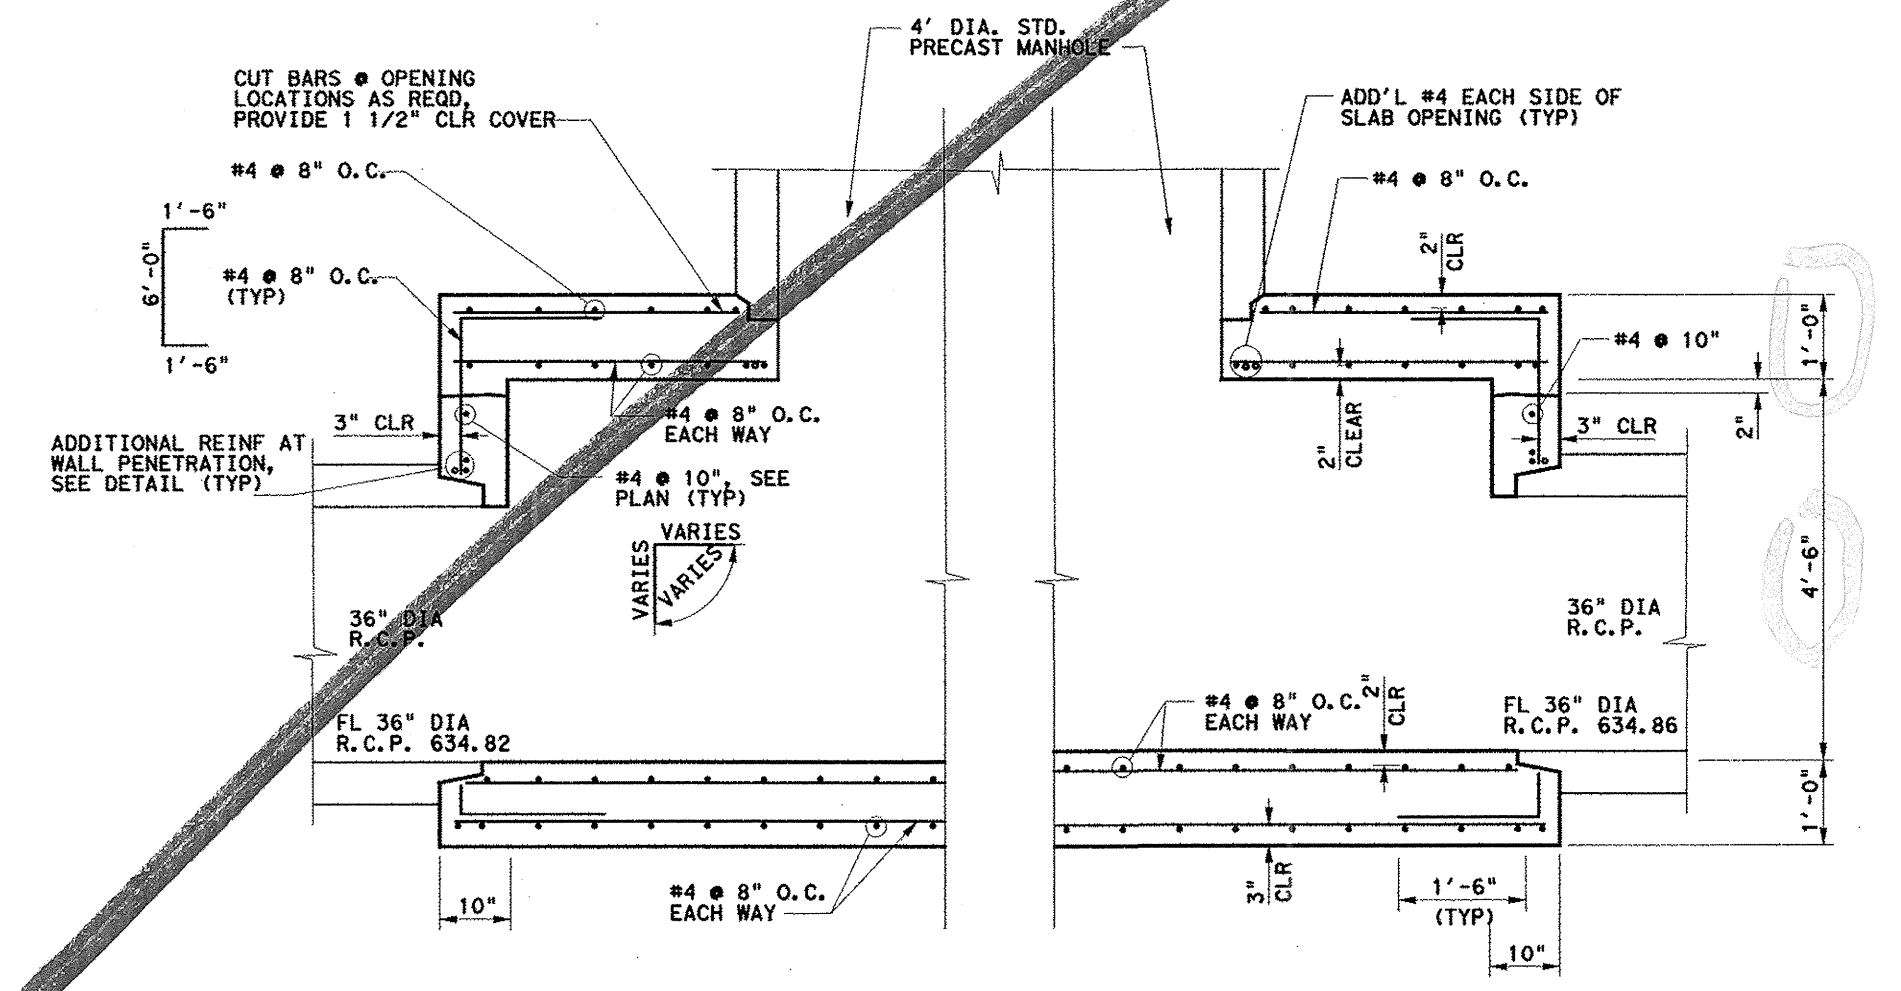


SECTION A-A
SCALE: 1/2" = 1'-0"
STA. 2+78.92 LN 'D'

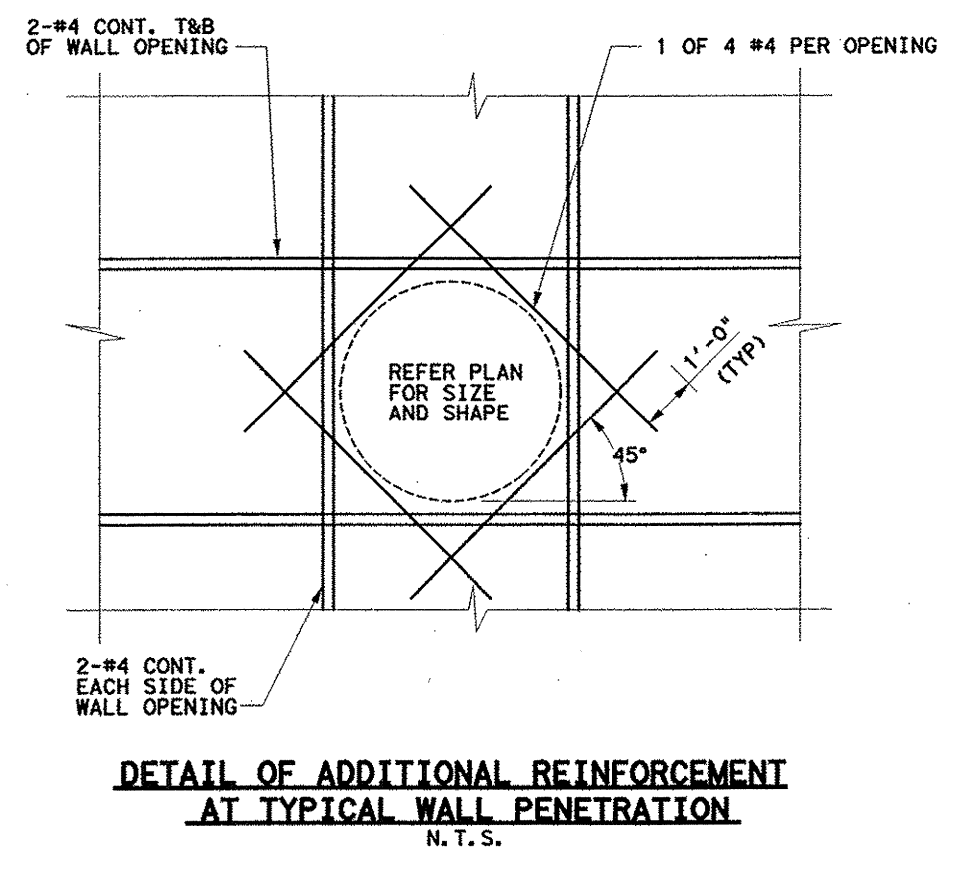

Kimley-Horn and Associates, Inc.
2000 Park Center Drive, Suite 900
Dallas, TX 75246
Tel: 972-770-8800
Fax: 972-770-8800

No.	Revision	Date

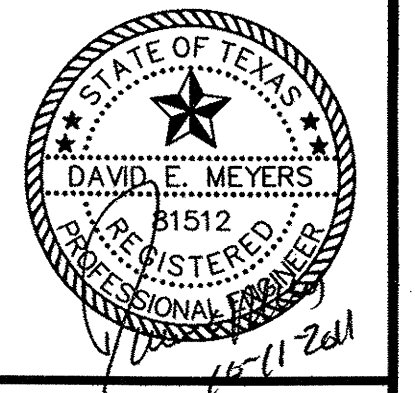

Keller Springs Lofts
Loft Apartments in Addison
Town of Addison, Texas

JUNCTION STRUCTURE DETAILS

DATE: OCTOBER 11, 2011
DESIGN: KHA
DRAWN: KHA
CHECKED: KHA
KHA NO.: 064362003
CITY NO.: