


NOTE: SEE SHEET C15 FOR GENERAL NOTES.

Kimley-Horn and Associates, Inc.  
2700 Park Central Drive, Suite 800  
Dallas, TX 75205-8808 972-770-8000  
FAX 972-770-8000  
Date: \_\_\_\_\_  
Revision: \_\_\_\_\_  
No. \_\_\_\_\_

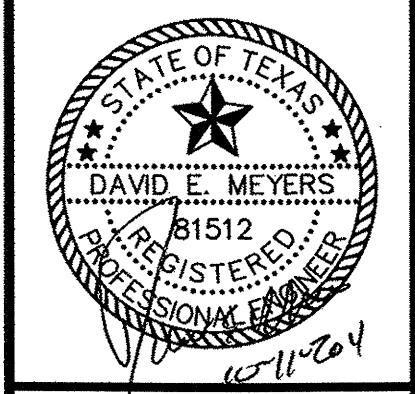

**Keller Springs Lofts**  
**Loft Apartments in Addison**  
Town of Addison, Texas

**JUNCTION STRUCTURE**  
**DETAILS**

DATE: OCTOBER 11, 2011  
DESIGN: KHA  
DRAWN: KHA  
CHECKED: KHA  
KHA NO.: 064-362003  
CITY NO.:

SHEET  
**C18**