

LEGEND

--- 634 ---	EX. MINOR CONTOUR
--- 635 ---	EX. MAJOR CONTOUR
--- 635 ---	PROP. CONTOUR
• 559.5	PROP. SPOT ELEVATION
• 551.19	EXIST. SPOT ELEVATION
F.F.	FINISH FLOOR ELEVATION
→	SURFACE FLOW DIRECTION

- Grading Notes (Multi-family)**
- This plan is for site rough grading only. See architect and structural plans for slab elevations to be used for foundation construction.
 - Plan elevations are to finish building slab, top of pavement, or finish grade in planting areas. Adjustment for slab, pavement, and planting bed thickness must be made for the purposes of earthwork. Refer to the architect and landscape architect plans for elements not detailed in this plan set.
 - Rough grading shall be accomplished to within +/- 0.10 feet of plan elevation after adjustment for finish thickness.
 - As a minimum requirement, all fill shall be placed in 6-inch lifts compacted to between 95% of standard proctor density between -3% and +3% of optimum moisture content. Refer to the geo-tech report for complete project specifications.
 - All trees, stumps, brush, grasses and surface organics are to be removed and properly disposed of offsite. Tree removal permits shall be obtained by the owner or the contractor prior to commencement of grading.
 - Existing utility poles will be removed or relocated by the utility companies through coordination by the owner and contractor. Contractor shall bring to the owner's attention any facilities that are, or appear to be, in conflict with construction activities.
 - The contractor shall install erosion control measures per the plans and maintain streets free of mud, dirt and debris for the duration of the construction activities. See Erosion Control and Storm Water Pollution Prevention Plan for specific details and requirements.
 - Cross slopes on sidewalks shall not exceed a 2% grade and longitudinal slopes shall not exceed a 5% grade. Slopes in excess of the above noted maximums will be in violation of accessibility requirements and will be subject to removal and replacement at the direction of the accessibility reviewer and at the expense of the contractor.

STOP!
CALL BEFORE YOU DIG
DIG TESS
1-800-DIG-TESS
 (at least 72 hours prior to digging)

WARNING: CONTRACTOR TO VERIFY PRESENCE AND EXACT LOCATION OF ALL UTILITIES PRIOR TO CONSTRUCTION.

BENCH MARKS:

BMS
 SQUARE CUT ON INLET, SOUTHWEST CORNER OF RATLIFF LANE AND ADDISON ROAD.
 ELEVATION 637.20

BMS
 SQUARE CUT ON INLET, SOUTHWEST CORNER OF AIRPORT PKWY. AND QUORUM DRIVE.
 ELEVATION 631.15

BMS
 BRASS DISK FOUND AT NORTHWEST CORNER OF INLET, SOUTHWEST CORNER OF KELLER SPRINGS AND ADDISON ROAD.
 ELEVATION 638.91


NOTE:
 ALL GRADES ARE TOP OF PAVEMENT UNLESS OTHERWISE NOTED

Kimley-Horn and Associates, Inc.

2000 Park Center Drive, Suite 900
 Dallas, TX 75241
 Phone: 972-968-9200

Date: 11/17/11
 Revision: 2/16/12

No. 1 REVISED FIRE LANE GRADES
 No. 2 REVISED PARKING GRADING

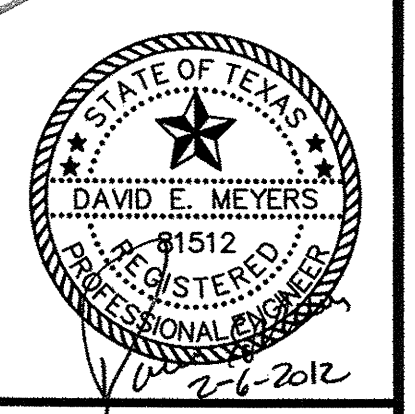

Keller Springs Lofts
Loft Apartments in Addison
 Town of Addison, Texas

GRADING PLAN

DATE: FEBRUARY 6, 2012	DESIGN: KHA	DRAWN: KHA	CHECKED: KHA	KHA NO.: 06-4362003	CITY NO.:
SHEET					
C4					