


10/27/11  
 3 ADDED 8" CONCRETE, REVISED DRIVEWAY AND ADDED BARRIER FREE RAMP

Kimley-Horn and Associates, Inc.  
 2700 Park Center Drive, Suite 800  
 Dallas, TX 75244  
 Phone: 972-770-8800  
 Fax: 972-770-8801  
 Email: kha@kimley-horn.com

No.	Revision	Date
1	REVISED DRIVE APPROACH SPEC	8/26/11
2	ADDED SIDEWALK REFERENCE AND REVISED FIRE LANE	9/14/11

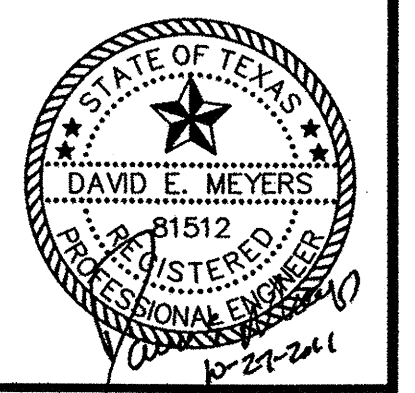

**Keller Springs Lofts**  
**Loft Apartments in Addison**  
 Town of Addison, Texas

**LEGEND**

	6" 4200 PSI REINFORCED CONCRETE PAVEMENT ON 6" LIME STABILIZED SUBGRADE, 28 LBS/SY COMPACTED TO A MINIMUM 95% STANDARD PROCTOR DENSITY AT 0% TO 3% OF OPTIMUM MOISTURE.
	8" 4500 PSI REINFORCED CONCRETE PAVEMENT ON 6" LIME STABILIZED SUBGRADE, 28 LBS/SY COMPACTED TO A MINIMUM 95% STANDARD PROCTOR DENSITY AT 0% TO 3% OF OPTIMUM MOISTURE.
	PROPOSED SIDEWALK REFER TO LANDSCAPE PLAN FOR LOCATION AND DETAILS

**BENCH MARKS:**

BMS	SQUARE CUT ON INLET, SOUTHWEST CORNER OF RATLIFF LANE AND ADDISON ROAD. ELEVATION 637.20
BM8	SQUARE CUT ON INLET, SOUTHWEST CORNER OF AIRPORT PKWY. AND QUORUM DRIVE. ELEVATION 631.15
BM1	BRASS DISK FOUND AT NORTHWEST CORNER OF INLET, SOUTHWEST CORNER OF KELLER SPRINGS AND ADDISON ROAD. ELEVATION 638.91

- NOTES:**
- REFER TO DIMENSION CONTROL PLAN FOR PAVING DIMENSIONS AND CENTERLINE CONTROL.
  - REFERENCE GENERAL NOTES FOR ADDITIONAL PLAN NOTES.
  - BARRIER FREE RAMPS AND SIDEWALKS SHALL BE ADA COMPLIANT AND CONSTRUCTED PER CITY DETAILS.

**PAVING PLAN**

DATE: OCTOBER 27, 2011  
 DESIGN: KHA  
 DRAWN: KHA  
 CHECKED: KHA  
 KHA NO.: 06-4-362003  
 CITY NO.:  
 SHEET  
**C4a**