


10/27/11
2/16/12

3. ADDED 8" CONCRETE, REVISED DRIVEWAY AND ADDED BARRIER FREE RAMP

4. REVISED PARALLEL PARKING AND SIDEWALK

Kimley-Horn and Associates, Inc.	
2700 W. Central Expressway, Suite 900 Austin, TX 78758-9898 Tel: 512-426-1100	Date:
Revision	8/26/11
1. REVISED DRIVE APPROACH SPEC	9/14/11
2. ADDED SIDEWALK REFERENCE AND REVISED FIRE LANE	

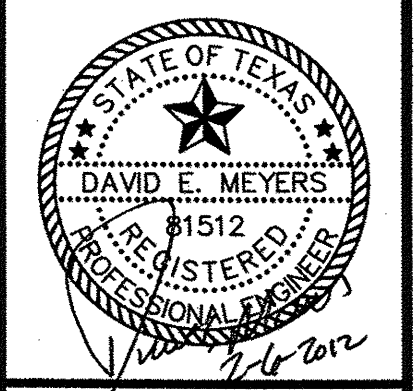

Keller Springs Lofts Loft Apartments in Addison, Texas

LEGEND	
	6" 4200 PSI REINFORCED CONCRETE PAVEMENT ON 6" LIME STABILIZED SUBGRADE, 28 LBS/SY COMPACTED TO A MINIMUM 95% STANDARD PROCTOR DENSITY AT 0% TO 3% OF OPTIMUM MOISTURE.
	8" 4500 PSI REINFORCED CONCRETE PAVEMENT ON 6" LIME STABILIZED SUBGRADE, 28 LBS/SY COMPACTED TO A MINIMUM 95% STANDARD PROCTOR DENSITY AT 0% TO 3% OF OPTIMUM MOISTURE.
	PROPOSED SIDEWALK REFER TO LANDSCAPE PLAN FOR LOCATION AND DETAILS

BENCH MARKS:	
BMS	SQUARE CUT ON INLET, SOUTHWEST CORNER OF RATLIFF LANE AND ADDISON ROAD. ELEVATION 637.20
BMB	SQUARE CUT ON INLET, SOUTHWEST CORNER OF AIRPORT PKWY. AND QUORUM DRIVE. ELEVATION 631.15
BMI	BRASS DISK FOUND AT NORTHWEST CORNER OF INLET, SOUTHWEST CORNER OF KELLER SPRINGS AND ADDISON ROAD. ELEVATION 638.91

- NOTES:**
- REFER TO DIMENSION CONTROL PLAN FOR PAVING DIMENSIONS AND CENTERLINE CONTROL.
 - REFERENCE GENERAL NOTES FOR ADDITIONAL PLAN NOTES.
 - BARRIER FREE RAMPS AND SIDEWALKS SHALL BE ADA COMPLIANT AND CONSTRUCTED PER CITY DETAILS.

PAVING PLAN

DATE: FEBRUARY 6, 2012	DESIGN: KHA	DRAWN: KHA	CHECKED: KHA	KHA NO.: 064362003	CITY NO.:
------------------------	-------------	------------	--------------	--------------------	-----------

SHEET
C4a