


10/27/11	ADDED 6" CONCRETE REVISED DRIVEWAY AND ADDED BARRIER FREE RAMP
2/6/12	REVISED PARALLEL PARKING AND SIDEWALK
3/27/13	ADDED PARKING AND RETAINING WALL
4/18/13	REVISED PARKING

Kimley-Horn and Associates, Inc.
 2700 West Central Expressway, Suite 600
 Dallas, TX 75201-6198
 Phone: 972-770-8000
 Fax: 972-770-8000

Date: 8/26/11
 Revised Drive Approach Spec
 Date: 9/14/11
 Revised Sidewalk Reference
 Date: 3/27/13
 And Revised Fire Lane
 Date: 4/18/13

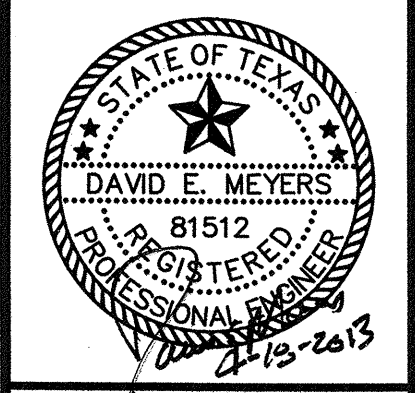

Keller Springs Lofts

Loft Apartments in Addison

Town of Addison, Texas

LEGEND

[Pattern]	6" 4200 PSI REINFORCED CONCRETE PAVEMENT ON 6" LIME STABILIZED SUBGRADE, 28 LB/SSY COMPACTED TO A MINIMUM 95% STANDARD PROCTOR DENSITY AT 0% TO 3% OF OPTIMUM MOISTURE.
[Pattern]	8" 4500 PSI REINFORCED CONCRETE PAVEMENT ON 6" LIME STABILIZED SUBGRADE, 28 LB/SSY COMPACTED TO A MINIMUM 95% STANDARD PROCTOR DENSITY AT 0% TO 3% OF OPTIMUM MOISTURE.
[Pattern]	PROPOSED SIDEWALK REFER TO LANDSCAPE PLAN FOR LOCATION AND DETAILS
[Pattern]	7" 4200 PSI REINFORCED CONCRETE PAVEMENT ON A COMPACTED SUB GRADE AT A MINIMUM OF 95% STANDARD PROCTOR DENSITY AT 0% TO 3% OF OPTIMUM MOISTURE.

BENCH MARKS:

BM5	SQUARE CUT ON INLET, SOUTHWEST CORNER OF RATLIFF LANE AND ADDISON ROAD. ELEVATION 637.20
BM8	SQUARE CUT ON INLET, SOUTHWEST CORNER OF AIRPORT PKWY. AND QUORUM DRIVE. ELEVATION 631.15
BM1	BRASS DISK FOUND AT NORTHWEST CORNER OF INLET, SOUTHWEST CORNER OF KELLER SPRINGS AND ADDISON ROAD. ELEVATION 638.91

- NOTES:**
- REFER TO DIMENSION CONTROL PLAN FOR PAVING DIMENSIONS AND CENTERLINE CONTROL.
 - REFERENCE GENERAL NOTES FOR ADDITIONAL PLAN NOTES.
 - BARRIER FREE RAMPS AND SIDEWALKS SHALL BE ADA COMPLIANT AND CONSTRUCTED PER CITY DETAILS.

PAVING PLAN

DATE: FEBRUARY 28, 2013
 DESIGN: KHA
 DRAWN: KHA
 CHECKED: KHA
 KHA NO.: 064362003
 CITY NO.:

SHEET

C4a