

BENCH MARKS:


BMS SQUARE CUT ON INLET, SOUTHWEST CORNER OF RATLIFF LANE AND ADDISON ROAD.
ELEVATION 637.20

BM8 SQUARE CUT ON INLET, SOUTHWEST CORNER OF AIRPORT PKWY. AND QUORUM DRIVE.
ELEVATION 631.15

BM1 BRASS DISK FOUND AT NORTHWEST CORNER OF INLET, SOUTHWEST CORNER OF KELLER SPRINGS AND ADDISON ROAD.
ELEVATION 638.91

Kimley-Horn and Associates, Inc.
2700 Park Central Drive, Suite 900
Dallas, TX 75201
Phone: 972-770-5500
Fax: 972-770-5501

No.	Revision	Date

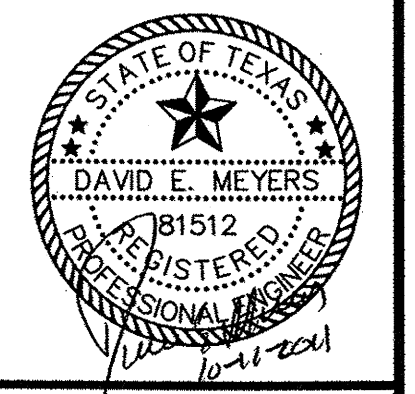

Keller Springs Lofts
Loft Apartments in Addison
Town of Addison, Texas

TREE DRAIN PLAN

DATE: OCTOBER 11, 2011
DESIGN: KHA
DRAWN: KHA
CHECKED: KHA
KHA NO.: 064362003
CITY NO.:

SHEET

C8a