


Kimley-Horn  
and Associates, Inc.

2700 Park Central Drive, Suite 800  
Dallas, TX 75245-8888  
Phone: 972-770-8800  
Fax: 972-770-8888

No. \_\_\_\_\_  
Revision \_\_\_\_\_  
Date \_\_\_\_\_

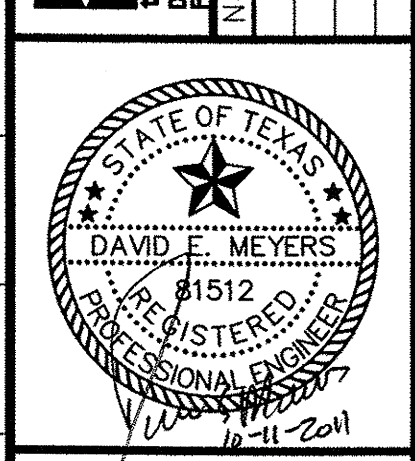

**Keller Springs Lofts  
Loft Apartments in Addison**  
Town of Addison, Texas

**STORM SEWER PROFILES**

DATE: OCTOBER 11, 2011
DESIGN: KHA
DRAWN: KHA
CHECKED: KHA
KHA NO.: 064-362003
CITY NO.: