


STORM SEWER — GENERAL NOTES:

1. ALL CONCRETE DRAINAGE STRUCTURES SHALL BE CLASS C CONCRETE MINIMUM.
2. ALL CRUSHED STONE SHALL BE 3/4", PASSING #4 SIEVE (GRADE 4).
3. ALL FIELD JOINTS WILL BE APPROVED BY THE TOWN ENGINEER IF NECESSARY. FIELD JOINTS SHALL BE WIPED ON THE INSIDE AND OUTSIDE TO PROVIDE FOR SMOOTH FLOW OF WATER.
4. RAMNECK COMPOUND OR APPROVED EQUAL SHALL BE USED FOR JOINT SEALS.
5. ALL STORM SEWER PIPE SHALL BE CAMERA INSPECTED AFTER THE INSTALLATION OF ALL PAVING AND UTILITIES AND PRIOR TO FINAL ACCEPTANCE OF THE PROJECT.

Addison!
PUBLIC WORKS DEPARTMENT

STORM SEWER
GENERAL NOTES


STANDARD CONSTRUCTION DETAILS STORM DRAINAGE		
DATE:	REV. DATE:	SHEET:
AUGUST, 2010	-	SD-001

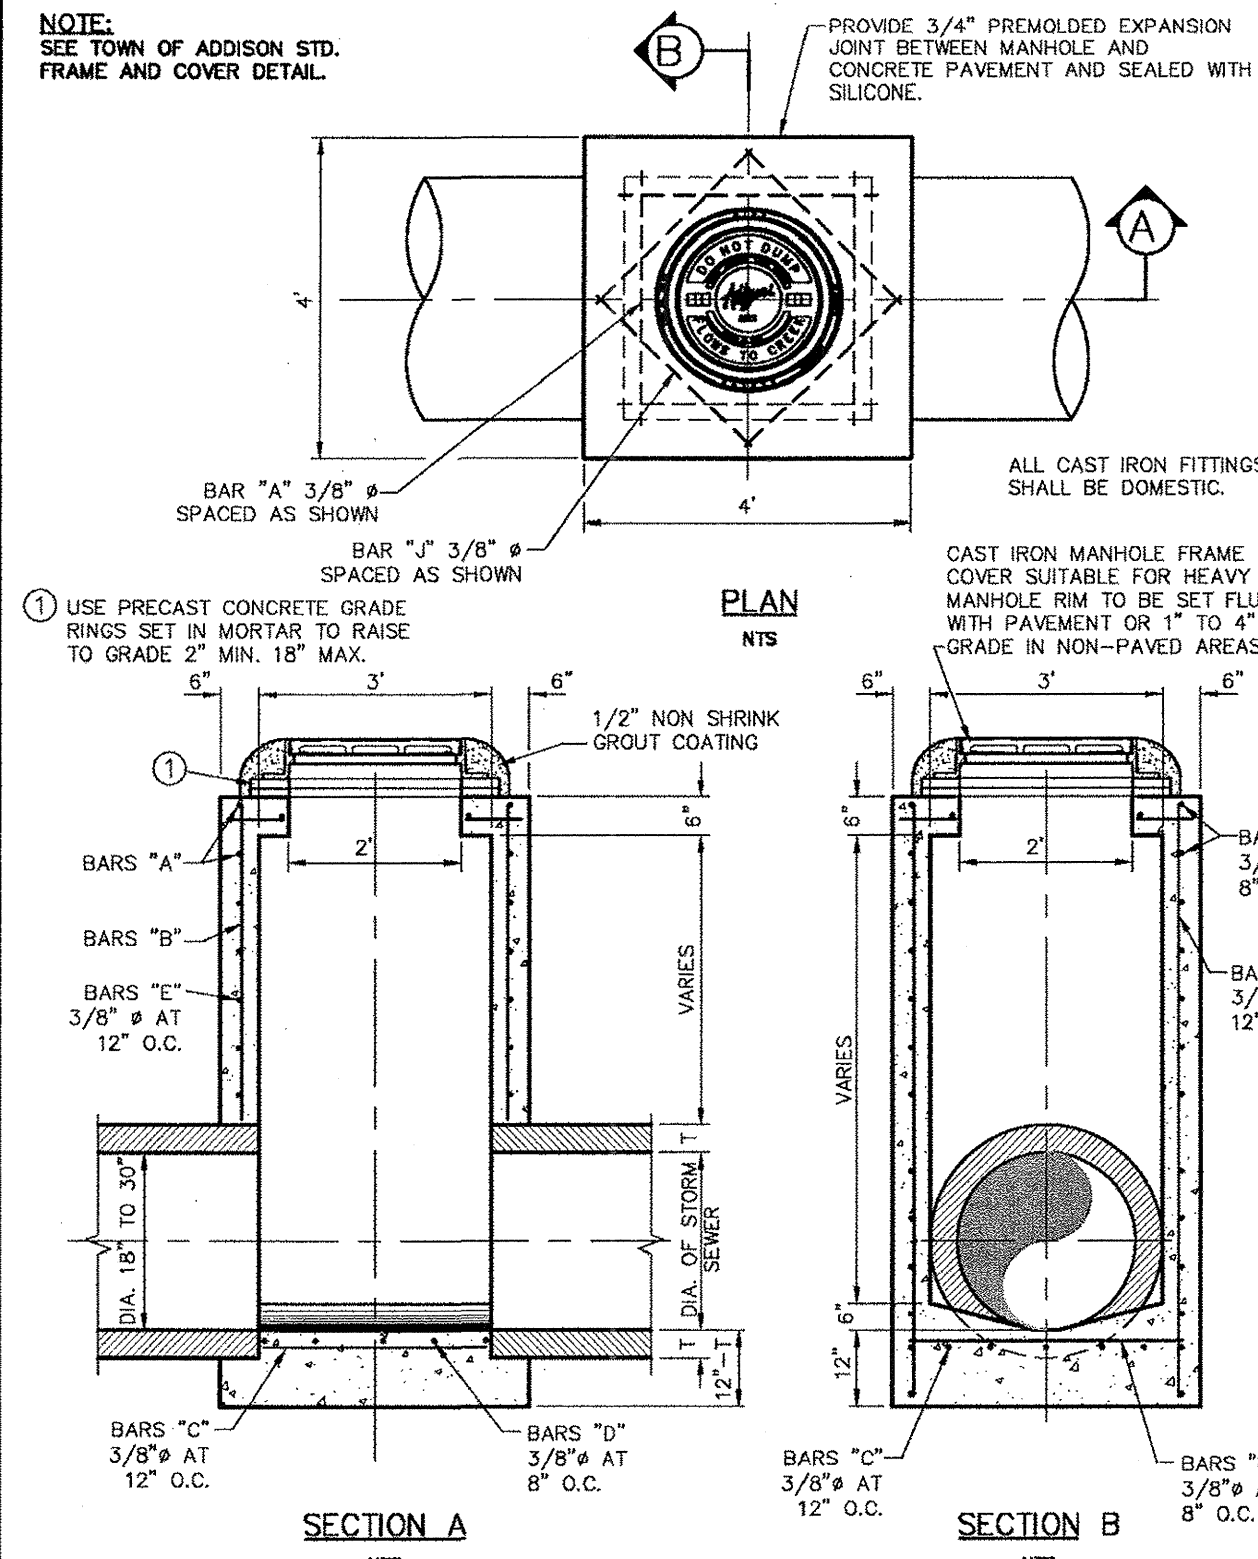

Addison!
PUBLIC WORKS DEPARTMENT

TYPE "A" STORM SEWER
MANHOLE
(FOR 18" TO 30" RCP)


STANDARD CONSTRUCTION DETAILS STORM DRAINAGE		
DATE:	REV. DATE:	SHEET:
AUGUST, 2010	-	SD-008

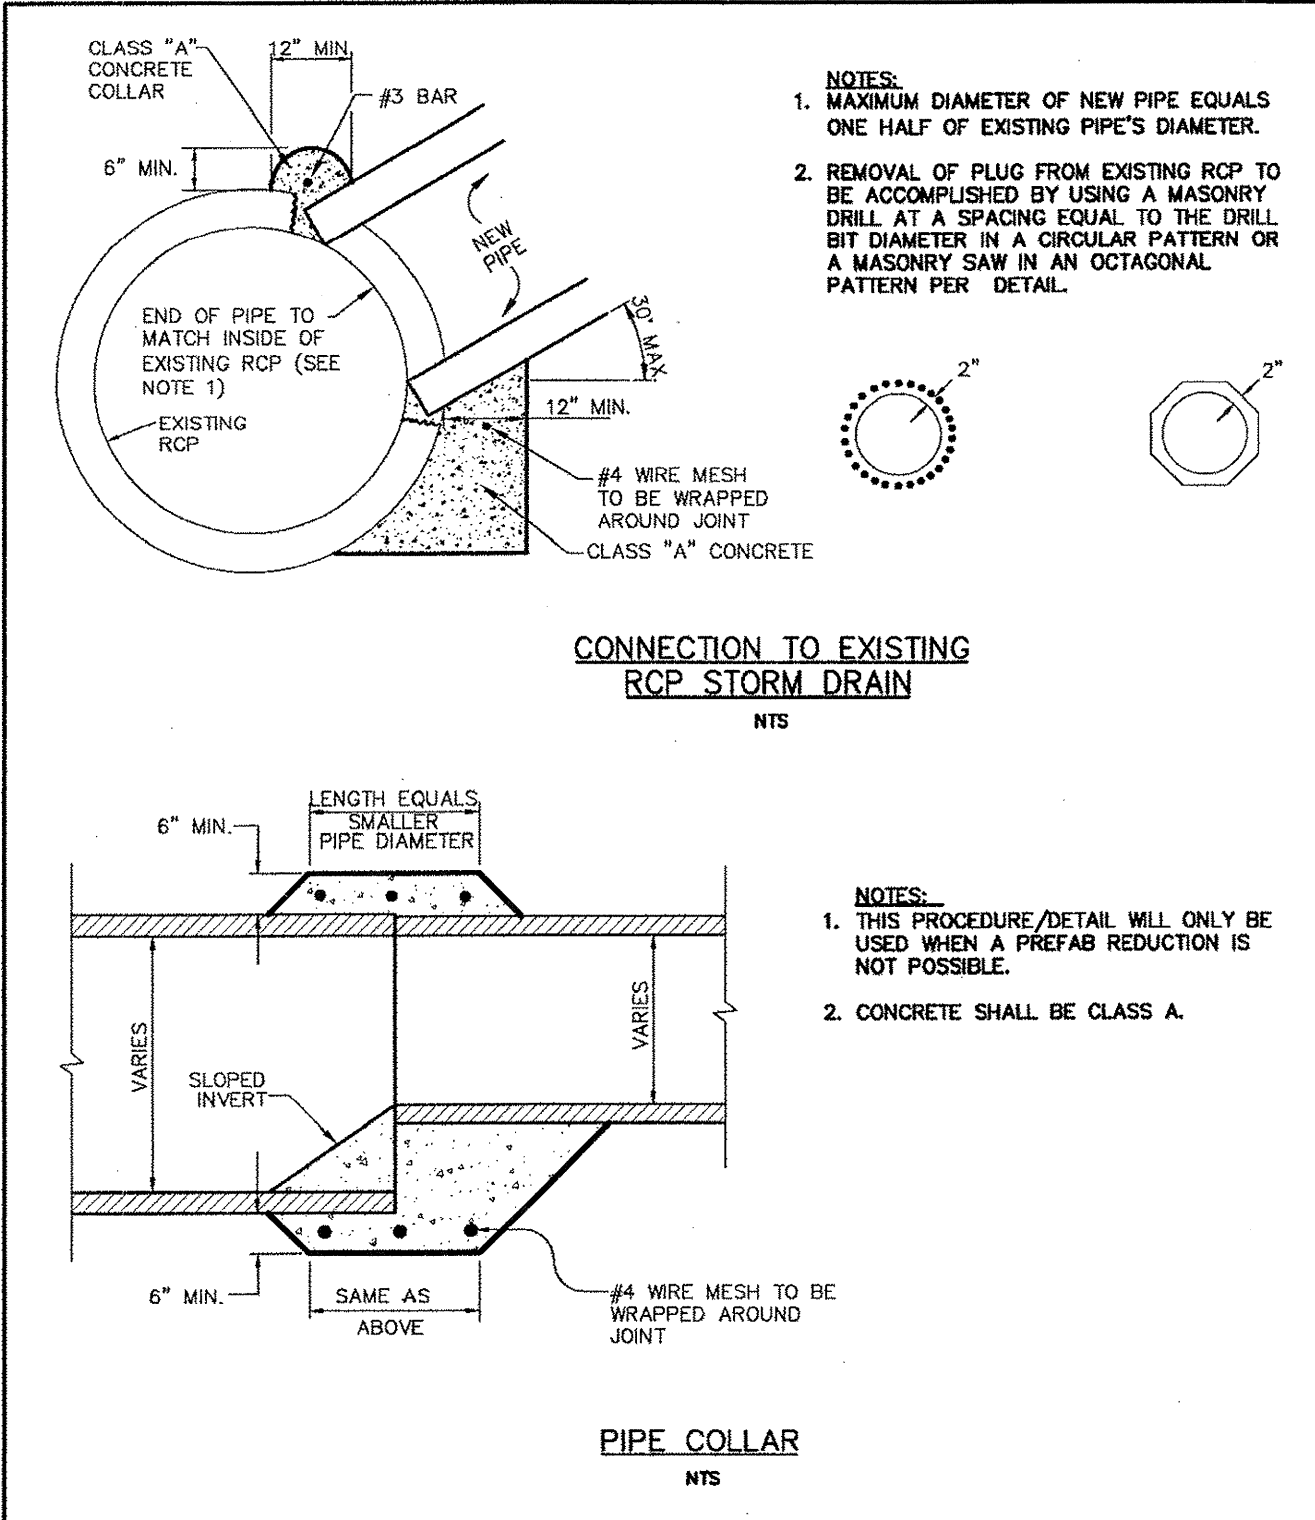

Addison!
PUBLIC WORKS DEPARTMENT

CONNECTION TO EXISTING
RCP STORM DRAIN
PIPE COLLAR


STANDARD CONSTRUCTION DETAILS STORM DRAINAGE		
DATE:	REV. DATE:	SHEET:
AUGUST, 2010	-	SD-005

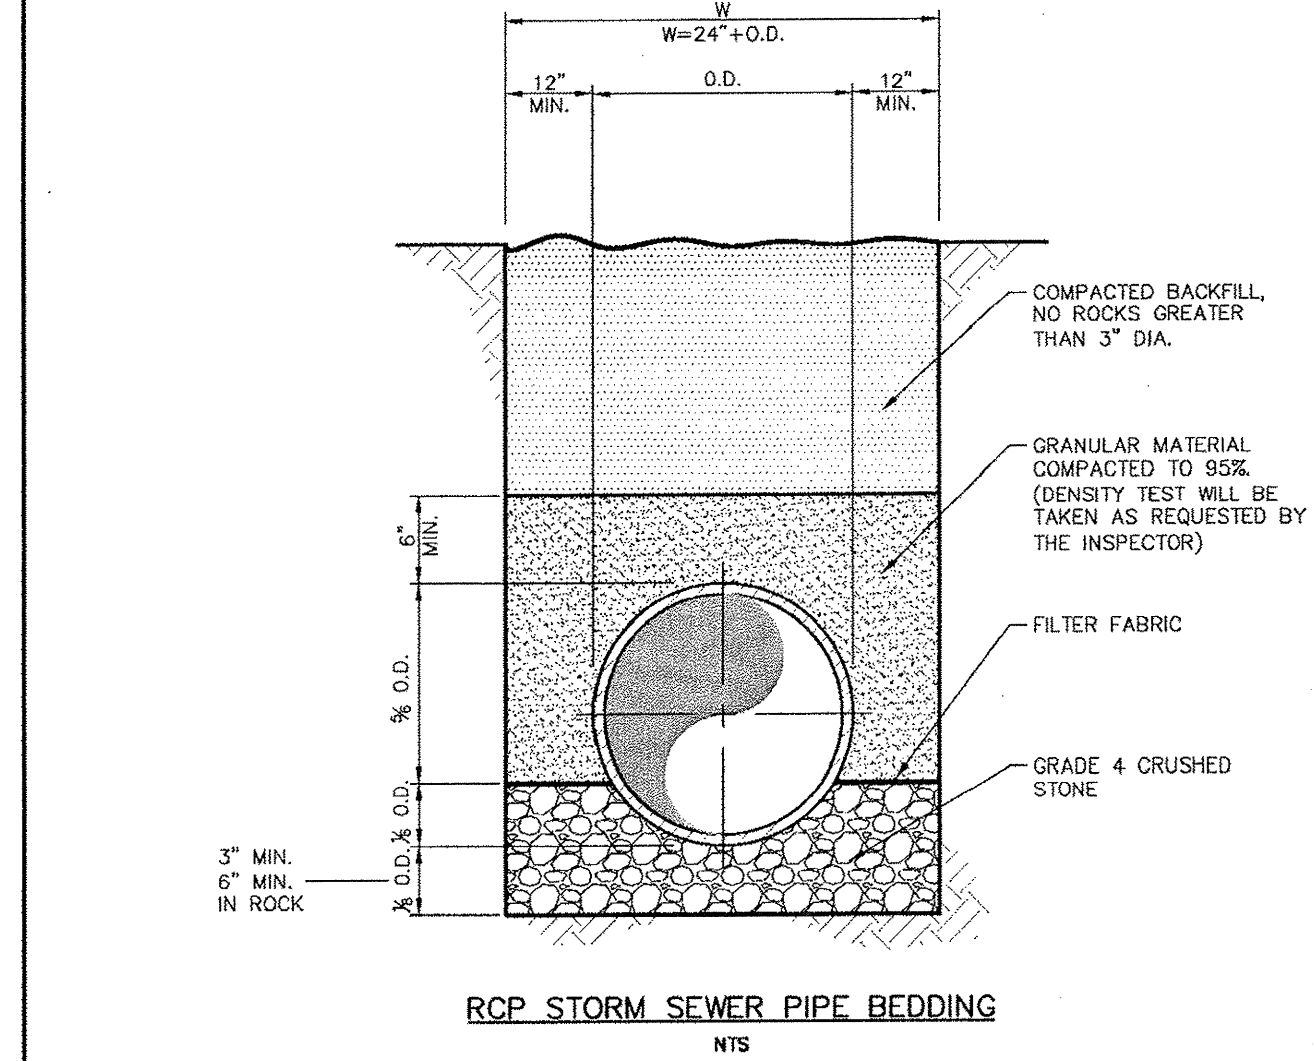

Addison!
PUBLIC WORKS DEPARTMENT

RCP STORM SEWER
PIPE BEDDING


STANDARD CONSTRUCTION DETAILS STORM DRAINAGE		
DATE:	REV. DATE:	SHEET:
AUGUST, 2010	-	SD-003

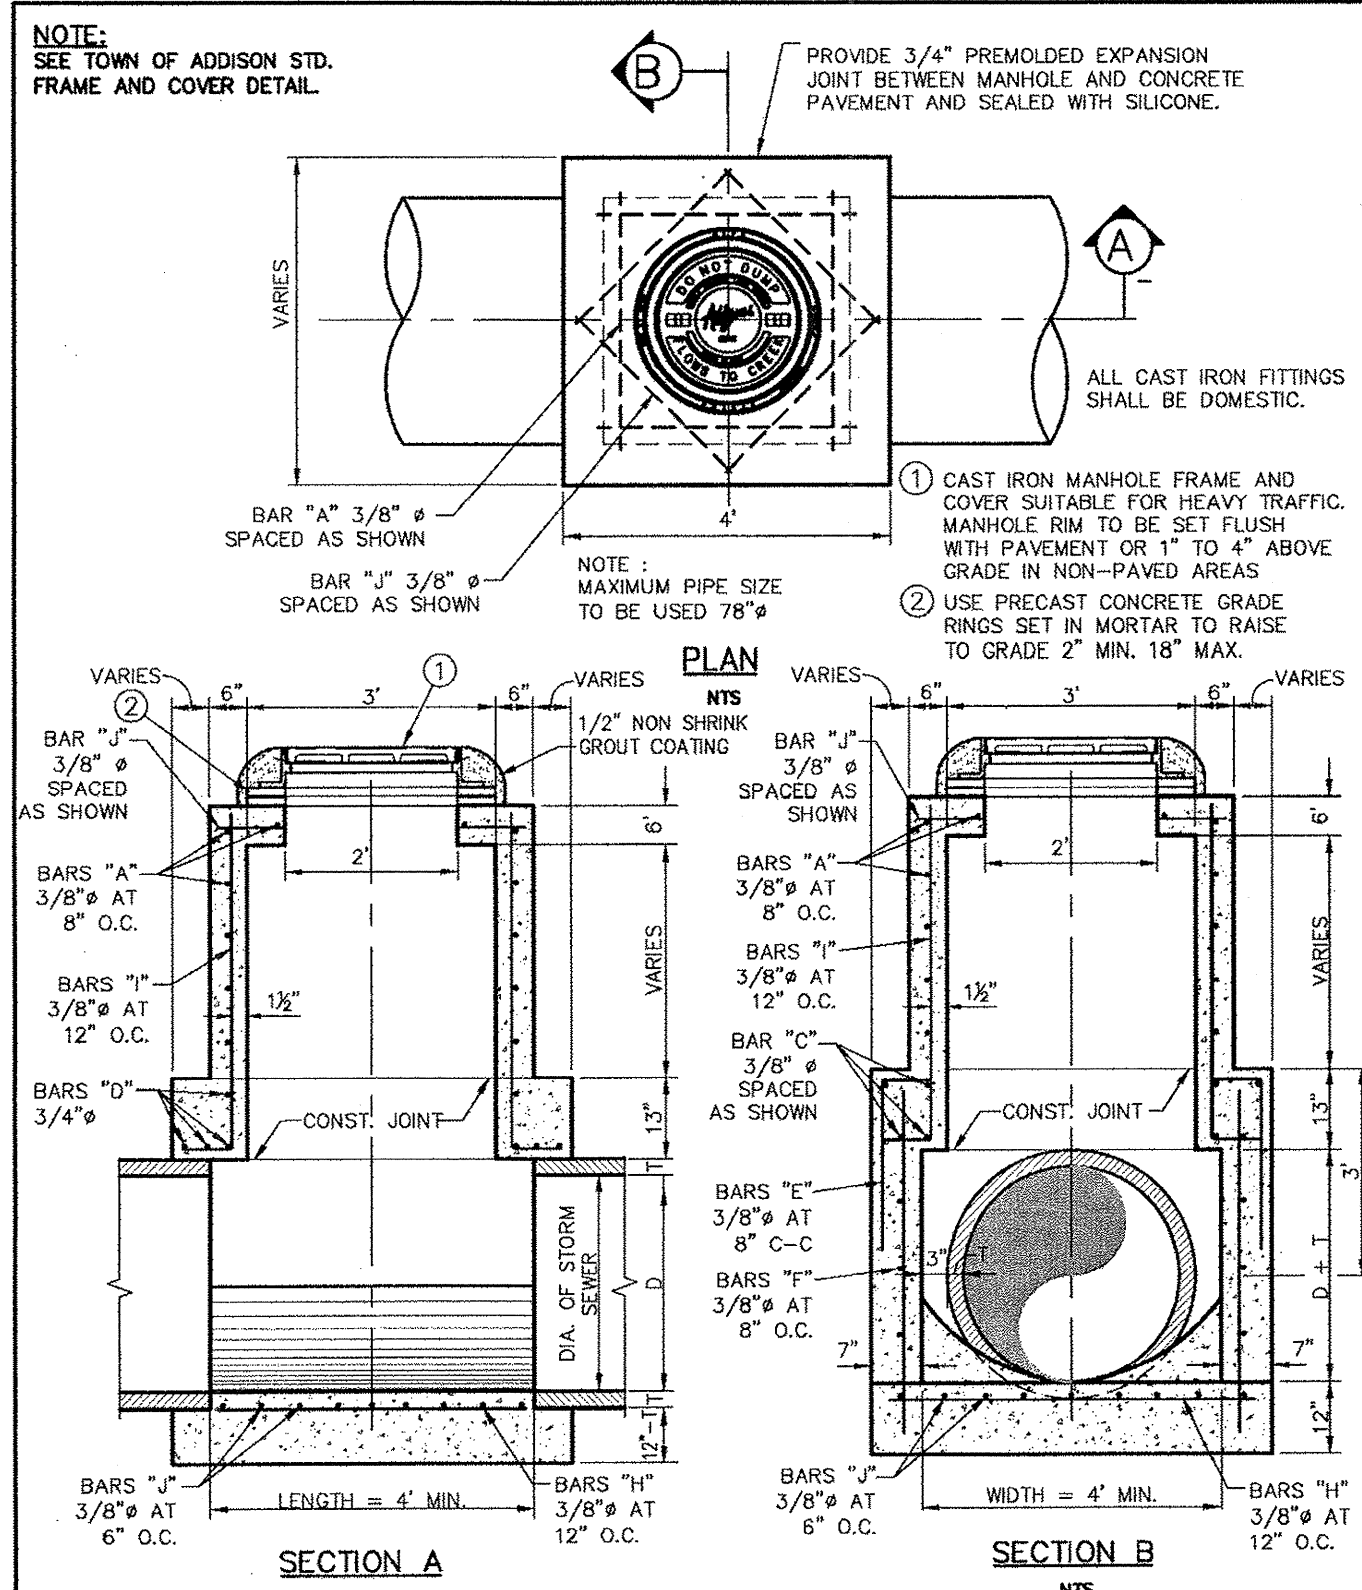

Addison!
PUBLIC WORKS DEPARTMENT

TYPE "B" STORM SEWER
MANHOLE
(FOR 33" TO 78" RCP)


STANDARD CONSTRUCTION DETAILS STORM DRAINAGE		
DATE:	REV. DATE:	SHEET:
AUGUST, 2010	-	SD-007

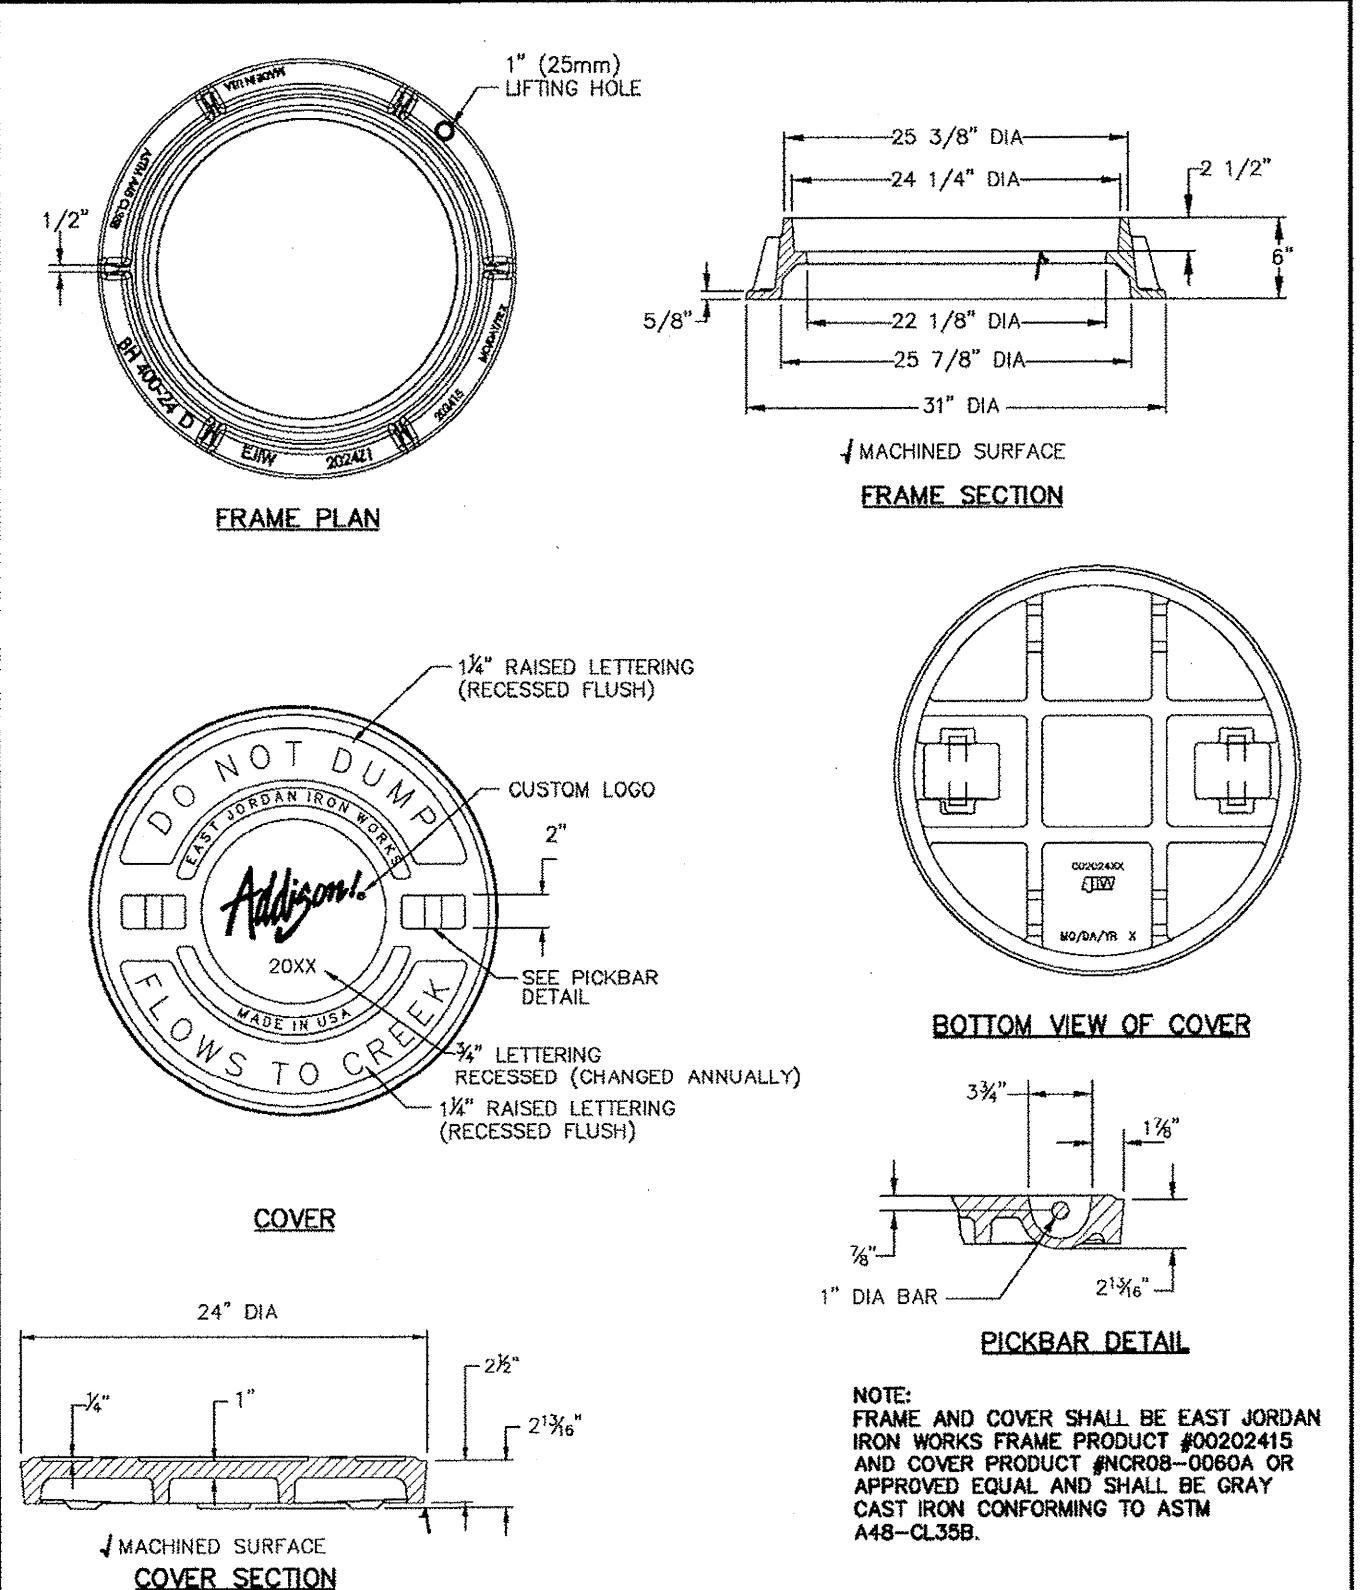

Addison!
PUBLIC WORKS DEPARTMENT

STORM MANHOLE
FRAME & COVER


STANDARD CONSTRUCTION DETAILS STORM DRAINAGE		
DATE:	REV. DATE:	SHEET:
AUGUST, 2010	-	SD-008

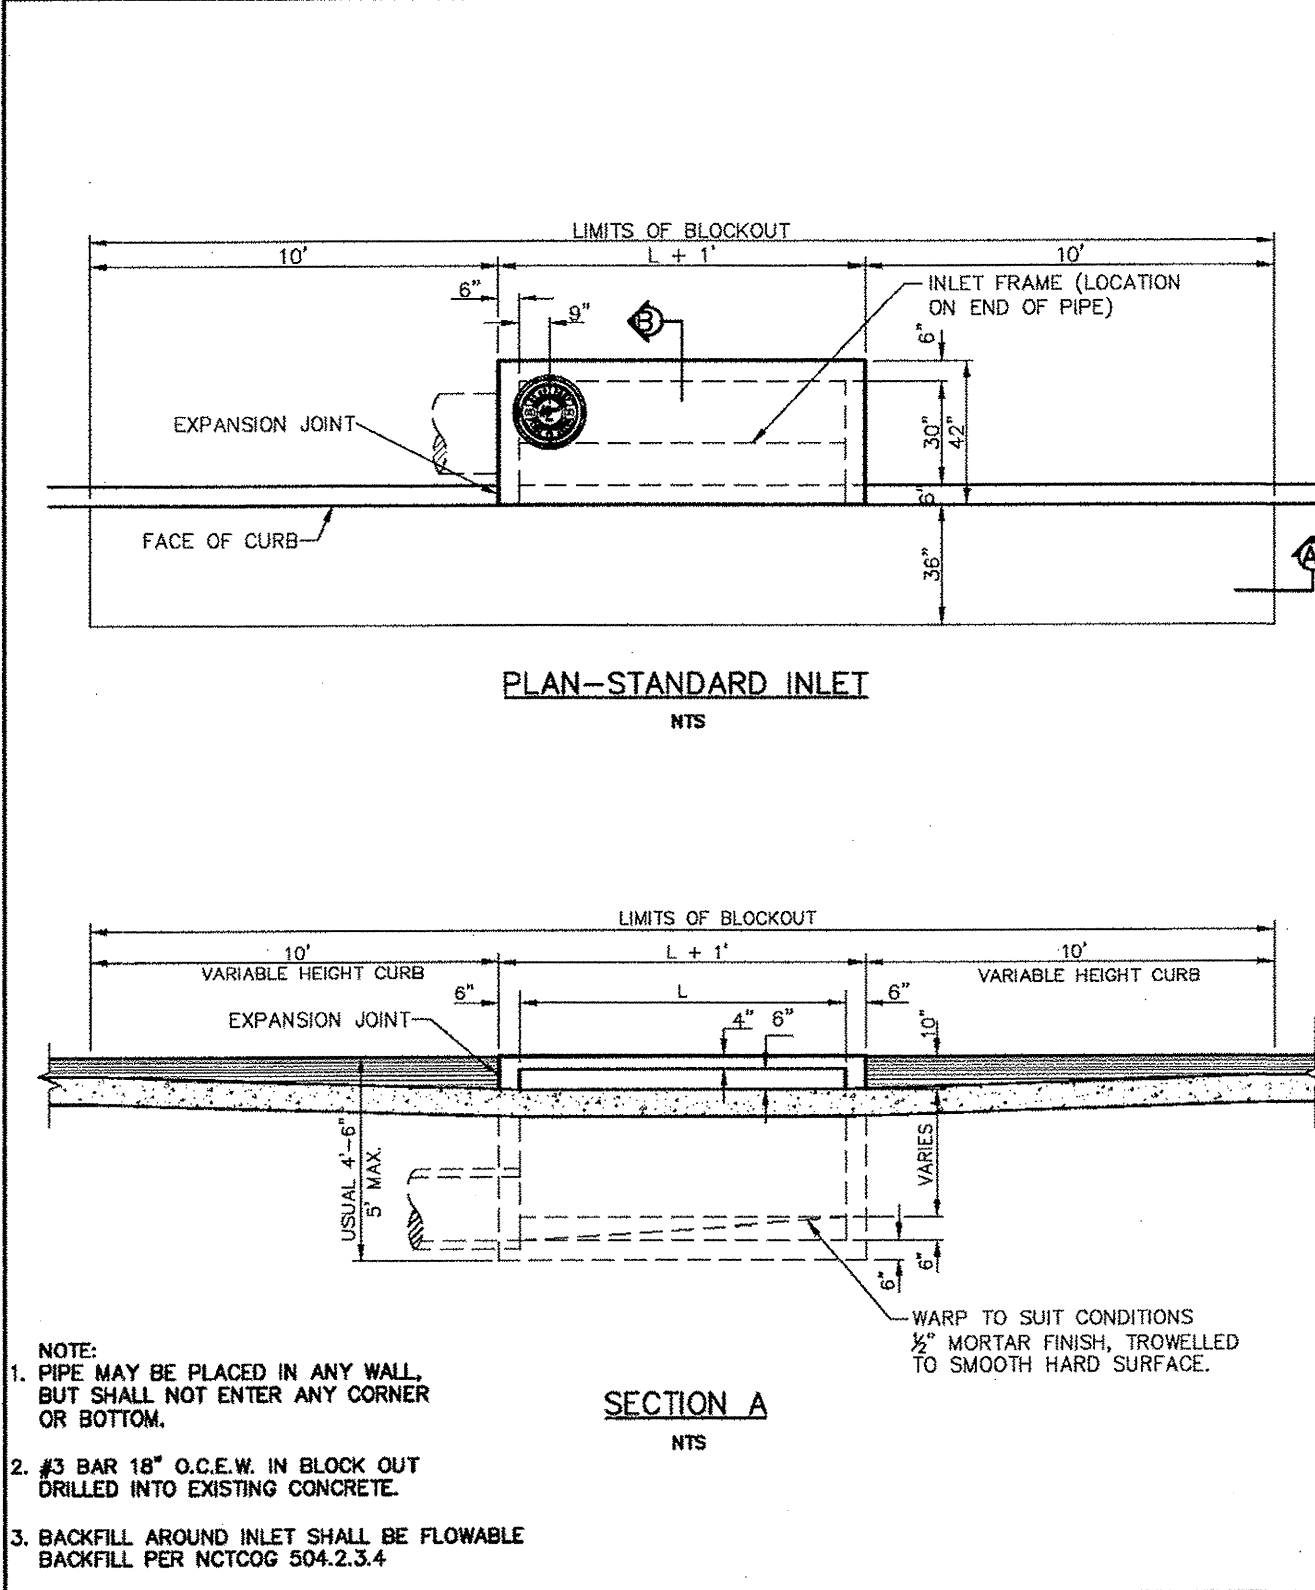

Addison!
PUBLIC WORKS DEPARTMENT

STANDARD CURB INLET

STANDARD CONSTRUCTION DETAILS STORM DRAINAGE		
DATE:	REV. DATE:	SHEET:
AUGUST, 2010	-	SD-010

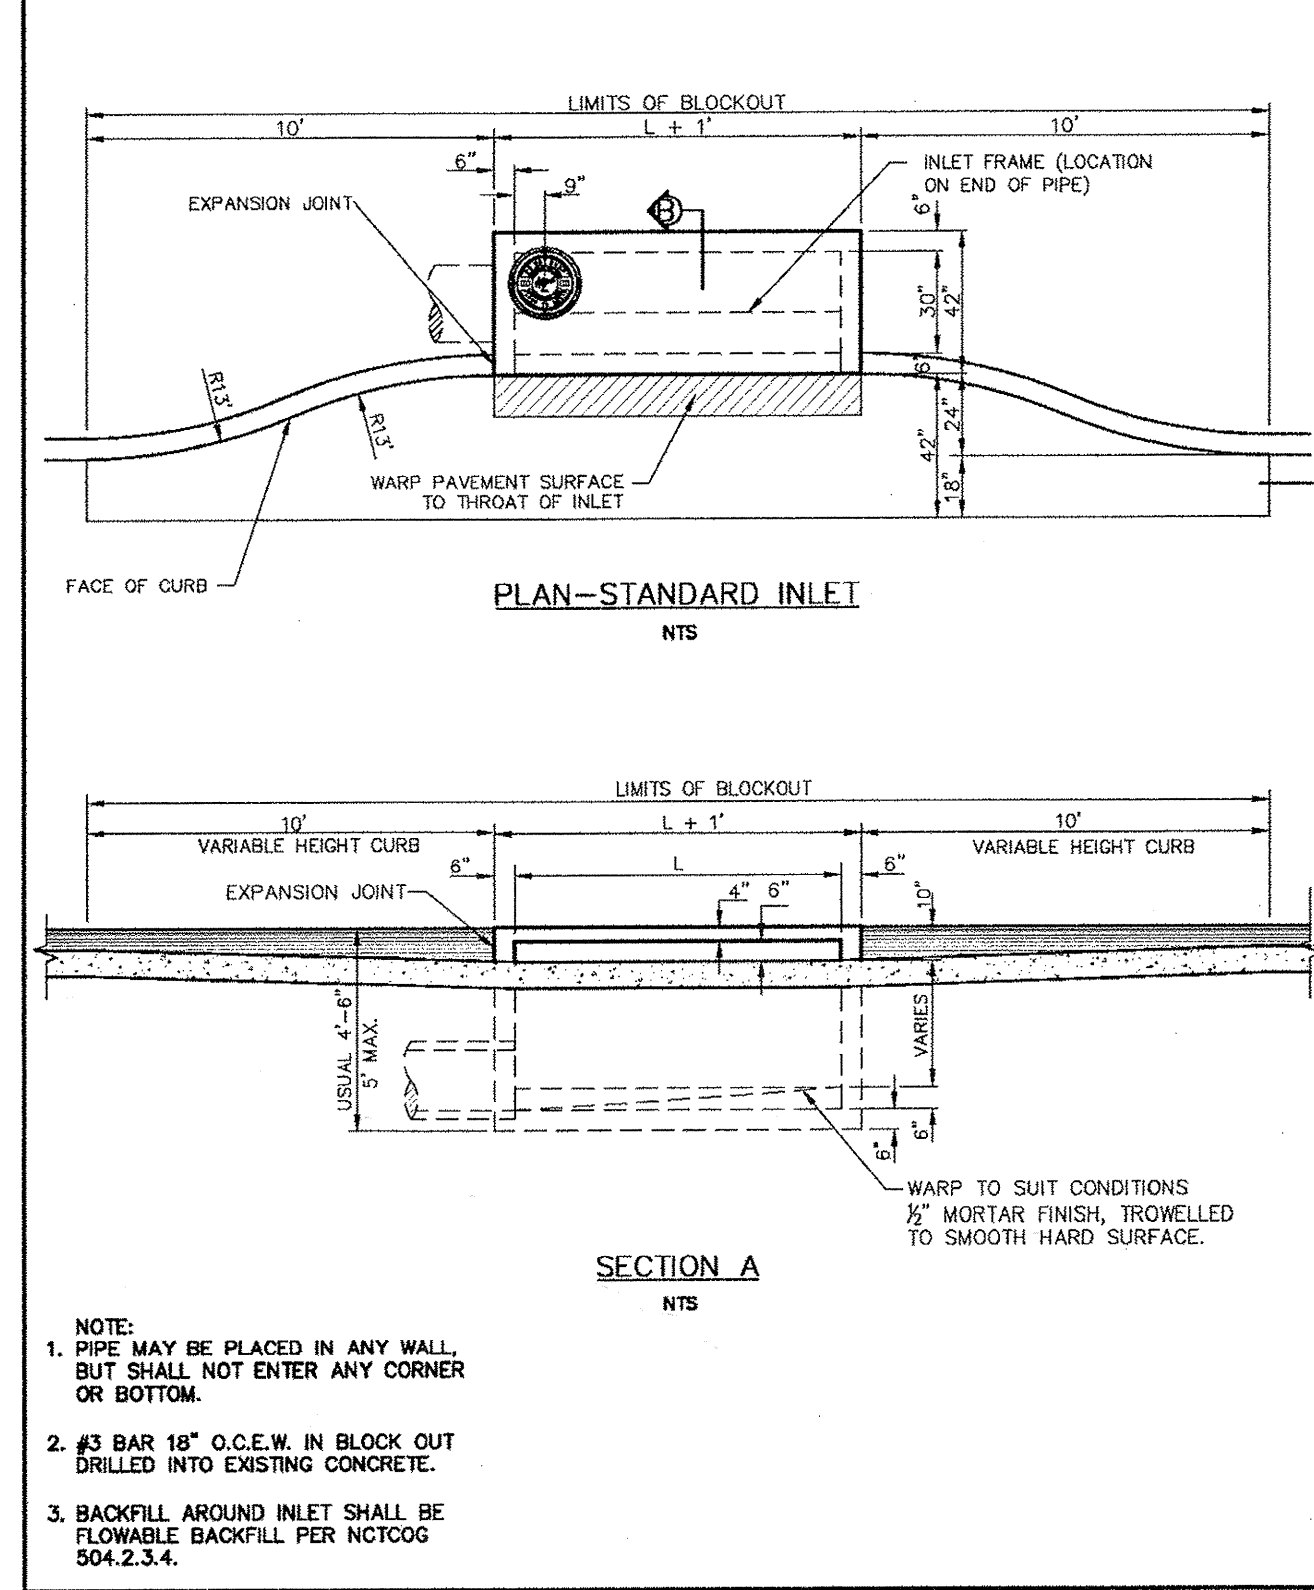

Addison!
PUBLIC WORKS DEPARTMENT

RECESSED CURB INLET

STANDARD CONSTRUCTION DETAILS STORM DRAINAGE		
DATE:	REV. DATE:	SHEET:
AUGUST, 2010	-	SD-011

Kimley-Horn and Associates, Inc.
2700 Park Central Drive, Suite 300
Dallas, TX 75201-2808
Phone: 972-968-6770-70-900
Fax: 972-968-6770-900
Revision: 1
Date: 8/26/11
REVISED TOWN DETAILS

STATE OF TEXAS
DAVID E. MEYERS
REGISTERED PROFESSIONAL ENGINEER
No. 16111
Exp. 12/1/2014

Keller Springs Lofts
Loft Apartments in Addison
Town of Addison, Texas

STORM WATER DETAILS

DATE:	OCTOBER 11, 2011
DESIGN:	KHA
DRAWN:	KHA
CHECKED:	KHA
KHA NO.:	06-4362003
CITY NO.:	