



PLAN VIEW
SCALE 1/2" = 1'-0"
STA. 3+19.42 LN 'D'
STA. 0+00 LN 'A'


NOTE: ONLY THE ADDITIONAL SLAB REINFORCEMENT AROUND 4' DIA M.H. AND MAIN WALL REINFORCEMENT ARE SHOWN IN THIS VIEW. SEE SECTIONS FOR TYPICAL SLAB AND WALL REINFORCEMENT.

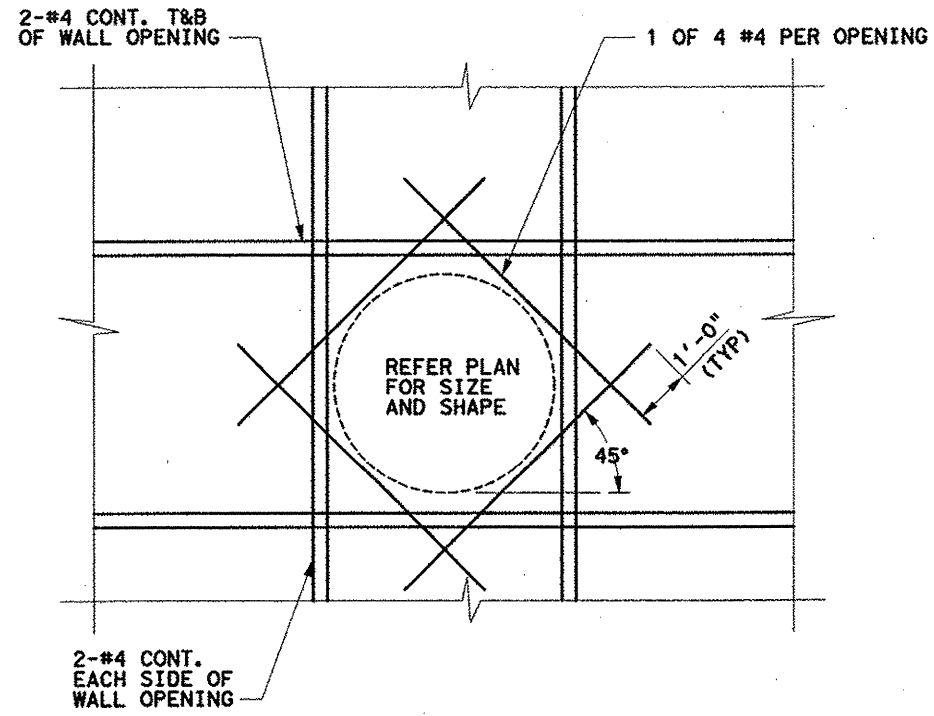

DETAIL OF ADDITIONAL REINFORCEMENT AT TYPICAL WALL PENETRATION
N.T.S.

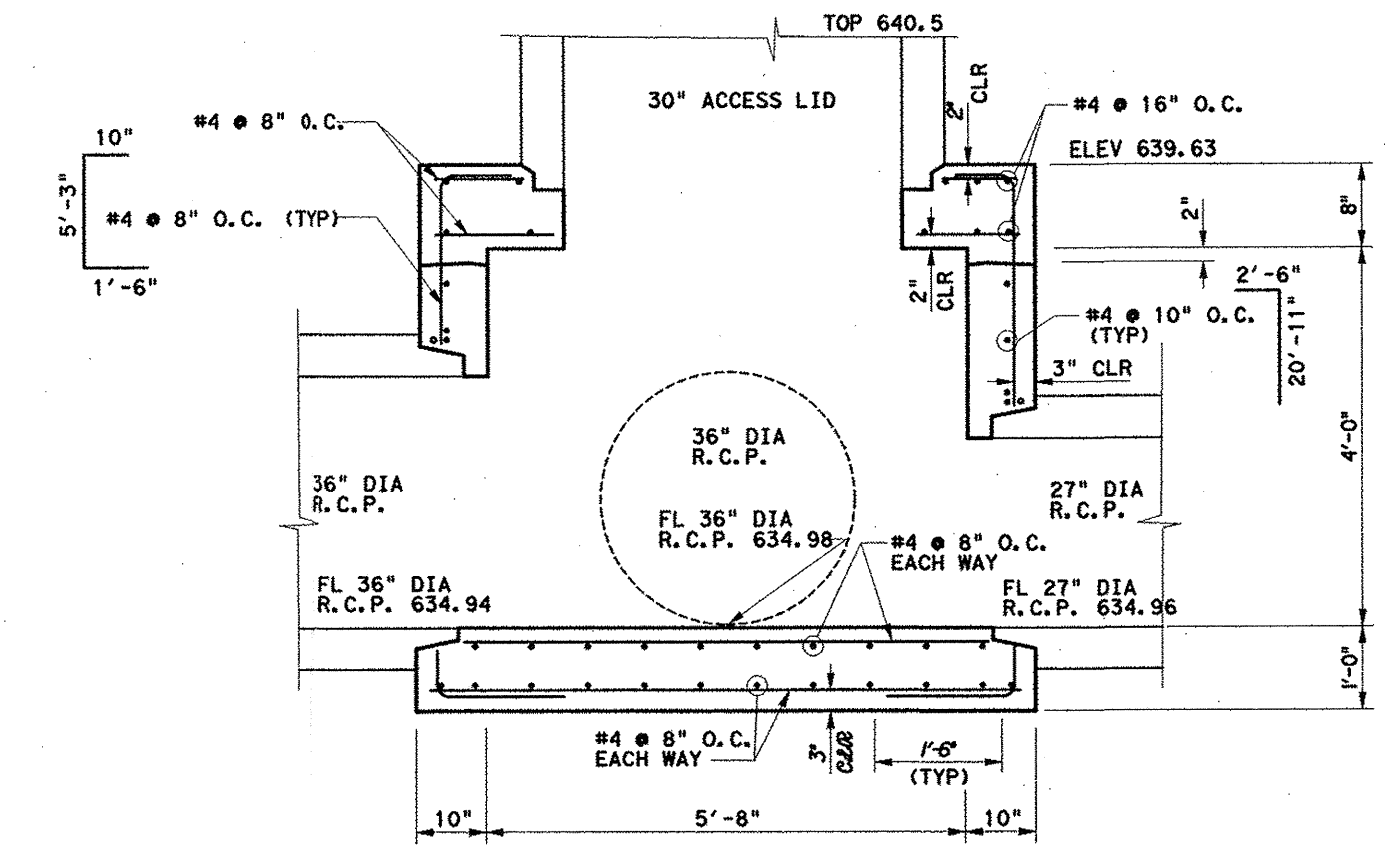

SECTION A-A
SCALE: NTS
STA. 3+19.42 LN 'D'
STA. 0+00 LN 'A'

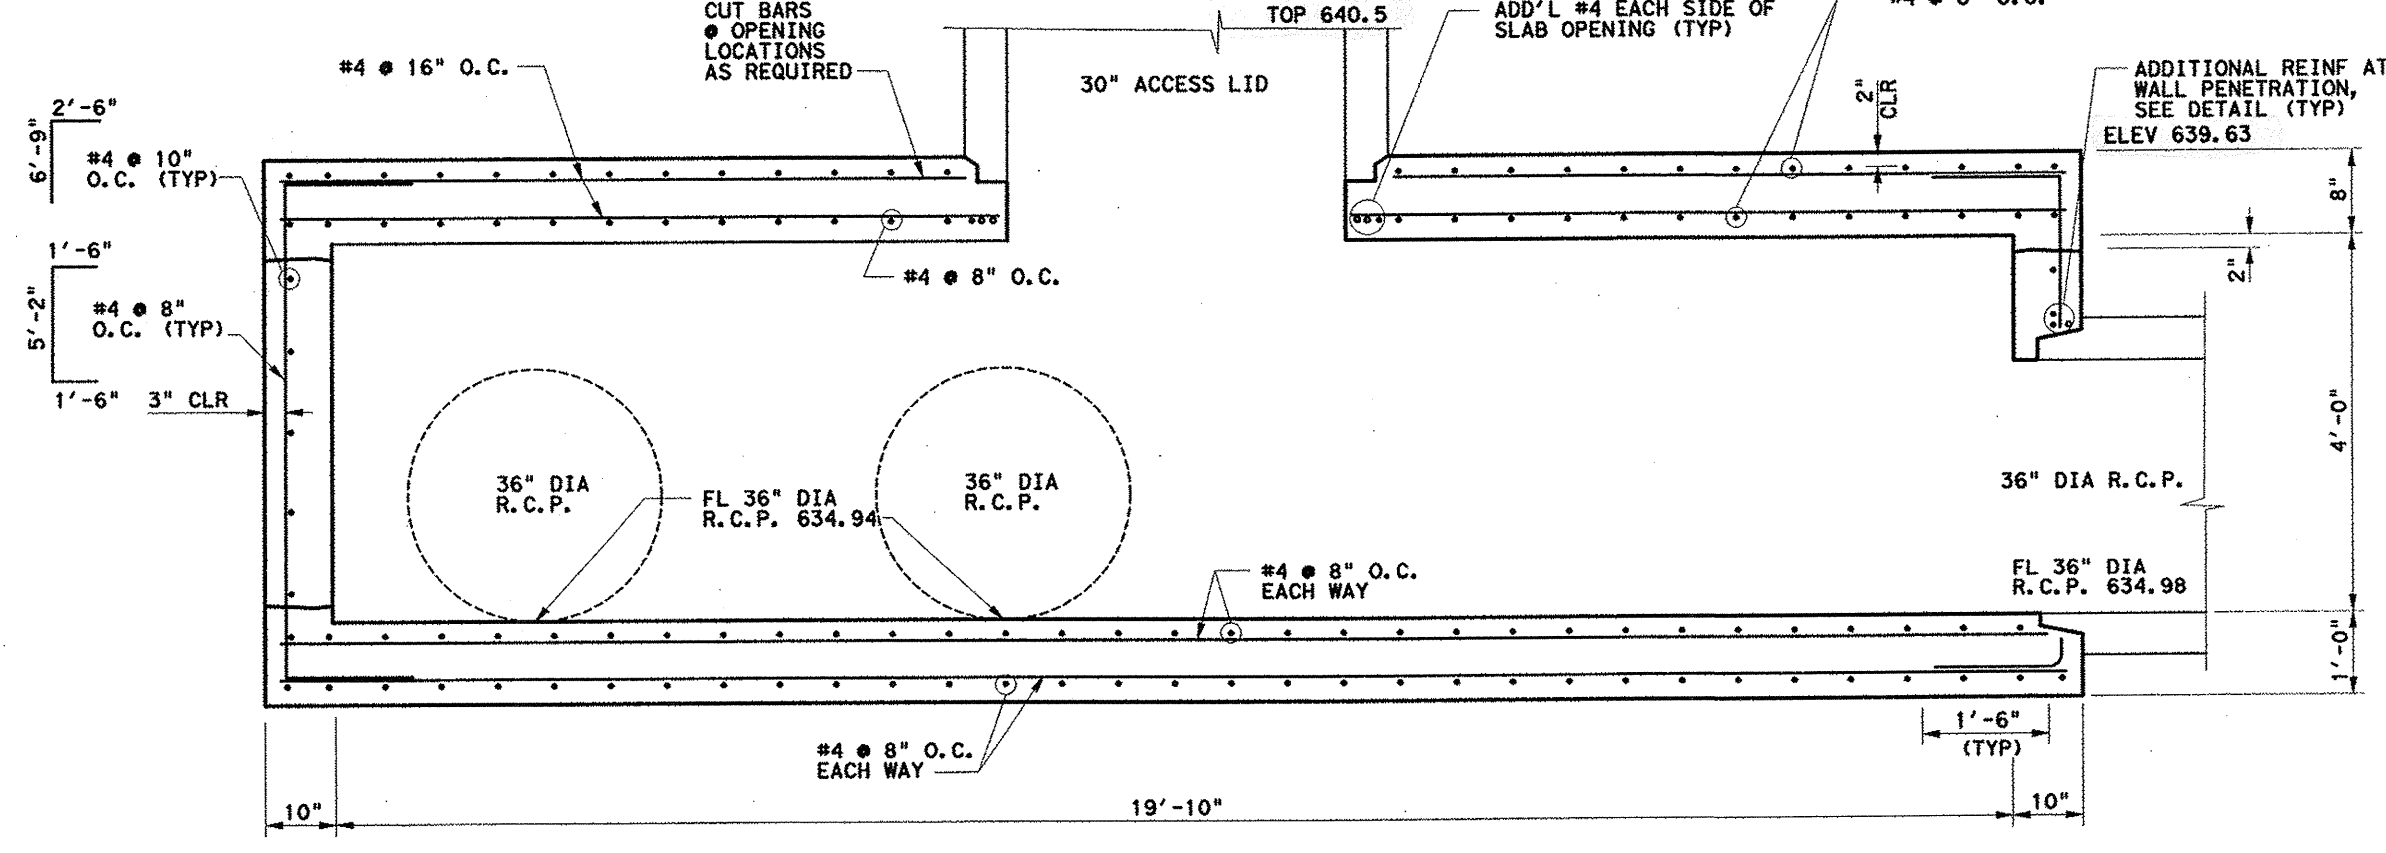

SECTION B-B
SCALE: NTS
STA. 3+19.42 LN 'D'
STA. 0+00 LN 'A'

NOTE: SEE SHEET C15 FOR GENERAL NOTES.

Kimley-Horn and Associates, Inc.
5700 Park Loop West, Suite 900
Dallas, Texas 75241
Phone: 972-770-8800
Fax: 972-770-8801
Date: 11/17/11
Revision: 1
No. 1 REVISED STRUCTURE DIMENSIONS



Keller Springs Lofts
Loft Apartments in Addison
Town of Addison, Texas

JUNCTION STRUCTURE DETAILS

DATE: NOVEMBER 17, 2011
DESIGN: KHA
DRAWN: KHA
CHECKED: KHA
KHA NO.: 064362003
CITY NO.:

SHEET
C18

