


10/27/11	ADDED 8" CONCRETE REVISED DRIVEWAY AND ADDED BARRIER FREE RAMP
2/6/12	REVISED PARALLEL PARKING AND SIDEWALK
3/27/13	ADDED PARKING AND RETAINING WALL
4/18/13	REVISED PARKING
5/29/13	REVISED PARKING

Revision	
1	REVISED DRIVE APPROACH SPEC
2	ADDED SIDEWALK REFERENCE AND REVISED FIRE LANE

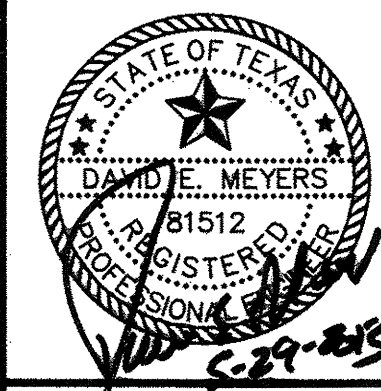

Keller Springs Lofts
Loft Apartments in Addison
Town of Addison, Texas

PAVING PLAN

DATE:	FEBRUARY 28, 2013
DESIGN:	KHA
DRAWN:	KHA
CHECKED:	KHA
KHA NO.:	064362003
CITY NO.:	

SHEET
C4a

