

**BENCH MARKS:**


BMS  
5 SQUARE CUT ON INLET, SOUTHWEST CORNER OF RATLIFF LANE AND ADDISON ROAD.  
ELEVATION 637.20

BMB  
5 SQUARE CUT ON INLET, SOUTHWEST CORNER OF AIRPORT PKWY. AND QUORUM DRIVE.  
ELEVATION 631.15

BM1  
BRASS DISK FOUND AT NORTHWEST CORNER OF INLET, SOUTHWEST CORNER OF KELLER SPRINGS AND ADDISON ROAD.  
ELEVATION 638.91

**Kimley-Horn and Associates, Inc.**  
2700 Park Center Drive, Suite 800  
Dallas, TX 75238-9888  
Phone: 972-770-8800  
Fax: 972-770-8801  
www.kimley-horn.com

NO.	REVISION	DATE
1	REVISED TREE DRAIN	3/7/12

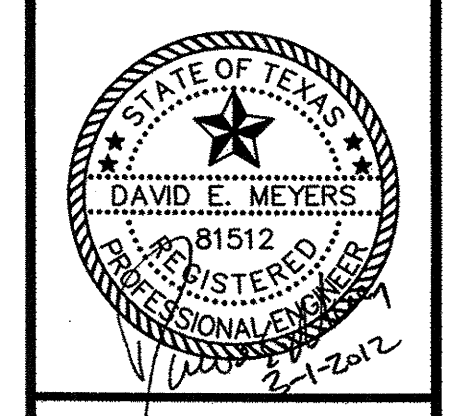

**Keller Springs Lofts**  
**Loft Apartments in Addison**  
Town of Addison, Texas

**TREE DRAIN PLAN**

DATE: MARCH 1, 2012  
DESIGN: KHA  
DRAWN: KHA  
CHECKED: KHA  
KHA NO.: 06-4362003  
CITY NO.:

SHEET  
**C8a**