

- 34 - MCB
- 400A MCB
- 600A MCB
- 800A MCB
- 1000A MCB
- 1200A MCB
- 1600A MCB
- 2000A MCB
- 34 - MLD
- 400A
- 600A
- 800A AL
- 800A CU
- 1600A
- 2000A

GENERAL NOTES:  
 #1 SHALL BE LATEST REVISION SHALL BE THE "Y".  
 #2 ALL DIMENSIONS UNLESS OTHERWISE NOTED TO THE CONTRARY ARE IN FEET AND INCHES.


GENERAL NOTES:  
 #1 SHALL BE LATEST REVISION SHALL BE THE "Y".  
 #2 ALL DIMENSIONS UNLESS OTHERWISE NOTED TO THE CONTRARY ARE IN FEET AND INCHES.

GENERAL NOTES:  
 #1 SHALL BE LATEST REVISION SHALL BE THE "Y".  
 #2 ALL DIMENSIONS UNLESS OTHERWISE NOTED TO THE CONTRARY ARE IN FEET AND INCHES.


GENERAL NOTES:  
 #1 SHALL BE LATEST REVISION SHALL BE THE "Y".  
 #2 ALL DIMENSIONS UNLESS OTHERWISE NOTED TO THE CONTRARY ARE IN FEET AND INCHES.

KEY NOTES:  
 (C) PROVIDE A SIGN FOR THE SIGNAGE, SECURE SIGNAGE TO LOBBY WALLS

GENERAL NOTES:  
 #1 SHALL BE LATEST REVISION SHALL BE THE "Y".  
 #2 ALL DIMENSIONS UNLESS OTHERWISE NOTED TO THE CONTRARY ARE IN FEET AND INCHES.

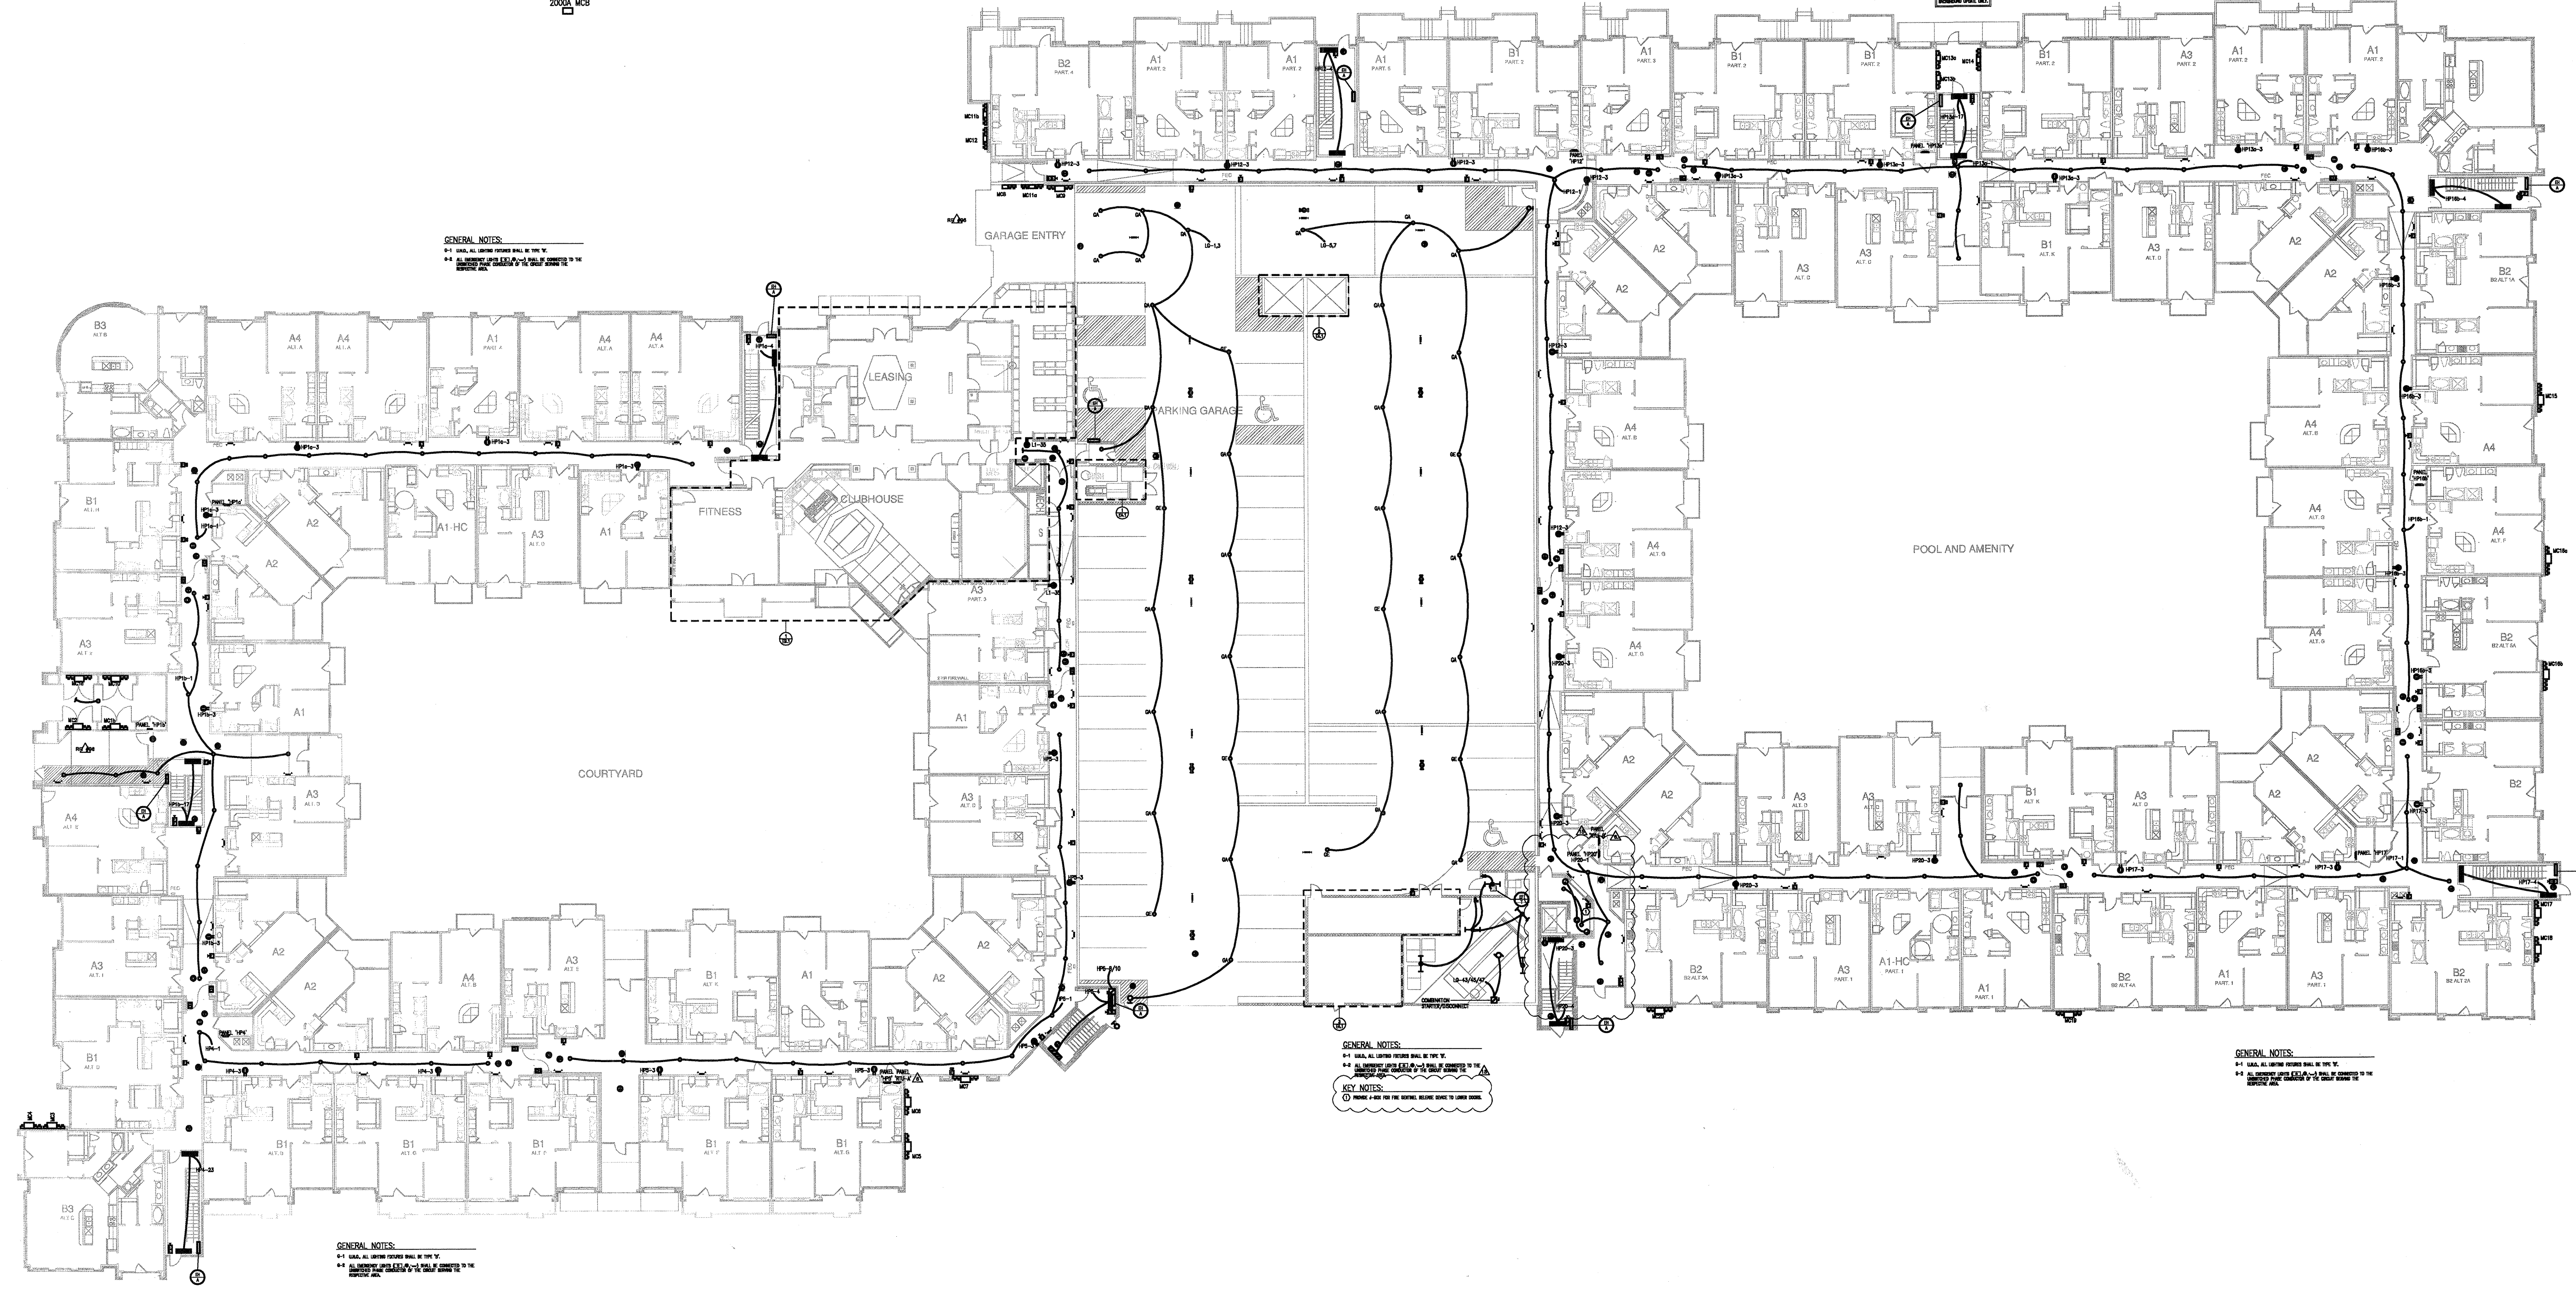

1 FLOOR PLAN - 3-1  
 SCALE: 1/32" = 1'-0"

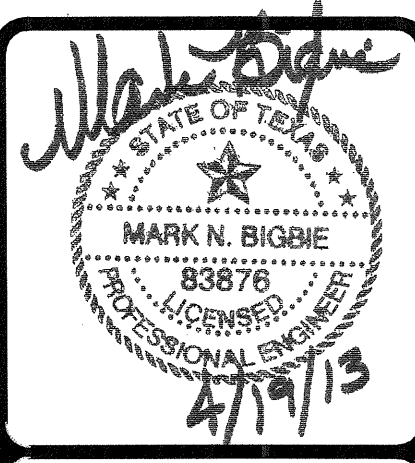

REVISIONS		
1	9-2-2011	DESIGN REVISIONS
2	9-13-2011	ANSI/FFHA COMMENTS
3	9-23-2011	DESIGN REVISIONS
4	10-17-2011	CONSTRUCTION ISSUE
5	12-21-2011	DESIGN REVISIONS
6	1-17-2012	DESIGN REVISIONS
7	2-15-2012	TRANSFORMER REVISIONS
8	3-27-2012	CLUBHOUSE REVISIONS
9	4-17-2012	COORDINATION

# KELLER SPRINGS LOFTS

LOFT APARTMENTS IN ADDISON, TEXAS

10	5-15-2012	COORDINATION
11	5-30-2012	SITE COORDINATION
12	6-01-12	LIGHTING REVISIONS
13	6-29-12	SITE COORDINATION
14	9-05-12	CLUB REVISIONS
15	4-19-13	EL. LOBBY REVISIONS

**BGO** architects  
 4144 N. Central Exp.  
 Suite 855  
 Dallas, TX 75204  
 214.520.8878  
 bgoarchitects.com

DATE  
 08-05-11

PROJECT  
 11129

SHEET NUMBER

**E-3.1**

**JSE** Jordan & Skala Engineers  
 17835 N. Dallas Parkway, Suite 320  
 Dallas, TX 75287-6827  
 V: (469) 385-1616 F: (469) 385-1615  
 Project Number - 113-0355 Texas Firm Registration # F-4990  
 Drawn By: MJ Checked By: RAD