

REVISIONS	
1	9-2-2011 DESIGN REVISIONS
2	9-13-2011 ANSI/FHA COMMENTS
3	9-23-2011 DESIGN REVISIONS
4	10-17-2011 CONSTRUCTION ISSUE

# KELLER SPRINGS LOFTS

LOFT APARTMENTS IN ADDISON, TEXAS


**BGO**  
architects  
4144 N. Central Expy.  
Suite 855  
Dallas, TX 75204  
214.520.8878  
bgoarchitects.com

DATE  
08-05-11

PROJECT  
11129

SHEET NUMBER  
**E-3.2**

**JSE** Jordan & Skala Engineers  
14250 Midway Road, Suite 350  
Dallas, TX 75244-9138  
Tel: (469) 383-1616 Fax: (469) 383-1615  
Project Number - 115-0555 Texas Firm Registration # F-4990  
Drawn By: MJ Checked By: RAD

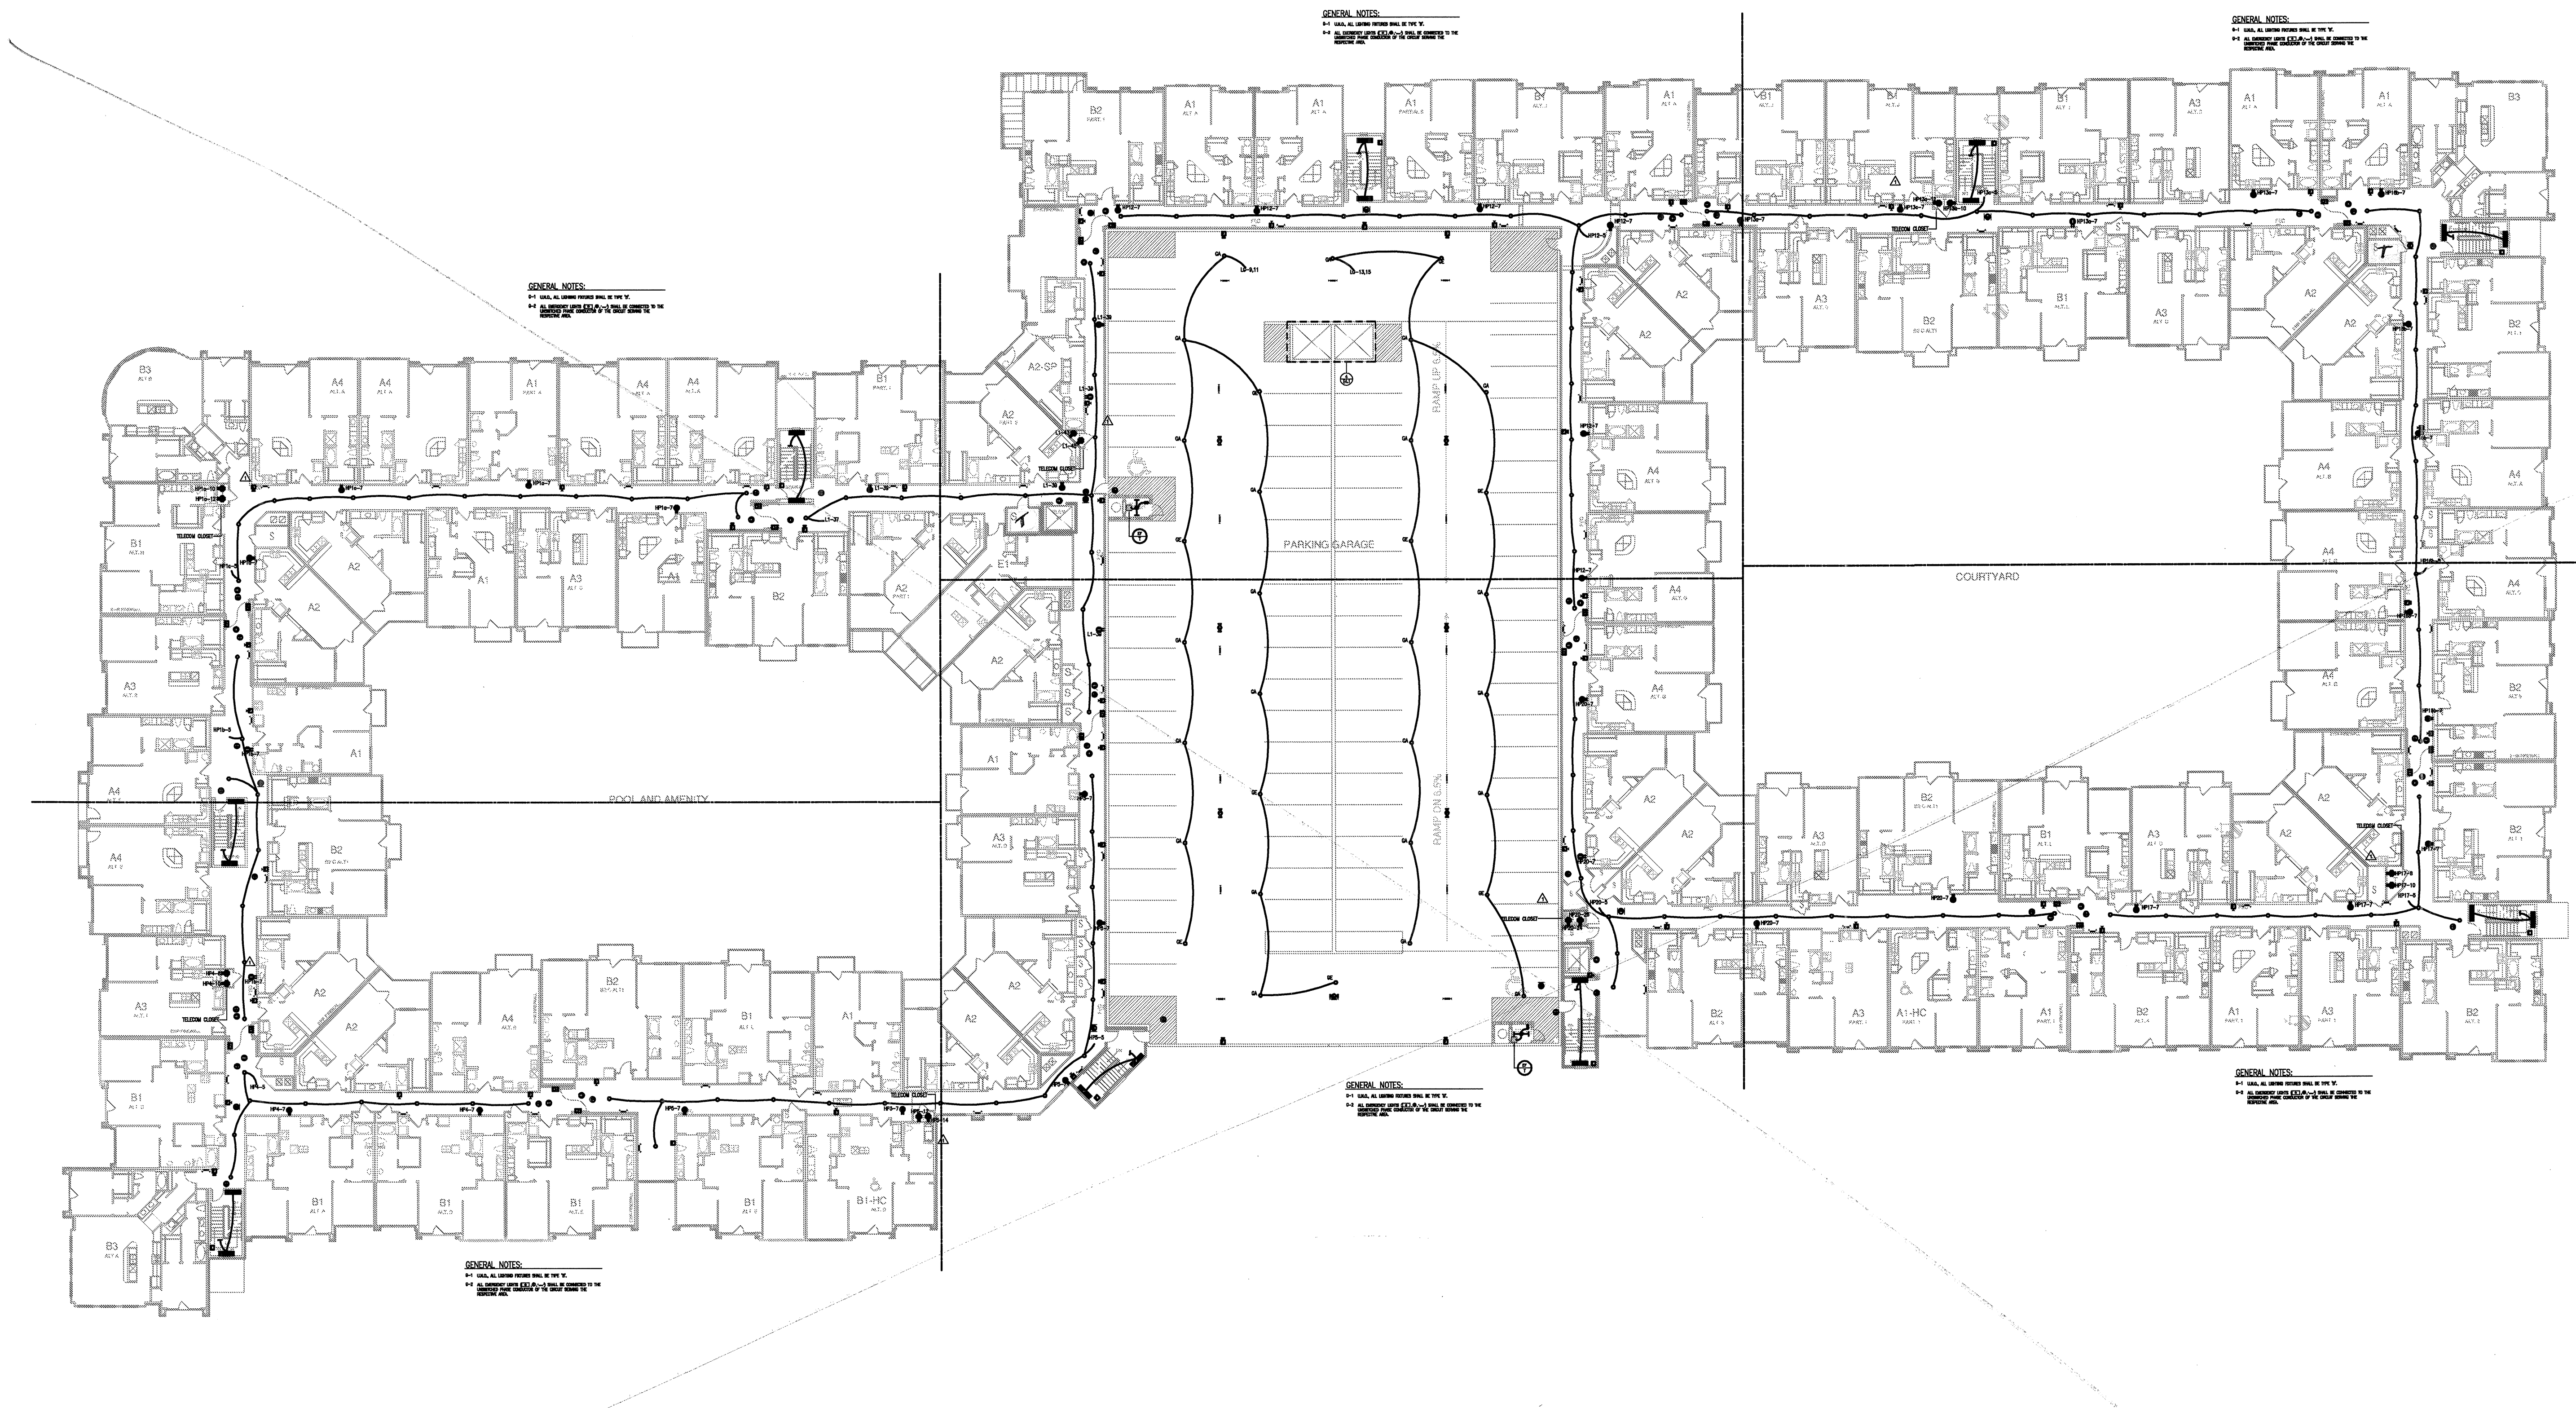

GENERAL NOTES:  
#1 SHALL BE LOBBY REVISIONS IN THE 'E'  
#2 ALL UNITS SHALL BE 100% COMPLETE TO THE  
#3 ALL UNITS SHALL BE 100% COMPLETE TO THE

GENERAL NOTES:  
#1 SHALL BE LOBBY REVISIONS IN THE 'E'  
#2 ALL UNITS SHALL BE 100% COMPLETE TO THE  
#3 ALL UNITS SHALL BE 100% COMPLETE TO THE

1 FLOOR PLAN - 3-2  
SCALE: 1/32" = 1'-0"

*AT: 7/24/11*